

APPLICATION

SEWAGE DISPOSAL TESTING

STATE OF MARYLAND - DEPARTMENT OF HEALTH AND MENTAL HYGIENE

HOWARD COUNTY HEALTH DEPARTMENT
ENVIRONMENTAL HEALTH SERVICES

P. O. BOX 473, ELLICOTT CITY, MARYLAND 21043
TELEPHONE: 992-2330

A 32180

P _____

DISTRICT 5th

DATE 9-16-82

TO: THE COUNTY HEALTH OFFICER
ELLICOTT CITY, MARYLAND

I, HEREBY, APPLY FOR THE NECESSARY TEST IN ORDER TO CONSTRUCT (OR RECONSTRUCT) A SEWAGE DISPOSAL SYSTEM.

PROPERTY OWNER RICHARD DEMMITT

ADDRESS 9966 MARYLAND ROUTE 99 PHONE 465-4544

PROPERTY LOCATION: _____

SUBDIVISION JOCELYN ACRES, SECTION 3 LOT NO. 3

ROAD AND DESCRIPTION HIGHLAND ROAD, DIRECTLY ACROSS FROM ALLNUT LANE

(13422 Rich Lynn Court)

SIZE OF LOT 3 ACRES TYPE BLDG. SINGLE FAMILY DWELLING
(NUMBER OF BEDROOMS)

THE SYSTEM INSTALLED UNDER THIS APPLICATION IS ACCEPTABLE ONLY UNTIL PUBLIC FACILITIES BECOME AVAILABLE. I FULLY UNDERSTAND THE
FEE CONNECTED WITH THE FILING OF THIS PERC TEST APPLICATION IS NON-REFUNDABLE UNDER ANY CIRCUMSTANCES. I ALSO AGREE TO COMPLY
WITH ALL M.O.S.H.A. REQUIREMENTS IN TESTING THIS LOT.

Charles J. Conner

(SIGNATURE OF APPLICANT)

APPROVED BY _____ FOR _____ DATE _____

REJECTED BY _____ FOR _____ DATE _____

HOLD PENDING FURTHER TESTS _____ DATE _____

REASONS FOR REJECTION OR HOLDING _____


THIS IS NOT A PERMIT

STAKE

SEEP LAY FOR ENTIRE LOT

HOLE ELEVATION

SOIL PROFILE
 1
 BROWN CLAY
 3
 HARD GRAY & BROWN SAND

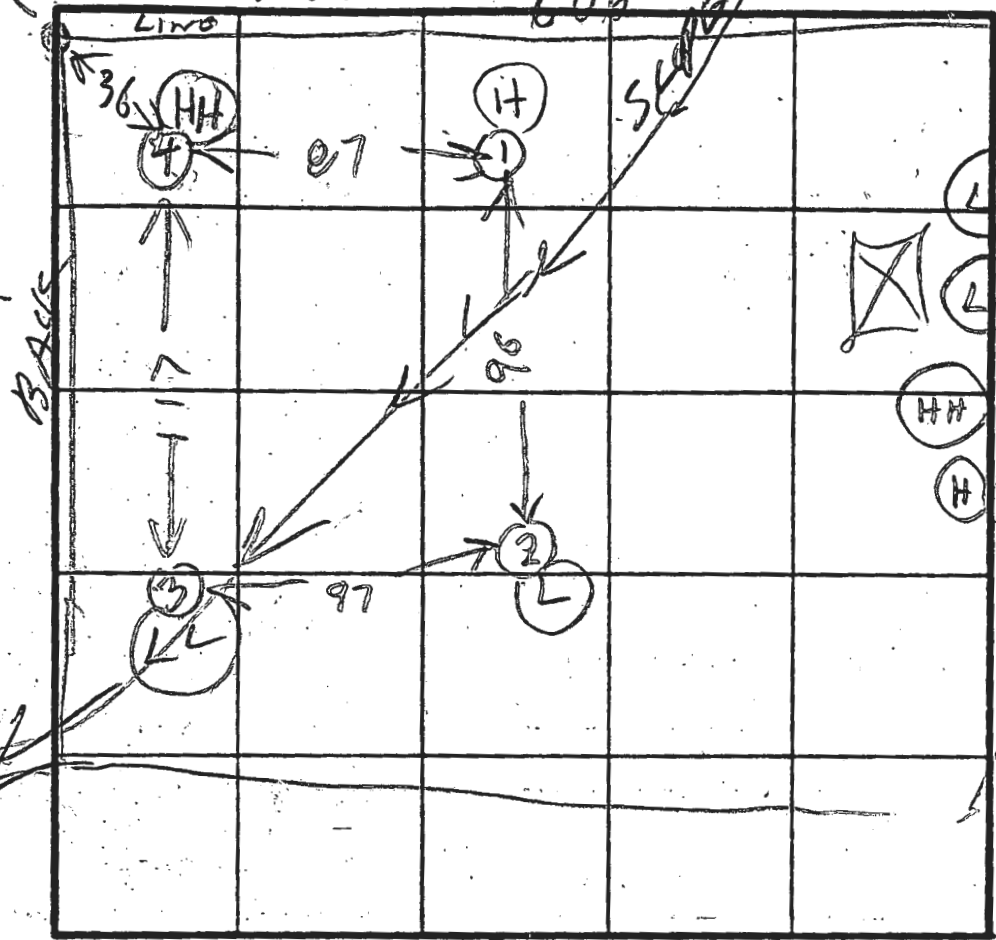

3 = LOWEST
 2 = NEXT LOWEST
 4 = HIGHEST
 1 = NEXT HIGHEST

INDICATE NORTH - NAME ADJOINING ROADWAY AS BASE LINE

2
 BROWN CLAY
 TAN & GRAY SAND
 HARD

3
 TAN CLAY
 HARD TAN SAND

DATE	TEST NO.	DEPTH	PRE-WET		TEST - 1' DROP		TIME
			START	STOP	START	STOP	
10/5/82	1 S	5 1/2	1004	1009	1008	1015	7
	1 D	8	1004	1006	1006	1013	7
	1 V	13	SEE SOIL PROFILE				
	2 S	5	1029	1031	1031	1036	5
	2 D	8 1/2	1039	1044	1044	1055	11
	2 V	6	SEE SOIL PROFILE				
	3 S	6	1045	1048	1048	1057	9
	3 D	9	1043	1048	1046	1049	3
	3 V	12	SEE SOIL PROFILE				
	4 D	8	1107	1108	1108	1109	1
	4 S	5	1107	1108	1108	1109	1
	4 V	12	SEE SOIL PROFILE				

avg 6
 max depth 3

4
 BROWN CLAY
 HARD TAN & GRAY SAND
 EH-12-1079


REMARKS DITCH BETWEEN HOLES (4) & (1)

TYPE OF SOIL
 TESTED BY R HODGES
 ALSO PRESENT R DIMMITT C CLESER

10/22/82 trench about 3' max depth bottom @ 8 ft. FS

NICHOLS

SHEET 1 OF 2	SHEET 2 OF 2	TOTAL
7	9	12
2255 AC	22034 AC	24289 AC
1807 AC	13616 AC	31623 AC
24046 AC	1307 AC	25353 AC
53800 AC		53800 AC

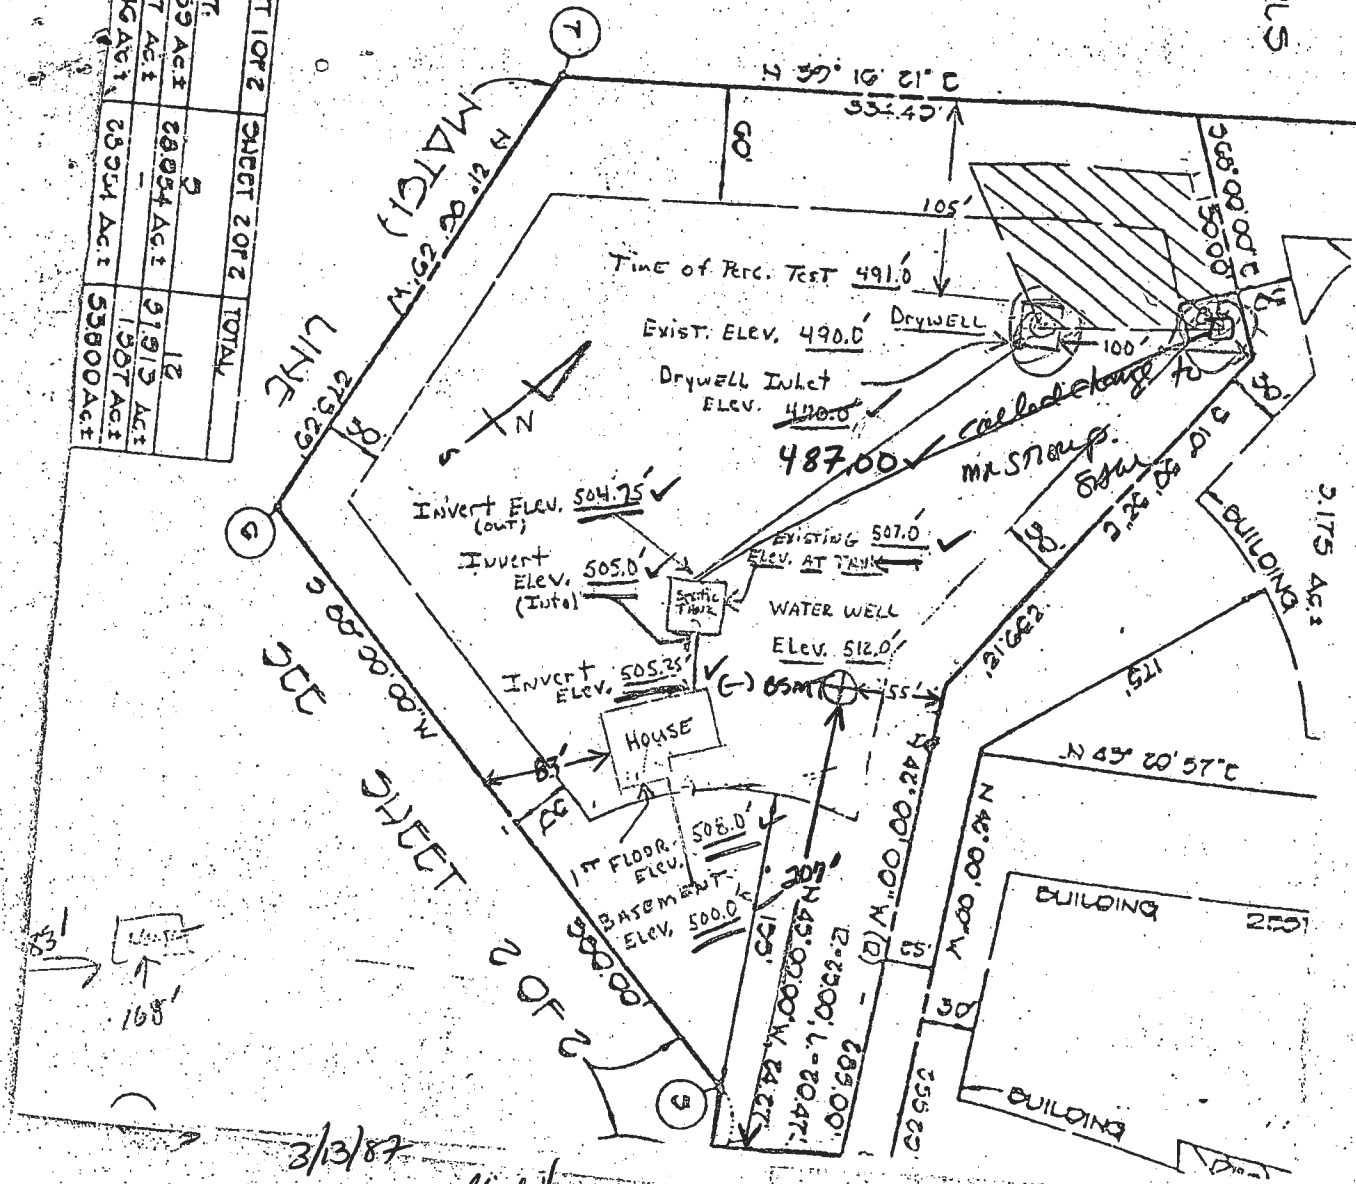

3/13/87
 elevations all w/
 inlet chng. noted above
 Soffel

BLDG. PERMIT SIGNED
 AND RETURNED 3-13-87

I CERTIFY THE ABOVE MEASUREMENTS ARE ACTUAL
 AND CORRECT FOR THIS PROPERTY

Jocelyn Acres
 Lot 3 - Sec 3
 490-0036
 Work - 588-2720
 13422 Ruth Lynne Ct.

Signed Shane Robert Soffel