Bureau of Environmental Health

8930 Stanford Boulevard, Columbia, MD 21045 Main: 410-313-2640 | Fax: 410-313-2648 TDD 410-313-2323 | Toll Free 1-866-313-6300

www.hchealth.org
Facebook: www.facebook.com/hocohealth

Maura J. Rossman, M.D., Health Officer

RECEIPT D	OATE: 3/29/21 ONSITE SEWAGE DISPOSAL	SYSTEM	Ρ.	568811			
		ank					
APPROVAL D	PERMIT: Repla	cement	Α.				
PROPERTY A	DDRESS: 610 Sobrina Farms Court						
SUBDIVISION	l:	LOT:	TAX ID: _				
CONTRACTO	R: WTC III Plumbing and Heating inc.	EMAIL:					
CONTRACTO	R ADDRESS: 1820 Gillis Falls Road, Woodbine, MD 21797		PHONE:	443-398-1782			
PROPERTY OWNER: Mark Springmann EMAIL:							
OWNER ADDRESS: 610 Sobrina Farms Court, Woodbine, MD 21797 Pl							
SEPTIC TANK SIZE (GALLONS): PUMP CHAMBER CAPACITY (GALLONS): PUMP SIZE:							
NUMBER OF	BEDROOMS: HOUSE SQ. FT.	A	PPLICATION RA	ATE:			
DISTRIBUTIO	N SYSTEM: GRAVITY FED 🔀 LOW PRESSURE D	OSED					
	LINEAR FEET REQUIRED:		INLET DEPTH:				
TRENCHES:							
	MINIMUM SPACE						
LOCATION	BETWEEN TRENCHES: EFFECTIVE AREA BEGINNING DEPTH: ATION: TO BE STAKED BY SANITARIAN DURING PRE-CONSTRUCTION INSPECTION.						
LOCATION:	TO BE STAKED BY SANTIAKIAN DURING PRE-CONSTRUCTION IN	43FECTION.					
NOTES:	warred to be propleted the end of						
NOTES.	NOTES: tank replacement only.						
ISSUED BY:	H. Dswold ISSUE DATE: Z	Issler F	XPIRATION DA	ATE: 3/24/20			
	TRACTOR MUST SCHEDULE A PRE-CONSTRUCTION INSPECTION P			' '			
NOTE: STON							
7.7	OTE: WATERTIGHT SEPTIC TANKS REQUIRED						
	DTE: ALL PARTS OF SEPTIC SYSTEM SHALL BE AT LEAST 100 FEET DOWNGRADIENT FROM ANY WATER WELL DTE: MANHOLE RISERS REQUIRED ON ALL SEPTIC TANKS AND PUMP CHAMBERS						
NOTE: AN E	ELECTRICAL PERMIT IS REQUIRED FOR INSTALLATION OF ANY ELEC		ONENTS OF THE	SYSTEM			
<u>_</u>	HCHD DOES NOT WARRANTY ANY SYSTEM AND CANNOT GUARA	NTEE THE PERF	ORMANCE OF T	HIS SYSTEM AS			
	DESIGNED. BY ACCEPTING THIS PERMIT, THE OWNER AND/OR APPLICANT ACKOWLEDGE THAT THE SPECIFICATIONS						
	AILED IN THIS DESIGN ARE ONE POSSIBLE OPTION AND THAT THE OPTION TO SEEK THE ADVICE OF A QUALIFIED DESIGN CONSULT!						
	ADNCE.	OKTROILS					
	MDE RECOMMENDS SEPTIC TANKS, BAT, AND OTHER PRETREATMENT UNITS BE PUMPED AT A FREQUENCY ADEQUATE TO ENSURE THAT SOLIDS ARE NOT DISCHARGED TO THE DISPOSAL AREA						

PERMITTEE RESPONSIBLE FOR OBTAINING FINAL APPROVAL ON THIS PERMIT.

CALL 410-313-1771 TO SCHEDULE INSPECTIONS.

NEITHER THE HOWARD COUNTY COUNCIL NOR THE HEALTH DEPARTMENT IS RESPONSIBLE FOR THE SUCCESSFUL OPERATION OF ANY SYSTEM.

NOT TO SCALE ST ~ 6'>11' driveway 168' H0-88-0986 W	TRENCH/DRAINFIELD DATA WIDTH INLET BOTTOM NUMBER OF TRENCHES TOTAL LENGTH ABSORPTION AREA DISTRIBUTION BOX LEVEL DISTRIBUTION BOX BAFFLE DISTRIBUTION BOX PORT TANK REPLACEMENT SEPTIC TANK DATA SEPTIC TANK 1 LEVEL MANUFACTURER BODY ON CAPACITY 1500 GAL SEAM LOC TOP TANK LID DEPTH 2' BAFFLES TON 16" - DACK 4" BAFFLE FILTER MANHOLE LOC FONT DACK 6" PORT LOC WATERTIGHT TEST SLOTTED YES DATE ON LID 42 21 PUMP/SEPTIC TANK LEVEL MANUFACTURER CAPACITY GAL SEAM LOC TANK LID DEPTH BAFFLES BAFFLE FILTER MANHOLE LOC 6" PORT LOC WATERTIGHT TEST SLOTTED WATERTIGHT TEST SLOTTED WATERTIGHT TEST SLOTTED WATERTIGHT TEST SLOTTED				
ROAD NAME Sobring Forms Ct.	DATE ON LID				
PRE-CONSTRUCTION:					
INSTALLATION: 6/17/21 - tank replacement - upgrade to 1500 gel for renovation in basement, baffles are good, had to step the sewer line down 1-2 ft coming out the back of the septic tank books apod-old tank pumped out and removed from site for recycling and new tank was installed in same place as old tank. OK to back !!! (Re)					
•					
FINAL INSPECTOR R.Rappaport DATE OF APPRO	VAL 6 17 21				



Bureau of Environmental Health 8930 Stanford Blvd | Columbia, MD 21045 410.313.2640 - Voice/Relay 410.313.2648 - Fax 1.866.313.6300 - Toll Free

Maura J. Rossman, M.D., Health Officer


INFORMATION FORM - SEPTIC SYSTEM REPAIR/UPGRADE Reason for Request: Has the septic tank been pumped within the last month? ☐ Failing System Date pumped:_ П System relocation for proposed addition No System upgrade for proposed addition Was a visual inspection of the septic tank and/or drain fields conducted? □ Inadequate treatment zone □ Collapsed septic tank Explain observation: Was trouw Yes □ Collapsed drywell 1000 No Existing system design Was a visual inspection of the sewage line conducted? Drywell Ø Trench Mound Unknown **Blockage Leading to the field** Other: Yes Explain is discharge surfacing on the ground? Yes No Additional Comments: α Dedvoom basecurent *For REPAIRS, are the owners proposing, or do they plan to add in the future any additions or modifications to the property, i.e. pools, living space additions, garages, etc? This information must be disclosed at the time of this application. The Health Department will not be able to accommodate requests in the field for property modifications unrelated to the repair request. Such requests may require an additional fee, testing, and submittal of a Percolation Certification Plan, if the property does not meet current Code and Regulations. Contractor's Phone. Septic Contractor: MD State Marter Plumber \$7979 Contractor's Address: Farms Ct County File: Property Address: Lot: _____ Year Built: _____ Existing bedrooms: ___ Owner's Name: Name of previous owners: Existing bedrooms: Proposed bedrooms: ____ *A Sanitarian will be in contact within three business days, depending upon the urgency of the situation, to coordinate the scheduling/review of the repair or upgrade. *Prior to scheduling inspections, scaled plans should be submitted to clarify the nature of the addition.* Print out a copy of Real Property Data via Dept. of Taxation website_____ _____Indexed file found_ If soil/site conditions are limited and sewer and/or Metro District status is not conducive to connection, the Sanitarian may recommend pursuit of Emergency Sewer Extension or Emergency Metro District Inclusion. The Owner should contact the Bureau of Utilities for details.

2/2020

Website: Specific and the Facebook: Specific and the Specific and Spec

No permit is to be issued nor inspection to be scheduled without prior fee collection at the office unless an emergency exists.

The contractor is to notify the office of the emergency as soon as possible.

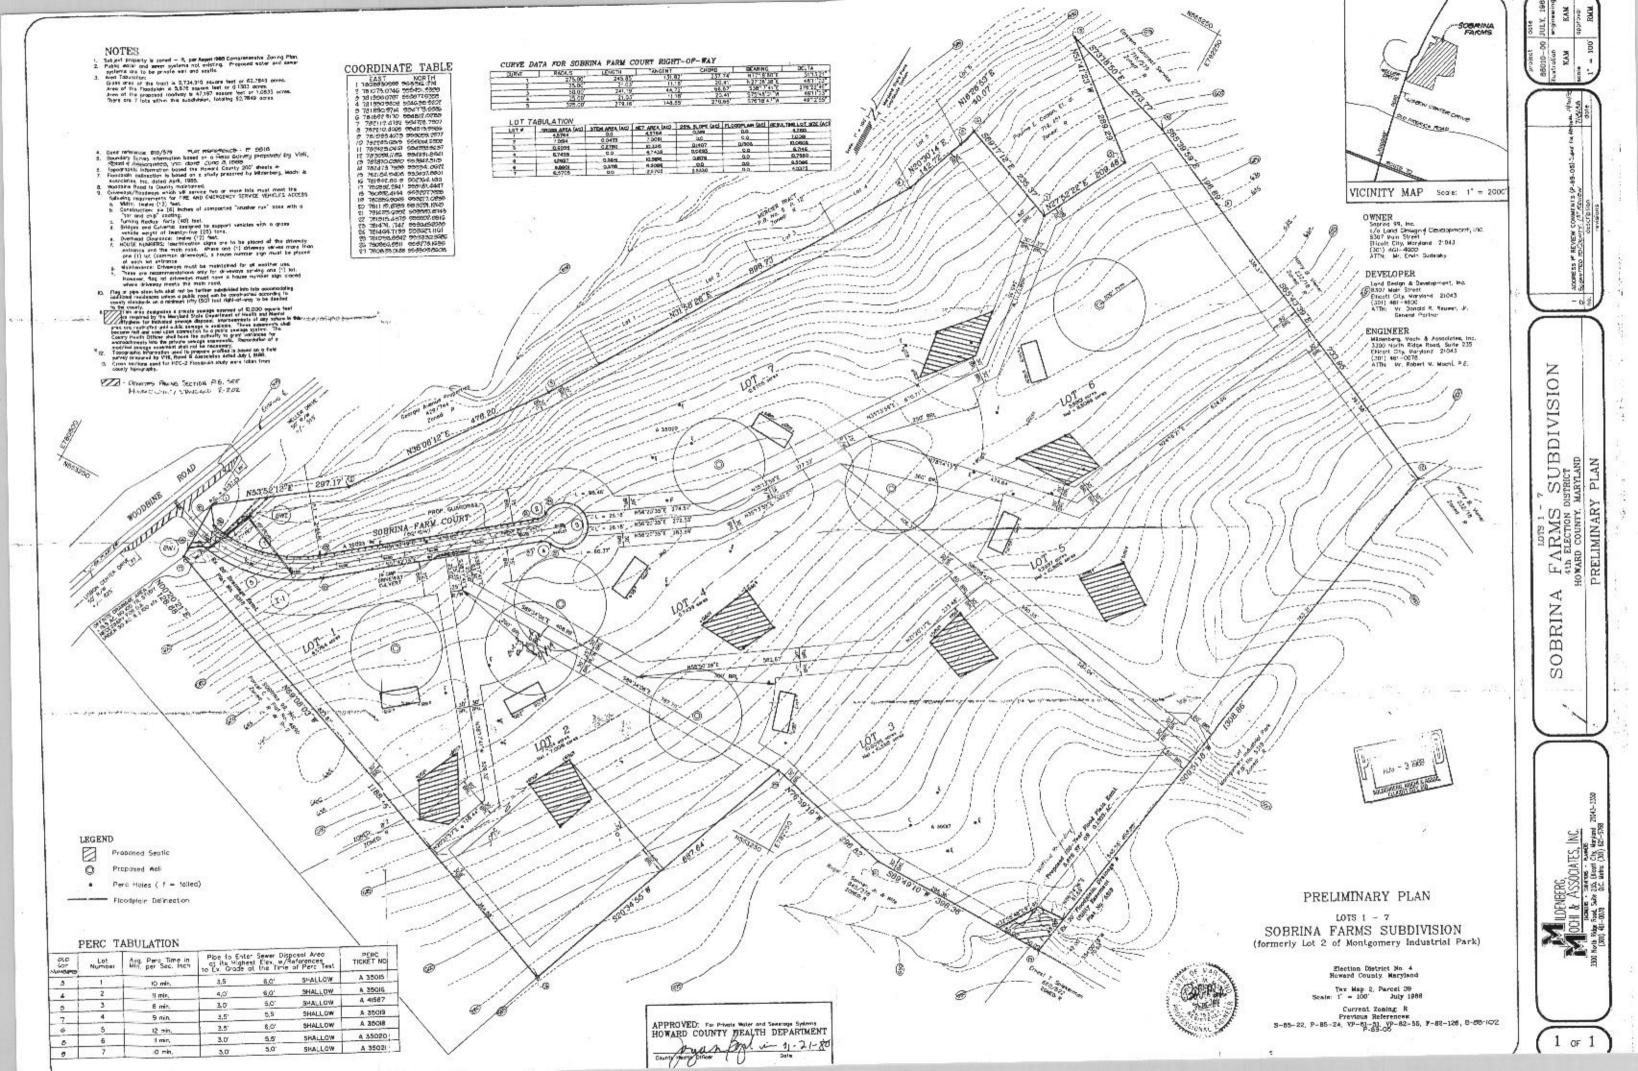



PERMIT

SEWAGE DISPOSAL SYSTEM

DEPARTMENT OF HEALTH AND MENTAL HYGIENE

A	35	01	6

DISTRICT

INSPECTOR

HOWARD COUNTY HEALTH DEPARTMENT BUREAU OF ENVIRONMENTAL HEALTH

##D\$98\$:313-2640

04.349768

Jack Fyock Septic Service	IS PERMITTED TO INSTALL X ALTER					
ADDRESS 13775 Triadelphia Road Glenelg, MD	21737 PHONE 988-9270					
SUBDIVISION Sobrina Farms LOT 2	ROAD610 Sobrina Farm Court					
PROPERTY OWNER Percontee,	Inc.					
ADDRESS						
SEPTIC TANK CAPACITY 1000 GALLONS						
NUMBER OF BEDROOMS 3						
2/0 SQUARE FEET PER BEDROOM						
LINEAR FEET OF TRENCH REQUIRED 2/0						
TRENCHES - 210 sq. ft. per bedroom. Trench to be 3 feet wide. Inlet 4.0 feet below ori original grade. Bottom maximum depth 5.5 feet below original grade. Effective area begins at 4.0 feet below original grade. 1.5 feet of stone below original grade. 1.5 feet of stone below distribution pipe. LOCATION - Start the first trench 310' from the rear (688') lot line and 260 feet from the right (365') lot line as seen when facing the lot from the Sobrina Farms Court. Run trenches on contour toward the left side line.						
NOTE - Noitrench to exceed 100 feet in leng cap to grade or above on septic tank	th. Provide 6" - 8" diameter cleanout and . 12 127 90 0 RIX					
PLANS APROVED BY RaymondiHodges	cm DATE 12/18/90					
COVER NO WORK UNTIL INSPECTED AND APPROVED						
NEITHER THE HOWARD COUNTY COUNCIL NOR THE HEALTH DEPARTMENT IS RESPONSIBLE FOR THE SUCCESSFUL OPERATION OF ANY SYSTEM						
NOTE: CLEANOUT REQUIRED EVERY 70 FEET OF SEWER LINE AND/OR AT 90° SWEEPS IN LINES FROM HOUSE TO DRAIN FIELDS, 90° ELBOWS NOT ACCEPTABLE.						
NOTE: ALL PARTS OF SEPTIC SYSTEMS (I.E. TANK, DISTRIBUTION BOX TRENCHES) TO BE 100 FEET FROM WELL (UNLESS OTHERWISE SPECIFICALLY AUTHORIZED)						

PVA OR ABS ACCEPTED. IF TOP OF SEPTIC TANK IS DEEPER THAN 3 FEET, MANHOLE TO GRADE REQUIRED.

NOTE: IF DEEP TRENCH(ES) ARE USED CALL FOR INSPECTION BEFORE AND AFTER PLACING GRAVEL IN TRENCH(ES) NOTE: NO DRY WELL SHALL EXCEED 15 FOOT IN DIAMETER NO ABSORPTION TRENCH TO EXCEED 100 FEET IN LENGTH

NOTE: ALL PIPE FROM HOUSE TO SEPTIC TANK MUST BE CAST IRON OR SCHEDULE 35/40 PVC OR ABS


NOTE: DISTRIBUTION BOXES MUST HAVE BAFFLES

*INSTALLER IS RESPONSIBLE FOR OBTAINING FINAL APPROVAL ON THIS PERMIT *CALL 461-9933 FOR INSPECTION OF SEPTIC SYSTEM.

NOTE: INSTALL STAND PIPE ON SEPTIC TANK AND DRY WELL STAND PIPES MUST BE 6 INCHES IN DIAMETER CAST IRON, CONCRETE OR TERRA COTTA OR

HD-260(6-90)

PERMIT VOID AFTER TWO YEARS

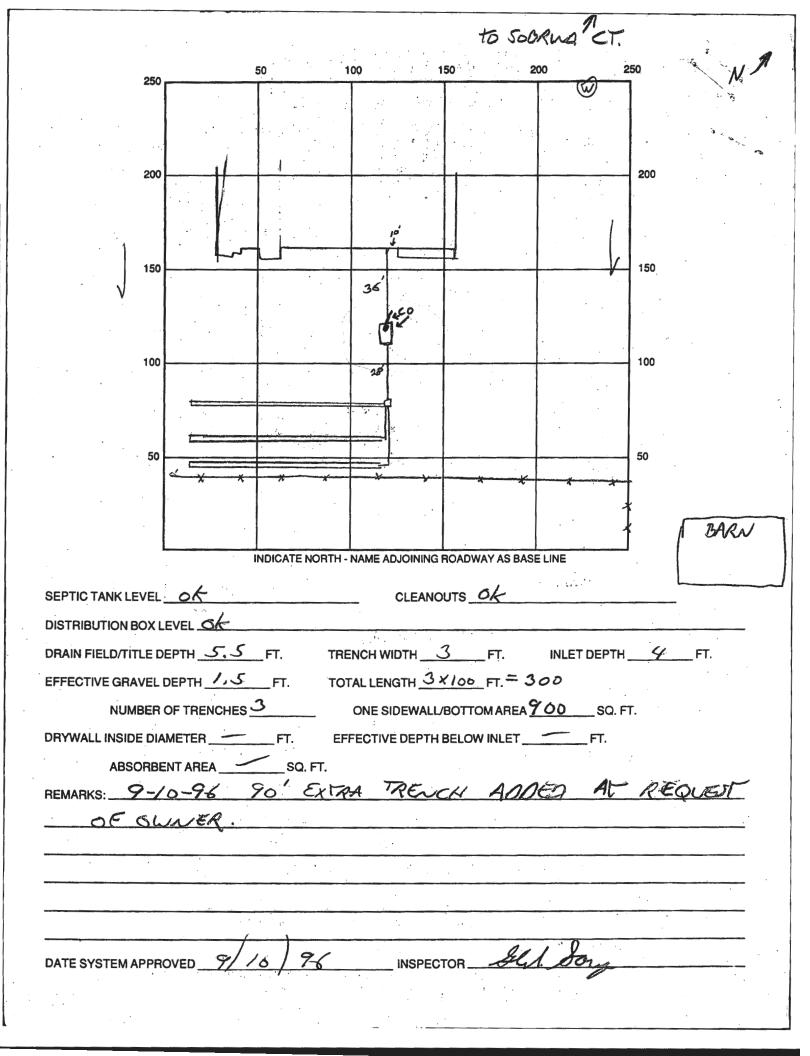

The new tank will be installed in the same location as the existing tank.