



# HOWARD COUNTY HEALTH DEPARTMENT

69522

DATE 5/21/21

Received From

Fogles Septic Clean

PHONE #

410 795-5070

For

Perc / Repair / 11833  
Roxbury Rd.

☐ CASH

☒ CHECK

NO

12084


one hundred thirty

Dollars

\$ 330 00

Received By

J King

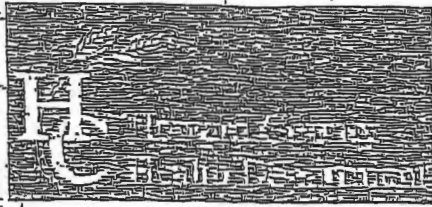

## Bureau of Environmental Health

8830 Stanford Boulevard, Columbia, MD 21045

Main: 410-313-2540 | Fax: 410-313-2548

TDD: 410-313-2333 | Toll Free: 1-866-313-8300

www.hchealth.org

Facebook: www.facebook.com/hcphhealth

Twitter: @HowardCoHealthDep

Dr. Maura J. Roszman, M.D., Health Officer

### INFORMATION FORM - SEPTIC SYSTEM REPAIR/UPGRADE

#### Reason for Request

- ☒ Existing System
- ☐ System relocation for proposed addition
- ☐ System upgrade for proposed addition
- ☐ Inadequate treatment zone
- ☐ Collapsed septic tank
- ☐ Collapsed drywell

Has the septic tank been pumped within the last month?

- ☐ Yes Date pumped: \_\_\_\_\_
- ☐ No

Was a visual inspection of the septic tank and/or drain fields conducted?

- ☐ Yes Explain observation: \_\_\_\_\_
- ☐ No

Was a visual inspection of the sewage line conducted?

- ☐ Yes Blockage leading to the tank:  
☐ Yes Explain: \_\_\_\_\_  
☐ No

Blockage leading to the field

- ☐ Yes Explain: \_\_\_\_\_
- ☐ No

#### Existing system design

- ☐ Drywell
- ☒ French
- ☐ Mound
- ☐ Unknown
- ☐ Other \_\_\_\_\_

Is discharge surfacing on the ground?

- ☐ Yes
- ☒ No

☐ No

Additional Comments: \_\_\_\_\_

\*For REPAIR, are the owners proposing, or do they plan to add in the future, any additions or modifications to the property, i.e., pools, living space additions, garages, etc? This information must be disclosed at the time of this application. The Health Department will not be able to accommodate requests in the field for property modifications unrelated to the repair request. Such requests may require an additional fee, testing, and submittal of a Percolation Certification Plan, if the property does not meet current Code and Regulation.

Septic Contractor: Fogles Septic Contractor's Phone: \_\_\_\_\_

Contractor's Address: 1550 Oldfield Rd Sykesville MD

Property Address: 11833 Ramsbury Rd Marriottsville County Rd

Subdivision: \_\_\_\_\_ Lot: 18 Year Built: 1965

Owner's Name: James Linder Owner's Phone: \_\_\_\_\_

Name of previous owner: \_\_\_\_\_ Existing bedrooms: 4

Proposed bedrooms: \_\_\_\_\_

Has this request been previously discussed with a Sanitarian? (Name): \_\_\_\_\_

Public Sewer available/nearby: \_\_\_\_\_

\*A Sanitarian will be in contact within three business days, depending upon the urgency of the situation, to coordinate the scheduling/visit of the repair or upgrade.

\*Prior to scheduling inspections, scaled plans should be submitted to clarify the nature of the addition.

Print out a copy of Real Property Data via Dept. of Taxation website Indexed file found

If public sewer may be nearby, verify whether sewer is technically "available" through the Bureau of Engineering

If sewer is available and the property is within the Metropolitan District, connection to sewer is required if the owner believes reason for inspection exists, the owner should justify the request in writing.

If soil/site conditions are limited and/or sewer District status is not conducive to connection, the Sanitarian may recommend pursuit of Emergency Sewer Extension or Emergency Metro District Inclusion. The Owner should contact the Bureau of Utilities for details.

No permits to be issued nor inspection to be scheduled without prior fee collection at the office unless an emergency situation exists. The contractor is to notify office of the emergency situation as soon as possible.



# Howard County Health Department

Maura J. Rossman, M.D., Health Officer

**Bureau of Environmental Health**  
8930 Stanford Boulevard, Columbia, MD 21045  
Main: 410-313-2640 | Fax: 410-313-2648  
TDD 410-313-2323 | Toll Free 1-866-313-6300  
[www.hchealth.org](http://www.hchealth.org)  
Facebook: [www.facebook.com/hocohealth](https://www.facebook.com/hocohealth)

RECEIPT DATE: 5/24/21 **ONSITE SEWAGE DISPOSAL SYSTEM** P 569522  
APPROVAL DATE: 06/07/2021 **PERMIT: MINOR REPAIR** A \_\_\_\_\_  
PROPERTY ADDRESS: 11833 Ramsburg Road  
SUBDIVISION: HENRYTON HEIGHTS LOT: 18 TAX ID: 03-303756  
CONTRACTOR: Fogles Septic Clean Inc EMAIL: kim@foglesinc.com  
CONTRACTOR ADDRESS: 580 Obrecht Road, Sykesville, MD 21784 PHONE: 410-795-5670  
PROPERTY OWNER: Thomas and Janice Linder EMAIL: \_\_\_\_\_  
OWNER ADDRESS: 11833 Ramsburg Road, Marriottsville, MD 21104 PHONE: 410-984-728854

SEPTIC TANK SIZE (GALLONS): \_\_\_\_\_ PUMP CHAMBER CAPACITY (GALLONS): \_\_\_\_\_ PUMP SIZE: \_\_\_\_\_  
NUMBER OF BEDROOMS: \_\_\_\_\_ HOUSE SQ. FT. \_\_\_\_\_ APPLICATION RATE: \_\_\_\_\_  
DISTRIBUTION SYSTEM: GRAVITY FED ☒ LOW PRESSURE DOSED ☐

TRENCHES: <b>EXISTING</b>	LINEAR FEET REQUIRED: _____	INLET DEPTH: _____
	TRENCH WIDTH: _____	MAXIMUM BOTTOM DEPTH: _____
	MINIMUM SPACE BETWEEN TRENCHES: _____	EFFECTIVE AREA BEGINNING DEPTH: _____
LOCATION:	TO BE STAKED BY SANITARIAN DURING PRE-CONSTRUCTION INSPECTION.	
NOTES:	<p>UPPER TRENCH IS HYDRAULICALLY FULL; CLOSED W/ SPEED LEVEL</p> <p>LOWER TRENCH IS DRY; RESTORED TO FUNCTIONING CAPACITY</p> <p>RE-EVALUATE AT FAILURE FOR NEW SYSTEM.</p>	

ISSUED BY: CABAHUG 001997 ISSUE DATE: 06/07/2021 EXPIRATION DATE: 06/07/2022


- NOTE: CONTRACTOR MUST SCHEDULE A PRE-CONSTRUCTION INSPECTION PRIOR TO BEGINNING ANY INSTALLATION**
- NOTE: CONTRACTOR MUST SCHEDULE AN INSPECTION AND GAIN APPROVAL OF ALL COMPONENTS PRIOR TO COVERING**
- NOTE: STONE MUST BE APPROVED BY HEALTH DEPARTMENT AND GRAVEL TICKET MUST BE AVAILABLE FOR REVIEW.**
- NOTE: WATERTIGHT SEPTIC TANKS REQUIRED**
- NOTE: ALL PARTS OF SEPTIC SYSTEM SHALL BE AT LEAST 100 FEET DOWNGRADE FROM ANY WATER WELL**
- NOTE: MANHOLE RISERS REQUIRED ON ALL SEPTIC TANKS AND PUMP CHAMBERS**
- NOTE: AN ELECTRICAL PERMIT IS REQUIRED FOR INSTALLATION OF ANY ELECTRICAL COMPONENTS OF THE SYSTEM**
- ☐ ELECTRICAL PERMIT ISSUED E \_\_\_\_\_
- NOTE: THE HCHD DOES NOT WARRANTY ANY SYSTEM AND CANNOT GUARANTEE THE PERFORMANCE OF THIS SYSTEM AS DESIGNED. BY ACCEPTING THIS PERMIT, THE OWNER AND/OR APPLICANT ACKNOWLEDGE THAT THE SPECIFICATIONS DETAILED IN THIS DESIGN ARE ONE POSSIBLE OPTION AND THAT THE HCHD WILL REVIEW OTHER PROPOSALS. YOU HAVE THE OPTION TO SEEK THE ADVICE OF A QUALIFIED DESIGN CONSULTANT OR PROFESSIONAL ENGINEER FOR FURTHER GUIDANCE.**
- NOTE: MDE RECOMMENDS SEPTIC TANKS, BAT, AND OTHER PRETREATMENT UNITS BE PUMPED AT A FREQUENCY ADEQUATE TO ENSURE THAT SOLIDS ARE NOT DISCHARGED TO THE DISPOSAL AREA**

**NEITHER THE HOWARD COUNTY COUNCIL NOR THE HEALTH DEPARTMENT IS RESPONSIBLE FOR THE SUCCESSFUL OPERATION OF ANY SYSTEM.**

**PERMITTEE RESPONSIBLE FOR OBTAINING FINAL APPROVAL ON THIS PERMIT.**

**CALL 410-313-1771 TO SCHEDULE INSPECTIONS.**

NOT TO SCALE

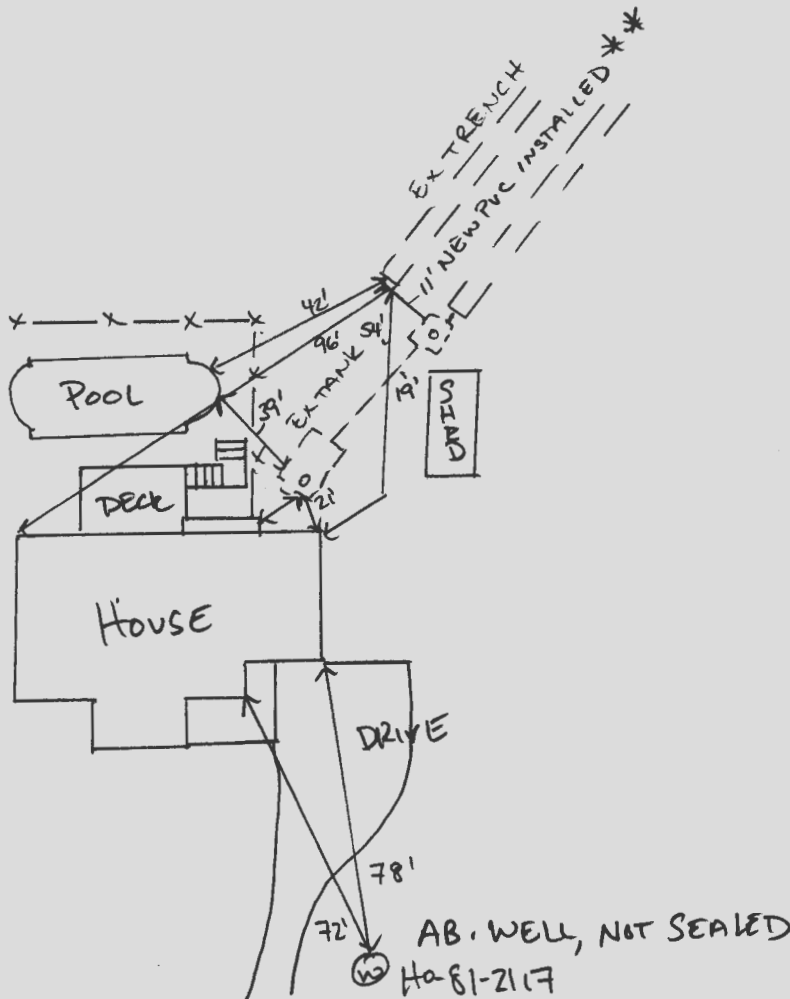

**TRENCH/DRAINFIELD DATA**

WIDTH INLET BOTTOM

NUMBER OF TRENCHES

TOTAL LENGTH

ABSORPTION AREA

DISTRIBUTION BOX LEVEL Speed

DISTRIBUTION BOX BAFFLE

DISTRIBUTION BOX PORT

**SEPTIC TANK DATA**

SEPTIC TANK 1 LEVEL

MANUFACTURER

CAPACITY GAL

SEAM LOC

TANK LID DEPTH ~1'

BAFFLES

BAFFLE FILTER

MANHOLE LOC INLET (NEW)

6" PORT LOC INLET

WATERTIGHT TEST

SLOTTED

DATE ON LID

PUMP/SEPTIC TANK LEVEL

MANUFACTURER

CAPACITY GAL

SEAM LOC

TANK LID DEPTH

BAFFLES

BAFFLE FILTER

MANHOLE LOC

6" PORT LOC

WATERTIGHT TEST

SLOTTED

DATE ON LID

PRE-CONSTRUCTION:

\* NO PERC REQUIRED

INSTALLATION: 06/07/2021 INSTALLED NEW PVC BETWEEN D BOX AND LOWER TRENCH. NEW RISER ADDED TO TANK. SPEED LEVEL INSTALLED

\* UPPER TRENCH IS HYDRAULICALLY FULL; TRENCH CLOSED W/ SPEED LEVEL FOR REST. AS OF 06/07/2021 ONLY THE LOWEST TRENCH IS RECEIVING EFFLUENT. \*

FINAL INSPECTOR

DATE OF APPROVAL 06/07/2021