

Bureau of Environmental Health 8930 Stanford Blvd | Columbia, MD 21045 410.313.2640 - Voice/Relay

410.313.2648 - Fax 1.866.313.6300 - Toll Free


138718

Maura J. Rossman, M.D., Health Officer

APPLICATION

FOR PERCOLATION TESTING AND SITE EVALUATION				
PROPERTY LOCATION				
SUBDIVISION/PROPERTY NAME				

SUBDIVISION/PROPER	TYNAME		
PROPERTY ADDRESS	6800 Redbern	Rd Clarismile	21029
TAX ACCOUNT #		009 PARCEL 0205 LOT NO.	PROPOSED LOT
ZONING CATEGORY	TIER		
PROPERTY OWNER	us) Prob mass	20	
DAYTIME PHONE TU		· 7235 EMAIL	
MAILING ADDRESS	800 Red Derry Rd	Clarwalle mp &	21023 ZIP
APPLICANT TYPE	dom Scoti	RELATIONSHIP TO OWNER: \\\\\\\\\\\\\\\\\\\\\\\\\\\\\\\\\\\\	taller I repair
DAYTIME PHONEL 10	785.2947 CELL	EMAIL Chrish Ofredo	m Senhacom
MAILING ADDRESS	2803 Livery Rd	Sikewile mo	21784
~	STREET STATE OF THE PROPERTY O	CITY, STATE	ZIP
THEREBY APPLY FOR THE	: NECESSARY TESTING/EVALUATION PRI	OR TO ISSUANCE OF SEWAGE DISPOSAL SYS	HEM PERMIT(S):
CONSTRUCT REPAIR OR RI UPGRADE EX BUILDING: RESIDENTIAL	ISION CLASSIFICATION (PER DEPT. OF PLANNING NEW OSDS ON UNDEVELOPED LOT EPLACE FAILING OSDS ISTING OSDS WITH EXISTING OR PROPOSED	BEDROOMS IN THE COMPLETED STRUCTURE BERS OF EMPLOYEES/CUSTOMERS ON ACCOMPANY	ING PLAN)
NO AS APPLICANT, I UNDERST THIS APPLICATION IS SIGNATURE OF A PER THE APPLICATION FE	VALID FOR TWO(2) YEARS FROM DATE IC CERTIFICATION PLAN PRIOR TO EXPIR E IS NON-REFUNDABLE	OF FEE PAYMENT AND APPROVAL IS BASED IATION OF THIS PERMIT. LE FEES AND A SUITABLE SITE PLAN IN ORDEI	
THIS IS A PUBLIC DOC			
property or duly authoregulations. By signature of this or	orized to make this application on behalf of	ation contained herein is correct. I declare that I the owner. I agree to comply with all applicable saith Department officials the right to enter onto sted permit/service.	state and county
-		2/0	4/21
SIGNATURE OF ARR	HICANT	DATE	/~

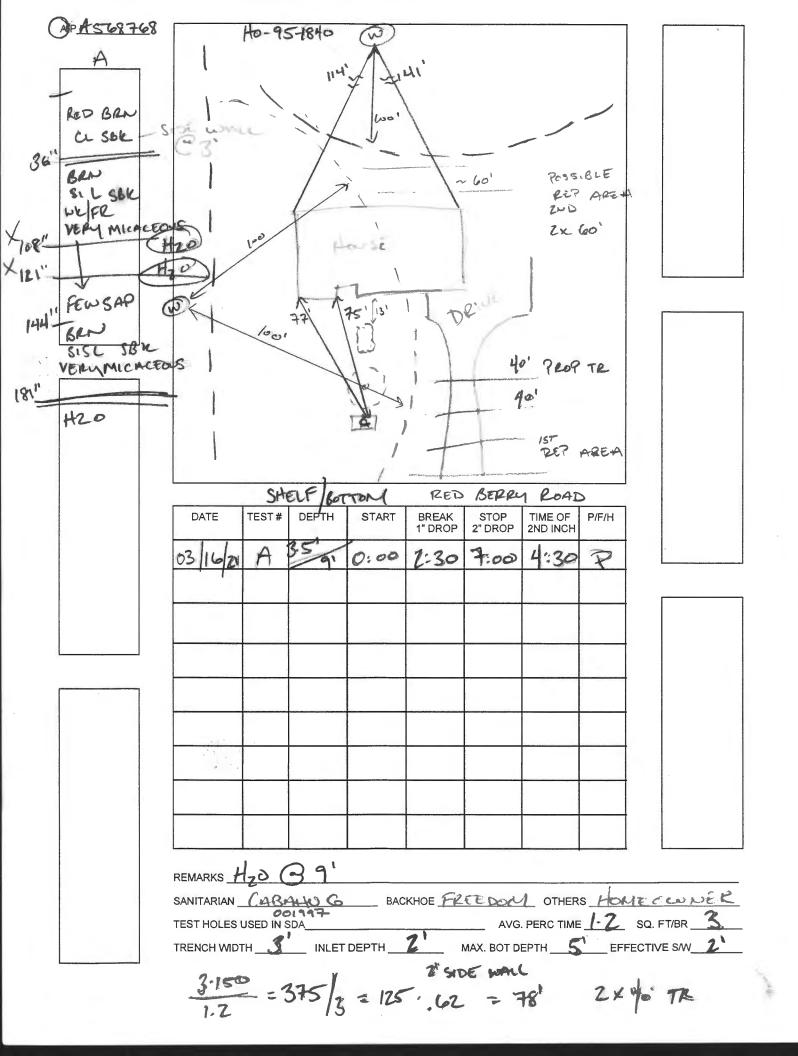

	HOWARD COUNTY HEALTH DEPARTMENT	68768
Received From	adom Soft 22421 PHONE #	10745-2941
CASH CHECK	For VIIC paper tapan	Spery Rd.
\$ 105	One hall died sinty!	Dollars