



HOWARD COUNTY HEALTH DEPARTMENT

31990

DATE
11 16 1991

115

Received
From

Foghts Well Drilling

PHONE #

410.795.5070

☐ CASH
☒ CHECK

NO. 11892

For

well permit Daywood Lot 17
Cosole Redberry Rd.

one hundred twenty



Dollars


\$

11009

Received By

H. H. M. S. A.

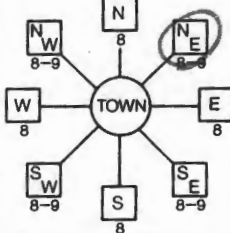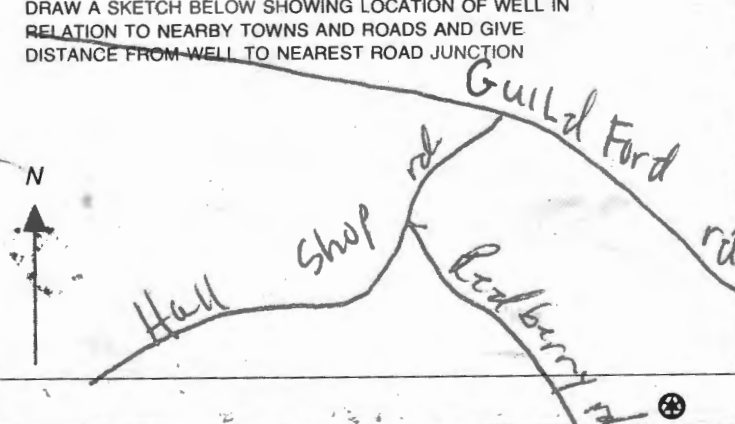B 1 1 2 3 6 9520	SEQUENCE NO. (MDE USE ONLY)	STATE OF MARYLAND APPLICATION FOR PERMIT TO DRILL WELL 531990 please type	STATE PERMIT NUMBER Ho-95-1840 fill in this form completely
Date Received (APA) 8 MM DD YY 13 LEY		B 3 OK LOCATION OF WELL 8 COUNTY Howard 21 23 SUBDIVISION Dogwood 42 SECTION 44 46 LOT 17 48 50 Highland 52 NEAREST TOWN 71	
OWNER INFORMATION 15 Last Name LEY Owner RICK First Name 34 36 6806 Redberry Rd Street or RFD 55 Clarksville MD 21029 57 Town 70 State 72 Zip 76		B 4 1 2 DIRECTION OF WELL FROM TOWN (CIRCLE BOX) 	
DRILLER INFORMATION Driller's Name Allen Compton 76 License No. MSD009 81 Firm Name Fogles Well Drilling Address 6003 Woodbine Rd Signature Allen Compton Date 10-5-09		11 NEAR WHAT ROAD 6806 Redberry Rd 30 ON WHICH SIDE OF ROAD (CIRCLE APPROPRIATE BOX) NORTH <input type="checkbox"/> WEST <input checked="" type="checkbox"/> EAST <input type="checkbox"/> SOUTH <input type="checkbox"/> 34 100 37 DISTANCE FROM ROAD ENTER FT OR MI 38 39 TAX MAP: _____ BLK: _____ PARCEL _____	
B 2 1 2 WELL INFORMATION APPROX. PUMPING RATE 5 (GAL. PER MIN.) 8 500 12 AVERAGE DAILY QUANTITY NEEDED 14 20 (GAL. PER DAY)		NOT TO BE FILLED IN BY DRILLER HEALTH DEPARTMENT APPROVAL Howard (13) A 00786 COUNTY NAME COUNTY NO. STATE SIGNATURE _____ INSERT S → 41 DATE ISSUED 11/16/09 43 MM DD YY 48 CO SIGNATURE John Wall EXP. DATE 11/16/10 NORTH GRID 491 000 55 EAST GRID 0820 000 63 50 57 63	
USE FOR WATER (CIRCLE APPROPRIATE BOX) <input checked="" type="radio"/> DOMESTIC POTABLE SUPPLY & RESIDENTIAL IRRIGATION <input type="radio"/> FARMING (LIVESTOCK WATERING & AGRICULTURAL IRRIGATION) 22 <input type="radio"/> INDUSTRIAL, COMMERCIAL, DEWATERING <input type="radio"/> PUBLIC WATER SUPPLY WELL <input type="radio"/> TEST, OBSERVATION, MONITORING <input type="radio"/> GEO-THERMAL		APPROXIMATE DEPTH OF WELL 300 FEET 24 28 APPROXIMATE DIAMETER OF WELL 6 INCH NEAREST	
METHOD OF DRILLING (circle one) BORED (or Augered) <input checked="" type="radio"/> JETTED <input type="radio"/> Jetted & DRIVEN <input type="radio"/> 30 AIR-ROTARY AIR-PERCussion ROTARY (Hydraulic Rotary) 3 CABLE REVERSE-ROTARY DRIVE-POINT other _____		SHOW MAJOR FEATURES OF BOX & LOCATE WELL WITH AN X SOURCES OF DRILLING WATER 1. 2. 3. WRITE THE BOX NUMBER FROM THE MAP HERE E 820 N 4901 000 000	
REPLACEMENT OR DEEPEMED WELLS (CIRCLE APPROPRIATE BOX) <input type="radio"/> THIS WELL WILL NOT REPLACE AN EXISTING WELL <input checked="" type="radio"/> THIS WELL WILL REPLACE A WELL THAT WILL BE ABANDONED AND SEALED 39 <input type="radio"/> THIS WELL WILL REPLACE A WELL THAT WILL BE USED AS A STANDBY-CONTACT LOCAL APPROVING AUTHORITY FOR POLICY ON STANDBY WELLS <input type="radio"/> THIS WELL WILL DEEPEN AN EXISTING WELL PERMIT NUMBER OF WELL TO BE REPLACED OR DEEPEMED (IF AVAILABLE) 41 _____ 52		DRAW A SKETCH BELOW SHOWING LOCATION OF WELL IN RELATION TO NEARBY TOWNS AND ROADS AND GIVE DISTANCE FROM WELL TO NEAREST ROAD JUNCTION 	
Not to be filled in by driller (MDE OR COUNTY USE ONLY) APPROX. PERMIT NUMBER _____ G _____ PERMIT No. Ho-95-1840 70 71 72 73 74 75 76 77 78 79			
SPECIAL CONDITIONS NOTE - APPROVING AUTHORITIES SHOULD USE SEPARATE SHEET IF NEEDED			

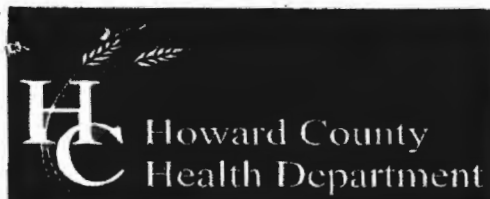

Bureau of Environmental Health
7178 Columbia Gateway Drive, Columbia, MD 21046-2147
(410) 313-2640 Fax (410) 313-2648
TDD (410) 313-2323 Toll Free 1-866-313-6300
website: www.hchealth.org

Peter L. Beilenson, M.D., M.P.H., Health Officer

TO ALL INTERESTED PARTIES

When submitting a well permit application for a proposed well for new construction, please indicate one of the following:

Well Site Location:

Dogwood 17 6806 Redberry rd
Subdivision/Property Name Lot# Road Name

☐ The well site has been staked by _____,
(professional land surveyor or company employing professional land surveyors)
on _____ (date) and does not require a site inspection.

☒ The well driller, builder or property owner will call the Health
Department to schedule a time to meet in the field to verify the
proposed well site location.

This sheet, along with two copies of an acceptable well site plan, must be attached to the green well permit application.

Revised 3/11/05


FILE INQUIRY NOTES

DATE	RESULTS OF REVIEW FOR FILE
11/12/05	met w/ well Driller on-site. (See attached site plan view w/ adjacent well's and neighboring septic) Could not pick loc. @ this time. (KW)
11/16/09	After review further review and some research, met w/ Driller on-site again to discuss possible location to back left of lot. (see attached site plan). This loc is approved to drill well. well is 200' diameter of neighboring septic, and 100' from a possible reserve well for 6810 Red berry. (KW) Also discussed in off re use to allow homeowner to drill well east front of house and pit septic in back yard. (KW)
1/4/10	Pitless adapter inspected. Tag attached to well looks good. GROUT exceptional. (see completion report) (KW)

* Keep this with File *

Health Department Copy

-76°55'35"

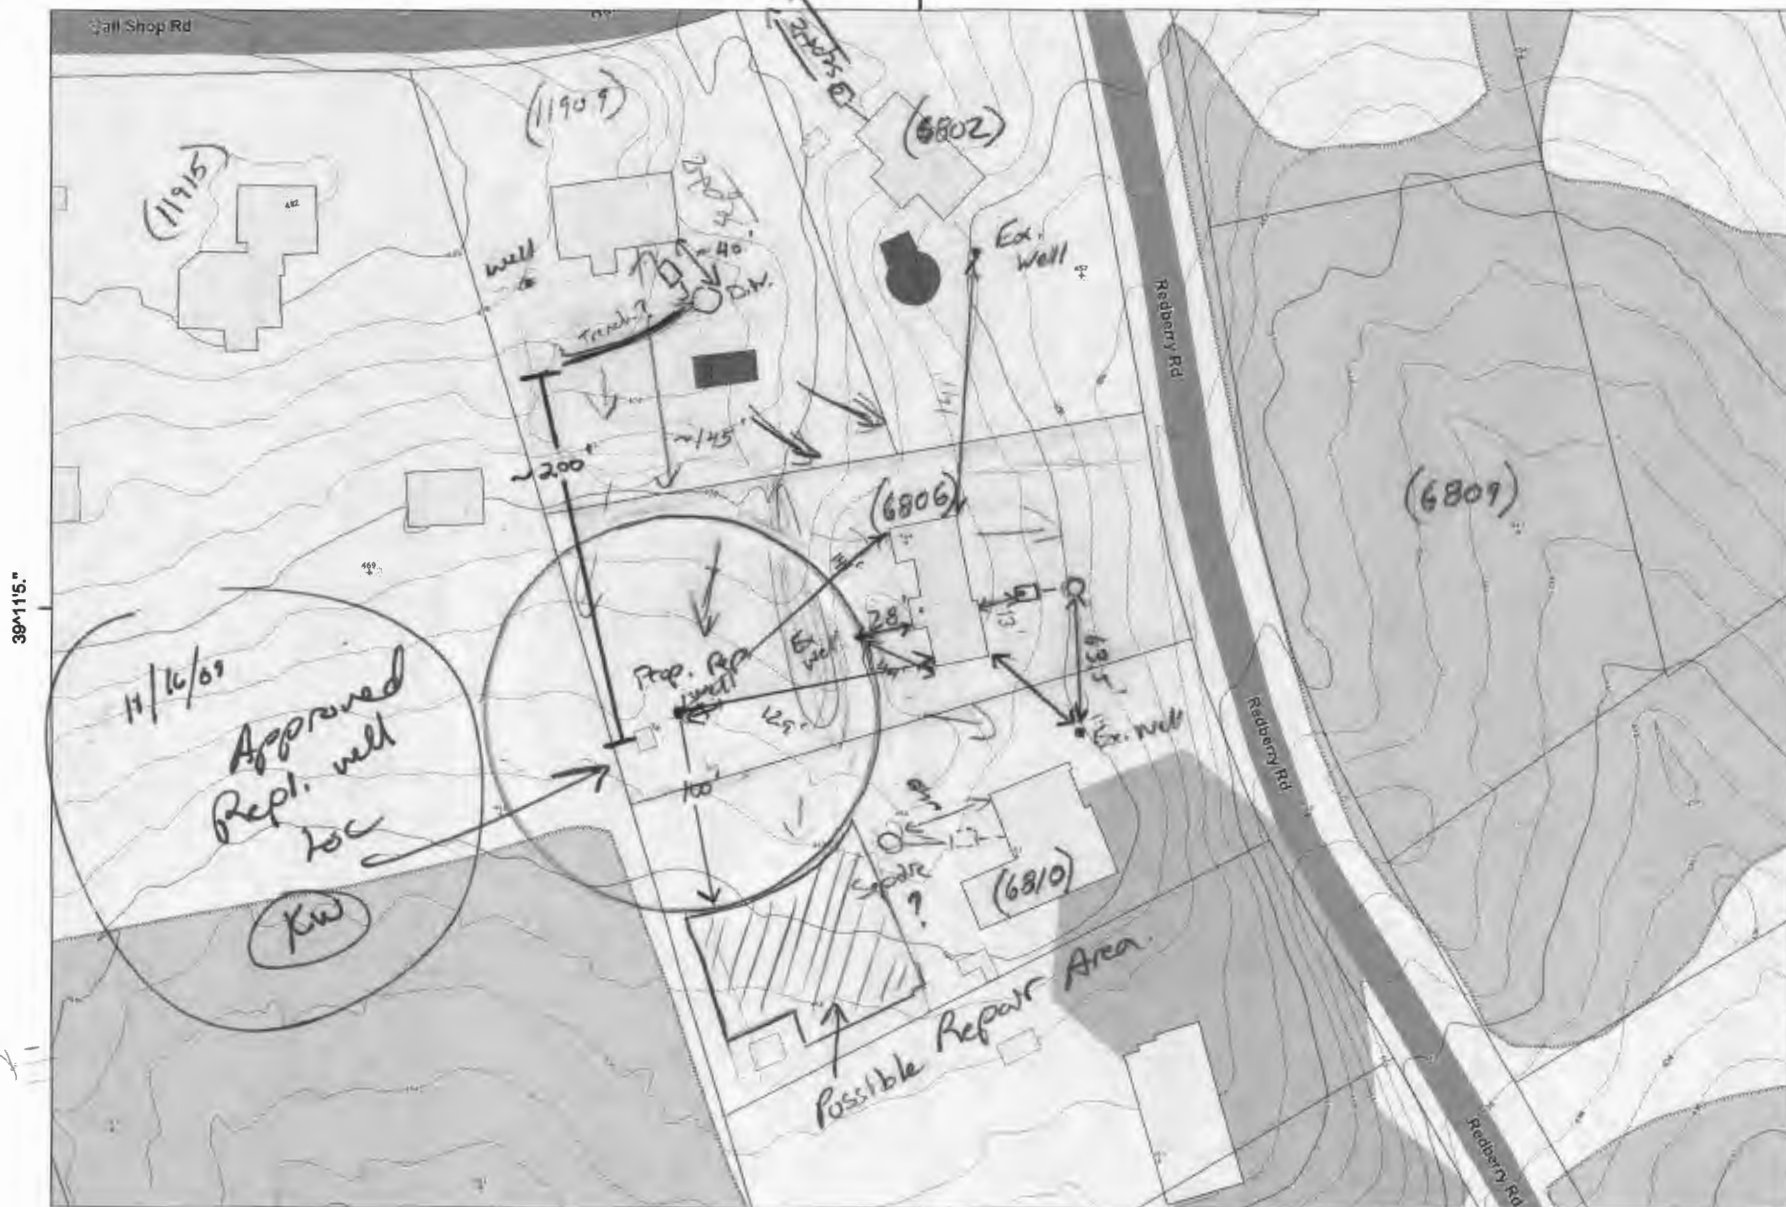

Disclaimer: Howard County, Maryland assumes no responsibility for the accuracy of this report or the information contained herein or derived therefrom. The user assumes all risks and liabilities whatsoever resulting from or arising out of the use of this information. There are no oral agreements or warranties relating to the use of this report.

-76°55'35"

Howard County

Howard County
M A R Y L A N D

By:
Office:
Map Width: 910.00 ft.
Print Date: 11/10/2009
Scale: 1 in. = 100 ft.