

DEPARTMENT OF INSPECTIONS, LICENSES AND PERMITS 3430 COURT HOUSE DRIVE ELLCOTT CITY, MD 21043 PERMITS (410) 313-2455 INSPECTIONS (410) 313-1810 AUTOMATED INFORMATION (410) 313-3800		HOWARD COUNTY PERMIT APPLICATION	PERMIT NUMBER B07002828
Building Address <u>15166 SApLInG RIDge DR.</u> <u>DAYTON, MD 21036</u>		Property Owner's Name <u>DeBNAM, DWAYNE E CANA</u>	
Suite/Apt. #: _____ SDP/WP/Petition #: _____		Address <u>15166 SApLInG RIDge DR.</u>	
Census Tract _____ Subdivision <u>High FronteST</u>		City <u>DAYTON</u> State <u>MD</u> Zip Code <u>21036</u>	
Section _____ Area _____ Lot <u>33</u>		Home Phone <u>410-531-7872</u> Work Phone <u>410-215-6130</u>	
Tax Map <u>27</u> Parcel <u>147</u> Grid <u>11</u>		Applicant's Name & Mailing Address, (if other than stated hereon): <u>Vicky Meyer</u>	
Zoning _____ Map Coordinates _____ Lot size <u>1.02Ac</u>		Phone <u>410-296-6900</u> Fax _____	
Existing Use <u>Single FAM. DWELLInG w/Deck</u>		Contractor Company <u>MORRIS Remodeling</u>	
Proposed Use <u>Screen-IN existing Deck</u>		Contact Person <u>SHMON or Vicky Meyer</u>	
Estimated Construction Cost \$ <u>7,000</u>		Address <u>69 MAIN St. 2nd Fl.</u>	
Description of Work <u>to screen enclose existing Deck (size 20x12 w D)</u>		City <u>Reisterstown</u> State <u>MD</u> Zip Code <u>21136</u>	
Occupant or Tenant _____		License No. <u>1913</u>	
Contact Name _____		Phone <u>410-356-2525</u> Fax _____	
Address _____		Engineer or Architect Company _____	
City _____ State _____ Zip Code _____		Contact Person _____	
Phone _____ Fax _____		Address _____	
		City _____ State _____ Zip Code _____	
		Phone _____ Fax _____	

BUILDING DESCRIPTION - <u>COMMERCIAL</u>		BUILDING DESCRIPTION - <u>RESIDENTIAL</u>	
Building Characteristics	Utilities	Building Characteristics	Utilities
Height: _____	Water Supply: _____	SF Dwelling ☒ SF Townhouse ☐	Water Supply: _____
No. of stories: _____	Public ☐ Private ☐	Depth _____ Width _____	Public ☐ Private ☒
Gross area, sq. ft. per floor: _____	Sewage Disposal: _____	1st floor: _____	Sewage Disposal: _____
Use group: _____	Public ☐ Private ☐	2nd floor: _____	Public ☐ Private ☒
Construction type: _____	Electric Yes ☐ No ☐	Basement: _____	Electric Yes ☐ No ☐
Reinforced Concrete ☐	Gas Yes ☐ No ☐	Finished Basement ☐ Unfinished Basement ☐	Gas Yes ☐ No ☐
Structural Steel ☐	Heating System: _____	Crawl space ☐ Slab on Grade ☐	Heating System: _____
Masonry ☐	Electric ☐ Oil ☐	No. of Bedrooms _____	Electric ☐ Oil ☐
Wood Frame ☐	Natural Gas ☐	Height: _____	Natural Gas ☐
State Certified Modular ☐	Propane Gas ☐	Multi-family dwellings: _____	Propane Gas ☐
	Sprinkler system: N/A ☐	No. of efficiency units: _____	Sprinkler system: N/A ☐
	Full ☐	No. of 1 BR units: _____	NFPA #13D ☐
	Partial ☐	No. of 2 BR units: _____	NFPA #13R ☐
	Other Suppression ☐	No. of 3 BR units: _____	Other: _____
	# of Heads _____	Other Structure: _____	
		Dimensions: _____	
		Footings: _____	
		Roof Height: _____	
		State Certified Modular ☐	
		Manufactured Home ☐	

THE UNDERSIGNED HEREBY CERTIFIES AND AGREES AS FOLLOWS: (1) THAT HE/SHE IS AUTHORIZED TO MAKE THIS APPLICATION; (2) THAT THE INFORMATION IS CORRECT; (3) THAT HE/SHE WILL COMPLY WITH ALL REGULATIONS OF HOWARD COUNTY WHICH ARE APPLICABLE THERETO; (4) THAT HE/SHE WILL PERFORM NO WORK ON THE ABOVE REFERENCED PROPERTY NOT SPECIFICALLY DESCRIBED IN THIS APPLICATION; (5) THAT HE/SHE GRANTS COUNTY OFFICIALS THE RIGHT TO ENTER ONTO THIS PROPERTY FOR THE PURPOSE OF INSPECTING THE WORK PERMITTED AND POSTING NOTICES.

Applicant's Signature V. Meyer Print Name Vicky Meyer
Title/Company Agent Date 7/5/02

Checks payable to: **DIRECTOR OF FINANCE OF HOWARD COUNTY**
** PLEASE WRITE NEATLY AND LEGIBLY. **
- FOR OFFICE USE ONLY -

AGENCY	DATE	SIGNATURE APPROVAL	DPZ SETBACK INFORMATION	PROPERTY ID#:
Land Development, DPZ			Front: _____	Filing fee \$ _____
State Highways			Rear: _____	Permit fee \$ _____
Building Official			Side: _____	Excise tax \$ _____
Dev. Engineering, DPZ			Side St.: _____	Add'l per. fee \$ _____
Health <u>7/5/2007</u>		<u>Salina A. G.</u>	All minimum setbacks met?	TOTAL FEES \$ _____
Fire Protection			YES ☐ NO ☐	Sub-total paid \$ _____
Is Sediment Control approval required prior to issuance?			Is Entrance Permit required?	Balance due \$ _____
YES ☐ NO ☐			YES ☐ NO ☐	Check # _____
CONTINGENCY CONSTRUCTION START: ☐			Historic District?	Validation # _____
ONE STOP SHOP: ☐			YES ☐ NO ☐	
			Lot Coverage for NewTown Zone _____	
			SDP/Red-line approval date _____	Accepted by _____

HOWARD COUNTY
PERMIT APPLICATION

PERMIT NUMBER

PO0147520

Building Address 15146 Sapling Ridge Rd
Dayton MD 21036

Suite/Apt. #: _____ SDP/WP/Petition #: _____

Census Tract _____ Subdivision High Forest Estates

Section _____ Area _____ Lot 33

Tax Map 27 Parcel 147 Grid 11

Zoning REYES Map Coordinates _____ Lot size 1.02 Ac

Existing Use SRD

Proposed Use SRD w/porch & fence

Estimated Construction Cost \$ 20,000

Description of Work Construct 4'x2' = 1400 sq ft porch
porch w/500 sq ft 3'-6" deep cantilever killed by truck
accident by 2006 1.6 of accident

Occupant or Tenant Owner

Contact Name Dana Krawczyk

Address _____

City _____ State _____ Zip Code _____

Phone _____ Fax _____

Property Owner's Name Dan & Carla Debnar

Address 15146 Sapling Ridge Rd

City Dayton State MD Zip Code 21036

Home Phone _____ Work Phone _____

Applicant's Name & Mailing Address, (if other than stated herein):

Dana Krawczyk
9515 Greenway Lane #119
Columbia MD 21046

Phone 410 995 7610 Fax _____

Contractor Company Maryland Pools

Contact Person Dana Krawczyk

Address 9515 Greenway Lane #119

City Columbia State MD Zip Code 21046

License No. 66696

Phone 410 995 7610 Fax _____

Engineer or Architect Company _____

Contact Person _____

Address _____

City _____ State _____ Zip Code _____

Phone _____ Fax _____

BUILDING DESCRIPTION - COMMERCIAL

Building Characteristics

Height: _____

No. of stories: _____

Gross area, sq. ft. per floor: _____

Use group: _____

Construction type:

☐ Reinforced Concrete

☐ Structural Steel

☐ Masonry

☐ Wood Frame

☐ State Certified Modular

Utilities

Water Supply:

☐ Public

☐ Private

Sewage Disposal:

☐ Public

☐ Private

Electric Yes ☐ No ☐

Gas Yes ☐ No ☐

Heating System:

Electric ☐ Oil ☐

Natural Gas ☐

Propane Gas ☐

Sprinkler system: N/A ☐

☐ Full

☐ Partial

☐ Other Suppression

☐ # of Heads

BUILDING DESCRIPTION - RESIDENTIAL

Building Characteristics

SF Dwelling ☒ SF Townhouse ☐

Depth Width

1st floor: _____

2nd floor: _____

Basement:

Finished Basement ☐ Unfinished Basement ☐

Crawl space ☐ Slab on Grade ☐

No. of Bedrooms: _____

Multi-family dwellings:

No. of efficiency units: _____

No. of 1 BR units: _____

No. of 2 BR units: _____

No. of 3 BR units: _____

Other Structure: _____

Dimensions: _____

Footings: _____

Roof: _____

☐ State Certified Modular

☐ Manufactured Home

Utilities

Water Supply:

☐ Public

☒ Private

Sewage Disposal:

☐ Public

☒ Private

Electric Yes ☐ No ☐

Gas Yes ☐ No ☐

Heating System:

Electric ☐ Oil ☐

Natural Gas ☐

Propane Gas ☐

Sprinkler system: N/A ☐

☐ NFPA #13D

☐ NFPA #13R

☐ Other:

THE UNDERSIGNED HEREBY CERTIFIES AND AGREES AS FOLLOWS: (1) THAT HE/SHE IS AUTHORIZED TO MAKE THIS APPLICATION; (2) THAT THE INFORMATION IS CORRECT; (3) THAT HE/SHE WILL COMPLY WITH ALL REGULATIONS OF HOWARD COUNTY WHICH ARE APPLICABLE THERETO; (4) THAT HE/SHE WILL PERFORM NO WORK ON THE ABOVE REFERENCED PROPERTY NOT SPECIFICALLY DESCRIBED IN THIS APPLICATION; (5) THAT HE/SHE GRANTS COUNTY OFFICIALS THE RIGHT TO ENTER ONTO THIS PROPERTY FOR THE PURPOSE OF INSPECTING THE WORK PERMITTED AND POSTING NOTICES.

Dana Krawczyk
Applicant's Signature

Account Mgr
Title/Company

Dana Krawczyk
Print Name

4/8/04
Date

Checks payable to: DIRECTOR OF FINANCE OF HOWARD COUNTY

** PLEASE WRITE NEATLY AND LEGIBLY **

FOR OFFICE USE ONLY

AGENCY

DATE

SIGNATURE APPROVAL


DPZ SETBACK INFORMATION

PROPERTY ID# 52911

SETBACKS:

REAR PL. 10'
SIDE PL. 10'
HOUSE N/A
SEPTIC 20'
WELL 30'

SAPLING RIDGE DRIVE

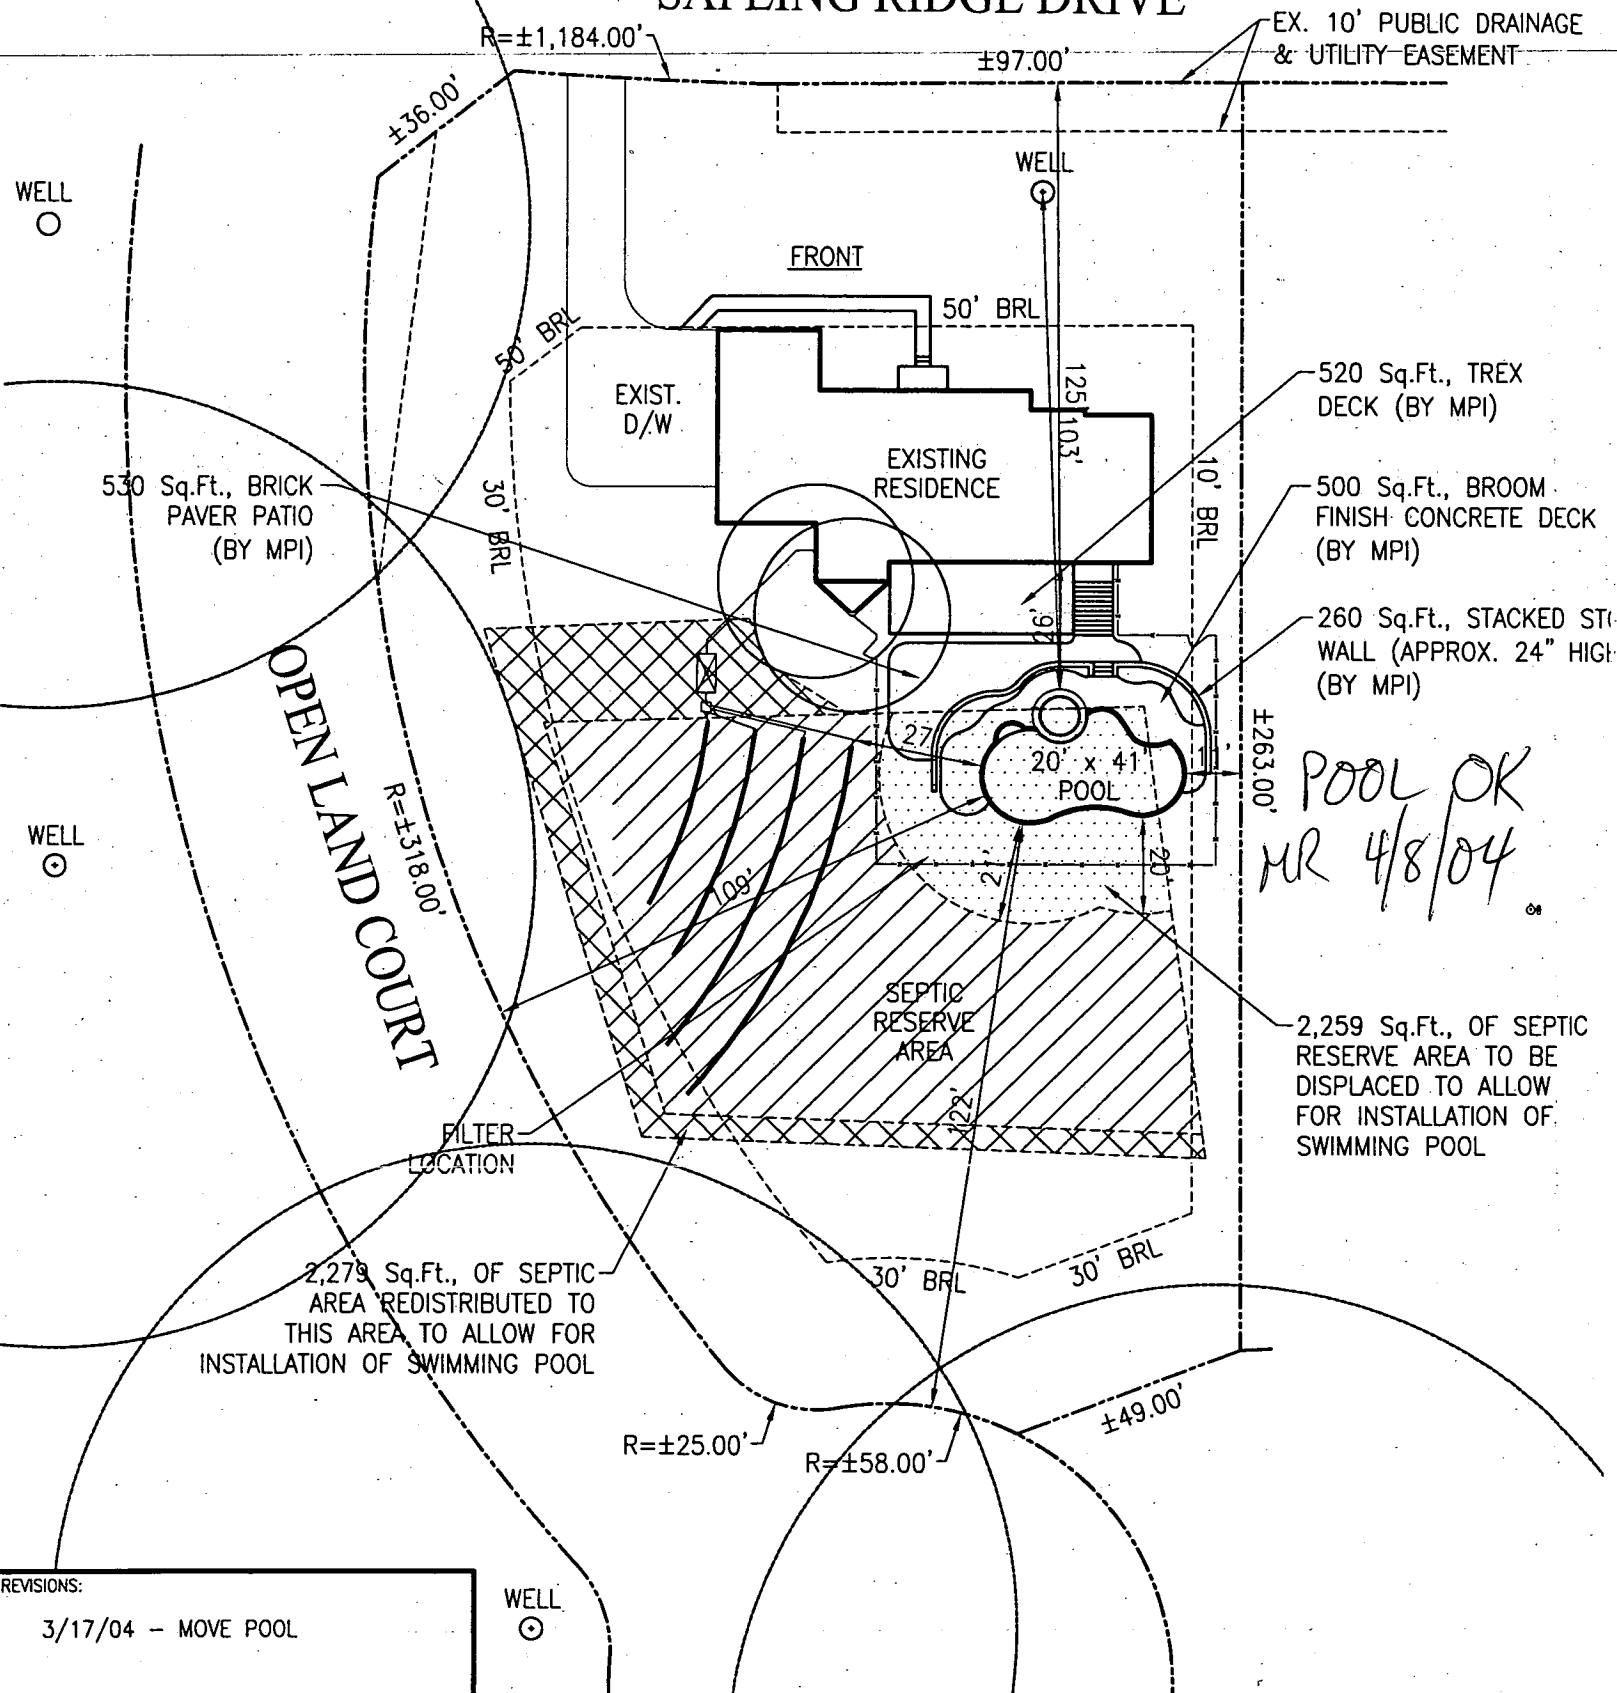

*POOL OK
MR 4/8/04*

REVISIONS:

3/17/04 - MOVE POOL