

RECORDED

APPLICATION

A 23229

5/20/76 av 955
9:30

26157

SEWAGE DISPOSAL TESTING

P _____

STATE OF MARYLAND - DEPARTMENT OF HEALTH AND MENTAL HYGIENE

HOWARD COUNTY HEALTH DEPARTMENT
ENVIRONMENTAL HEALTH SERVICES
P. O. BOX 476, ELLICOTT CITY, MARYLAND 21043
TELEPHONE: 465-5000, EXT. 356

DISTRICT 6th

DATE 5/6/76

*Property now connected
to public sewer*

TO: THE COUNTY HEALTH OFFICER
ELLICOTT CITY, MARYLAND

I, HEREBY, APPLY FOR THE NECESSARY TEST IN ORDER TO CONSTRUCT (OR RECONSTRUCT) A SEWAGE DISPOSAL SYSTEM.

PROPERTY OWNER WARREN K, MONTOURI

ADDRESS c/o Century 21 - H. T. Brown Real Estate
229 Washington Blvd., Laurel, Md. 20810 PHONE 725-8888

PROPERTY LOCATION: HYDROTECH TRANSMISSIONS
SUBDIVISION 11011 Scaggsville Road, Laurel, Md. LOT NO. None

ROAD AND DESCRIPTION 11011 Scaggsville Road, Laurel, Md. 4/10 mile

from intersection of Rt 29 on Right

SIZE OF LOT 3+ acres TYPE BLDG. Existing House
2 BR Single fam. home
NUMBER OF BEDROOMS

IF NOT SINGLE RESIDENCE DESCRIBE _____

THE SYSTEM INSTALLED UNDER THIS APPLICATION IS ACCEPTABLE ONLY UNTIL PUBLIC FACILITIES BECOME AVAILABLE.

SIGNATURE OF APPLICANT [Signature]
H. T. Brown - Agent for Warren K, Montouri

APPROVED BY _____ FOR _____ DATE _____
(KIND OF SYSTEM)


REJECTED BY _____ FOR _____ DATE _____
(KIND OF SYSTEM)

HOLD PENDING FURTHER TESTS 1 DATE _____

REASONS FOR REJECTION OR HOLDING _____

THE SYSTEM UNDER THIS PERMIT
IS ACCEPTABLE ONLY UNTIL
PUBLIC FACILITIES BECOME AVAILABLE

THIS IS NOT A PERMIT

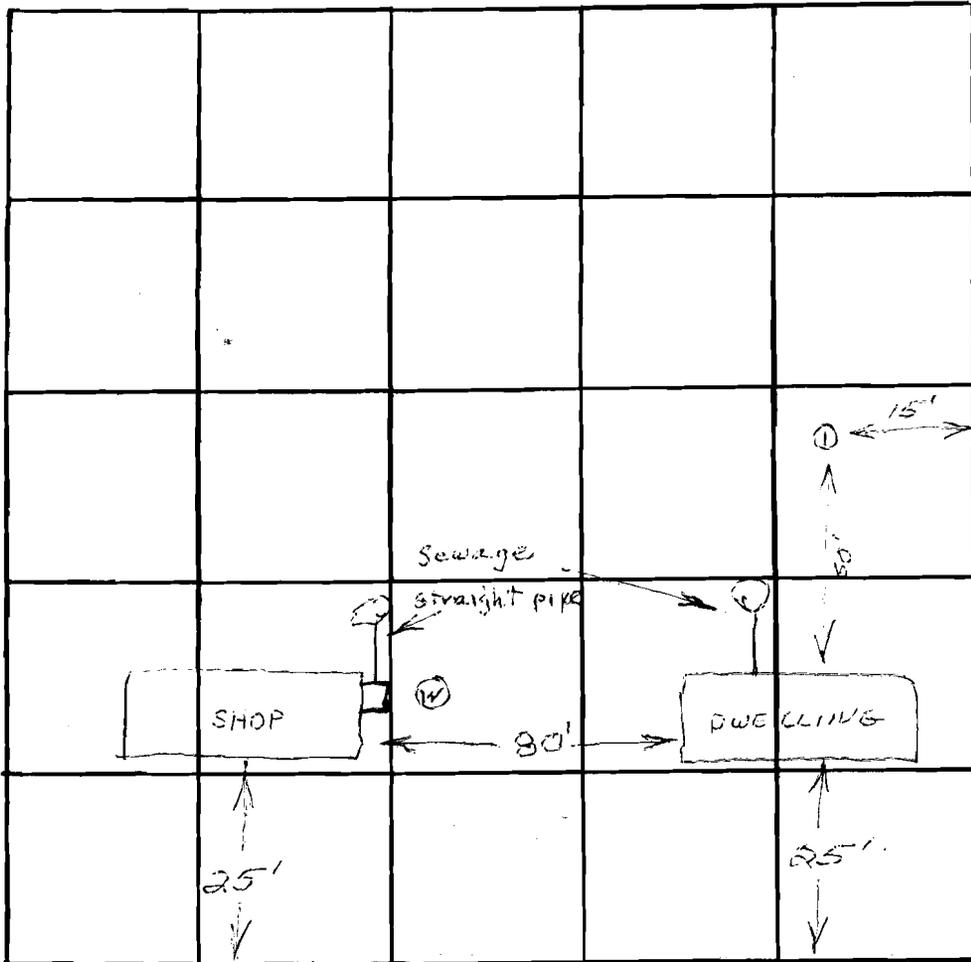

City sewer under construction 5/10 mile

INDICATE NORTH. - NAME ADJOINING ROADWAY AS BASE LINE.

Route 216

1/10 mile to Rt. 29

DATE	TEST NO.	DEPTH	PRE-WET		TEST - 1" DROP		TIME
			START	STOP	START	STOP	
5/20/76	1	13	Top 4 ft.	clay			
			Bottom 9 ft	sandy			

10 AM.
REMARKS 5-20-76 Prev. cancelled by H.T. Brown - R. Ho

TYPE OF SOIL _____

TESTED BY _____ ALSO PRESENT: _____

RECORDED

APPLICATION

A 23229

P _____

SEWAGE DISPOSAL TESTING

STATE OF MARYLAND - DEPARTMENT OF HEALTH AND MENTAL HYGIENE

HOWARD COUNTY HEALTH DEPARTMENT
ENVIRONMENTAL HEALTH SERVICES
P. O. BOX 476, ELLICOTT CITY, MARYLAND 21043
TELEPHONE: 465-5000, EXT. 356

DISTRICT 6th

DATE 5/6/76

TO: THE COUNTY HEALTH OFFICER
ELLICOTT CITY, MARYLAND

I, HEREBY, APPLY FOR THE NECESSARY TEST IN ORDER TO CONSTRUCT (OR RECONSTRUCT) A SEWAGE DISPOSAL SYSTEM.

PROPERTY OWNER WARREN K, MONTOURI

ADDRESS c/o Century 21 - H. T. Brown Real Estate
229 Washington Blvd., Laurel, Md. 20810 PHONE 725-8888

PROPERTY LOCATION:


SUBDIVISION 11011 Scaggsville Road, Laurel, Md. LOT NO. None

ROAD AND DESCRIPTION 11011 Scaggsville Road, Laurel, Md.

SIZE OF LOT 3+ acres TYPE BLDG. Existing house
2 BR Single fam. hc
NUMBER OF BEDROOMS _____

IF NOT SINGLE RESIDENCE DESCRIBE _____

THE SYSTEM INSTALLED UNDER THIS APPLICATION IS ACCEPTABLE ONLY UNTIL PUBLIC FACILITIES BECOME AVAILABLE.

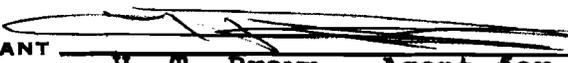SIGNATURE OF APPLICANT 
H. T. Brown - Agent for Warren K, Montouri


APPROVED BY _____ FOR _____ DATE _____
(KIND OF SYSTEM)

REJECTED BY _____ FOR _____ DATE _____
(KIND OF SYSTEM)

HOLD PENDING FURTHER TESTS _____ DATE _____

REASONS FOR REJECTION OR HOLDING _____

THIS IS NOT A PERMIT

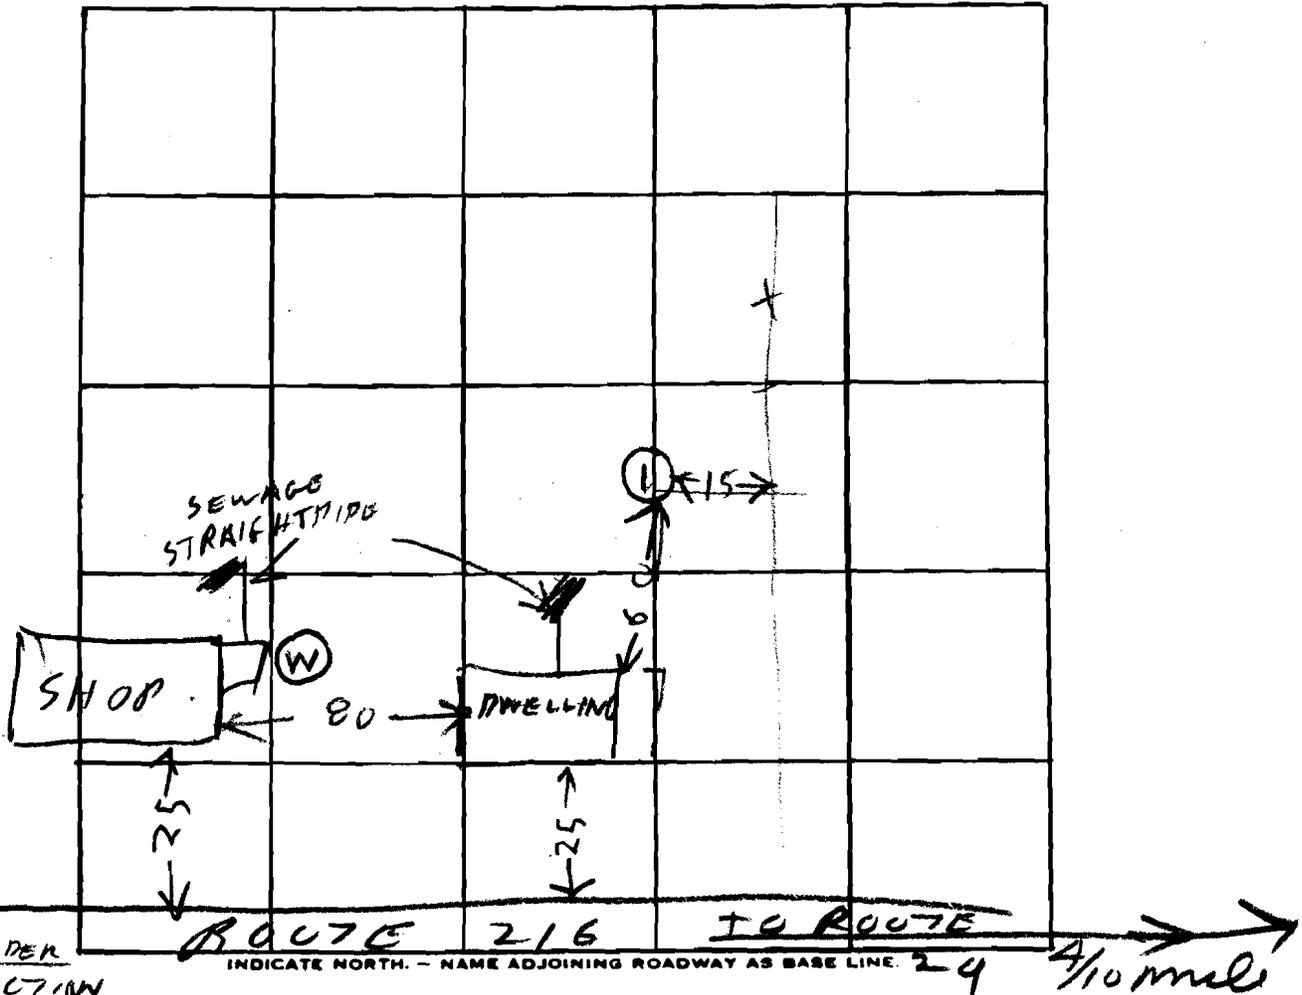

CITY SEWER UNDER CONSTRUCTION
5/10 MILES

INDICATE NORTH. - NAME ADJOINING ROADWAY AS BASE LINE. 24 1/10 mile

DATE	TEST NO.	DEPTH	PRE-WET		TEST - 1" DROP		TIME
			START	STOP	START	STOP	
5/1/76	1	13	TOP BOT	4 FT 9 FT	CLAY SANDY		

1006AM
REMARKS 5/19/76 - PERC CANCELLED BY H7 BROWN RH

TYPE OF SOIL _____
TESTED BY BH ALSO PRESENT: H7 BROWN