

DEPARTMENT OF INSPECTIONS, LICENSES AND PERMITS 3430 COURT HOUSE DRIVE ELLCITY CITY, MD 21043 PERMITS (410) 313-2155 INSPECTIONS (410) 313-1810 AUTOMATED INFORMATION (410) 313-3800		HOWARD COUNTY PERMIT APPLICATION		PERMIT NUMBER B08000399	
Building Address <u>11218 SCODGESSVILLE ROAD</u> <u>01</u> <u>11226</u>				Property Owner's Name <u>MD SHA</u>	
Suite/Apt. #: <u>N/A</u> SDP/WP/Petition #: <u>N/A</u>				Address <u>511 Buckleys Town Pike</u>	
Census Tract <u>605/02</u> Subdivision <u>N/A</u>				City <u>Frederick</u> State <u>MD</u> Zip Code <u>21704</u>	
Section <u>N/A</u> Area <u>N/A</u> Lot <u>N/A</u>				Home Phone _____ Work Phone <u>301-624-4100</u>	
Tax Map <u>46</u> Parcel <u>288</u> Grid <u>4</u>				Applicant's Name & Mailing Address, (if other than stated hereon): <u>John Meidunas Kibler, Construction, Inc</u>	
Zoning <u>N/A</u> Map Coordinates _____ Lot size <u>N/A</u>				Phone <u>410-833-5345</u> Fax <u>410-833-1732</u>	
Existing Use <u>Vacant space</u>				Contractor Company <u>Kibler Construction</u>	
Proposed Use <u>Turnkey office trailer</u>				Contact Person <u>John Meidunas</u>	
Estimated Construction Cost \$ <u>125,000</u>				Address <u>3332 Baltimore Blvd</u>	
Description of Work <u>Turnkey office trailer</u> <u>from pole to trailer</u> <u>40' x 60' SELF contained</u>				City <u>Finksburg</u> State <u>MD</u> Zip Code <u>21044</u>	
Occupant or Tenant <u>Kibler Construction</u>				License No. _____	
Contact Name <u>John Meidunas</u>				Phone <u>410-833-5345</u> Fax <u>410-833-1732</u>	
Address <u>3332 Baltimore Blvd</u>				Engineer or Architect Company <u>N/A</u>	
City <u>Finksburg</u> State <u>MD</u> Zip Code <u>21044</u>				Contact Person _____	
Phone <u>410-833-5345</u> Fax <u>410-833-1732</u>				Address _____	
				City _____ State _____ Zip Code _____	
				Phone _____ Fax _____	

BUILDING DESCRIPTION - <u>COMMERCIAL</u>		BUILDING DESCRIPTION - <u>RESIDENTIAL</u>	
<b>Building Characteristics</b>	<b>Utilities</b>	<b>Building Characteristics</b>	<b>Utilities</b>
Height: <u>8'</u>	Water Supply: <input type="checkbox"/> Public <u>Bath</u> <input type="checkbox"/> Private	SF Dwelling <input type="checkbox"/> SF Townhouse <input type="checkbox"/> Depth _____ Width _____	Water Supply: <input type="checkbox"/> Public <input type="checkbox"/> Private
No. of stories: <u>1</u>	Sewage Disposal: <input type="checkbox"/> Public <input checked="" type="checkbox"/> Private	1st floor: 2nd floor: Basement:	Sewage Disposal: <input type="checkbox"/> Public <input type="checkbox"/> Private
Gross area, sq. ft. per floor: <u>400</u>	Electric Yes <input checked="" type="checkbox"/> No <input type="checkbox"/> Gas Yes <input type="checkbox"/> No <input checked="" type="checkbox"/>	Finished Basement <input type="checkbox"/> Unfinished Basement <input type="checkbox"/> Crawl space <input type="checkbox"/> Slab on Grade <input type="checkbox"/> No. of Bedrooms _____ Height: _____	Electric Yes <input type="checkbox"/> No <input type="checkbox"/> Gas Yes <input type="checkbox"/> No <input type="checkbox"/>
Use group: <u>Turnkey office trailer</u>	Heating System: Electric <input checked="" type="checkbox"/> Oil <input type="checkbox"/> Natural Gas <input type="checkbox"/> Propane Gas <input type="checkbox"/>	Multi-family dwellings: No. of efficiency units: _____ No. of 1 BR units: _____ No. of 2 BR units: _____ No. of 3 BR units: _____	Heating System: Electric <input type="checkbox"/> Oil <input type="checkbox"/> Natural Gas <input type="checkbox"/> Propane Gas <input type="checkbox"/>
Construction type: <input type="checkbox"/> Reinforced Concrete <input type="checkbox"/> Structural Steel <input type="checkbox"/> Masonry <input type="checkbox"/> Wood Frame  <input type="checkbox"/> State Certified Modular	Sprinkler system: <u>N/A</u> <input checked="" type="checkbox"/> <input type="checkbox"/> Full <input type="checkbox"/> Partial <input type="checkbox"/> Other Suppression <input type="checkbox"/> # of Heads _____	Other Structure: _____ Dimensions: _____ Footings: _____ Roof Height: _____  <input type="checkbox"/> State Certified Modular <input type="checkbox"/> Manufactured Home	Sprinkler system: <u>N/A</u> <input type="checkbox"/> <input type="checkbox"/> NFPA #13D <input type="checkbox"/> NFPA #13R <input type="checkbox"/> Other:

THE UNDERSIGNED HEREBY CERTIFIES AND AGREES AS FOLLOWS: (1) THAT HE/SHE IS AUTHORIZED TO MAKE THIS APPLICATION; (2) THAT THE INFORMATION IS CORRECT; (3) THAT HE/SHE WILL COMPLY WITH ALL REGULATIONS OF HOWARD COUNTY WHICH ARE APPLICABLE THERETO; (4) THAT HE/SHE WILL PERFORM NO WORK ON THE ABOVE REFERENCED PROPERTY NOT SPECIFICALLY DESCRIBED IN THIS APPLICATION; (5) THAT HE/SHE GRANTS COUNTY OFFICIALS THE RIGHT TO ENTER ONTO THIS PROPERTY FOR THE PURPOSE OF INSPECTING THE WORK PERMITTED AND POSTING NOTICES.

<u>John Meidunas</u> Applicant's Signature	<u>John Meidunas</u> Print Name
<u>Kibler Construction, Inc.</u> Title/Company	<u>2/19/08</u> Date

Checks payable to: **DIRECTOR OF FINANCE OF HOWARD COUNTY**

\*\* PLEASE WRITE NEATLY AND LEGIBLY. \*\*

- FOR OFFICE USE ONLY -


AGENCY	DATE	SIGNATURE APPROVAL	DPZ SETBACK INFORMATION	PROPERTY IDE
Land Development DPZ			Front: _____	Filing fee \$ _____
State Highway			Rear: _____	Permit fee \$ <u>100.00</u>
Building Official			Side: _____	Excise tax \$ _____
Dev. Engineering DPZ			Side St: _____	Add'l per. fee \$ _____
Health	<u>2/29/08</u>	<u>John Meidunas</u>	All minimum setbacks met? YES <input type="checkbox"/> NO <input type="checkbox"/>	TOTAL FEES \$ _____
Fire Protection			Is Entrance Permit required? YES <input type="checkbox"/> NO <input type="checkbox"/>	Sub-total paid \$ _____
Is Sediment Control approval required prior to issuance? YES <input type="checkbox"/> NO <input type="checkbox"/>			Historic District? YES <input type="checkbox"/> NO <input type="checkbox"/>	Balance due \$ _____
CONTINGENCY CONSTRUCTION START: <input type="checkbox"/>			Lot Coverage for NewTown Zone _____	Check \$ <u>13.7</u>
ONE STOP SHOP: <input type="checkbox"/>			SDP/Red-line approval date _____	Validation \$ _____
Distribution of Copies: 1 - to owner/PERMIT FROM	White: Building Official	Green: LDD, DPZ	Yellow: DED, DPZ	Pink: Health
				Gold: SHA

Rev. 11/4/04



Address MD-216  
MD

Get Google Maps on your phone  
Text the word "GMAPS" to 466453

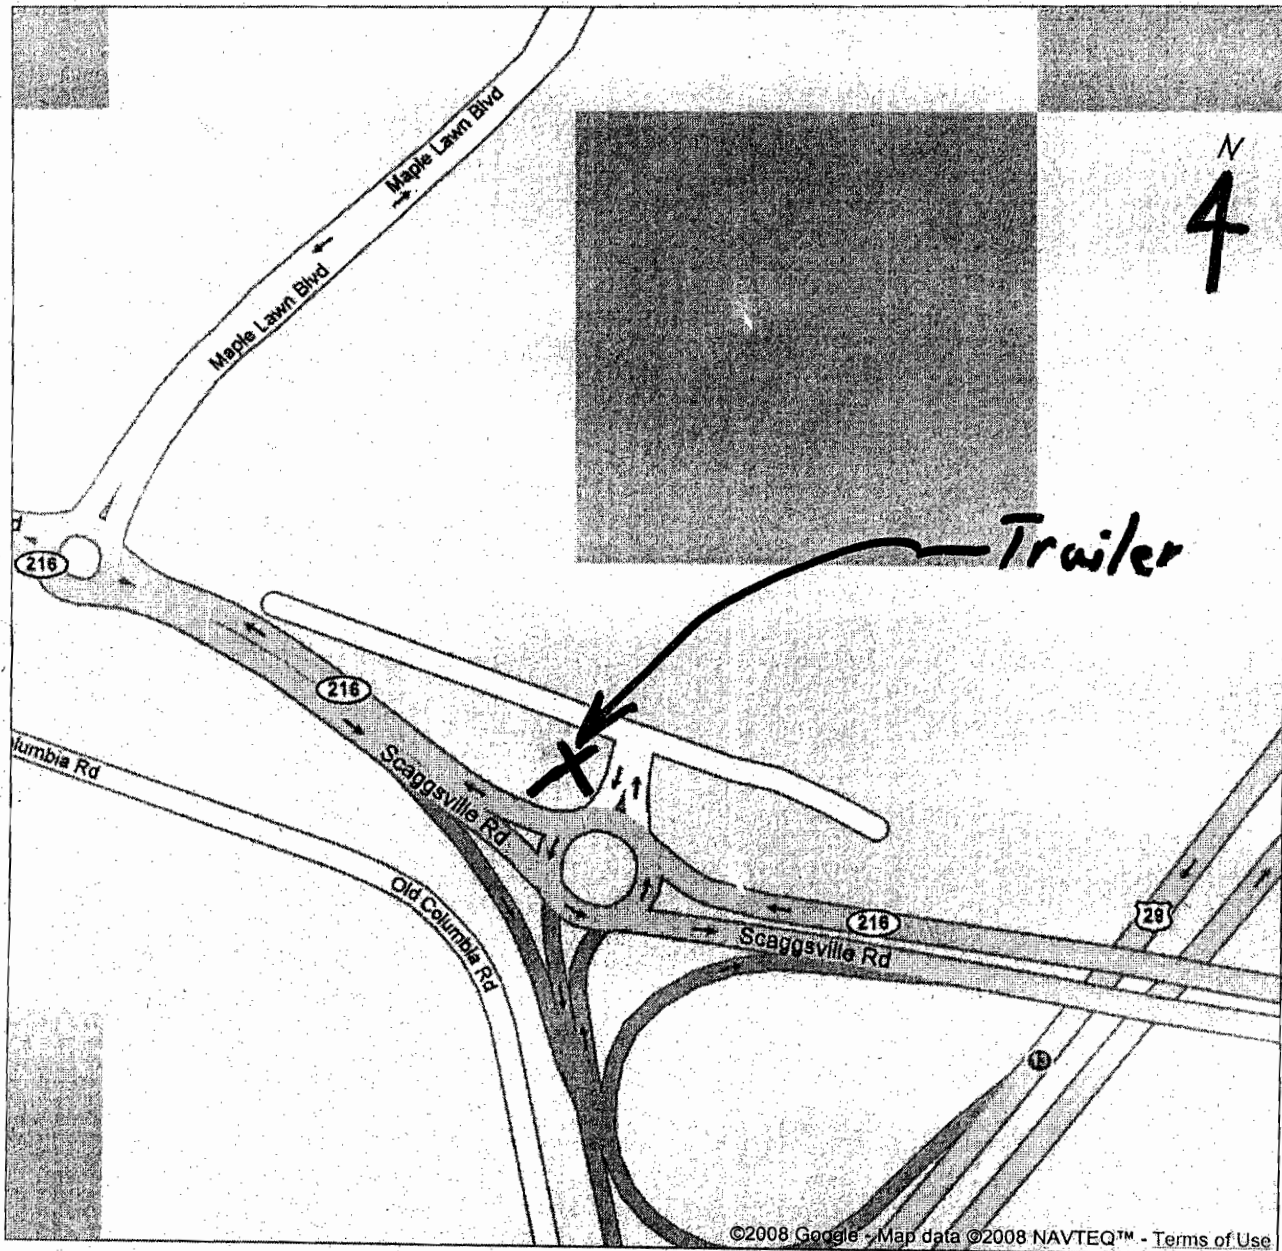

Location of trailer is inside SHA road R/W  
There are no site or property plates for this area  
Project work is along MP RT 29