

C1 08075  
1 2 3 6

SEQUENCE NO.  
(MDE USE ONLY)

STATE OF MARYLAND  
WELL COMPLETION REPORT  
FILL IN THIS FORM COMPLETELY  
PLEASE TYPE

THIS REPORT MUST BE SUBMITTED AFTER  
WELL IS COMPLETED. 08/26/00

COUNTY  
NUMBER A 34850

ST/CO USE ONLY  
DATE Received  
MM DD YY  
8 13

DATE WELL COMPLETED

12 8 2000  
15 20

Depth of Well

22 200 26  
(TO NEAREST FOOT)

PERMIT NO.  
FROM "PERMIT TO DRILL WELL"  
H0-94-2886  
28 29 30 31 32 33 34 35 36 37

OWNER Croser Homes  
STREET OR RFD last name Shady Lane first name  
SUBDIVISION Sharp Farms SECTION LOT 6

WELL LOG

Not required for driven wells

STATE THE KIND OF FORMATIONS PENETRATED, THEIR  
COLOR, DEPTH, THICKNESS AND IF WATER BEARING

| DESCRIPTION (Use<br>additional sheets if needed) | FEET |     | check<br>if water<br>bearing |
|--|------|-----|------------------------------|
|  | FROM | TO  |                              |
| Sand   | 0    | 58  |                              |
| Gray Mica Rock                                   | 58   | 200 |                              |

GROUTING RECORD

WELL HAS BEEN GROUTED  
(Circle Appropriate Box)

yes no  
Y N  
44 44

TYPE OF GROUTING MATERIAL (Circle one)

CEMENT CM BENTONITE CLAY BC

NO. OF BAGS 45 46 30 NO. OF POUNDS 2820

GALLONS OF WATER 180

DEPTH OF GROUT SEAL (to nearest foot)

from 0 ft. to 57 ft.  
48 TOP 52 54 BOTTOM 58  
(enter 0 if from surface)

CASING RECORD

casing  
types  
insert  
appropriate  
code  
below

ST CO  
STEEL CONCRETE  
PL OT  
PLASTIC OTHER

MAIN CASING TYPE ST  
Nominal diameter top (main) casing (nearest inch) 6  
Total depth of main casing (nearest foot) 62  
60 61 63 64 66 70

OTHER CASING (if used)

EACH CASING diameter inch depth (feet) from to

screen type  
or open hole  
(insert  
appropriate  
code  
below)

SCREEN RECORD

ST BR HO  
STEEL BRASS OPEN HOLE  
PL OT  
PLASTIC OTHER

NUMBER OF UNSUCCESSFUL WELLS: 0

WELL HYDROFRACTURED

yes no  
Y N

CIRCLE APPROPRIATE LETTER

- A A WELL WAS ABANDONED AND SEALED WHEN THIS WELL WAS COMPLETED  
E ELECTRIC LOG OBTAINED  
P TEST WELL CONVERTED TO PRODUCTION WELL

I HEREBY CERTIFY THAT THIS WELL HAS BEEN CONSTRUCTED IN ACCORDANCE WITH COMAR 26.04.04 "WELL CONSTRUCTION" AND IN CONFORMANCE WITH ALL CONDITIONS STATED IN THE ABOVE CAPTIONED PERMIT, AND THAT THE INFORMATION PRESENTED HEREIN IS ACCURATE AND COMPLETE TO THE BEST OF MY KNOWLEDGE.

DRILLERS LIC. NO. MSD 24

DRILLERS SIGNATURE  
(MUST MATCH SIGNATURE ON APPLICATION)

LIC. NO. D

SITE SUPERVISOR (sign. of driller or journeyman responsible for sitework if different from permittee)

GRAVEL PACK IF WELL DRILLED WAS FLOWING WELL INSERT F IN BOX 68

MDE USE ONLY  
(NOT TO BE FILLED IN BY DRILLER)

T (E.R.O.S.) W Q

70 72 74 75 76  
TELESCOPE CASING LOG INDICATOR OTHER DATA

C 3

PUMPING TEST

HOURS PUMPED (nearest hour) 3

PUMPING RATE (gal. per min.) 15

METHOD USED TO MEASURE PUMPING RATE Bucket

WATER LEVEL (distance from land surface)

BEFORE PUMPING 47 ft.  
WHEN PUMPING 58 ft.

TYPE OF PUMP USED (for test)

A air P piston T turbine  
27 27 27  
C centrifugal R rotary O other (describe below)  
27 27 27  
J jet S submersible  
27 27

PUMP INSTALLED

DRILLER INSTALLED PUMP YES NO

IF DRILLER INSTALLS PUMP, THIS SECTION MUST BE COMPLETED FOR ALL WELLS.

TYPE OF PUMP INSTALLED PLACE (A,C,J,P,R,S,T,O) IN BOX 29

CAPACITY: GALLONS PER MINUTE (to nearest gallon) 31 35

PUMP HORSE POWER 37 41


PUMP COLUMN LENGTH (nearest ft.) 43 47

CASING HEIGHT (circle appropriate box and enter casing height)

+ above LAND SURFACE  
- below 2 (nearest foot)  
49 50 51

LOCATION OF WELL ON LOT

SHOW PERMANENT STRUCTURES AND INDICATE NOT LESS THAN TWO DISTANCES (MEASUREMENTS TO WELL)

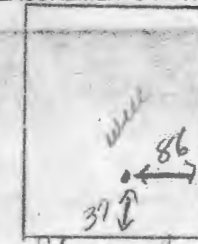

B 1 03784

SEQUENCE NO.  
(MDE USE ONLY)STATE OF MARYLAND  
PERMIT TO DRILL WELL

STATE PERMIT NUMBER

HO-94-2886

fill in this form completely

W51466 Please print or type

Date Received (APA)

11 22 00

## OWNER INFORMATION

8 MM DD YY 13

15 Last Name Owner First Name 34

36 3825 Shady Lane Street or RFD 55

57 Glenwood md 21738 Town 70 State 72 Zip 76

## DRILLER INFORMATION

Driller's Name Joseph L. Mayne M S D 24 License No. 81

Firm Name Joseph L. Mayne Well Drilling

Address 5512 Ridge Rd Mt. Airy md 21771

Signature Joseph L. Mayne Date 11/21/2000

## B 2 WELL INFORMATION

1. 2 APPROX. PUMPING RATE (GAL. PER MIN.) 8 500 12

AVERAGE DAILY QUANTITY NEEDED (GAL. PER DAY) 14 500 20

## USE FOR WATER (CIRCLE APPROPRIATE BOX)

- ☒ DOMESTIC POTABLE SUPPLY & RESIDENTIAL IRRIGATION
- ☐ FARMING (LIVESTOCK WATERING & AGRICULTURAL IRRIGATION)
- ☐ INDUSTRIAL, COMMERCIAL, DEWATERING
- ☐ PUBLIC WATER SUPPLY WELL
- ☐ TEST, OBSERVATION, MONITORING
- ☐ GEO-THERMAL

APPROXIMATE DEPTH OF WELL 300 FEET

APPROXIMATE DIAMETER OF WELL 6 INCH

## METHOD OF DRILLING (circle one)

- BORED (or Augered) JETTED Jetted & DRIVEN
- 30 AIR-ROTARY AIR-PERCussion ROTARY (Hydraulic Rotary)
- 37 CABLE REVERSE-ROTARY DRIVE-POINT
- other

REPLACEMENT OR DEEPEMED WELLS  
(CIRCLE APPROPRIATE BOX)

- ☒ THIS WELL WILL NOT REPLACE AN EXISTING WELL
- ☐ THIS WELL WILL REPLACE A WELL THAT WILL BE ABANDONED AND SEALED
- 39 ☐ THIS WELL WILL REPLACE A WELL THAT WILL BE USED AS A STANDBY-CONTACT LOCAL APPROVING AUTHORITY FOR POLICY ON STANDBY WELLS
- ☐ THIS WELL WILL DEEPEN AN EXISTING WELL

PERMIT NUMBER OF WELL TO BE REPLACED OR DEEPEMED (IF AVAILABLE) 41 52

Not to be filled in by driller (MDE OR COUNTY USE ONLY)

APPROP. PERMIT NUMBER 54 GAP 63

PERMIT No. HO-94-2886

## SPECIAL CONDITIONS

NOTE - APPROVING AUTHORITIES SHOULD USE SEPARATE SHEET IF NEEDED

## B 3 LOCATION OF WELL

8 COUNTY 21


23 SUBDIVISION 42

SECTION 44 46 LOT 6 48 50

52 NEAREST TOWN 71

MILES FROM TOWN (enter 0 if in town) 2 M 1 73 76 77 78

B 4 DIRECTION OF WELL FROM TOWN (CIRCLE BOX)

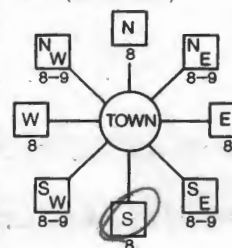

11 Shady Lane NEAR WHAT ROAD 30

ON WHICH SIDE OF ROAD (CIRCLE APPROPRIATE BOX)

34 60 37 DISTANCE FROM ROAD FT ENTER FT OR MI 38 39

TAX MAP: BLK: PARCEL

NOT TO BE FILLED IN BY DRILLER  
HEALTH DEPARTMENT APPROVAL

Howard A 34850

COUNTY NAME COUNTY NO.

STATE SIGNATURE INSERT S

DATE ISSUED 12 06 00 Steven R. Krieg 12 06 01

43 MM DD YY 48 CO SIGNATURE EXP. DATE

NORTH GRID 522 000 EAST GRID 795 000

SHOW MAJOR FEATURES OF BOX &amp; LOCATE WELL WITH AN X

SOURCES OF DRILLING WATER 1. WELL

2.


WRITE THE BOX NUMBER FROM THE MAP HERE

E 79645

N 5202

000  
000

DRAW A SKETCH BELOW SHOWING LOCATION OF WELL IN RELATION TO NEARBY TOWNS AND ROADS AND GIVE DISTANCE FROM WELL TO NEAREST ROAD JUNCTION

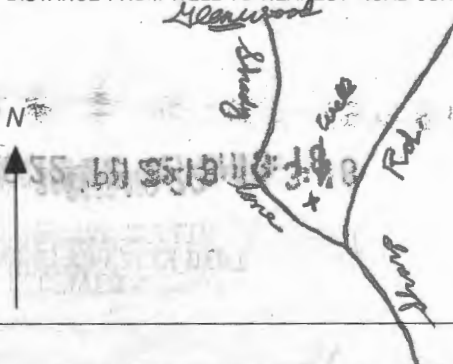

## Well Permit No. HO - 94-2886

Subdivision Sharp Farms

Lot 6

Block

Plat

*Sec.*

Well Driller Joseph Mayne

Owner

Crosen Homes

Depth of well

Distance of measuring point (M.P.) above ground

Static water level (S.W.L.) below M.P.

Time pump started

Pumping rate


|            |                              |                |
|------------|------------------------------|----------------|
| Total time | to reach pumping water level | ft. below M.P. |
|------------|------------------------------|----------------|

[illegible]



HAPP FARM INC.  
LIBER 707 FOLIO 419

|    |            |            |    |            |
|----|------------|------------|----|------------|
| 14 | 422 773.04 | 895 624.80 | 28 | 422 163.47 |
|    |            |            | 29 | 422 909.34 |

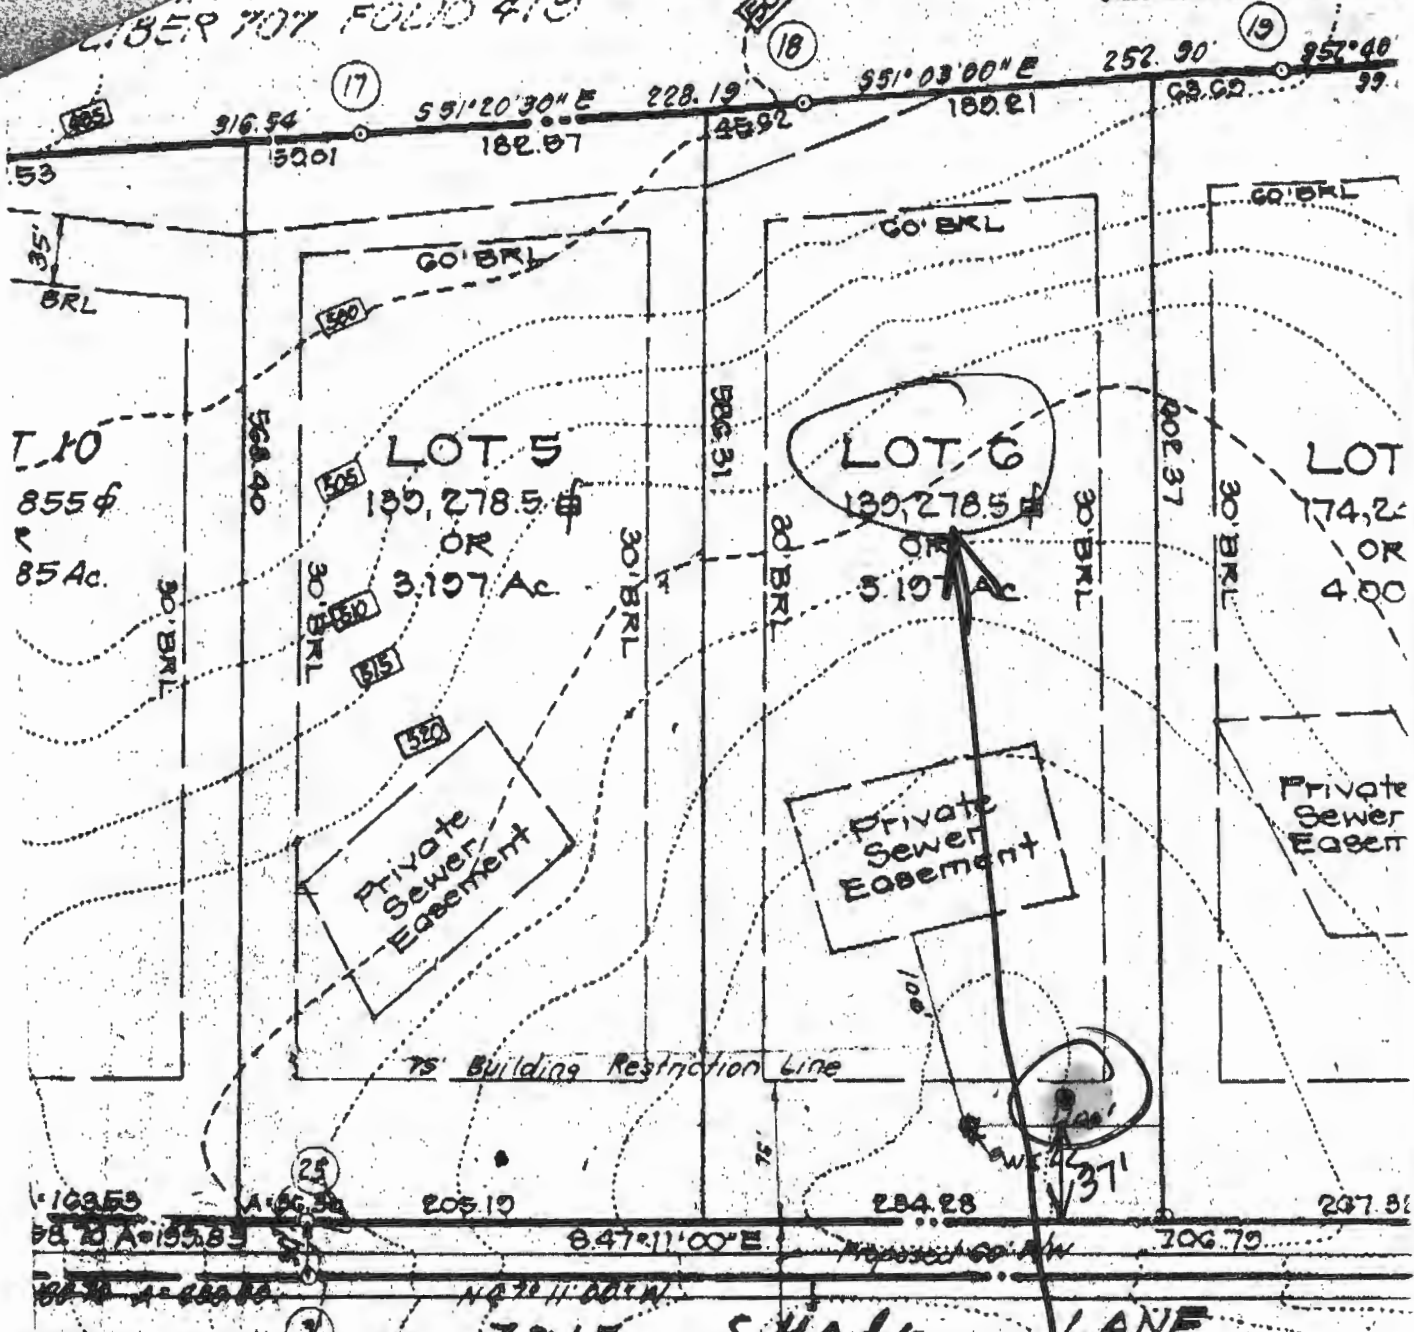

3815 SHADY LANE

Existing Paving, 20 feet wide

11/30/00 Well  
site ok  
as staked  
by Mr. Crosen

**CROSEN HOMES**

3825 Shady Lane  
Glenwood, MD 21738

HD Copy