

APPLICATION

SEWAGE DISPOSAL TESTING

STATE OF MARYLAND - DEPARTMENT OF HEALTH AND MENTAL HYGIENE

HOWARD COUNTY HEALTH DEPARTMENT
ENVIRONMENTAL HEALTH SERVICES

P. O. BOX 476 ELLICOTT CITY, MARYLAND 21043
TELEPHONE: 992-2330

A 34850

P _____

DISTRICT 4

DATE 4/22/85

TO: THE COUNTY HEALTH OFFICER
ELLICOTT CITY, MARYLAND

I, HEREBY, APPLY FOR THE NECESSARY TEST IN ORDER TO CONSTRUCT (OR RECONSTRUCT) A SEWAGE DISPOSAL SYSTEM.

PROPERTY OWNER Don Chosen

ADDRESS _____ PHONE _____

PROPERTY LOCATION:

SUBDIVISION Sharp Farms Parcel A (Pt 5336) LOT NO. 3A

ROAD AND DESCRIPTION West side Sharp Rd at Shady Lane

NEW LOT 6 of
F-87-05
87-2-86

SIZE OF LOT 3A TYPE BLDG. Residence

(NUMBER OF BEDROOMS)

THE SYSTEM INSTALLED UNDER THIS APPLICATION IS ACCEPTABLE ONLY UNTIL PUBLIC FACILITIES BECOME AVAILABLE. I FULLY UNDERSTAND THE
FEE CONNECTED WITH THE FILING OF THIS PERC TEST APPLICATION IS NON-REFUNDABLE UNDER ANY CIRCUMSTANCES. I ALSO AGREE TO COMPLY
WITH ALL M.O.S.H.A. REQUIREMENTS IN TESTING THIS LOT.

(SIGNATURE OF APPLICANT)

APPROVED BY _____ FOR _____ DATE _____

REJECTED BY _____ FOR _____ DATE _____

HOLD PENDING FURTHER TESTS _____ DATE _____

REASONS FOR REJECTION OR HOLDING 3-6-85 PERC SATISFACTORY, HOLD FOR CERTIFIED HOME


LOCATION AND HOUSE AND WELL SITE SATISF

THIS IS NOT A PERMIT

① ② ③
SOIL PROFILE

0'
1'
3'4'
13'

AP
BROWN CLAY
LOAM 210%
SAPROLITE
BROWN
SAND LOAM
10-20%
SAPROLITE
GREY
SAND LOAM
IN SMALL
VEINS
NOTED

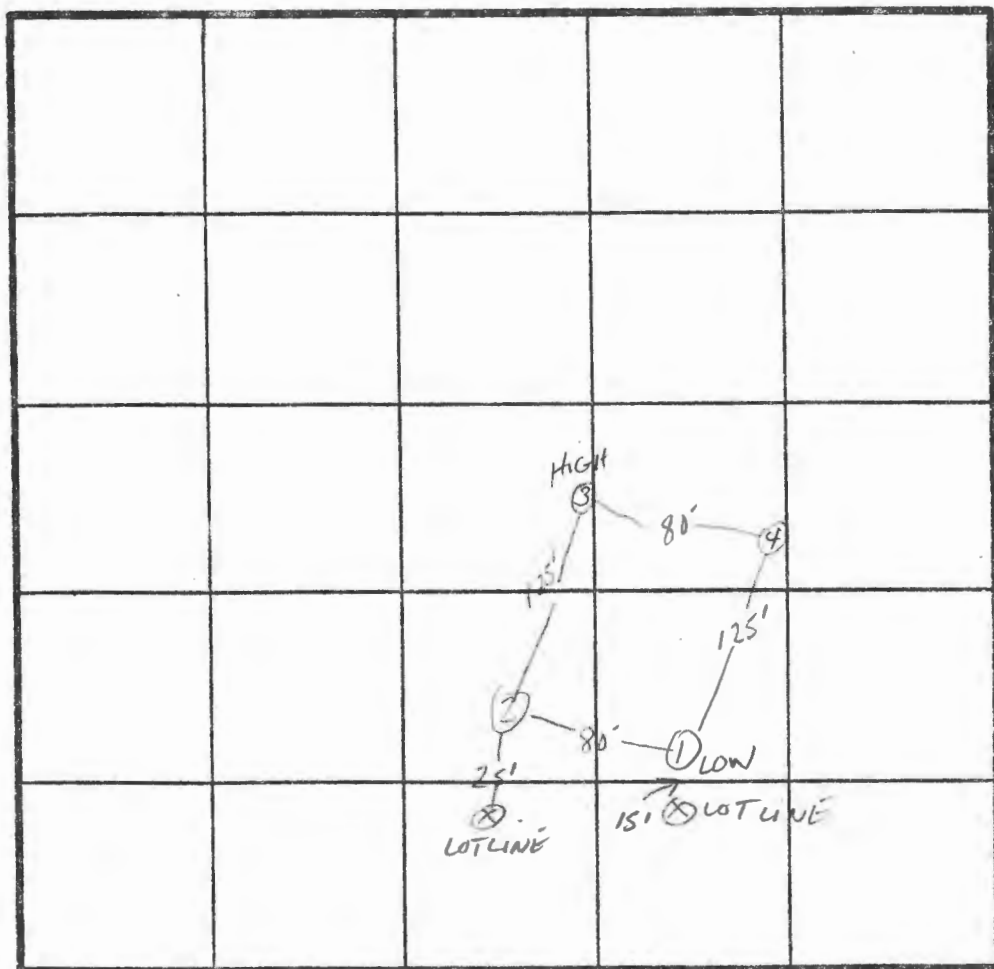

INDICATE NORTH - NAME ADJOINING ROADWAY AS BASE LINE.

SHARP Rd.

DATE	TEST NO.	DEPTH	PRE-WET		TEST - 1" DROP		TIME
			START	STOP	START	STOP	
8/6/85	15	4'	10:27	10:30	10:30	10:36	6min
	1V	13'	UNIFORM SOIL STRUCTURE BELOW 3'				
	25	4'	10:31	10:35	10:35	10:43	8min
	2V	12'	UNIFORM SOIL STRUCTURE BELOW 3'				
	35	3.5'	10:42	10:54	10:54	11:22	28min
	3V	12'	UNIFORM SOIL STRUCTURE BELOW 3'				
	45	4'	10:36	10:37:30	10:37:30	10:41	3min 30sec
	4V	12.5'	UNIFORM SOIL STRUCTURE BELOW 3'				

REMARKS

TYPE OF SOIL Glenelg / CHESTER ASSOCIATION

TESTED BY S. Abel

ALSO PRESENT CHUCK SHARP
COLLINS - BACKHOE

APPLICATION

SEWAGE DISPOSAL TESTING

STATE OF MARYLAND - DEPARTMENT OF HEALTH AND MENTAL HYGIENE

HOWARD COUNTY HEALTH DEPARTMENT
ENVIRONMENTAL HEALTH SERVICES

P. O. BOX 476 ELLICOTT CITY, MARYLAND 21043
TELEPHONE: 992-2330

A 34850

P _____

DISTRICT 4

DATE 1/22/85

TO: THE COUNTY HEALTH OFFICER
ELLICOTT CITY, MARYLAND

I, HEREBY, APPLY FOR THE NECESSARY TEST IN ORDER TO CONSTRUCT (OR RECONSTRUCT) A SEWAGE DISPOSAL SYSTEM.

PROPERTY OWNER DON CROSEN

ADDRESS _____ PHONE _____

PROPERTY LOCATION:

SUBDIVISION SHARP FARMS PARCEL A (PLAT 5336) LOT NO. 4

ROAD AND DESCRIPTION WEST SIDE SHARPROD. AT SHADY LANE

SIZE OF LOT 3A TYPE BLDG. Residence
(NUMBER OF BEDROOMS)

THE SYSTEM INSTALLED UNDER THIS APPLICATION IS ACCEPTABLE ONLY UNTIL PUBLIC FACILITIES BECOME AVAILABLE. I FULLY UNDERSTAND THE
FEE CONNECTED WITH THE FILING OF THIS PERC TEST APPLICATION IS NON-REFUNDABLE UNDER ANY CIRCUMSTANCES. I ALSO AGREE TO COMPLY
WITH ALL M.O.S.H.A. REQUIREMENTS IN TESTING THIS LOT. _____

(SIGNATURE OF APPLICANT)

APPROVED BY _____ FOR _____ DATE _____

REJECTED BY _____ FOR _____ DATE _____

HOLD PENDING FURTHER TESTS _____ DATE _____

REASONS FOR REJECTION OR HOLDING _____

THIS IS NOT A PERMIT

SOIL PROFILE

0'

INDICATE NORTH - NAME ADJOINING ROADWAY AS BASE LINE.

DATE	TEST NO.	DEPTH	PRE-WET		TEST - 1" DROP		TIME
			START	STOP	START	STOP	

REMARKS _____

TYPE OF SOIL _____

TESTED BY _____ ALSO PRESENT _____