

APPLICATION

PERCOLATION TESTING

A 49292

P _____

HOWARD COUNTY HEALTH DEPARTMENT

BUREAU OF ENVIRONMENTAL HEALTH

3525-H ELLICOTT MILLS DRIVE/ELLICOTT CITY, MARYLAND 21043
TELEPHONE: 313-2640

DISTRICT Fifth

DATE MAY 26, 1993

TO: THE COUNTY HEALTH OFFICER
ELLICOTT CITY, MARYLAND

I HEREBY APPLY FOR THE NECESSARY TEST PRIOR TO APPLICATION FOR PERMIT TO CONSTRUCT (OR RECONSTRUCT) A SEWAGE DISPOSAL SYSTEM.

PROPERTY OWNER CATHERINE CLEVENGER

ADDRESS 12459 SCAGGSVILLE ROAD PHONE 531-5991

AGENT OR PROSPECTIVE BUYER SAME AS ABOVE

ADDRESS _____ PHONE _____

PROPERTY LOCATION:

SUBDIVISION CLEVENGER PROPERTY LOT NO. 11 (4)

ROAD AND DESCRIPTION 1400'± NORTHWEST FROM INTERSECTION OF BROWN'S BRIDGE

TAX MAP 40 PARCEL # 138

SIZE OF LOT 43000 Sq. Ft. TYPE BLDG. SINGLE
(SINGLE FAMILY DWELLING OR COMMERCIAL)

THE SYSTEM INSTALLED UNDER THIS APPLICATION IS ACCEPTABLE ONLY UNTIL PUBLIC FACILITIES BECOME AVAILABLE. I FULLY UNDERSTAND THE FEE CONNECTED WITH THE FILING OF THIS PERC TEST APPLICATION IS NON-REFUNDABLE UNDER ANY CIRCUMSTANCES. I ALSO AGREE TO COMPLY WITH ALL M.O.S.H.A. REQUIREMENTS IN TESTING THIS LOT. [Signature]
(SIGNATURE OF APPLICANT)

APPROVED BY _____ FOR _____ DATE _____

DISAPPROVED BY _____ FOR _____ DATE _____

HOLD PENDING FURTHER TESTS _____

REASONS FOR REJECTION OR HOLDING 6/15/93 PERC OK 1-HOLD FOR PLAT R/H

PERCOLATION TEST PLAT/PRELIMINARY PLAT - TITLE OR I.D. # _____ DATE _____

SITE DEVELOPMENT PLAN/FINAL PLAT - TITLE OR I.D. # _____ DATE _____

THIS IS NOT A PERMIT

49292

Lot 11

COUNTY #

ONLINE
SOIL PROFILE

0' TOPSOIL

3' CLAY

BROWN
PIN/L
WHITE
SAND
LOAM

12' TOPSOIL

3' CLAY


BROWN
SAND
LOAM

115' TOPSOIL

3' CLAY

ORANGE
BROWN
SAND
LOAM

12 1/2'

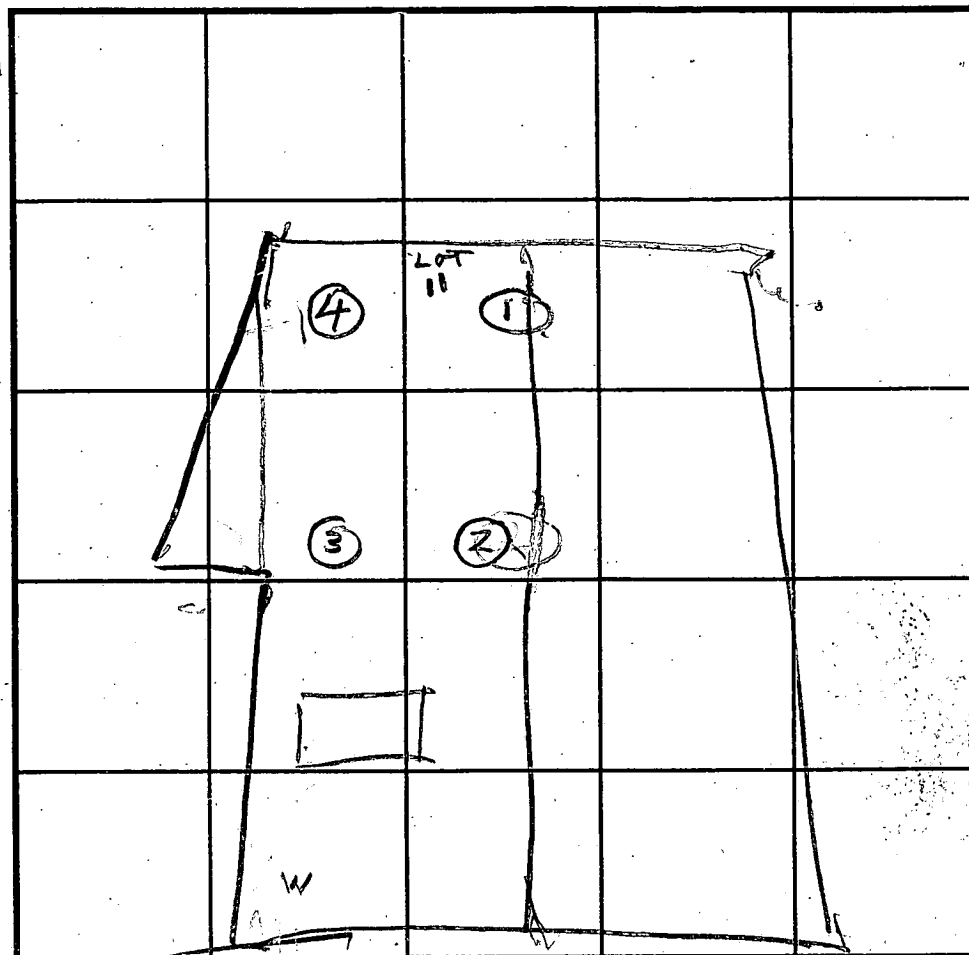

INDICATE NORTH - NAME ADJOINING ROADWAY AS BASE LINE

RD

SOIL PROFILE

0' TOPSOIL

3' CLAY

ORANGE
BROWN
SAND
LOAM

11' TOPSOIL

HOLE
ELEVATION

①② = LOW

③④ = HIGH

DATE	TEST NO.	DEPTH	PRE-WET		TEST - 1" DROP		TIME
			START	STOP	START	STOP	
6/15/93	1D	7	135	137	137	140	3
	1S	3.5	135	136	136	138	1
6/15/93	1V	12	OK				
	2S	3.5	142	145	145	153	8
	2V	11.5	OK				
	3D	7	154	155	155	158	3
	3S	3	155	202	202	210	8
	3V	12 1/2	OK				
	4V	11	OK				

ON
LINE
LIST TO
LOT 11

ON LINE

REMARKS Holes Dry Similar to Previous Test Plot of 6/16/93

TYPE OF SOIL

TESTED BY R. HODGES

C. CROVO
ALSO PRESENT MRS. CLEVERSON
O. KETTERMAN JR

TRENCH DESIGN DATA: AVERAGE PERCOLATION TIME

4

TRENCH WIDTH

2

INLET DEPTH

3

MAXIMUM BOTTOM DEPTH

8

SQ. FT./BEDROOM

180