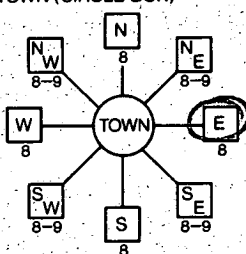
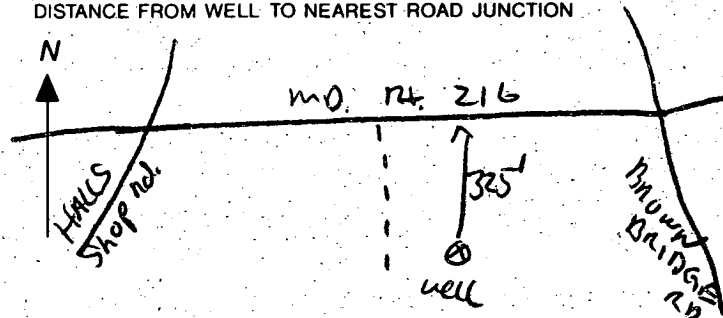


B 1 1209 (THIS NUMBER IS TO BE PUNCHED IN COLS. 3-6 ON ALL CARDS)	SEQUENCE NO. (DP USE ONLY)	STATE OF MARYLAND APPLICATION FOR PERMIT TO DRILL WELL please print or type	STATE PERMIT NUMBER H0-94-0057 fill in this form completely
Date Received (APA) 040594 OWNER INFORMATION BUCK HAVEN FARM 12459 RT 216 HIGHLAND MD 20772 57 Town 70 State 72 Zip 76		B 3 LOCATION OF WELL HOWARD 8 COUNTY CLEVENGER PROP 23 SUBDIVISION SECTION 44 46 LOT 48 50 HIGHLAND 52 NEAREST TOWN MILES FROM TOWN (enter 0 if in town) 1 MI 73 76 77 78	
DRILLER INFORMATION Ralph MAYNE 116 77 License No. 80 Ralph MAYNE well Drilling 9120 Brown Church Rd. W.H. Army Address Ralph Mayne 3/15/94 Signature Date		B 4 DIRECTION OF WELL FROM TOWN (CIRCLE BOX)  NEAR WHAT ROAD MD Rt. 216 ON WHICH SIDE OF ROAD (CIRCLE APPROPRIATE BOX) 34 325 37 DISTANCE FROM ROAD ENTER FT OR MI 1/4 38 39 TAX MAP: _____ BLK: _____ PARCEL: _____	
B 2 WELL INFORMATION APPROX. PUMPING RATE (GAL. PER MIN.) 5 AVERAGE DAILY QUANTITY NEEDED (GAL. PER DAY) 500 14 20		USE FOR WATER (CIRCLE APPROPRIATE BOX) ☒ D HOME (SINGLE OR DOUBLE HOUSEHOLD UNIT ONLY) ☐ F FARMING (LIVESTOCK WATERING & AGRICULTURAL IRRIGATION) ☐ I INDUSTRIAL, COMMERCIAL, STATE AND FEDERAL GOV. OTHER (REQUIRES APPROPRIATION PERMIT) ☐ P PUBLIC OR PRIVATE WATER COMPANY (REQUIRES APPROPRIATION PERMIT AND STATE HEALTH DEPARTMENT APPROVAL) ☐ T TEST, OBSERVATION, MONITORING (MAY REQUIRE APPROPRIATION PERMIT)	
APPROXIMATE DEPTH OF WELL 150 FEET APPROXIMATE DIAMETER OF WELL 6" INCH		NOT TO BE FILLED IN BY DRILLER HEALTH DEPARTMENT APPROVAL Howard W49933A COUNTY NAME COUNTY NO. STATE SIGNATURE _____ INSERT S DATE ISSUED 040594 SIGNATURE _____ EXP. DATE 04/05/95 NORTH GRID 486000 EAST GRID 0814000 50 55 57 63	
METHOD OF DRILLING (circle one) BORED (or Augered) JETTED Jetted & DRIVEN AIR-ROTARY AIR-PERCussion ROTARY (Hydraulic Rotary) CABLE REVERSE-ROTARY Drive-POINT other _____		SHOW MAJOR FEATURES OF BOX & LOCATE WELL WITH AN X SOURCES OF DRILLING WATER 1. well 2. 3. WRITE THE BOX NUMBER FROM THE MAP HERE E 810 4 N 480 6 000 000	
REPLACEMENT OR DEEPEMED WELLS (CIRCLE APPROPRIATE BOX) ☒ N THIS WELL WILL NOT REPLACE AN EXISTING WELL ☐ Y THIS WELL WILL REPLACE A WELL THAT WILL BE ABANDONED AND SEALED ☐ S THIS WELL WILL REPLACE A WELL THAT WILL BE USED AS A STANDBY-CONTACT LOCAL APPROVING AUTHORITY FOR POLICY ON STANDBY WELLS ☐ D THIS WELL WILL DEEPEN AN EXISTING WELL PERMIT NUMBER OF WELL TO BE REPLACED OR DEEPEMED (IF AVAILABLE) 41 _____ 52		DRAW A SKETCH BELOW SHOWING LOCATION OF WELL IN RELATION TO NEARBY TOWNS AND ROADS AND GIVE DISTANCE FROM WELL TO NEAREST ROAD JUNCTION 	
Not to be filled in by driller (OEP USE ONLY)			
APPROX. PERMIT NUMBER _____ GAP _____ 54 63			
FORCE CS WRITE INITIALS IN BOX PERMIT No. H0-94-0057 67 68 70 71 72 73 74 75 76 77 78 79			
SPECIAL CONDITIONS CATHERINE CLEVENGER 854-2018 - 631-5991 NOTE = APPROVING AUTHORITIES SHOULD USE SEPARATE SHEET IF NEEDED =			

8-20-94
Received 6/9/94
SC

HOWARD COUNTY HEALTH DEPARTMENT
Bureau of Environmental Health
3525-H Ellicott Mills Drive
Ellicott City, MD 21043
461-9933

8/26 Hold - not approved
Need cement grout around pitless adapter to 1/2" below adapter
OK
Hold
C.B.D.

APPLICATION FOR PITLESS ADAPTER, WELL PUMP AND PRESSURE TANK INSTALLATION LINE

New Installation ☒ X
Replacement _____

Receipt # _____
Date June 6, 1994

Name of Installer CHARLES A. KLEIN & SONS, INC.

Telephone (410) 549-6960

License Number 6521

Certified Well Pump Installer ☒ X Well Driller _____ Registered Plumber _____

Name of Property Owner Cornerstone Homes

Telephone (410) 379-0157

Subdivision Bucks Haven Manor Lot # 4

Well Tag # HO-94-0057

Site Address 12515 Scaggsville Road Highland, MD 20777

Pump

1. Type

- a. Deep well jet _____
b. Shallow well jet _____
c. Submersible _____

Motor

1. Horsepower _____
2. RPM _____
3. Voltage _____
a. 110 _____
b. 220 _____

Pitless Adapter

1. Make _____
2. Model # _____
3. Depth _____

2. Make _____

3. Model # _____

4. Capacity _____ GPM

5. Pump exceeds well capacity Yes _____ No _____

6. If Yes, is low pressure cutoff switch installed? Yes _____ No _____

7. What methods are used to protect the pump and electrical wiring from vibrations? Torque arrestors _____ Cable guards _____ Other _____

Tank

1. Capacity _____
2. Pressure relief valve? _____

Piping

1. Type _____
2. Size _____
3. NSF and/or BOCA Code approved _____
4. Depth of supply line _____

Well data

1. Depth _____ ft.
2. Yield _____ GPM
3. Static water level _____ ft.
4. Will water supply be disinfected by installer? _____

8/30/94 met R. Mayre @ 1 PM
Grout added to 1/2' below

Pitless adapter, cap properly attached - OK DKS

I understand that it is my responsibility to notify the Howard County Health Department when the installation is ready for inspection (otherwise this permit is null and void).

All information given above is true to the best of my knowledge.

Signature of Applicant: X Charles A Klein Jr

Date: June 6, 1994

Note: A sticker indicating approval/status of the installation will be placed on the well casing at the time of the inspection.

HD-215

Not approved 8/26
Top cover, ON HOLD AROUND CASING - 2 1/2" x 8" no grout below adapter
C.B.D.

42-14-0052
Howard County Health Department
Bureau of Environmental Health
3525-H Ellicott Mills Drive
Ellicott City, Maryland 21043

~~484-2238~~

313-2640

INSPECTION NOTICE

Remarks

8/26

NOT APPROVED

NEED CEMENT

GRUNT UP TO 2" OF

PITLESS

Disapproved

Chick E. Stutz

Approved

Work not complete

Not for use

Inspected by

Chick E. Stutz

Date

8/26/79