

Bureau of Environmental Health

8930 Stanford Boulevard, Columbia, MD 21045 Main: 410-313-2640 | Fax: 410-313-2648 TDD 410-313-2323 | Toll Free 1-866-313-6300 www.hchealth.org


Facebook: www.facebook.com/hocohealth

Maura J. Rossman, M.D., Health Officer


RECEIPT DATE: 7/28/22 ONSITE SEWAGE DISPOSAL SYSTEM P 567 917
APPROVAL DATE: 10/1/20 COPERMIT: CONSTRUCTION A
PROPERTY ADDRESS: 15457 Rivercrest Ct.
SUBDIVISION: Rivercrest LOT: 12 TAX ID: 04373383
CONTRACTOR: Hatfields EMAIL:
CONTRACTOR ADDRESS: PHONE:
PROPERTY OWNER: Roxbury Farm , LLC C/O Columbia Developers EMAIL:
OWNER ADDRESS: 6420 Autumn Sky Way Columbia, MD PHONE: 410-730-3940
SEPTIC TANK SIZE (GALLONS): 2000 TANK MANUFACTURER: Babylon Vault
PUMP MODEL: N/A PUMP SIZE N/A PUMP TANK CAPACITY: N/A
DISTRIBUTION SYSTEM: GRAVITY PRESSURE DOSED BEDROOMS: 5 APPLICATION RATE: 1.2
LINEAR FEET REQUIRED: 105 INLET DEPTH: 2.5
TRENCHES: TRENCH WIDTH: _3 MAXIMUM BOTTOM DEPTH: _7
MINIMUM SPACE BETWEEN TRENCHES: 10 EFFECTIVE AREA BEGINNING DEPTH: 4
LOCATION: PER APPROVED SITE PLAN. SEWAGE DISPOSAL AREA AND TANK LOCATIONS MUST BE STAKED BY LICENSED SURVEYOR PRIOR TO PRE-CONSTRUCTION INSPECTION.
NOTES:
ISSUED BY: Robert Freemon ISSUE DATE: 7/28/20 EXPIRATION DATE: 2/28/20
NOTE: CONTRACTOR MUST SCHEDULE A PRE-CONSTRUCTION INSPECTION PRIOR TO BEGINNING ANY INSTALLATION
NOTE: CONTRACTOR MUST SCHEDULE AN INSPECTION AND GAIN APPROVAL OF ALL COMPONENTS PRIOR TO COVERING
NOTE: STONE MUST BE APPROVED BY HEALTH DEPARTMENT AND GRAVEL TICKET MUST BE AVAILABLE FOR REVIEW.
NOTE: WATERTIGHT TANKS REQUIRED
NOTE: ALL PARTS OF SEPTIC SYSTEM SHALL BE AT LEAST 100 FEET DOWNGRADIENT FROM ANY WATER WELL NOTE: MANHOLE RISERS REQUIRED ON ALL SEPTIC TANKS AND PUMP CHAMBERS
NOTE: AN ELECTRICAL PERMIT IS REQUIRED FOR INSTALLATION OF ANY ELECTRICAL COMPONENTS OF THE SYSTEM ELECTRICAL PERMIT ISSUED E
NOTE: MDE RECOMMENDS SEPTIC TANKS, BAT, AND OTHER PRETREATMENT UNITS BE PUMPED AT A FREQUENCY ADEQUATE TO ENSURE THAT SOLIDS ARE NOT DISCHARGED TO THE DISPOSAL AREA
NEITHER THE HOWARD COUNTY COUNCIL NOR THE HEALTH DEPARTMENT IS RESPONSIBLE FOR THE

SUCCESSFUL OPERATION OF ANY SYSTEM. PERMITTEE RESPONSIBLE FOR OBTAINING FINAL APPROVAL ON THIS PERMIT.


CALL 410-313-1771 TO SCHEDULE INSPECTIONS.

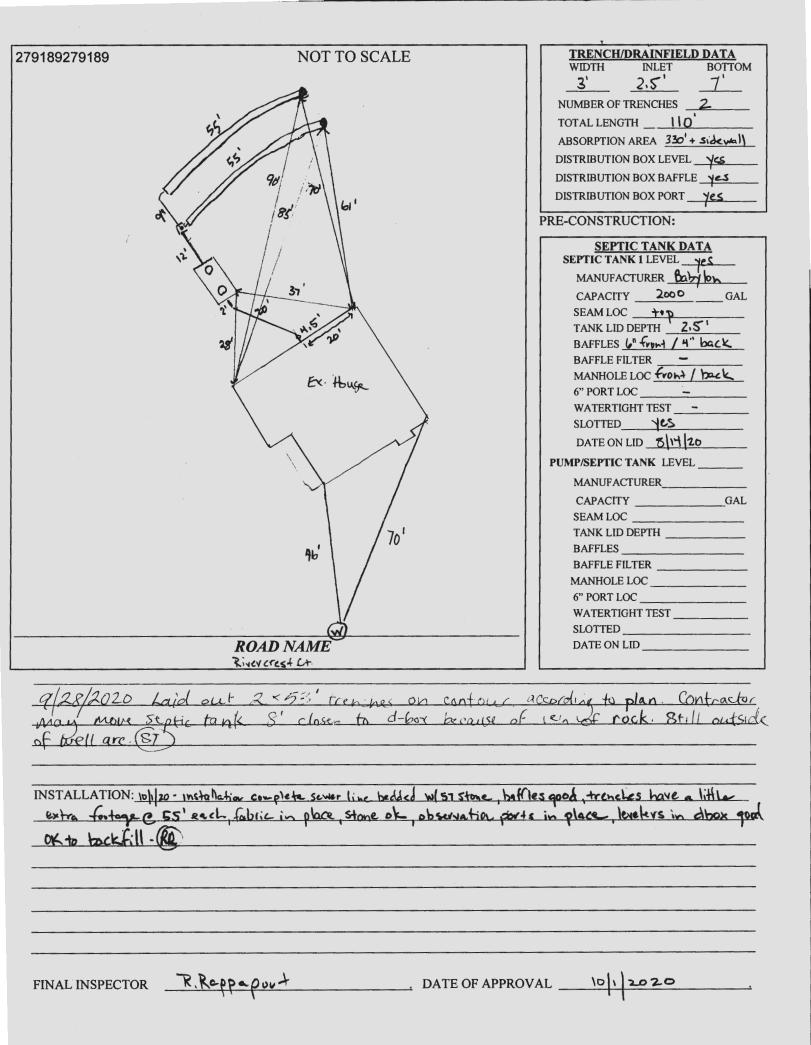



STORY (AND IN FEBRUARY OF COMPANY OF COMPANY

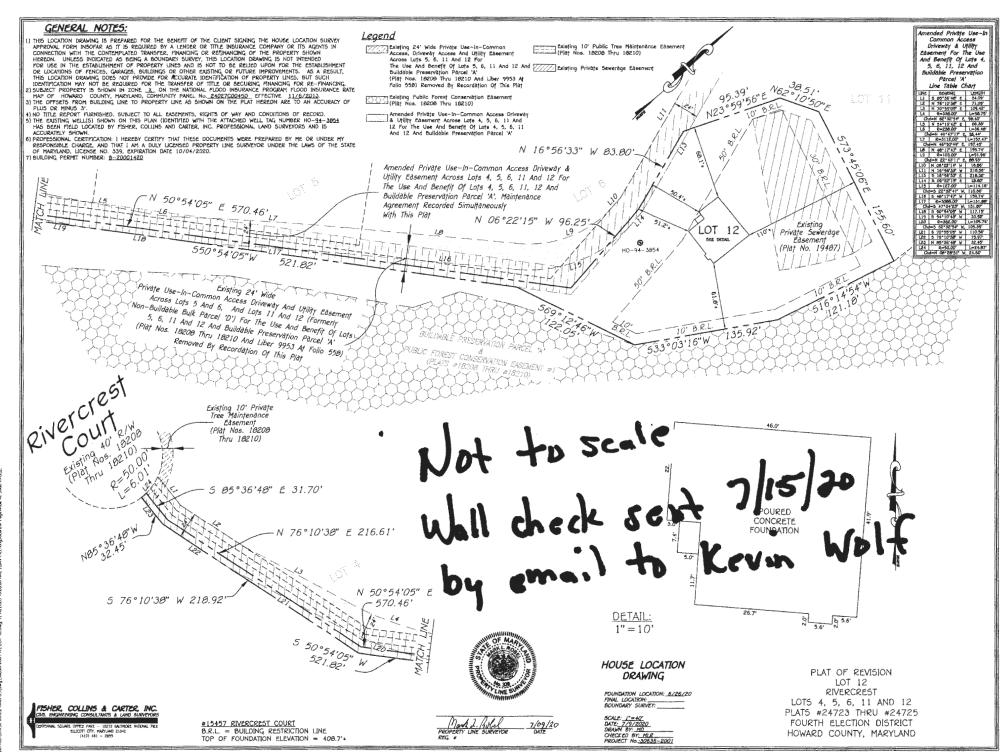


PACENCEROPA DIGES BEITE BLAD BENJAMAN TAGESCOMEN HILLOTT 12 Anna 1774 2000 NA WEDNI ACCOUNT ACCOUNT TAGESTURE BENANDERS YE OF

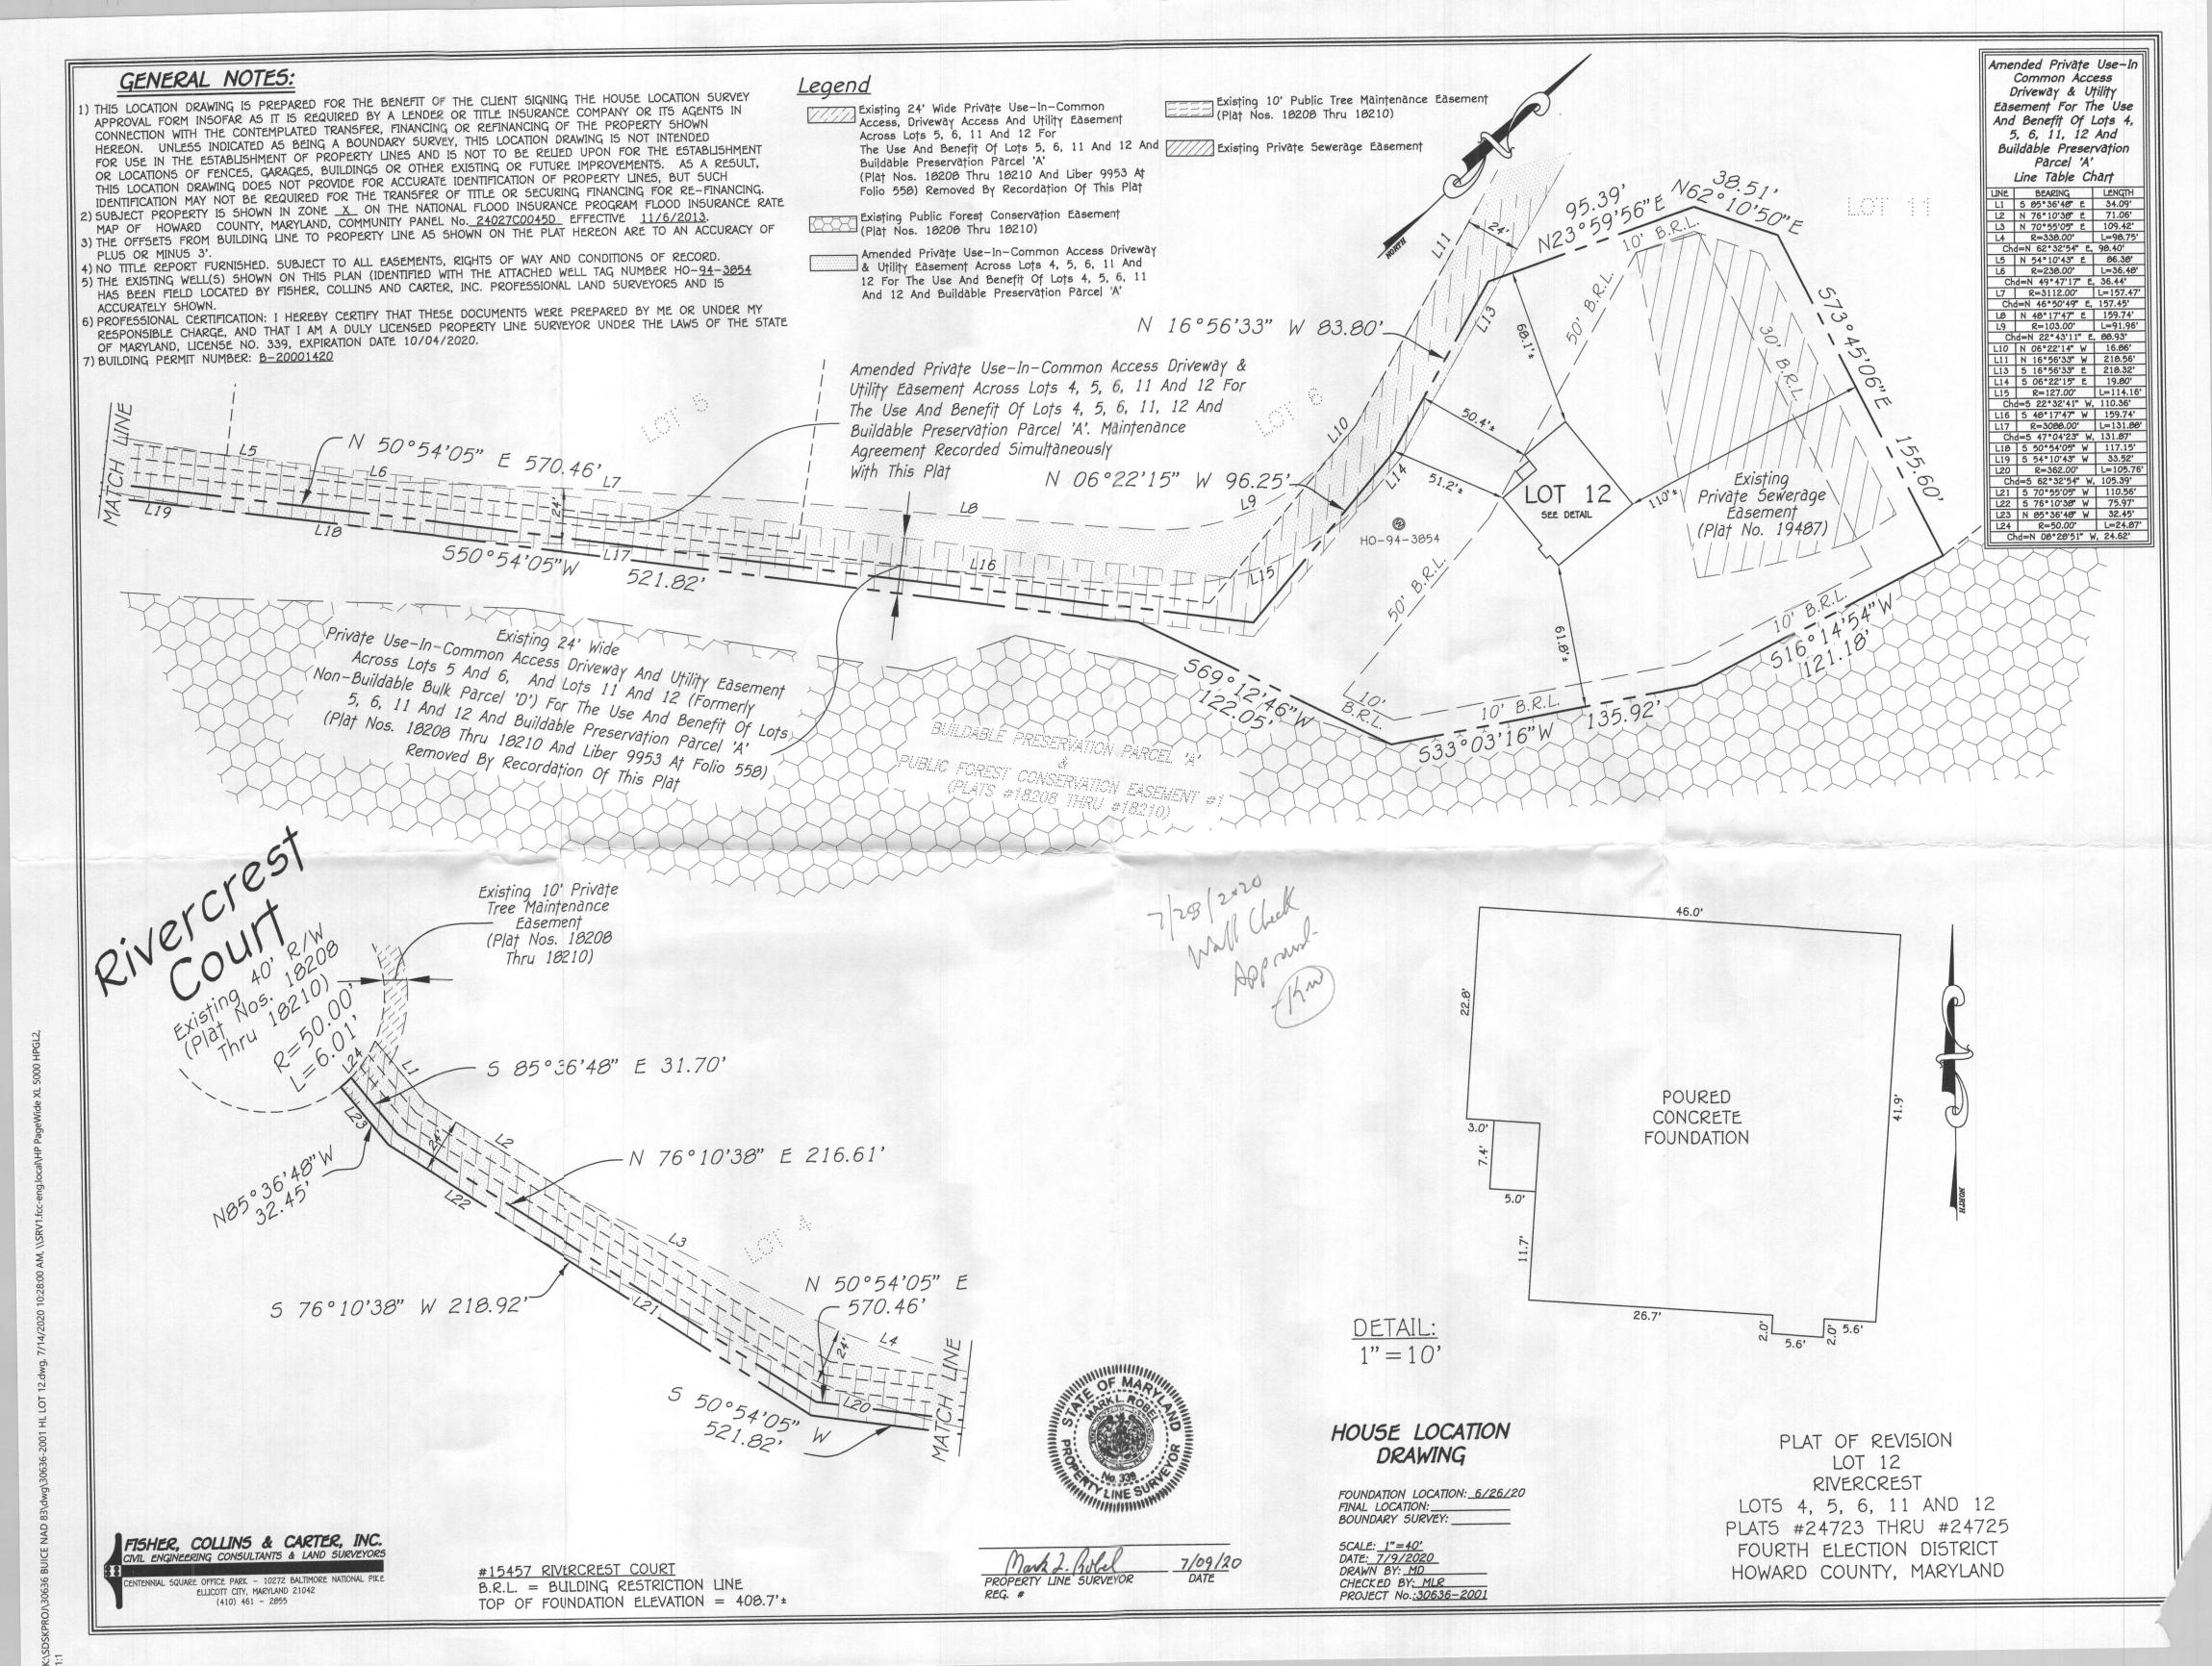

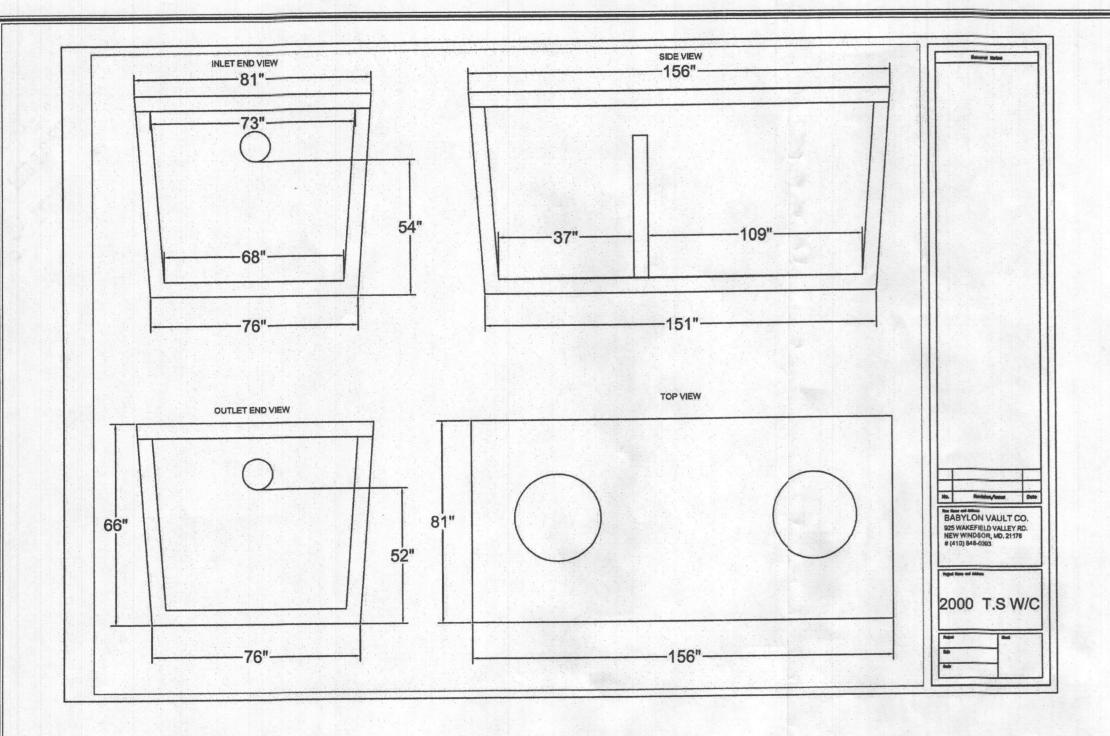

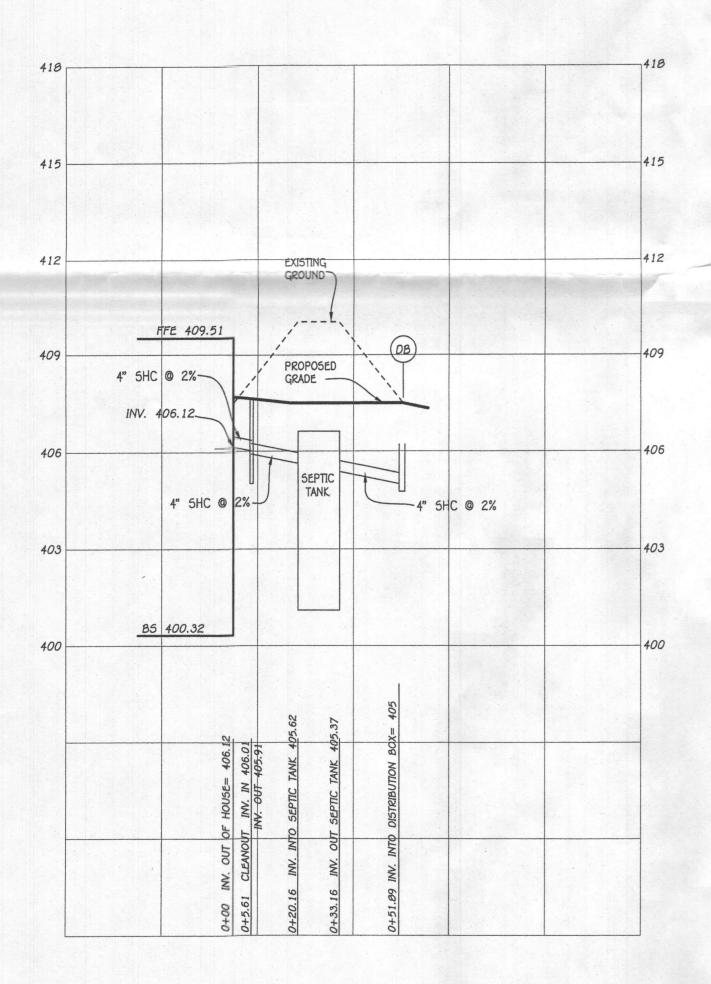

SEPTIC PROFILE SCALE: 1"=30"

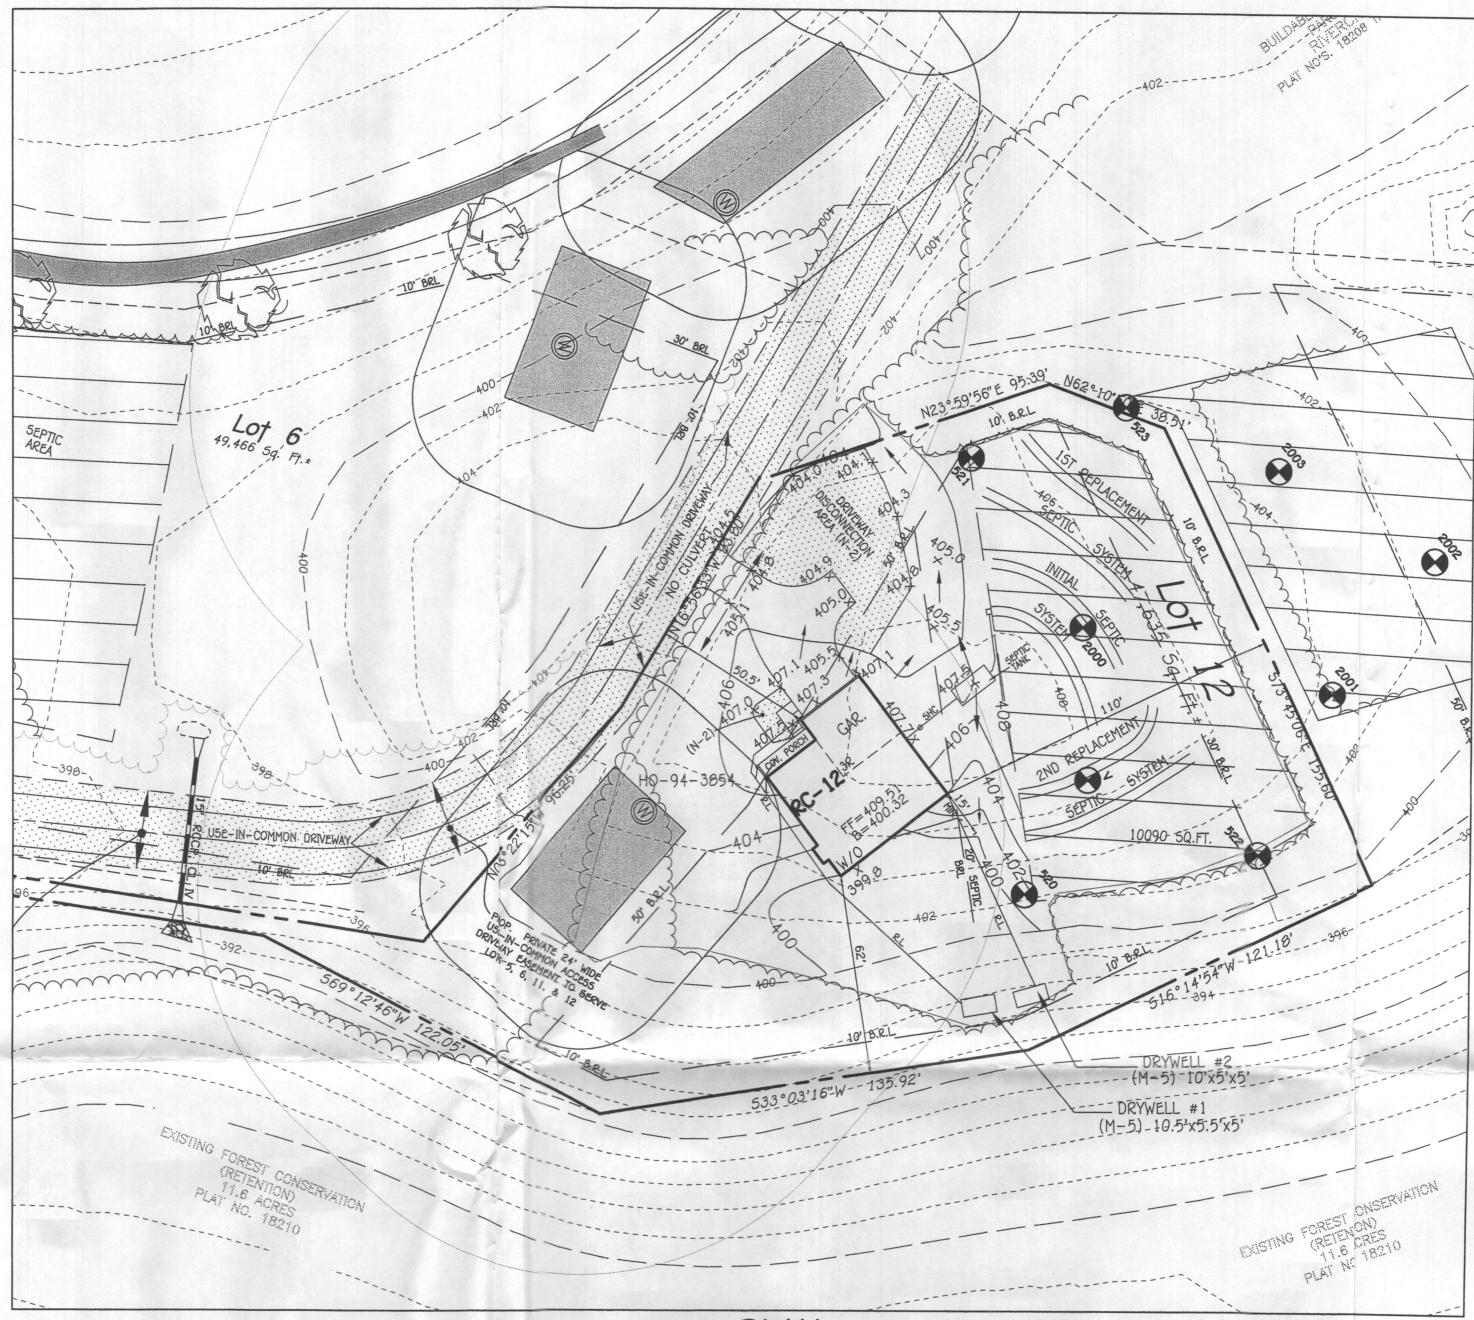

SCALE: 1" = 30'

INITIAL SYSTEM

SEWAGE DISPOSAL SYSTEM DATA, DESIGN FOR 5 BEDROOMS (PERMIT FOR 4 BEDROOMS) LOADING RATE = 5 BEDROOMS X 150 GPD/BEDROOM = 750 GPD APPLICATION RATE = 1.2 EFFECTIVE SIDEWALL BEGINS AT 4 FEET TRENCH DEPTH = 7 FEET TRENCH WIDTH (W) = 3 FEET EFFECTIVE DEPTH (D) = 3 FEET SF OF DRAINFIELD = 750 GPD / 1.2 = 625 SF COEFFICIENT OF REDUCTION OF TRENCH LENGTH = (W+2)/(W+1+2D)=(3+2)/(3+1+(2x3))=0.50TRENCH LENGTH = 208.33 SF x 0.50 = 104.17 FEET (USE 2 TRENCHES AT 52.08 L.F.) TRENCH SPACING = 2D+W = ((2*3) + 3) = 9' USE 10'

15T REPLACEMENT SYSTEM SEWAGE DISPOSAL SYSTEM DATA, DESIGN FOR 5 BEDROOMS (PERMIT FOR 4 BEDROOMS) LOADING RATE = 5 BEDROOMS X 150 GPD/BEDROOM = 750 GPD APPLICATION RATE = 1.2 EFFECTIVE SIDEWALL BEGINS AT 4 FEET TRENCH DEPTH = 7 FEET TRENCH WIDTH (W) = 3 FEET EFFECTIVE DEPTH (D) = 3 FEET SF OF DRAINFIELD = 750 GPD / 1.2 = 625 SF COEFFICIENT OF REDUCTION OF TRENCH LENGTH = (W+2)/(W+1+20)=(3+2)/(3+1+(2x3))=0.50TRENCH LENGTH = 208.33 SF x 0.50 = 104.17 FEET (USE 2 TRENCHES AT 52.08 L.F.) TRENCH SPACING = 20+W = ((2*3) + 3) = 9' USE 10'

2ND REPLACEMENT SYSTEM
SEWAGE DISPOSAL SYSTEM DATA, DESIGN FOR 5 BEDROOMS (PERMIT FOR 4 BEDROOMS) APPLICATION RATE = 1.2 EFFECTIVE SIDEWALL BEGINS AT 4 FEET TRENCH DEPTH = 7 FEET TRENCH WIDTH (W) = 3 FEET EFFECTIVE DEPTH (D) = 3 FEET SF OF DRAINFIELD = 750 GPD / 1.2 = 625 SF COEFFICIENT OF REDUCTION OF TRENCH LENGTH = (W+2)/(W+1+2D)=(3+2)/(3+1+(2x3))=0.50TRENCH LENGTH = 208.33 5F x 0.50 = 104.17 FEET (USE 2 TRENCHES AT 52.08 L.F.)

TRENCH SPACING = 2D+W = ((2*3) + 3) = 9' USE 10'

1. ANY CHANGE TO THE LOCATIONS OR DEPTHS TO ANY COMPONENTS UST BE APPROVED BY THE ENGINEER AND THE HOWARD COUNTY HEALTH DEPARTMENT PRIOR TINSTALLATION. A REVISED SITE PLAN MAY BE REQUIRED.

LOADING RATE = 5 BEDROOMS X 150 GPD/BEDROOM = 750 GPD 2. THE MAXIMUM EARTH COVER OVER THE TANK IS 3 FEET. GREATER RTH COVER WILL REQUIRE A HEAVY LOAD BEARING TANK. 3. THE WELL HO-94-3854 HAS BEEN FIELD LOCATED AND IS ACCURALY SHOWN. 4. ALL WELLS AND SEPTIC SYSTEMS LOCATED WITHIN 100' OF THE PRERTY BOUNDARIES AND

200' DOWN GRADIENT OF ANY WELLS AND/OR SEPTIC SYSTEMS HAVBEEN SHOWN.

VICINITY MAP

5CALE: 1" = 2000'

----- EXISTING 2' CONTOURS


- - EXISTING 10' CONTOURS EXISTING TREE LINE

- SOIL LINES AND TYPES

DENOTES EXISTING WELL DENOTES PASSED PERC

DENOTES 1500 54.Ft. ALTERNATE WELL SITE

FFE 409.51 BSE 400.32 INV. OUT OF HOUSE = 406.12 PROP. GROUND AT CLEANOUT #1 = 407.7 INV. INTO CLEANOUT = 406.01 INV. OUT OF CLEANOUT = 405.91 EX. GROUND AT SEPTIC TANK = 410.0 PROP. GRADE ABOVE SEPTIC TANK = 407.5 TOP OF SEPTIC TANK = 406.62 INV. INTO SEPTIC TANK = 405.62 INV. OUT OF SEPTIC TANK = 405.37 EX. GROUND AT DISTRIBUTION BOX = 407.5 INV. INTO DISTRIBUTION BOX = 405.0 INV. OUT OF DISTRIBUTION BOX = 404.9

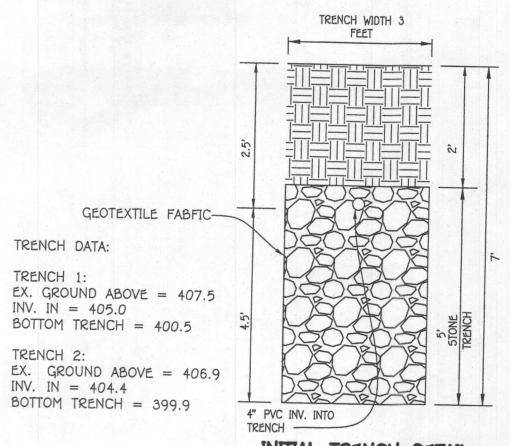

INITIAL TRENCH DETAIL

SEPTIC SYSTEM INSTALLATION SITE PLAN RIVERCREST


15457 RIVERCREST COURT

ZONED: RC-DEO PLAT NO.: 24723 THRU 24725 TAX MAP NO.: 21 GRID NO.: 20 PARCEL NO.: 270 4TH ELECTION DISTRICT HOWARD COUNTY, MARYLAND SCALE: 1" = 50' DATE: JAN. 24, 2020

SHEET 1 OF 1

PROFESSIONAL CERTIFICATION I HEREBY CERTIFY THAT THESE DOCUMENTS WERE PREPARED OR APPROVED BY ME

AND THAT I AM A DULY LICENSED PROFESSIONAL ENGINEER UNDER THE LAWS OF

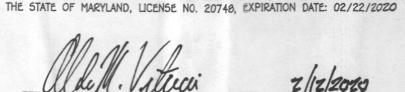


BUILDER COLUMBIA BUILDERS, INC P.O. BOX 999 COLUMBIA, MARYLAND 21044


443-324-4732

OWNER ROXBURY FARM, LLC C/O COLUMBIA DEVELOPERS LL 6420 AUTUMN SKY WAY COLUMBIA, MARYLAND 21044


410-730-3940



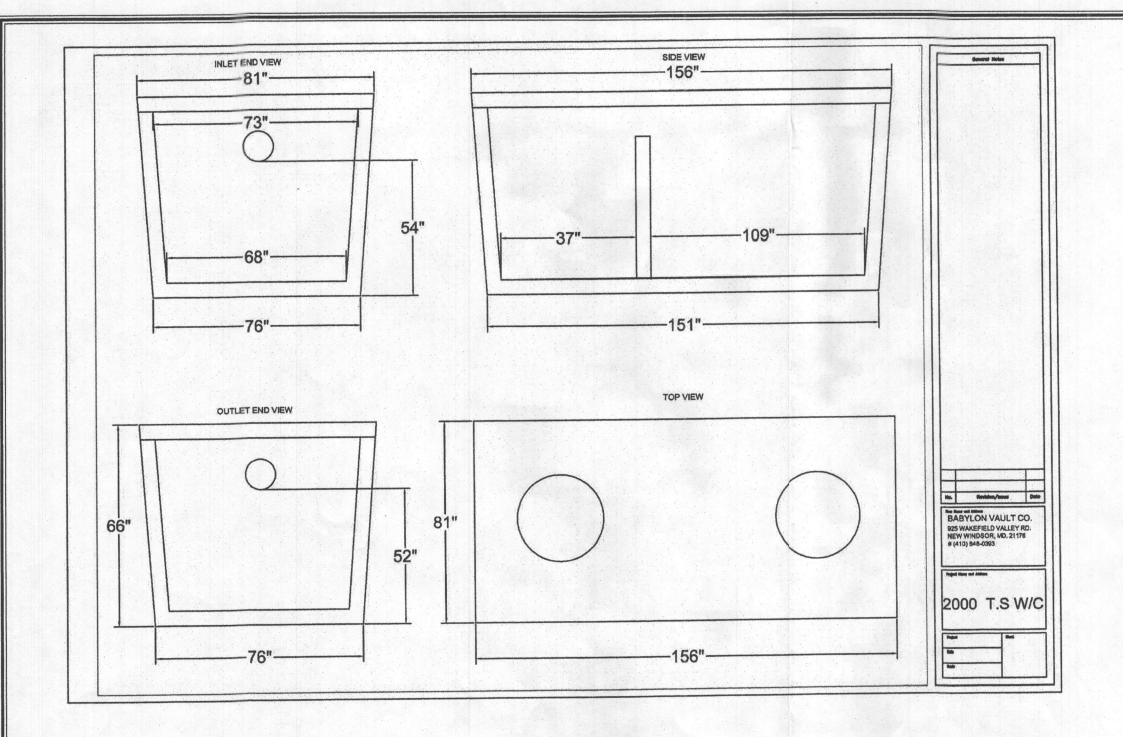

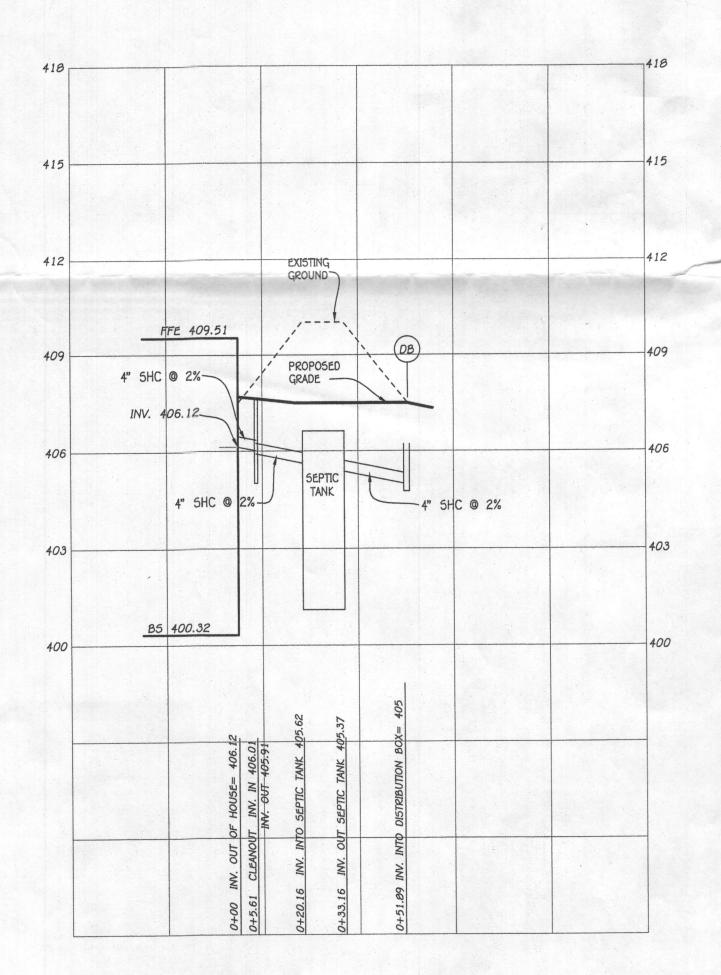

SEPTIC PROFILE

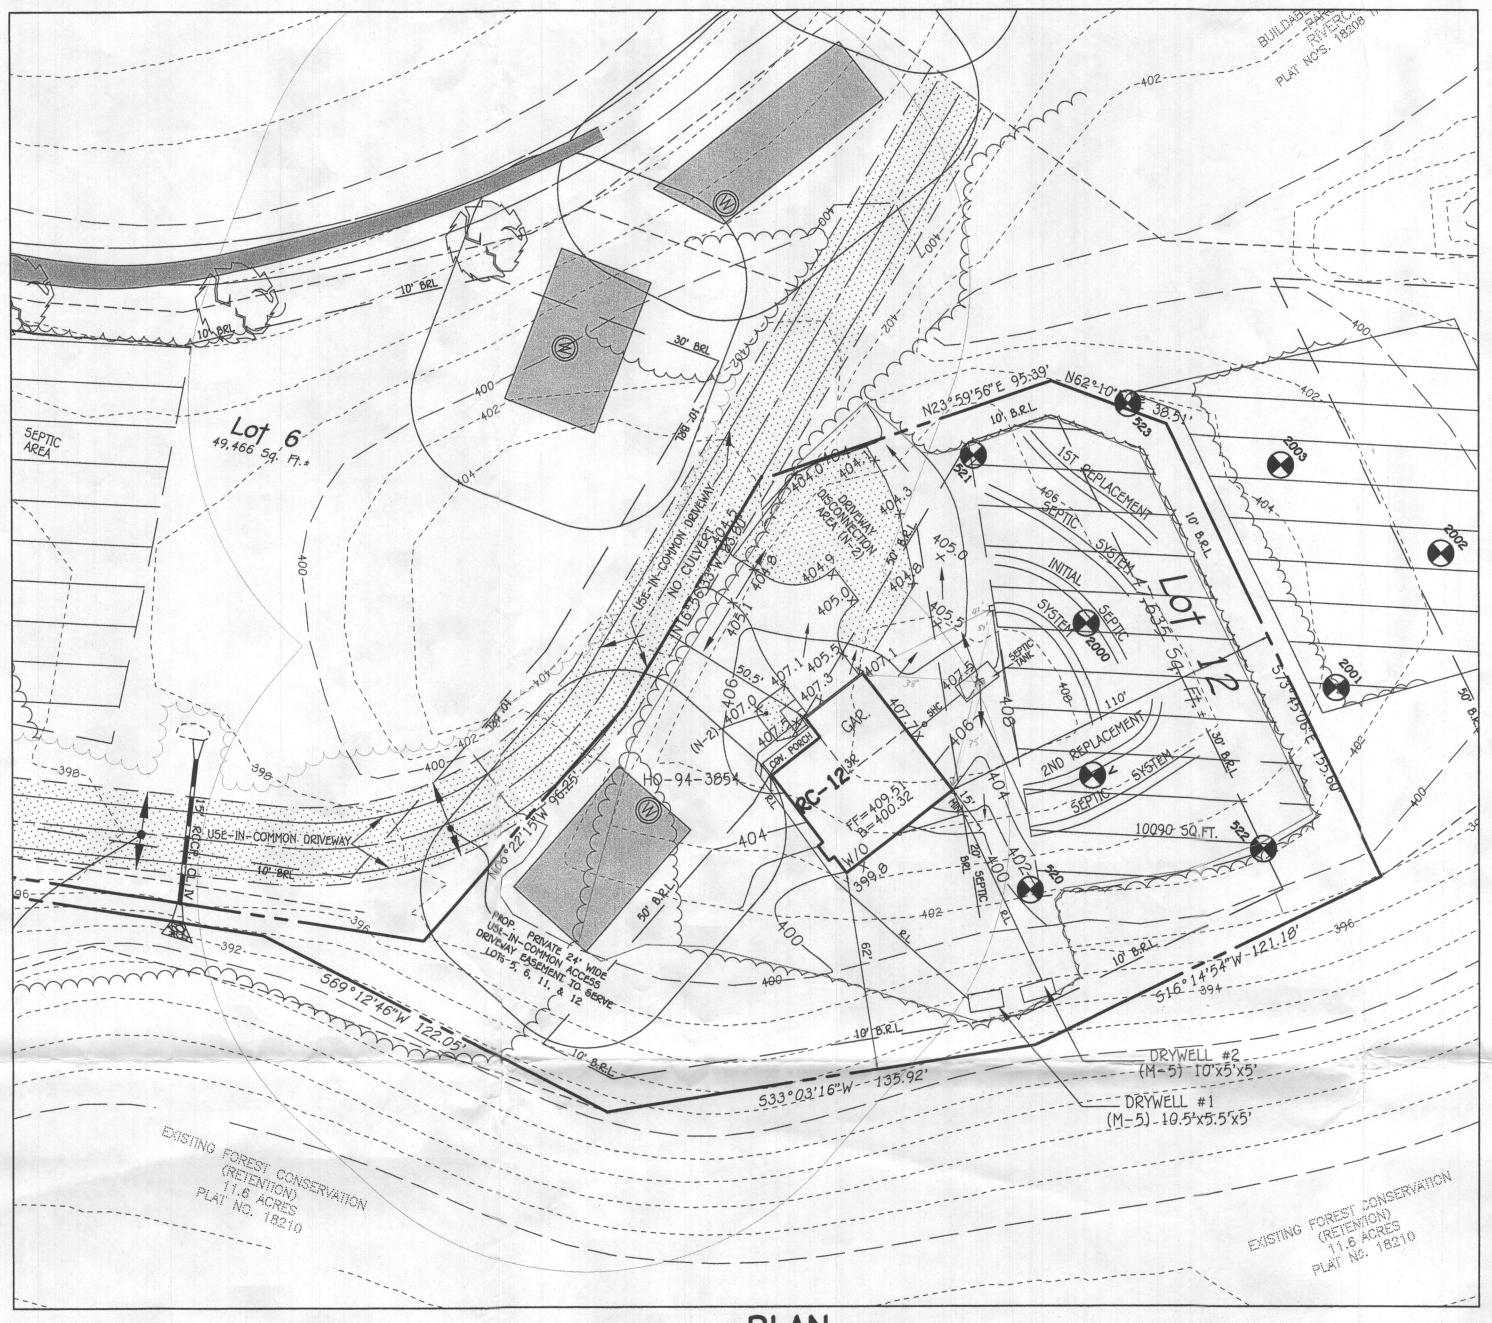

PLAN SCALE: 1" = 30'

INITIAL SYSTEM

SEWAGE DISPOSAL SYSTEM DATA, DESIGN FOR 5 BEDROOMS (PERMIT FOR 4 BEDROOMS) LOADING RATE = 5 BEDROOMS X 150 GPD/BEDROOM = 750 GPD APPLICATION RATE = 1.2 EFFECTIVE SIDEWALL BEGINS AT 4 FEET TRENCH DEPTH = 7 FEET TRENCH WIDTH (W) = 3 FEET EFFECTIVE DEPTH (D) = 3 FEET 5F OF DRAINFIELD = 750 GPD / 1.2 = 625 5F COEFFICIENT OF REDUCTION OF TRENCH LENGTH = (W+2)/(W+1+2D)=(3+2)/(3+1+(2x3))=0.50TRENCH LENGTH = 208.33 SF x 0.50 = 104.17 FEET (USE 2 TRENCHES AT 52.08 L.F.) TRENCH SPACING = 2D+W = ((2*3) + 3) = 9' USE 10'

15T REPLACEMENT SYSTEM

SEWAGE DISPOSAL SYSTEM DATA, DESIGN FOR 5 BEDROOMS (PERMIT FOR 4 BEDROOMS) LOADING RATE = 5 BEDROOMS X 150 GPD/BEDROOM = 750 GPD APPLICATION RATE = 1.2 EFFECTIVE SIDEWALL BEGINS AT 4 FEET TRENCH DEPTH = 7 FEET TRENCH WIDTH (W) = 3 FEET EFFECTIVE DEPTH (D) = 3 FEET SF OF DRAINFIELD = 750 GPD / 1.2 = 625 SF COEFFICIENT OF REDUCTION OF TRENCH LENGTH = (W+2)/(W+1+2D)=(3+2)/(3+1+(2x3))=0.50TRENCH LENGTH = 208.33 SF x 0.50 = 104.17 FEET (USE 2 TRENCHES AT 52.08 L.F.) TRENCH SPACING = 2D+W = ((2*3) + 3) = 9' USE 10'

2ND REPLACEMENT SYSTEM
SEWAGE DISPOSAL SYSTEM DATA, DESIGN FOR 5 BEDROOMS (PERMIT FOR 4 BEDROOMS) LOADING RATE = 5 BEDROOMS X 150 GPD/BEDROOM = 750 GPD APPLICATION RATE = 1.2 EFFECTIVE SIDEWALL BEGINS AT 4 FEET TRENCH DEPTH = 7 FEET TRENCH WIDTH (W) = 3 FEET EFFECTIVE DEPTH (D) = 3 FEET SF OF DRANFIELD = 750 GPD / 1.2 = 625 SF COEFFICIENT OF REDUCTION OF TRENCH LENGTH = (W+2)/(W+1+2D)=(3+2)/(3+1+(2x3))=0.50TRENCH LENGTH = 208.33 SF x 0.50 = 104.17 FEET (USE 2 TRENCHES AT 52.08 L.F.) TRENCH SPACING = 2D+W = ((2*3) + 3) = 9' USE 10'

- 1. ANY CHANGE TO THE LOCATIONS OR DEPTHS TO ANY COMPONENTS MUST BE APPROVED BY THE ENGINEER AND THE HOWARD COUNTY HEALTH DEPARTMENT PRIOR TO INSTALLATION. A REVISED SITE PLAN MAY BE REQUIRED.
- 2. THE MAXIMUM EARTH COVER OVER THE TANK IS 3 FEET. GREATER EARTH COVER WILL REQUIRE A HEAVY LOAD BEARING TANK.
- 3. THE WELL HO-94-3854 HAS BEEN FIELD LOCATED AND IS ACCURATELY SHOWN. 4. ALL WELLS AND SEPTIC SYSTEMS LOCATED WITHIN 100' OF THE PROPERTY BOUNDARIES AND 200' DOWN GRADIENT OF ANY WELLS AND/OR SEPTIC SYSTEMS HAVE BEEN SHOWN.

LEGEND

---- EXISTING 2' CONTOURS

- - EXISTING 10' CONTOURS MEXISTING TREE LINE

> - SOIL LINES AND TYPES DENOTES EXISTING WELL

DENOTES PASSED PERC DENOTES 1500 Sq.Ft. ALTERNATE WELL SITE

> FFE 409.51 BSE 400.32 INV. OUT OF HOUSE = 406.12 PROP. GROUND AT CLEANOUT #1 = 407.7 INV. INTO CLEANOUT = 406.01 INV. OUT OF CLEANOUT = 405.91 EX. GROUND AT SEPTIC TANK = 410.0 PROP. GRADE ABOVE SEPTIC TANK = 407.5 TOP OF SEPTIC TANK = 406.62 INV. INTO SEPTIC TANK = 405.62 INV. OUT OF SEPTIC TANK = 405,37 EX. GROUND AT DISTRIBUTION BOX = 407.5 INV. INTO DISTRIBUTION BOX = 405.0 INV. OUT OF DISTRIBUTION BOX = 404.9

TRENCH WIDTH 3
FEET GEOTEXTILE FABFIC-EX. GROUND ABOVE = 407.5 INV. IN = 405.0BOTTOM TRENCH = 400.5 EX. GROUND ABOVE = 406.9 INV. IN = 404.4BOTTOM TRENCH = 399.9 4" PVC INV. INTO

INITIAL TRENCH DETAIL

TRENCH DATA:

TRENCH 1:

TRENCH 2:

SEPTIC SYSTEM INSTALLATION SITE PLAN RIVERCREST

15457 RIVERCREST COURT

ZONED: RC-DEO PLAT NO.: 24723 THRU 24725 TAX MAP NO.: 21 GRID NO.: 20 PARCEL NO.: 270 4TH ELECTION DISTRICT HOWARD COUNTY, MARYLAND SCALE: 1" = 50' DATE: JAN. 24, 2020

SHEET 1 OF 1

PROFESSIONAL CERTIFICATION I HEREBY CERTIFY THAT THESE DOCUMENTS WERE PREPARED OR APPROVED BY ME AND THAT I AM A DULY LICENSED PROFESSIONAL ENGINEER UNDER THE LAWS OF THE STATE OF MARYLAND, LICENSE NO. 20748, EXPIRATION DATE: 02/22/2020


BUILDER COLUMBIA BUILDERS, INC. P.O. BOX 999


COLUMBIA, MARYLAND 21044

OWNER ROXBURY FARM, LLC C/O COLUMBIA DEVELOPERS LLC 6420 AUTUMN SKY WAY COLUMBIA, MARYLAND 21044


410-730-3940

FISHER, COLLINS & CARTER, INC.
CIVIL ENGINEERING CONSULTANTS & LAND SURVEYORS

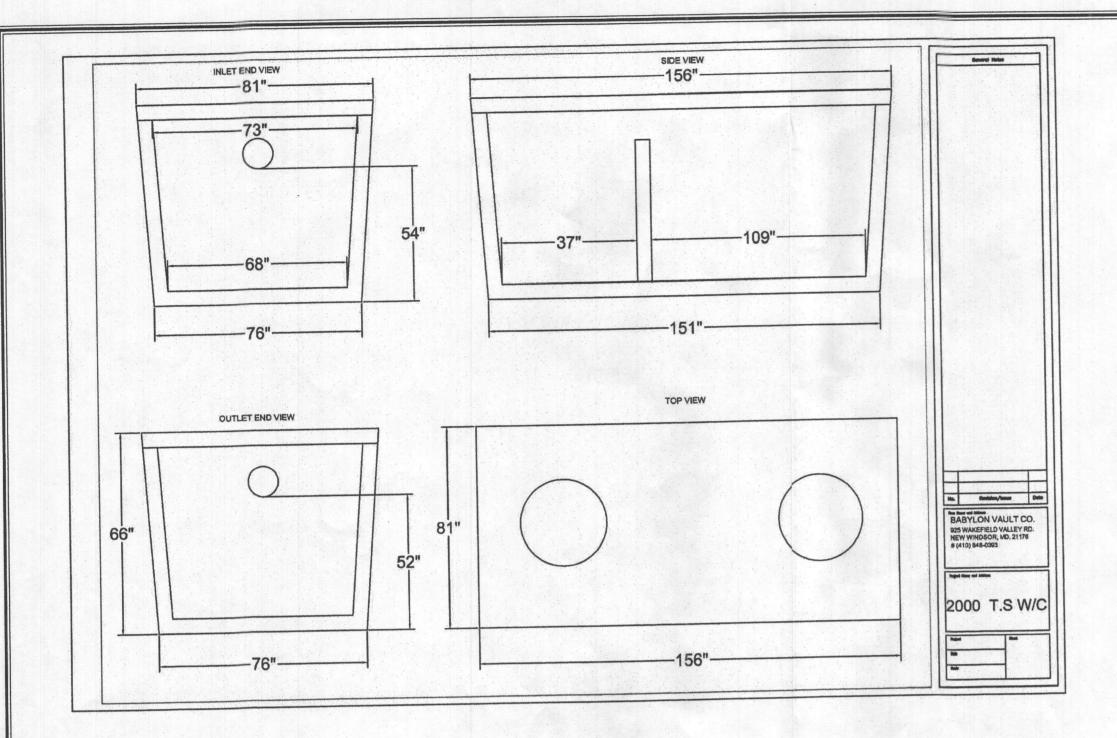

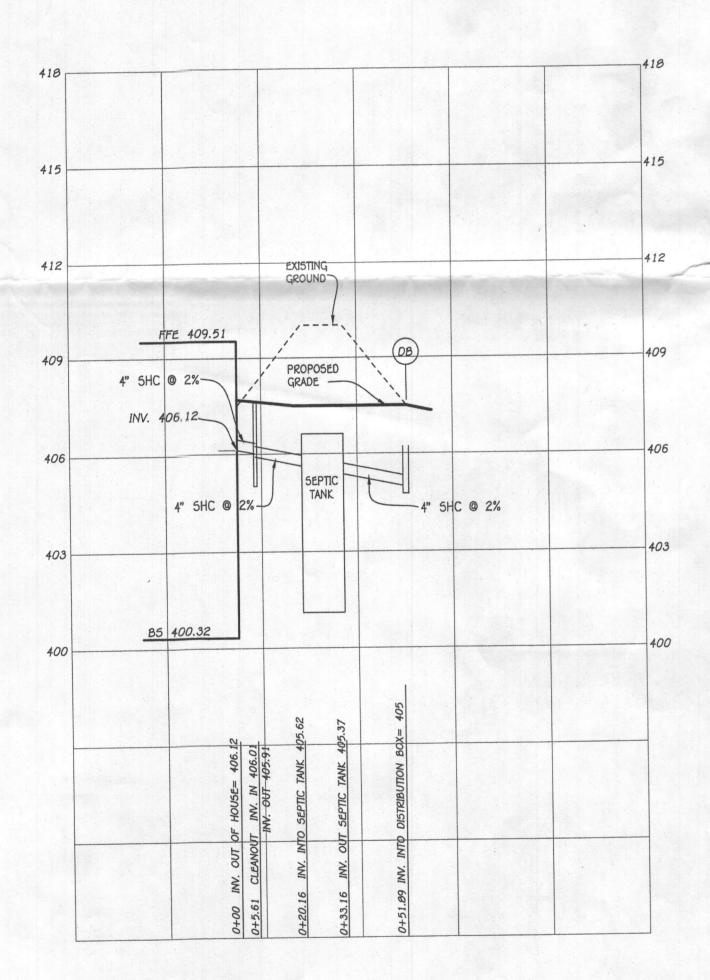

SEPTIC PROFILE

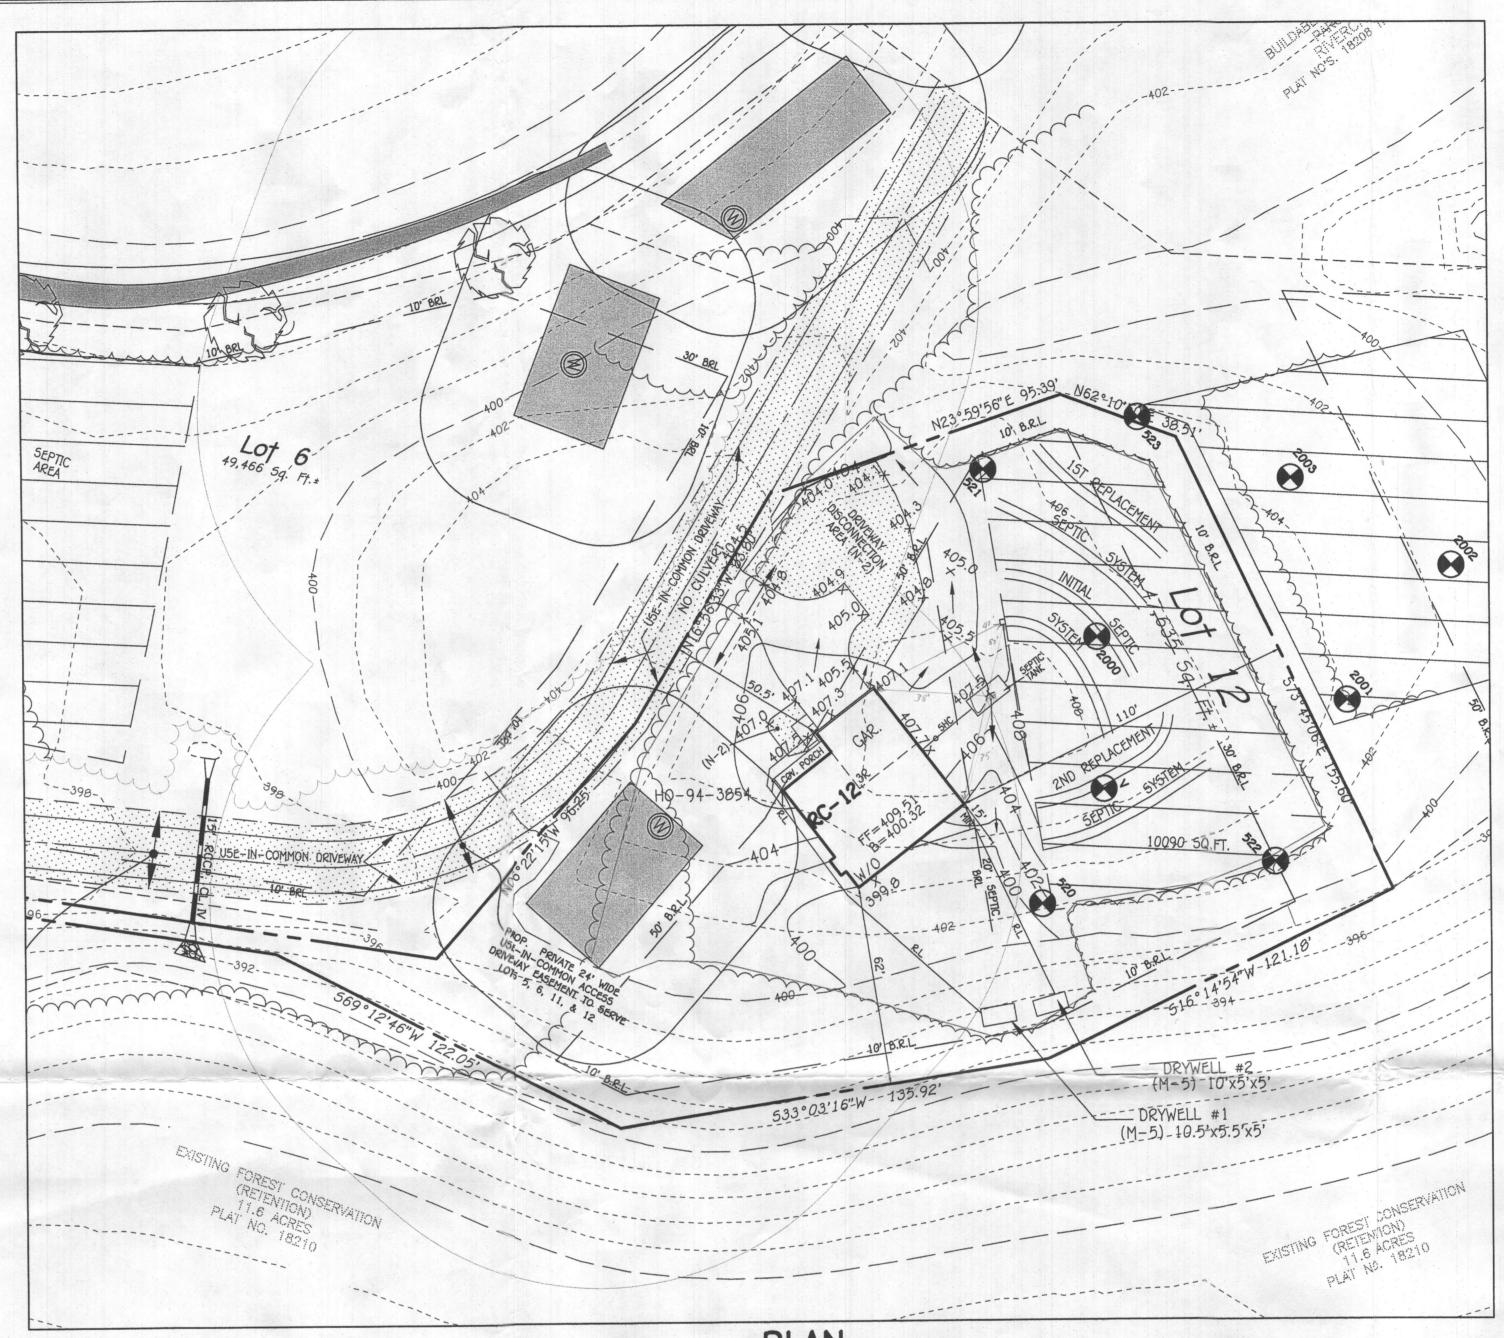

PLAN SCALE: 1" = 30'

INITIAL SYSTEM
SEWAGE DISPOSAL SYSTEM DATA, DESIGN FOR 5 BEDROOMS (PERMIT FOR 4 BEDROOMS) LOADING RATE = 5 BEDROOMS X 150 GPD/BEDROOM = 750 GPD APPLICATION RATE = 1.2 EFFECTIVE SIDEWALL BEGINS AT 4 FEET TRENCH DEPTH = 7 FEET TRENCH WIDTH (W) = 3 FEET EFFECTIVE DEPTH (D) = 3 FEET SF OF DRAINFIELD = 750 GPD / 1.2 = 625 SF COEFFICIENT OF REDUCTION OF TRENCH LENGTH = (W+2)/(W+1+2D)=(3+2)/(3+1+(2x3))=0.50TRENCH LENGTH = 208.33 SF x 0.50 = 104.17 FEET

TRENCH SPACING = 2D+W = ((2*3) + 3) = 9' USE 10'

15T REPLACEMENT SYSTEM

(USE 2 TRENCHES AT 52.08 L.F.)

SEWAGE DISPOSAL SYSTEM DATA, DESIGN FOR 5 BEDROOMS (PERMIT FOR 4 BEDROOMS) LOADING RATE = 5 BEDROOMS X 150 GPD/BEDROOM = 750 GPD APPLICATION RATE = 1.2 EFFECTIVE SIDEWALL BEGINS AT 4 FEET TRENCH DEPTH = 7 FEET TRENCH WIDTH (W) = 3 FEET EFFECTIVE DEPTH (D) = 3 FEET SF OF DRAINFIELD = 750 GPD / 1.2 = 625 SF COEFFICIENT OF REDUCTION OF TRENCH LENGTH = (W+2)/(W+1+2D)=(3+2)/(3+1+(2x3))=0.50TRENCH LENGTH = 208.33 SF x 0.50 = 104.17 FEET (USE 2 TRENCHES AT 52.08 L.F.) TRENCH SPACING = 20+W = ((2*3) + 3) = 9' USE 10'

2ND REPLACEMENT SYSTEM

SEWAGE DISPOSAL SYSTEM DATA, DESIGN FOR 5 BEDROOMS (PERMIT FOR 4 BEDROOMS) LOADING RATE = 5 BEDROOMS X 150 GPD/BEDROOM = 750 GPD APPLICATION RATE = 1.2 EFFECTIVE SIDEWALL BEGINS AT 4 FEET TRENCH DEPTH = 7 FEET TRENCH WIDTH (W) = 3 FEET EFFECTIVE DEPTH (D) = 3 FEET SF OF DRANFIELD = 750 GPD / 1.2 = 625 SF COEFFICIENT OF REDUCTION OF TRENCH LENGTH = (W+2)/(W+1+2D)=(3+2)/(3+1+(2x3))=0.50TRENCH LENGTH = 208.33 SF x 0.50 = 104.17 FEET (USE 2 TRENCHES AT 52.08 L.F.) TRENCH SPACING = 2D+W = ((2*3) + 3) = 9' USE 10'

1. ANY CHANGE TO THE LOCATIONS OR DEPTHS TO ANY COMPONENTS MUST BE APPROVED BY THE ENGINEER AND THE HOWARD COUNTY HEALTH DEPARTMENT PRIOR TO INSTALLATION. A REVISED SITE PLAN MAY BE REQUIRED.

OWNER

ROXBURY FARM, LLC

C/O COLUMBIA DEVELOPERS ILC

6420 AUTUMN SKY WAY

COLUMBIA, MARYLAND 21044

410-730-3940

A HEAVY LOAD BEARING TANK. 3. THE WELL HO-94-3854 HAS BEEN FIELD LOCATED AND IS ACCURATELY SHOWN. 4. ALL WELLS AND SEPTIC SYSTEMS LOCATED WITHIN 100' OF THE PROPERTY BOUNDARIES AND 200' DOWN GRADIENT OF ANY WELLS AND/OR SEPTIC SYSTEMS HAVE BEEN SHOWN.

2. THE MAXIMUM EARTH COVER OVER THE TANK IS 3 FEET. GREATER EARTH COVER WILL REQUIRE

VICINITY MAP SCALE: 1" = 2000'

LEGEND

---- EXISTING 2' CONTOURS

- - EXISTING 10' CONTOURS


MEXISTING TREE LINE

- SOIL LINES AND TYPES DENOTES EXISTING WELL

DENOTES PASSED PERC

DENOTES 1500 Sq.Ft. ALTERNATE WELL SITE

FFE 409.51 BSE 400.32 INV. OUT OF HOUSE = 406.12 PROP. GROUND AT CLEANOUT #1 = 407.7 INV. INTO CLEANOUT = 406.01 INV. OUT OF CLEANOUT = 405.91 EX. GROUND AT SEPTIC TANK = 410.0 PROP. GRADE ABOVE SEPTIC TANK = 407.5 TOP OF SEPTIC TANK = 406.62 INV. INTO SEPTIC TANK = 405.62 INV. OUT OF SEPTIC TANK = 405.37 EX. GROUND AT DISTRIBUTION BOX = 407.5 INV. INTO DISTRIBUTION BOX = 405.0 INV. OUT OF DISTRIBUTION BOX = 404.9

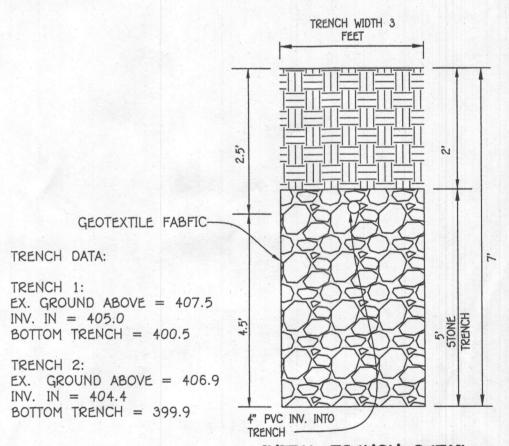

INITIAL TRENCH DETAIL

TRENCH 1:

TRENCH 2:

SEPTIC SYSTEM INSTALLATION SITE PLAN RIVERCREST

15457 RIVERCREST COURT

PLAT NO.: 24723 THRU 24725 ZONED: RC-DEO TAX MAP NO.: 21 GRID NO.: 20 PARCEL NO.: 270 4TH ELECTION DISTRICT HOWARD COUNTY, MARYLAND DATE: JAN. 24, 2020 SCALE: 1" = 50'

SHEET 1 OF 1



PROFESSIONAL CERTIFICATION I HEREBY CERTIFY THAT THESE DOCUMENTS WERE PREPARED OR APPROVED BY ME AND THAT I AM A DULY LICENSED PROFESSIONAL ENGINEER UNDER THE LAWS OF

THE STATE OF MARYLAND, LICENSE NO. 20740, EXPIRATION DATE: 02/22/2020



BUILDER COLUMBIA BUILDERS, INC. P.O. BOX 999 COLUMBIA, MARYLAND 21044 443-324-4732

FISHER, COLLINS & CARTER, INC.