

APPLICATION

A 07566

SEWAGE DISPOSAL TESTING

P _____

MARYLAND STATE DEPARTMENT OF HEALTH

HOWARD COUNTY

ELLICOTT CITY

ONE ADDITIONAL DRY WELL CONNECTED
IN SERIES WITH OLD DRY WELLDISTRICT 5

NEW DRY WELL TO HAVE 300 SQ FT

DATE 10-14-63

SIDE WALL AREA BELOW THE INLET

Place the new dry well 138 ft to 158 ft from
the front lot line and 20 ft to 40 ft from
the right side of the lot as seen when
facing the lot from Route 216

TO: THE COUNTY HEALTH OFFICER
ELLICOTT CITY, MARYLANDI, HEREBY, APPLY FOR THE NECESSARY TESTS IN ORDER TO CONSTRUCT (OR RECONSTRUCT) A SEWAGE
DISPOSAL SYSTEM.PROPERTY OWNER Arthur EyreADDRESS Brown Bridge Rd. Highland PHONE _____

PROPERTY LOCATION:

SUBDIVISION _____ LOT NO. _____

ROAD AND DESCRIPTION Brown Bridge Rd - approx 500 yards
from Rt 216 on left. Between Brown Bridge Rd
and Highland

OCCUPANT _____ PHONE _____

PERSON TO CONSTRUCT SYSTEM _____

ADDRESS _____ PHONE _____

SIZE OF LOT 210' X 180' TYPE BLDG. 3 TOTAL

NUMBER OF BEDROOMS

IF NOT SINGLE RESIDENCE DESCRIBE addition to present dwelling
ONE EXTRA BEDROOM IN ADDITION ALREADY 2 BEDROOMS
IN HOUSESIGNATURE OF APPLICANT Le Roy W BrownAPPROVED BY Raymond Hodges FOR Dry Well DATE 15 Oct 63

(KIND OF SYSTEM)


REJECTED BY _____ FOR _____ DATE _____

(KIND OF SYSTEM)

HOLD PENDING FURTHER TESTS _____ DATE _____

REASONS FOR REJECTION OR HOLDING _____

THIS IS NOT A PERMIT

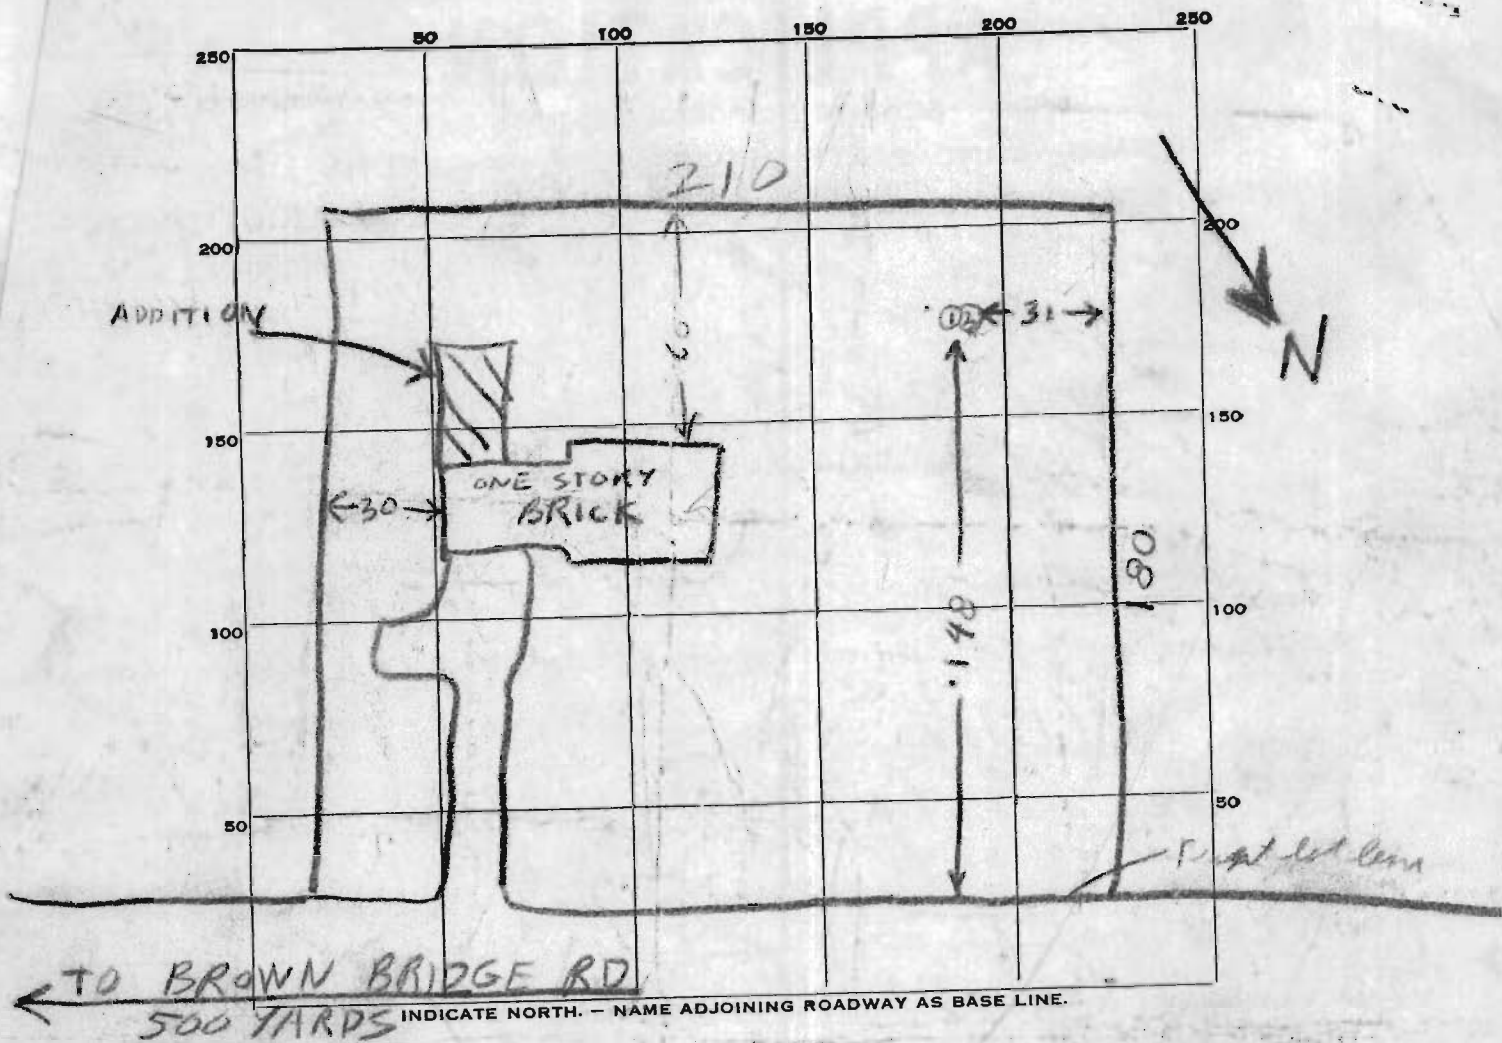


DATE	TEST NO.	DEPTH	PRE-WET		TEST - 1" DROP		TIME
			START	STOP	START	STOP	
10-15-63	1	9 1/2	1258	100	100	103	3
150d/63	2	5	105	110	110	120	10

SOIL AUGER FINDING

TESTED BY Raymond Hodges

REMARKS 750 Gallon tank

ALSO PRESENT Le Roy W. Brown LOT NO.

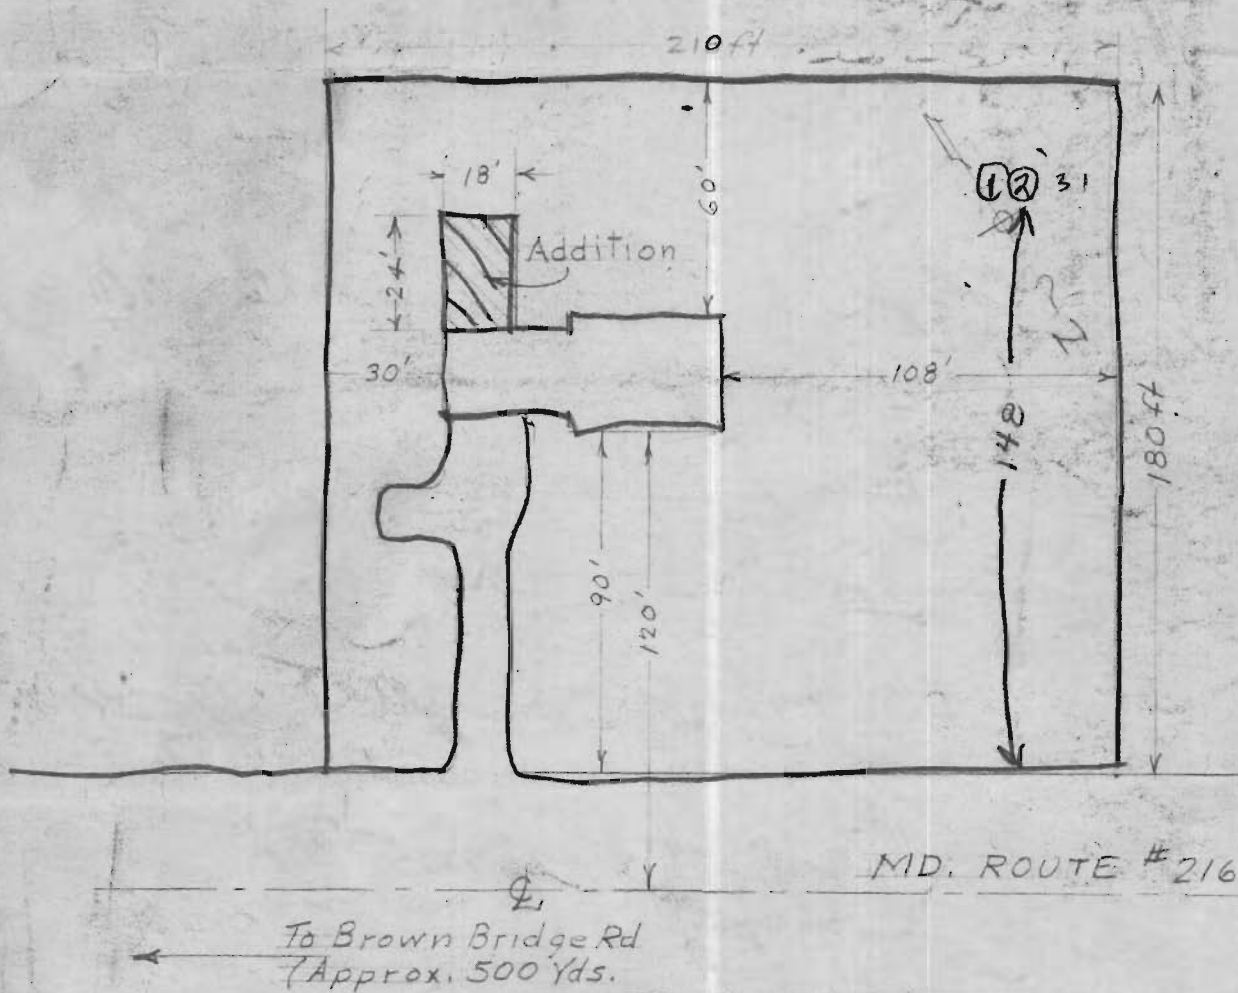

PLOT PLAN
Scale 1" = 50'-0"

① & ② = PERCOLATION TEST HOLES

Arthur Eyre
Rt 216
Highland