

05-349524

PERMIT

SEWAGE DISPOSAL SYSTEM

MARYLAND STATE DEPARTMENT OF HEALTH*

P 39024A REPAIR

HOWARD COUNTY

BUREAU OF ENVIRONMENTAL HEALTH
461-9933

INDEXED

DATE

DATE SYSTEM APPROVED

INSPECTOR

3/30/87C. WilliamsZeppIS PERMITTED TO INSTALL ALTER X

ADDRESS

PHONE

SUBDIVISION

ROAD 12523 Scaggsville Rd LOT

PROPERTY OWNER

Arthur Eyres12523 Scaggsville Road

ADDRESS

IF GARBAGE GRINDER IS USED INCREASE SEPTIC TANK CAPACITY BY 50% AND ABSORPTION AREA BY 22%.

GARBAGE GRINDER?

YES

NO

SEPTIC TANK CAPACITY

GALLONS

NUMBER OF BEDROOMS

REPAIR - CALL FOR INSPECTION WHEN GROUND IS OPENED UP SO SANITARIAN CAN RECOMMEND REPAIR.

BUILDING PERMIT SIGNED

AND RETURNED

3-16-85 BOD 152772 - DECKON - 10-2-87

PLANS APPROVED BY

C. Williams

DATE

3/30/87

COVER NO WORK UNTIL INSPECTED AND APPROVED.

NEITHER THE HOWARD COUNTY COUNCIL NOR THE HEALTH DEPARTMENT IS RESPONSIBLE FOR THE SUCCESSFUL OPERATION OF ANY SYSTEM.

NOTE: CLEANOUT REQUIRED EVERY 70 FEET OF SEWER LINE AND/OR AT 90° SWEEPS IN LINES FROM HOUSE TO DRAIN FIELDS.

NOTE: ALL PARTS OF SEPTIC SYSTEMS (I.E., TANK, DISTRIBUTION BOX, TRENCHES) TO BE 100 FEET FROM WELL (UNLESS OTHERWISE SPECIFICALLY AUTHORIZED)

NOTE: IF DEEP TRENCH(ES) ARE USED CALL FOR INSPECTION BEFORE AND AFTER PLACING GRAVEL IN TRENCH(ES).

NOTE: NO DRY WELL SHALL EXCEED 15 FOOT IN DIAMETER. NO ABSORPTION TRENCH TO EXCEED 100 FEET IN LENGTH.

NOTE: ALL PIPE FROM HOUSE TO SEPTIC TANK MUST BE CAST IRON OR SCHEDULE 40 PVC OR ABS.

PERMIT VOID AFTER TWO YEARS.

NOTE: INSTALL STAND PIPE ON SEPTIC TANK AND DRY WELL. STAND PIPES MUST BE 6 INCHES IN DIAMETER. CAST IRON, CONCRETE OR TERRA COTTA OR PVC OR ABS ACCEPTED. IF TOP OF SEPTIC TANK IS DEEPER THAN 3 FEET, MANHOLE TO GRADE REQUIRED.


NOTE: DISTRIBUTION BOXES MUST HAVE BAFFLES.

*INSTALLER IS RESPONSIBLE FOR OBTAINING FINAL APPROVAL ON THIS PERMIT

*CALL 461-9933 FOR INSPECTION OF SEPTIC SYSTEMS.

EH - 2-1186

P 39024

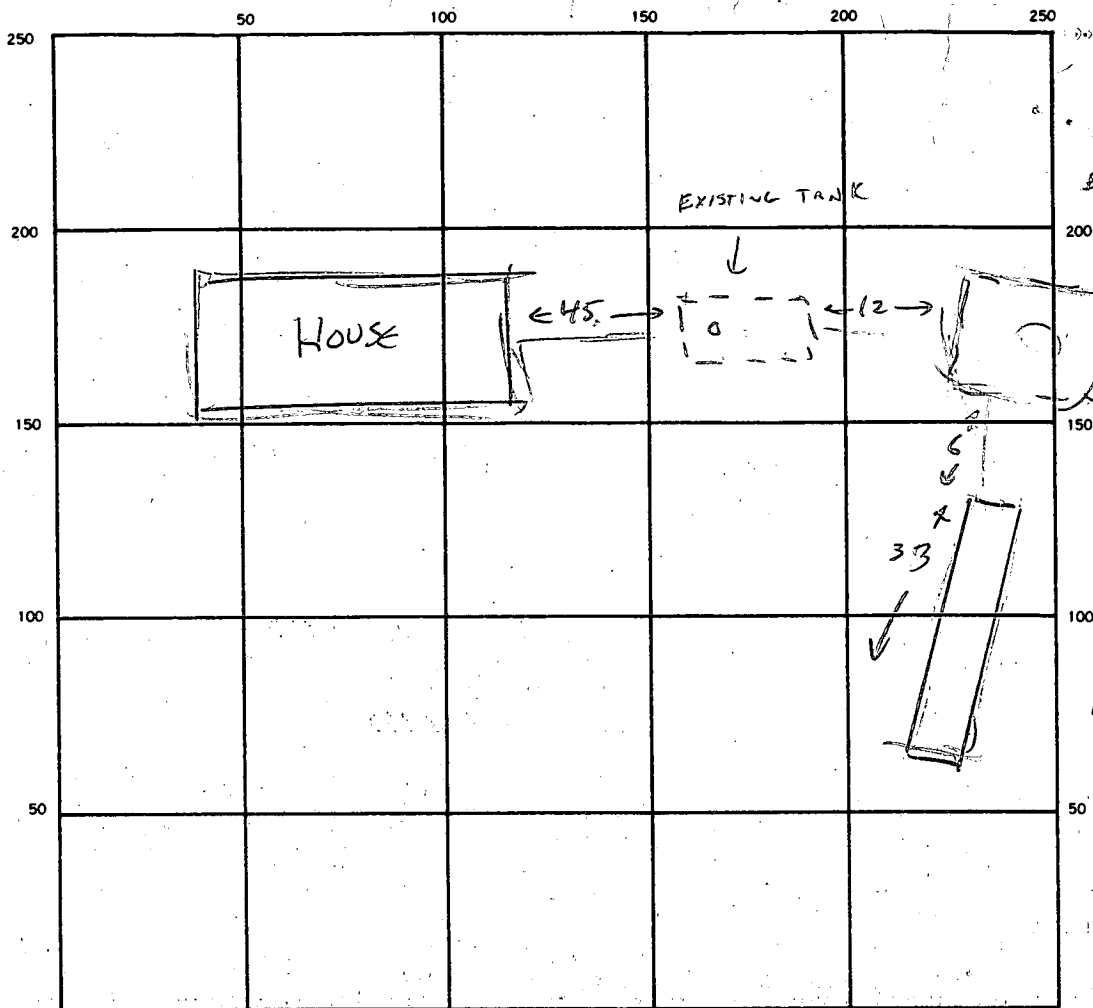

INDICATE NORTH. — NAME ADJOINING ROADWAY AS BASE LINE.

BUILDING PERMIT SIGNED
AND RETURNED

SEPTIC TANK, LEVEL EXISTING CLEANOUTS ST & DW - CLEANOUTS ADDED

DISTRIBUTION BOX, LEVEL N/A

DRAIN FIELD/TILE FIELD, DEPTH 15 FT. TRENCH WIDTH 2 FT. INLET DEPTH 5 FT. 32
32

EFFECTIVE GRAVEL DEPTH 11 FT. TOTAL LENGTH 33 FT.

NUMBER OF TRENCHES 1 ONE SIDEWALL/BOTTOM AREA 360 SQ. FT.

DRYWELL INSIDE DIAMETER — FT. EFFECTIVE DEPTH BELOW INLET — FT.

ABSORBENT AREA 360 SQ. FT. + EXISTING DRYWELL

REMARKS 3/30/87 CONTRACTOR REPLACED ORANBBURG LINE WITH CAST IRON,
REPLACED CLEANOUTS & BAFFLES,
TRENCH DUG OVER WEEKEND - EMERGENCY REPAIR,
DUG TO 15' PER CONTRACTOR, COVERED BEFORE INSP.
SOIL LOOKS VERY LOAMY, NO ROCK.

DATE SYSTEM APPROVED 3/30/87 INSPECTOR C. Melton