

C1 1908

SEQUENCE NO.
(MDE USE ONLY)STATE OF MARYLAND
WELL COMPLETION REPORT
FILL IN THIS FORM COMPLETELY
PLEASE TYPETHIS REPORT MUST BE SUBMITTED AFTER
WELL IS COMPLETED. OK 10/14/99COUNTY
NUMBER A39024ST/CO USE ONLY
DATE Received

09 13 99

DATE WELL COMPLETED

MM 8 26 99

Depth of Well

22 200' 26
(TO NEAREST FOOT)PERMIT NO.
FROM "PERMIT TO DRILL WELL"

HO 94 2372

OWNER Bodnyk

STREET OR RFD

12523 Scaggsville Rd

TOWN

Highland

SUBDIVISION

SECTION

LOT

WELL LOG

Not required for driven wells

GROUTING RECORD

WELL HAS BEEN GROUTED
(Circle Appropriate Box)yes
Y N
44 44

TYPE OF GROUTING MATERIAL (Circle one)

CEMENT

BENTONITE CLAY

BC

NO. OF BAGS

NO. OF POUNDS

GALLONS OF WATER

114

DEPTH OF GROUT SEAL (to nearest foot)

from 0 ft. to 55 ft.
(enter 0 if from surface)

CASING RECORD

casing
types
insert
appropriate
code
belowST
STEELCO
CONCRETEPL
PLASTICOT
OTHERMAIN
CASING
TYPE
STNominal diameter
top (main) casing
(nearest inch)

6

Total depth
of main casing
(nearest foot)

60

OTHER CASING (if used)

diameter depth (feet)

inch from to

screen type
or open hole

SCREEN RECORD

(insert
appropriate
code
below)ST
STEELBR
BRASSHO
OPEN
HOLEPL
PLASTICOT
OTHER

NUMBER OF UNSUCCESSFUL WELLS: 0

WELL HYDROFRACTURED

yes

Y

no

N

CIRCLE APPROPRIATE LETTER

- A A WELL WAS ABANDONED AND SEALED
WHEN THIS WELL WAS COMPLETED
- E ELECTRIC LOG OBTAINED
- P TEST WELL CONVERTED TO PRODUCTION
WELL

I HEREBY CERTIFY THAT THIS WELL HAS BEEN CONSTRUCTED IN
ACCORDANCE WITH COMAR 26.04.04 "WELL CONSTRUCTION" AND
IN CONFORMANCE WITH ALL CONDITIONS STATED IN THE ABOVE
CAPTIONED PERMIT, AND THAT THE INFORMATION PRESENTED
HEREIN IS ACCURATE AND COMPLETE TO THE BEST OF MY
KNOWLEDGE.

DRILLERS LIC. NO. 1 M S D 24

DRILLERS SIGNATURE

(MUST MATCH SIGNATURE ON APPLICATION)

LIC. NO. 1 D

GRAVEL PACK
IF WELL DRILLED
WAS FLOWING WELL
INSERT P IN BOX 68MDE USE ONLY
(NOT TO BE FILLED IN BY DRILLER)

(E.R.O.S.)

70

72

74 75 76

TELESCOPE
CASINGLOG
INDICATOR

OTHER DATA

SITE SUPERVISOR (sign. of driller or journeyman
responsible for sitework if different from permittee)

PUMPING TEST

HOURS PUMPED (nearest hour)

3

PUMPING RATE (gal. per min.)

15

METHOD USED TO
MEASURE PUMPING RATE

air

WATER LEVEL (distance from land surface)

BEFORE PUMPING

48 ft.

WHEN PUMPING

148 ft.

TYPE OF PUMP USED (for test)

A air

P piston

T turbine

C centrifugal

R rotary

O other
(describe
below)

J jet

S submersible

PUMP INSTALLED

DRILLER INSTALLED PUMP
(CIRCLE) (YES OR NO)

YES NO

IF DRILLER INSTALLS PUMP, THIS SECTION
MUST BE COMPLETED FOR ALL WELLS.TYPE OF PUMP INSTALLED
PLACE (A,C,J,P,R,S,T,O)
IN BOX 29CAPACITY
GALLONS PER MINUTE
(to nearest gallon)

31

35

PUMP HORSE POWER

37

41

PUMP COLUMN LENGTH
(nearest ft.)

43

47

CASING HEIGHT (circle appropriate box
and enter casing height).

+ above

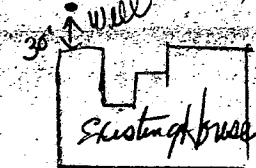
LAND SURFACE

- below

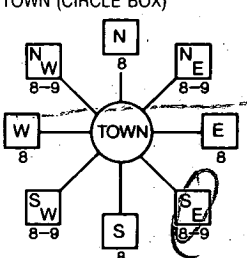
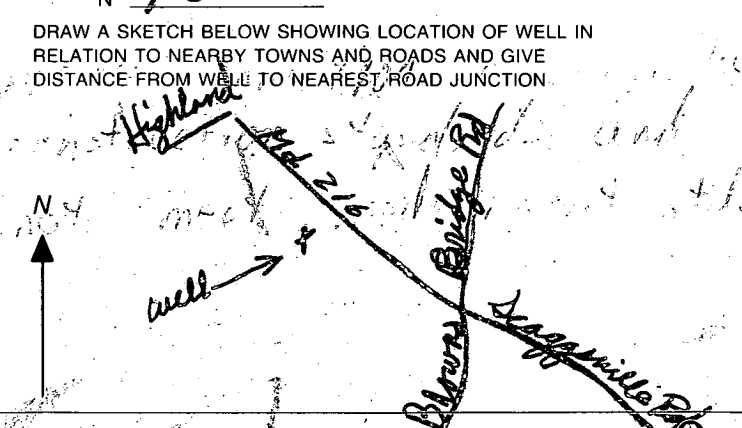
2

(nearest
foot)

LOCATION OF WELL ON LOT

SHOW PERMANENT STRUCTURES
AND INDICATE NOT LESS THAN
TWO DISTANCES
(MEASUREMENTS TO WELL)

H216

B 1 14396 09.13.99	SEQUENCE NO. (MDE USE ONLY)	STATE OF MARYLAND PERMIT TO DRILL WELL please print or type	STATE PERMIT NUMBER HO-94-2372 fill in this form completely
Date Received (ABA) 0820 99 OWNER INFORMATION 8 MM DD YY 13 Bodnyk Ann 15 Last Name Owner First Name 34 12523 Rt 216 36 Highland Md 20777 57 Town 70 State 72 Zip 76		B 3 LOCATION OF WELL 8 COUNTY 21 23 SUBDIVISION 42 SECTION 44 46 LOT 48 50 Highland 52 NEAREST TOWN 71 MILES FROM TOWN (enter 0 if in town) 1.12 M 11 73 0126/27/78/1/99	
DRILLER INFORMATION Joseph L. Mayne MS D 24 Driller's Name 76 License No. 81 Joseph L. Mayne Well Drilling Firm Name 551 Z Ridge Rd Mt. Airy Md 21771 Address Joseph L. Mayne 8/20/99 Signature Date		B 4 1 2 DIRECTION OF WELL FROM TOWN (CIRCLE BOX)  ON WHICH SIDE OF ROAD (CIRCLE APPROPRIATE BOX) NORTH N WEST W EAST E SOUTH S 34 130 37 DISTANCE FROM ROAD ENTER FT OR MI 38 39 TAX MAP: _____ BLK: _____ PARCEL: _____	
B 2 WELL INFORMATION 1 2 APPROX. PUMPING RATE (GAL. PER MIN.) 5 8 12 AVERAGE DAILY QUANTITY NEEDED (GAL. PER DAY) 500 14 20		NOT TO BE FILLED IN BY DRILLER HEALTH DEPARTMENT APPROVAL Howard Co A 39024 COUNTY NAME COUNTY NO. STATE SIGNATURE INSERT S → 41 DATE ISSUED 082099 A M. Mullen 082000 43 MM DD YY 48 CO SIGNATURE EXP. DATE NORTH GRID 480 000 EAST GRID 810 000 50 55 57 63	
USE FOR WATER (CIRCLE APPROPRIATE BOX) ☒ DOMESTIC POTABLE SUPPLY & RESIDENTIAL IRRIGATION ☐ FARMING (LIVESTOCK WATERING & AGRICULTURAL IRRIGATION) 22 ☐ INDUSTRIAL, COMMERCIAL, DEWATERING ☐ PUBLIC WATER SUPPLY WELL ☐ TEST, OBSERVATION, MONITORING ☐ GEO-THERMAL		SHOW MAJOR FEATURES OF BOX & LOCATE WELL WITH AN X SOURCES OF DRILLING WATER 1. well 2. 3. WRITE THE BOX-NUMBER FROM THE MAP HERE only E 810 226 N 480 000 000	
APPROXIMATE DEPTH OF WELL 311005 8005772- D586 24 28 FEET APPROXIMATE DIAMETER OF WELL 6 NEAREST INCH		8/26/99 9200 NO INST MR	
METHOD OF DRILLING (circle one) 30 BORED (or Augered) JETTED Jetted & DRIVEN AIR-ROTARY AIR-PERCussion ROTARY (Hydraulic Rotary) 37 CABLE REVERSE-ROTARY Drive-POINT other _____		DRAW A SKETCH BELOW SHOWING LOCATION OF WELL IN RELATION TO NEARBY TOWNS AND ROADS AND GIVE DISTANCE FROM WELL TO NEAREST ROAD JUNCTION. 	
REPLACEMENT OR DEEPENED WELLS (CIRCLE APPROPRIATE BOX) ☐ THIS WELL WILL NOT REPLACE AN EXISTING WELL ☐ THIS WELL WILL REPLACE A WELL THAT WILL BE ABANDONED AND SEALED 39 ☒ THIS WELL WILL REPLACE A WELL THAT WILL BE USED AS A STANDBY CONTACT LOCAL APPROVING AUTHORITY FOR POLICY ON STANDBY WELLS ☐ THIS WELL WILL DEEPEAN AN EXISTING WELL PERMIT NUMBER OF WELL TO BE REPLACED OR DEEPEANED (IF AVAILABLE) 41 _____ 52		Not to be filled in by driller (MDE OR COUNTY USE ONLY) APPROP. PERMIT NUMBER 54 _____ G A P 63 PERMIT No. HO-94-2372 70 71 72 73 74 75 76 77 78 79	
SPECIAL CONDITIONS NOTE - APPROVING AUTHORITIES SHOULD USE SEPARATE SHEET IF NEEDED -			

8/20/99
12:30 meet driller

SITE INSPECTION SHEET

OWNER: Broadnick

DATE REQUESTED: 8/19/99

ADDRESS: 12523 Scaggsville Rd

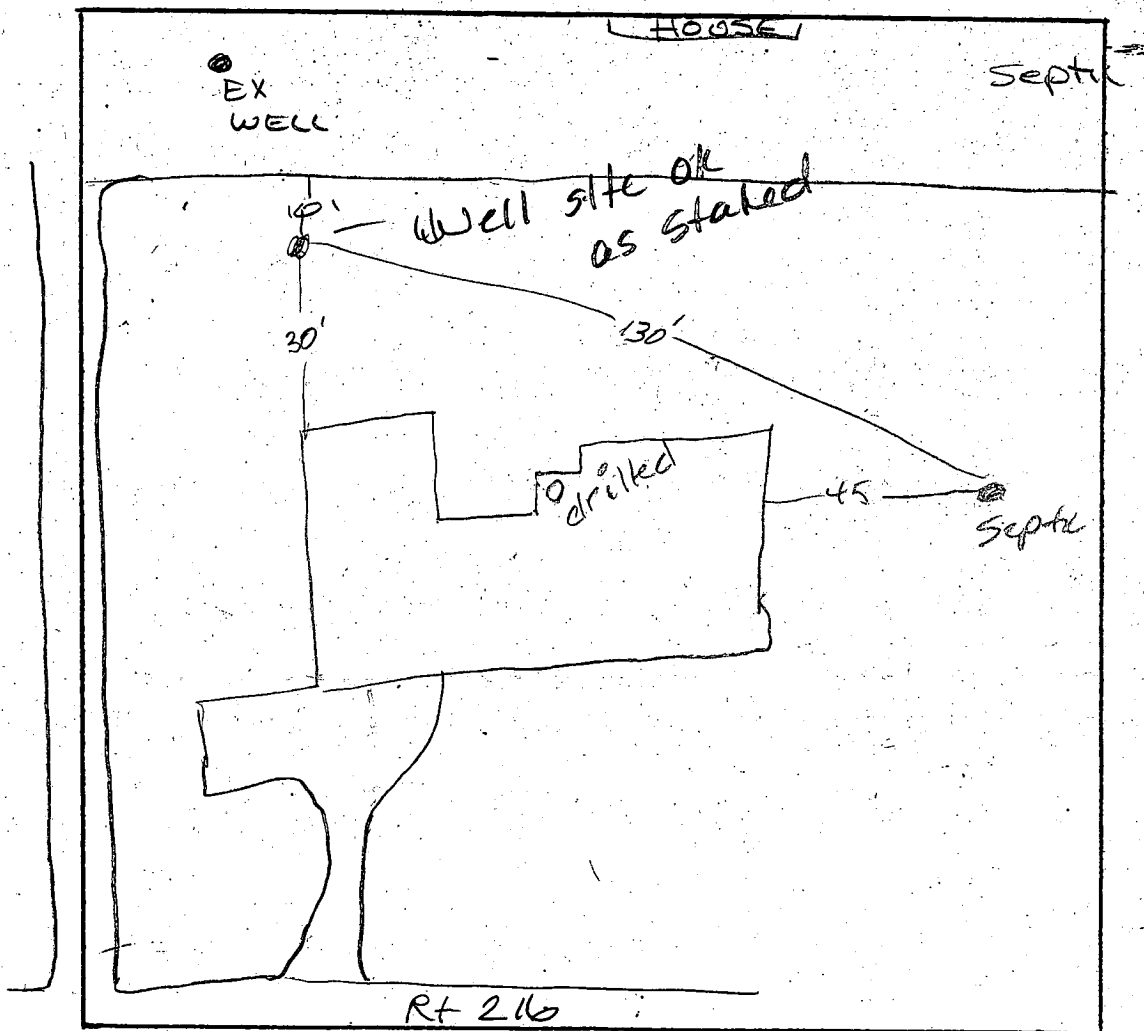
DRILLER: Joseph Mayne

WELL TAG # _____

COUNTY # _____

PROPOSAL: Replacement Well Site

LOCATION DIAGRAM



COMMENTS: 8/20/99 Owner has drilled well in basement that would be too difficult to abandon so the two wells will be hooked up together

DATE: 8/20/99

INSPECTOR: A. McMill