

PRELIMINARY

APPLICATION

18841

SEWAGE DISPOSAL TESTING

STATE OF MARYLAND - DEPARTMENT OF HEALTH AND MENTAL HYGIENE

HOWARD COUNTY HEALTH DEPARTMENT
ENVIRONMENTAL HEALTH SERVICES

P. O. BOX 476, ELLICOTT CITY, MARYLAND 21043
TELEPHONE: 469-3000, EXT. 356

DISTRICT 3rd

DATE 8/3/73

TO: THE COUNTY HEALTH OFFICER
ELLICOTT CITY, MARYLAND

I, HEREBY, APPLY FOR THE NECESSARY TEST IN ORDER TO CONSTRUCT (OR RECONSTRUCT) A SEWAGE DISPOSAL SYSTEM.

PROPERTY OWNER G. Albert Scheel, Jr.

ADDRESS 12845 Triadelphia Road, Ellicott City, Md. PHONE Boender - 465-7777

PROPERTY LOCATION:

SUBDIVISION Wayside Estates LOT NO. 7, Blk. B, Sect. 1

ROAD AND DESCRIPTION Wayside Drive

SIZE OF LOT 1 acre

TYPE BLDG. 3 or 4 bedrooms
NUMBER OF BEDROOMS

IF NOT SINGLE RESIDENCE DESCRIBE _____

THE SYSTEM INSTALLED UNDER THIS APPLICATION IS ACCEPTABLE ONLY UNTIL PUBLIC FACILITIES BECOME AVAILABLE.

SIGNATURE OF APPLICANT /s/ G. Albert Scheel, Jr.

APPROVED BY _____ FOR _____ DATE _____
(KIND OF SYSTEM)

REJECTED BY _____ FOR _____ DATE _____
(KIND OF SYSTEM)

HOLD PENDING FURTHER TESTS _____ DATE _____


REASONS FOR REJECTION OR HOLDING _____

THIS IS NOT A PERMIT

TABLE

APPLICATION

MANHOLE

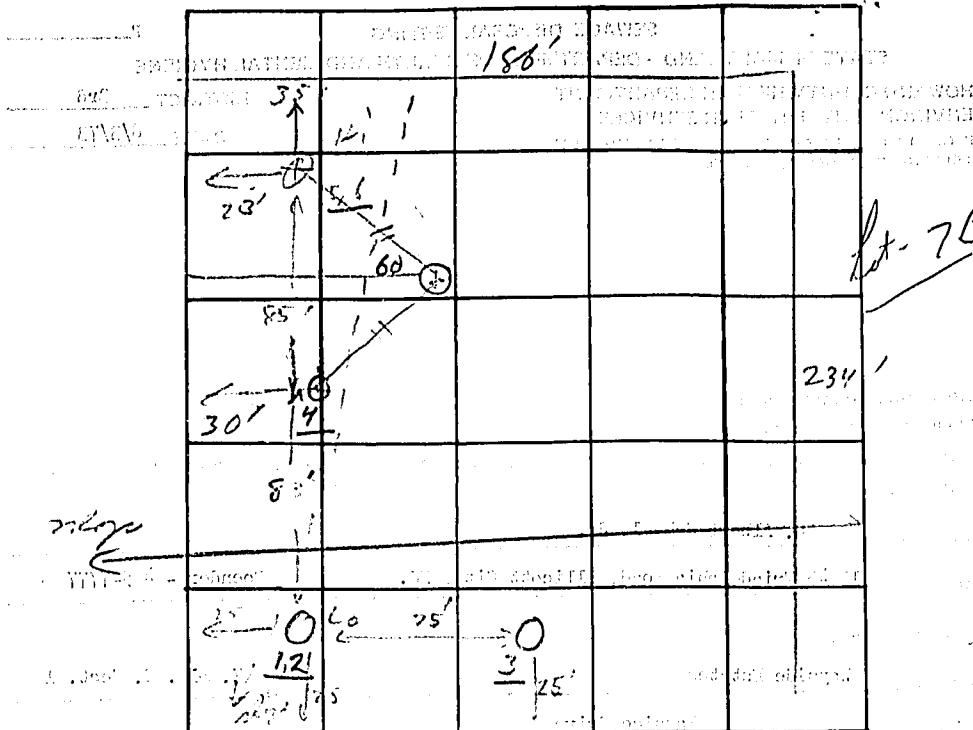

INDICATE NORTH - NAME ADJOINING ROADWAY AS BASE LINE

Weymouth Dr. to Trudolphin →

DATE	TEST NO.	DEPTH	PRE-WET		TEST - 1" DROP		TIME
			START	STOP	START	STOP	
8/15	1	3	11:51	11:52	11:52	11:53	1
	2	12	11:50	11:55	11:55	12:08	13
	3	11'	11:55	12:00	12:00	12:05	5
	4	12'	12:00	12:05	12:05	12:10	5
	5	12	12:19	12:23	12:23	12:41	18
✓	6	3	12:20	12:22	12:22	12:24	2
8/22	7	10	12:25	12:30	12:30	12:35	5

REMARKS

TYPE OF SOIL

Mudaceous

Arteries
- 9mm
max
Depth