

PERMIT

SEWAGE DISPOSAL SYSTEM

MARYLAND STATE DEPARTMENT OF HEALTH

HOWARD COUNTY

ELLICOTT CITY

DISTRICT 3rd

DATE 4/11/77

INDEXED

Albert School

IS PERMITTED TO INSTALL ☒ ALTER

ADDRESS 3620 School Drive, Ellicott City, Md. 21043 PHONE 531-6677

A SEWAGE DISPOSAL SYSTEM LOCATED AT

SUBDIVISION Wayside Estates

3604 School Drive
Wayside Drive

LOT 7, Blk. B, Sec. 1

PROPERTY OWNER Albert School

DAVE & Robin Murray

ADDRESS same as above

SPECIFICATIONS 3 bedrooms

DRAIN FIELD _____ DEPTH _____ FEET, BOTTOM AREA _____ SQ. FT.

SEEPAGE PITS _____ ABSORBENT SIDE-WALL AREA _____ SQ. FT.

SEPTIC TANK CAPACITY 1000 GALLONS

FOR GARBAGE GRINDER, INCREASE DISPOSAL AREA 22% & TANK CAPACITY 50%.

OTHER DRY WELL AND TRENCH - The dry well will be located 25 ft. from the front property line and 85 ft. in from the right property line. The invert will be 3 ft. below original grade with a maximum depth of 10 ft. below original grade. The dry well will be 15' x 15' square and 10 ft. deep for a total sidewall area of 420 sq. ft. The trench will begin 5 ft. from the edge of the dry well and follow the contour of the land. The trench will be 2 ft. wide, 10 ft. deep, 25 ft. long, and have 7 ft. of stone. Lot line determined as you face from the road. NOTE: CALL FOR INSPECTION BEFORE PLACING STONE IN TRENCH. NOTE: ALL PIPE FROM HOUSE TO DISPOSAL AREA MUST BE CAST IRON. PERMIT VOID AFTER THREE YEARS. NOTE: INSTALL STAND PIPE ON SEPTIC TANK AND DRY WELL. STAND PIPES MUST BE 6 INCHES IN DIAMETER. CAST IRON, CONCRETE OR

PLANS APPROVED BY Robert T. Moorefield

DATE 1/3/76

TERRA COTTA ACCEPTED.

FILL SEPTIC TANK AND DISTRIBUTION BOX WITH WATER BEFORE CALLING FOR AN INSPECTION. COVER NO WORK UNTIL INSPECTED AND APPROVED.

NEITHER THE HOWARD COUNTY COMMISSIONERS NOR THE HEALTH DEPARTMENT IS RESPONSIBLE FOR THE SUCCESSFUL OPERATION OF ANY SYSTEM.


BEG. PERMIT SIGNED AND RETURNED

12/28/77
Serial # 30915
extension of existing, kldkr

18841

INSTRUCTIONS

DATE SYSTEM APPROVED

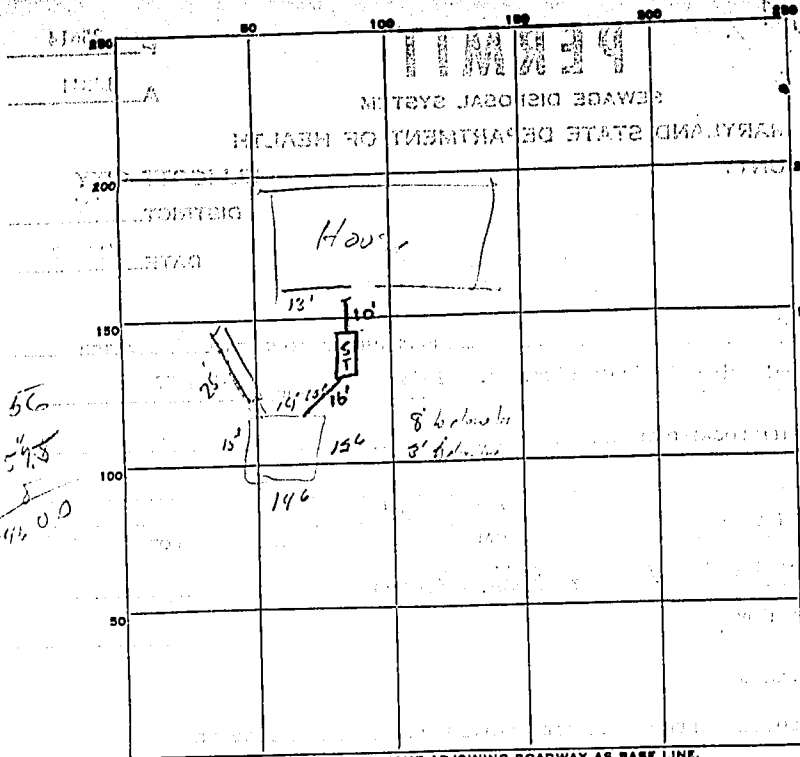

INDICATE NORTH. - NAME ADJOINING ROADWAY AS BASE LINE.

PERMIT CARD Partial Adm

SEPTIC TANK, LEVEL 1000

CLEANOUTS ST DW
N.1 ✓ ✓

DISTRIBUTION BOX, LEVEL 11.4

TILE FIELD, DEPTH 11-12 FT. TRENCH WIDTH 2 FT.

GRAVEL DEPTH 7 1/2 FT (9' eff. depth) IN. TOTAL LENGTH 25' FT.

NUMBER OF TRENCHES 1 SIDEWALL TOTAL BOTTOM AREA 175'

SEEPAGE PITS, INSIDE DIAMETER 57.5 FT. DEPTH BELOW INLET 8 FT. 11' eff

ABSORBENT AREA 402.5 SQ. FT. in DW; TOTAL 578

REMARKS Spoke to boss stuff - in ground turn 1' to 2' deep
will OK this time but water cannot lid

DRAW Size 04 V Stone depth 11' to 12'

4/27/77 10:45 AM - No change - not ready til PM WWZ

4/27/77 3:30 AM - OK to come all except house - ST conn. WWZ

OK'd by PFW 12/19/77

DATE SYSTEM APPROVED _____ INSPECTOR _____