

APPLICATION

PERCOLATION TESTING

A 38381

P _____

HOWARD COUNTY HEALTH DEPARTMENT
BUREAU OF ENVIRONMENTAL HEALTH
P.O. BOX 476 ELLICOTT CITY, MARYLAND 21043
TELEPHONE: 461-9933

DISTRICT _____

DATE 10-14-86

TO: THE COUNTY HEALTH OFFICER
ELLICOTT CITY, MARYLAND

I, HEREBY, APPLY FOR THE NECESSARY TEST IN ORDER TO CONSTRUCT (OR RECONSTRUCT) A SEWAGE DISPOSAL SYSTEM.

PROPERTY OWNER STANLEY STARK

ADDRESS _____ PHONE _____

PROSPECTIVE BUYER Ronald Carter

ADDRESS 8388 Court Ave., Ellicott City, Md PHONE 21043 461-2855

PROPERTY LOCATION:

SUBDIVISION Hakes Property LOT NO. Thirty Three

ROAD AND DESCRIPTION ~~Hobbs Road~~ 2834 SHADOW ROLL CA. Prelim on 4/29/87

TAX MAP 14 PARCEL # 87,83,202

SIZE OF LOT 3+ ACRES TYPE BLDG. SFD
(SINGLE FAMILY DWELLING OR COMMERCIAL)

THE SYSTEM INSTALLED UNDER THIS APPLICATION IS ACCEPTABLE ONLY UNTIL PUBLIC FACILITIES BECOME AVAILABLE. I FULLY UNDERSTAND THE
FEE CONNECTED WITH THE FILING OF THIS PERC TEST APPLICATION IS NON-REFUNDABLE UNDER ANY CIRCUMSTANCES. I ALSO AGREE TO COMPLY
WITH ALL M.O.S.H.A. REQUIREMENTS IN TESTING THIS LOT.

(SIGNATURE OF APPLICANT)

APPROVED BY _____ FOR _____ DATE _____

REJECTED BY _____ FOR _____ DATE _____



HOLD PENDING FURTHER TESTS _____ DATE _____

REASONS FOR REJECTION OR HOLDING 23-87 PENC SATS Factory; Hold For Subdivision Permit. S. Aba

BLDG. PERMIT SIGNED
AND RETURNED 5-16-88

BP18213

THIS IS NOT A PERMIT

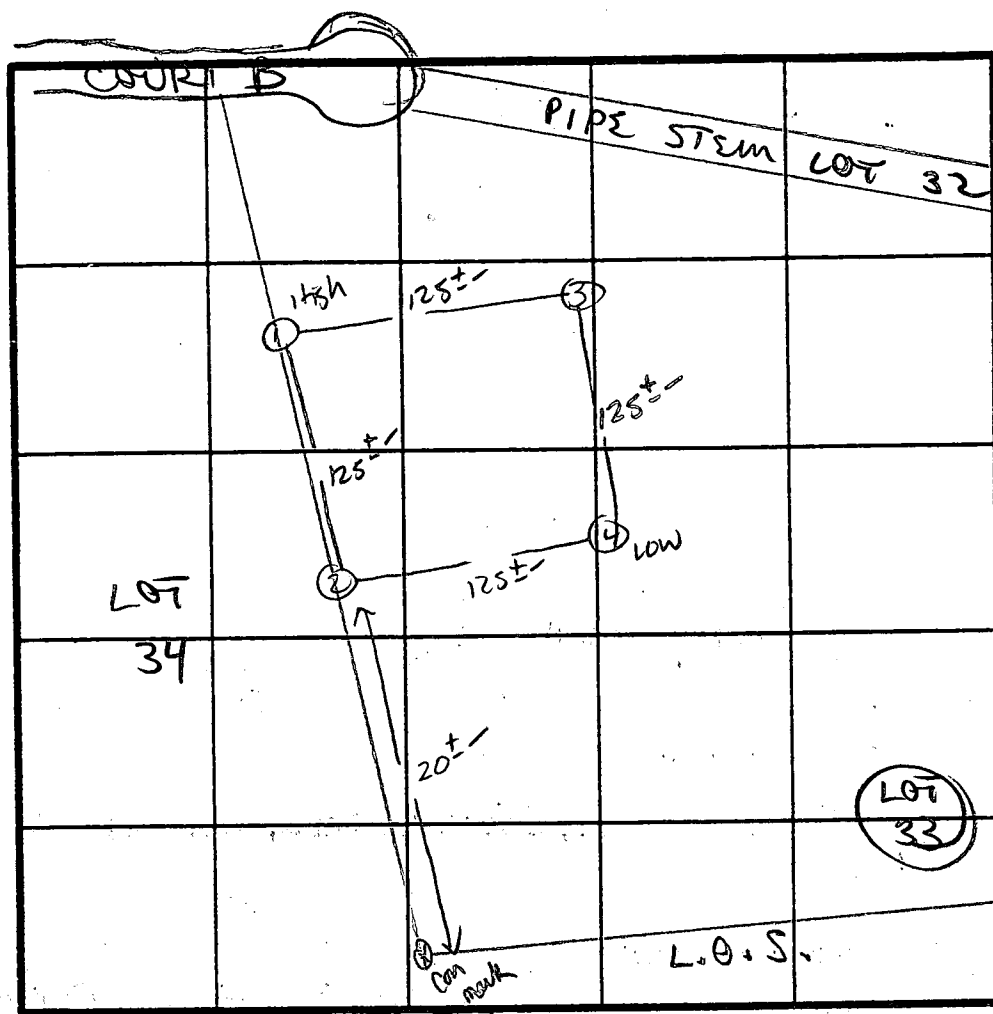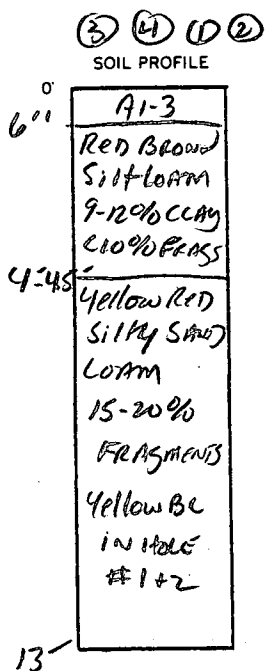

INDICATE NORTH - NAME ADJOINING ROADWAY AS BASE LINE.

DATE	TEST NO.	DEPTH	PRE-WET		TEST - 1" DROP		TIME
			START	STOP	START	STOP	
3/3/87	1 S M	4.5" 8"	11:50 11:45	11:56 11:47	11:56 11:47	12:07 11:51	8 MIN 4 MIN
	1 V	13'	UNIFORM SOIL below		4.5-5'		
	2 V	12.5'	UNIFORM SOIL below		3.5'		
	3 S V	4.5" 13'	11:34 UNIFORM SOIL	11:36 SOIL	11:36 below 4'	11:40	4 MIN
	4 S V	4.5" 13'	11:37 UNIFORM SOIL	11:40 below 4.5'	11:40 below 4.5'	11:47	7 MIN

REMARKS HOLE'S DIFF THAN PLAT

TYPE OF SOIL MIMOR

TESTED BY S. Abel ALSO PRESENT Phil M. C. Cissel