

3/10/64
fm.

PERMIT

SEWAGE DISPOSAL SYSTEM

MARYLAND STATE DEPARTMENT OF HEALTH

HOWARD COUNTY

ELLICOTT CITY

INDEXED

DISTRICT

DATE 3/6/64

Alwood Seaggs IS PERMITTED TO INSTALL 2 ALTER
ADDRESS Rt. 1 - Box 2670 - Laurel, Md. PHONE DL 5-1324

A SEWAGE DISPOSAL SYSTEM LOCATED AT

SUBDIVISION Beas Property ROAD 8180 Stephens Dr. LOT 2

PROPERTY OWNER Stanley Beas

ADDRESS Murphy Rd., Fulton Md.

SPECIFICATIONS 3 bedrooms

DRAIN FIELD DEPTH FEET, BOTTOM AREA SQ. FT.

SEEPAGE PITS ABSORBENT SIDE-WALL AREA 750 SQ. FT.

SEPTIC TANK CAPACITY GALLONS

FOR GARBAGE GRINDER, INCREASE DISPOSAL AREA 25% & TANK CAPACITY 50%


OTHER Two dry wells each 10 ft. in dia. by 10 1/2 ft. deep below the surface
located 125 ft. from the front property line with one dry well 35 ft. off the right
side property line and the second dry well 30 ft. from the first as measured
edge to edge. Locations determined as seen from the road. Toler 5 ft. below
original grade.

PLANS APPROVED BY J. Hennigan DATE 1/16/64

FILL SEPTIC TANK AND DISTRIBUTION BOX WITH WATER BEFORE CALLING FOR AN INSPECTION. COVER NO WORK
UNTIL INSPECTED AND APPROVED.

NEITHER THE HOWARD COUNTY COMMISSIONERS NOR THE HEALTH DEPARTMENT IS RESPONSIBLE FOR THE
SUCCESSFUL OPERATION OF ANY SYSTEM

10720

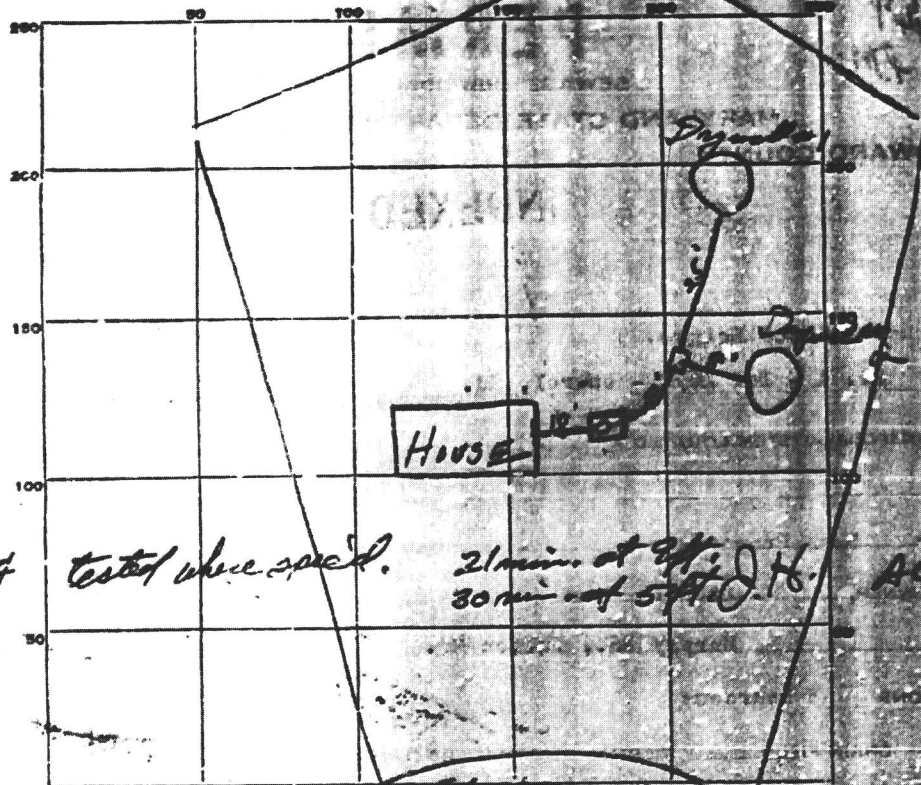

1-16-64 tested where spec'd.

21 min. at 2 ft. D.H.
30 min. at 5 ft. D.H.

A07828

INDICATE NORTH. - NAME ADJOINING ROADWAY OR RAIL LINE

Sta. 0+00 to 0+100

PERMIT CARD None Seen

SEPTIC TANK, LEVEL 750 gal. concrete

CLEANOUTS 8" Standpipe

DISTRIBUTION BOX, LEVEL None

TILE FIELD, DEPTH _____ FT. TRENCH WIDTH _____ FT.

GRAVEL DEPTH _____ IN. TOTAL LENGTH _____ FT.

NUMBER OF TRENCHES _____ TOTAL BOTTOM AREA _____

SEEPAGE PITS: INSIDE DIAMETER 11 FT. DEPTH BELOW INLET 10 1/2 FT.

ABSORBENT AREA _____ SQ. FT.

REMARKS Good soil

DATE SYSTEM APPROVED 2-10-64

INSPECTOR

J. H. Hanning

3/10/64
fm.

PERMIT

SEWAGE DISPOSAL SYSTEM

P. 0200

A. 0200

MARYLAND STATE DEPARTMENT OF HEALTH

HOWARD COUNTY

ELLCOTT CITY

INDEXED

DISTRICT

DATE 3/6/64

Wood Leaga IS PERMITTED TO INSTALL X ALTER

ADDRESS Rt. 2 - Box 267D - Laurel, Md. PHONE BA 5-0300

A SEWAGE DISPOSAL SYSTEM LOCATED AT

SUBDIVISION Beas Property ROAD 8180 Stephens Dr. LOT 7

PROPERTY OWNER Stanley Beas

ADDRESS Murphy Rd., Fulton Md.

SPECIFICATIONS 3 bedrooms

DRAIN FIELD DEPTH FEET, BOTTOM AREA SQ. FT.

SEEPAGE PITS ABSORBENT SIDE-WALL AREA 780 SQ. FT.

SEPTIC TANK CAPACITY GALLONS

FOR GARBAGE GRINDER, INCREASE DISPOSAL AREA 25% & TANK CAPACITY 50%


OTHER Two dry wells each 10 ft. in dia. by 10 1/2 ft. deep below the ground
located 125 ft. from the front property line with one dry well 35 ft. off the right
side property line and the second dry well 30 ft. from the first as measured
edge to edge. Locations determined as seen from the road. Inlet 5 ft. below
original grade.

PLANS APPROVED BY J. Hennigan DATE 1/16/64

FILL SEPTIC TANK AND DISTRIBUTION BOX WITH WATER BEFORE CALLING FOR AN INSPECTION. COVER NO WORK UNTIL INSPECTED AND APPROVED.

NEITHER THE HOWARD COUNTY COMMISSIONERS NOR THE HEALTH DEPARTMENT IS RESPONSIBLE FOR THE SUCCESSFUL OPERATION OF ANY SYSTEM

0200

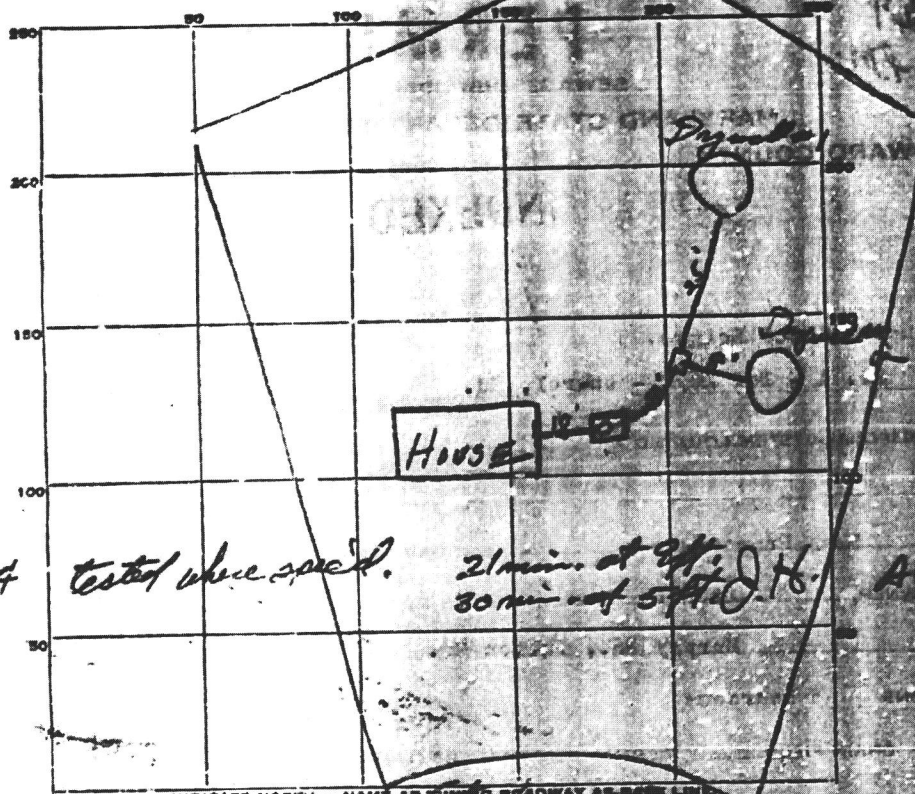

1-16-64 tested when spec'd.

21 min. at 2 ft. D.H.
30 min. at 5 ft. D.H.

A 87828

INDICATE NORTH. - NAME ADDRESS ROADWAY AS SHOWN

PERMIT CARD None Seen

SEPTIC TANK, LEVEL 750 gal concrete

CLEANOUTS 4" Standpipe

DISTRIBUTION BOX, LEVEL None

TILE FIELD, DEPTH _____ FT. TRENCH WIDTH _____ FT.

GRAVEL DEPTH _____ IN. TOTAL LENGTH _____ FT.

NUMBER OF TRENCHES _____ TOTAL BOTTOM AREA _____

SEEPAGE PITS Dry well #1 INSIDE DIAMETER 11 FT. DEPTH BELOW INLET 10 1/2 FT.

Dry well #2 ABSORBENT AREA _____ SQ. FT.

REMARKS Good soil

DATE SYSTEM APPROVED 2-10-61

INSPECTOR J. H. Hannon

LOT 7 BEAN PROPERTY FIFTH ELECTION DISTRICT HOWARD COUNTY MARYLAND

SCALE: 1" = 100' OCTOBER 1963.

OWNER'S STATEMENT

We, Stanley J. Bean and Juanita M. Bean, his wife, owners of the property shown and described hereon, adopt this plan of subdivision and reserve the fee simple title to the beds of the streets shown hereon and in consideration of the approval of this plan by the Planning Commission of Howard County, we hereby give and grant unto the Board of County Commissioners of Howard County the right and option to acquire for the consideration of One Dollar the fee simple title to the beds of the streets shown hereon, within the period of five years from the date of the recording of this plan among the land records of Howard County.

Witness our hands and seals this 21st day of October 1963.

Witness:

Stanley J. Bean
Stanley J. Bean
Juanita M. Bean

We consent to this plan of subdivision

Witness:

Stanley J. Bean
Stanley J. Bean
Juanita M. Bean

ENGINEER'S CERTIFICATE


I, hereby, certify, that the plan delineated hereon is correct, that it is a subdivision of part of that land conveyed by Hiram E. Walter and Katherine L. Walter, his wife, to Stanley J. Bean and Juanita M. Bean, his wife, by deed dated October 6, 1961, as recorded in the land records of Howard County, Maryland, in Liber MH 314 of folio 473; that all monuments shown hereon actually exist and are in accordance with Section 12 of Article 17 of the Annotated Code of Maryland as amended.

October 21, 1963.

Area in subdivision = 64.424 ±
Area dedicated = 4.851 ±
Total = 1.590 acres.

William C. Cook
William C. Cook
Registered Land Surveyor
Maryland Reg. # 1513.

Owner's Atty: Stanley J. Bean
Murry Road
Fulton, Md.
Phone: 776-7973

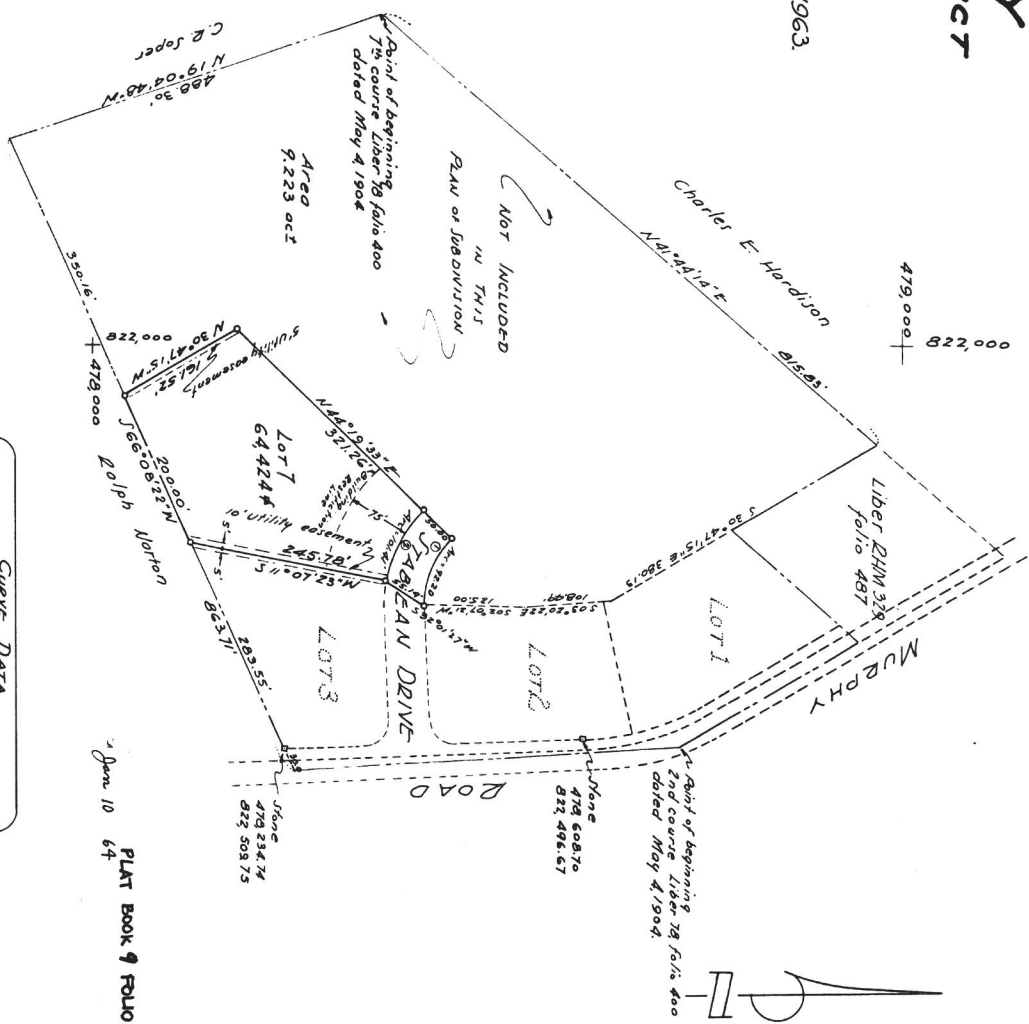

CURVE DATA				
St. R.	Δ	ARC	TAN	CHORD
1	175.00'	42° 54' 16"	92.30'	87.8'
2	175.00'	33° 18' 10"	101.41'	52.17'

PLAT BOOK 9 FOLIO 64

EDWARD W. MANSFIELD & ASSOC.
ENGINEERS & SURVEYORS
1835 SHEPARD ST. N.W.
WASHINGTON, D.C. 20036
Phone: RA 3-0784.

APPROVED: 1-10-64
William C. Cook
Chairman
Planning Comm.
Director
County Road
Chief Eng.
Metropolitan Comm.

pg 9 of 64