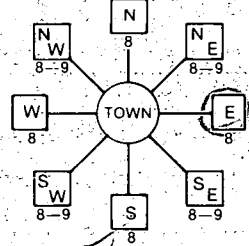
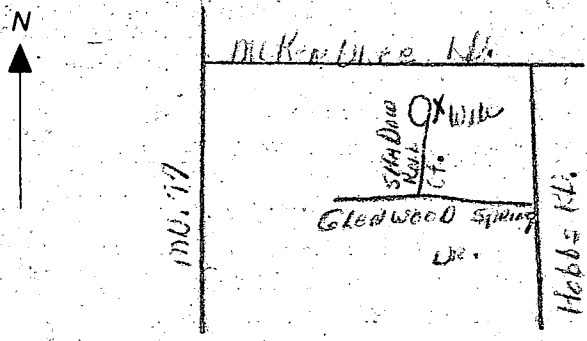


C1 7755 1 2 3 4 5 6 (THIS NUMBER IS TO BE PUNCHED IN COLS. 3-6 ON ALL CARDS)		STATE OF MARYLAND WELL COMPLETION REPORT FILL IN THIS FORM COMPLETELY PLEASE PRINT OR TYPE		PERMIT NO. 45 DAYS AFTER WELL IS COMPLETED.	
DATE RECEIVED		DATE WELL COMPLETED		COUNTY NUMBER A 38381	
8 9 10 11 12 13		14 15 16 17 18 19 20		21 22 23 24 25 26 27 28 29 30 31 32 33 34 35 36 37	
OWNER CORPORATION		STREET OR RFD SHADY ROLL COURT		TOWN GLENWOOD	
SUBDIVISION GLENWOOD SPRINGS		SECTION		LOT 33	
WELL LOG Not required for driven wells		GROUTING RECORD WELL HAS BEEN GROUTED (Circle Appropriate Box) Y N		C 3	
STATE THE KIND OF FORMATIONS PENETRATED, THEIR COLOR, DEPTH, THICKNESS AND IF WATER BEARING		TYPE OF GROUTING MATERIAL CEMENT CM BENTONITE CLAY BC		PUMPING TEST	
DESCRIPTION (Use additional sheets if needed)		NO. OF BAGS 10 NO. OF POUNDS 940		HOURS PUMPED (nearest hour) 3	
FEET FROM TO		GALLONS OF WATER 60		PUMPING RATE (gal. per min. to nearest gal.) 12	
0 56		DEPTH OF GROUT SEAL (to nearest foot) from 1 ft. to 40 ft.		METHOD USED TO MEASURE PUMPING RATE bucket	
56 125		(enter 0 if from surface)		WATER LEVEL (distance from land surface)	
SAND		CASING RECORD		BEFORE PUMPING 35	
GRAVEL		casing types insert appropriate code below		WHEN PUMPING 61	
rock		ST CO STEEL CONCRETE PL OT PLASTIC OTHER		TYPE OF PUMP USED (for test)	
15		MAIN CASING TYPE		A air P piston T turbine	
		Nominal diameter top (main) casing (nearest inch)		C centrifugal R rotary O other (describe below)	
		Total depth of main casing (nearest foot)		J jet S submersible	
		ST 6 43			
		OTHER CASING (if used)		PUMP INSTALLED	
		diameter inch depth (feet) from to		DRILLER WILL INSTALL PUMP YES NO	
				IF DRILLER INSTALLS PUMP, THIS SECTION MUST BE COMPLETED FOR ALL WELLS EXCEPT HOME USE	
				TYPE OF PUMP INSTALLED PLACE (A,C,J,P,R,S,T,O) IN BOX-SEE ABOVE: 29	
		SCREEN RECORD		CAPACITY: GALLONS PER MINUTE (to nearest gallon) 31 35	
		screen type or open hole insert appropriate code below		PUMP HORSE POWER 37 41	
		ST BR HO STEEL BRASS OPEN HOLE PL OT PLASTIC OTHER		PUMP COLUMN LENGTH (nearest ft.) 43 47	
C 2		DEPTH (nearest ft.)		CASING HEIGHT (circle appropriate box and enter casing height)	
1 2		HC 61 135		+ above 49	
3 4		4 15 17 21		- below 49	
5 6		23 24 26 30 32 36		LAND SURFACE (nearest foot) 2 50 51	
7 8		38 39 41 45 47 51		LOCATION OF WELL ON LOT	
9 10		SLOT SIZE 1 2 3		SHOW PERMANENT STRUCTURE SUCH AS BUILDING, SEPTIC TANKS, AND/OR LANDMARKS AND INDICATE NOT LESS THAN TWO DISTANCES (MEASUREMENTS TO WELL)	
11 12		DIAMETER OF SCREEN (NEAREST INCH) 56 60			
13 14		GRAVEL PACK IF WELL DRILLED WAS FLOWING WELL INSERT F IN BOX 68			
15 16		OEP USE ONLY (NOT TO BE FILLED IN BY DRILLER)			
17 18		T (E.R.O.S.) WQ			
19 20		70 72 74 75 76			
21 22		TELESCOPE CASING LOG INDICATOR OTHER DATA			
23 24					
25 26					
27 28					
99 100					

B 1 3672 (THIS NUMBER IS TO BE PUNCHED IN COLS. 3-6 ON ALL CARDS)	SEQUENCE NO. (DP USE ONLY)	STATE OF MARYLAND PERMIT TO DRILL WELL please print or type	STATE PERMIT NUMBER HO-81-2672 fill in this form completely
Date Received (APA) 032388 OWNER INFORMATION KCM CORPORA + LOU 5520 CUDAR LANE COLUMBIA MD 21044		B 3 LOCATION OF WELL TOWN COUNTY GLENWOOD SPRINGS SUBDIVISION SECTION LOT 33 GLENWOOD NEAREST TOWN MILES FROM TOWN (enter 0 if in town) 3 MI	
DRILLER INFORMATION Joseph L. Mayne Driller's Name Joseph L. Mayne with Drilling Firm Name 5512 Ridge Rd. Mt. Airy, NC Address Signature Date 3/18/88		B 4 DIRECTION OF WELL FROM TOWN (CIRCLE BOX)  NEAR WHAT ROAD SHADOW HALL CT. ON WHICH SIDE OF ROAD (CIRCLE APPROPRIATE BOX)  DISTANCE FROM ROAD ENTER FT or MI 45 FT	
B 2 WELL INFORMATION APPROX. PUMPING RATE (GAL. PER MIN.) 5 AVERAGE DAILY QUANTITY NEEDED (GAL. PER DAY) 500		NOT TO BE FILLED IN BY DRILLER HEALTH DEPARTMENT APPROVAL COUNTY NAME Howard COUNTY NO. A38381 STATE SIGNATURE DATE ISSUED 10/18/88 CO SIGNATURE B. Nelson NORTH GRID 533000 EAST GRID 0794000	
USE FOR WATER (CIRCLE APPROPRIATE BOX) ☒ HOME (SINGLE OR DOUBLE HOUSEHOLD UNIT ONLY) ☐ FARMING (LIVESTOCK WATERING & AGRICULTURAL IRRIGATION) ☐ INDUSTRIAL, COMMERCIAL, STATE AND FEDERAL GOV. OTHER (REQUIRES APPROPRIATION PERMIT) ☐ PUBLIC OR PRIVATE WATER COMPANY (REQUIRES APPROPRIATION PERMIT AND STATE HEALTH DEPARTMENT APPROVAL) ☐ TEST, OBSERVATION, MONITORING (MAY REQUIRE APPROPRIATION PERMIT)		SHOW MAJOR FEATURES OF BOX & LOCATE WELL WITH AN X SOURCES OF DRILLING WATER 1. Well 2. 3. WRITE THE BOX NUMBER FROM THE MAP HERE E 790 4 N 530 3	
APPROXIMATE DEPTH OF WELL 200 FEET APPROXIMATE DIAMETER OF WELL 6 INCH METHOD OF DRILLING (circle one) BORED (or Augered) JETTED Jettied & DRIVEN AIR-ROTary AIR-PERCussion ROTARY (Hydraulic Rotary) CABLE REVERSE-ROTary DRIVE-POINT other		DRAW A SKETCH BELOW SHOWING LOCATION OF WELL IN RELATION TO NEARBY TOWNS AND ROADS AND GIVE DISTANCE FROM WELL TO NEAREST ROAD JUNCTION 	
REPLACEMENT OR DEEPEENED WELLS (CIRCLE APPROPRIATE BOX) ☒ THIS WELL WILL NOT REPLACE AN EXISTING WELL ☐ THIS WELL WILL REPLACE A WELL THAT WILL BE ABANDONED AND SEALED ☐ THIS WELL WILL REPLACE A WELL THAT WILL BE USED AS A STANDBY ☐ THIS WELL WILL DEEPEEN AN EXISTING WELL PERMIT NUMBER OF WELL TO BE REPLACED OR DEEPEENED (IF AVAILABLE)		Not to be filled in by driller (OEP USE ONLY) APPROP. PERMIT NUMBER FORCE INITIALS PERMIT NO. HO-81-2672 SPECIAL CONDITIONS	

Well Permit No. HO - 81-2672
Location of property (road) SHADOW ROLL COURT
Subdivision GLENWOOD SPRINGS Lot 33 Block Plat Sec.
Well Driller JOSEPH A. MAYNE Owner CORP., RCM
Depth of well 125'
Distance of measuring point (M.P.) above ground 1 1/2'
Static water level (S.W.L.) below M.P. 35'

Time pump started 7:45 Pumping rate 20 gpm.
Total time 15 min to reach pumping water level 60 ft. below M.P.

HD-224

9/30/88

APPLICATION FOR PITLESS ADAPTER, WELL PUMP AND PRESSURE TANK INSTALLATION

Howard County Health Department
Bureau of Environmental Health
3525-H Ellicott Mills Drive
Court House Square
Ellicott City, Md. 21043
461-9933

New Installation ☒
Replacement ☐

Receipt # 42322
Date 8/8/88

Name of Installer WOOD & WILLOUGHBY PLBO SER.

Telephone _____

License number MD 7040

Certified Well Pump Installer _____ Well Driller _____ Registered Plumber ☒

Name of Property Owner RCM BUILDERS

Telephone 995-0133

Subdivision Glenwood Springs Lot # 33

Well tag # HD - 81-2672

Site Address 2834 SHADOW ROLL COURT

GLENWOOD MD 21738

Pump

1. Type
 - a. Deep well jet _____
 - b. Shallow well jet _____
 - c. Submersible ☒

Motor

1. Horsepower 3/4
2. RPM 1750
3. Voltage _____
 - a. 110 _____
 - b. 220 ☒

Pitless Adapter

1. Make _____
2. Model # PRESSURIZED
3. Depth 4'

2. Make GOULDS

3. Model # SE00422

4. Capacity 5 GPM

5. Pump exceeds well capacity Yes _____ No ☒

6. If Yes, is low pressure cutoff switch installed? Yes _____ No _____

7. What methods are used to protect the pump and electrical wiring from vibrations? Torque arrestors yes Cable guards yes Other Ties

Tank

1. Capacity 40 GAL.
2. Pressure relief valve? 75 PSI

Piping

1. Type POLY BUTYLENE
2. Size 1"
3. NSF and/or BOCA Code approved yes
4. Depth of supply line 4'

Well data

1. Depth 125'
2. Yield 37 GPM
3. Static water level 35'
4. Will water supply be disinfected by installer? NO


I understand that it is my responsibility to notify the Howard County Health Department when the installation is ready for inspection (otherwise this permit is null and void).

All information given above is true to the best of my knowledge.

Signature of Applicant: Don A. Wane

Date: 8/9/88

Note: A sticker indicating approval/status of the installation will be placed on the well casing at the time of the inspection.

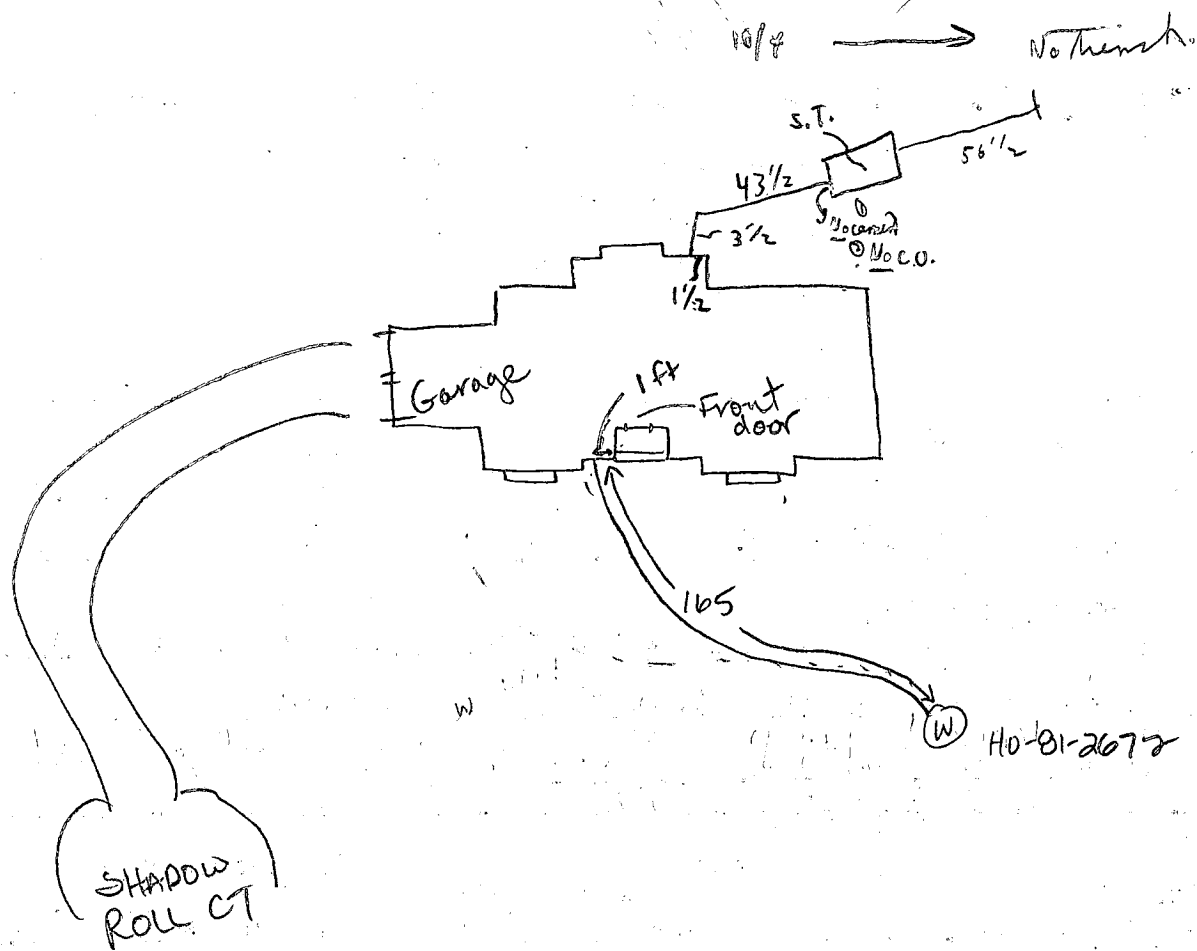

b 29.
2.5
276
138
165.6

9-30-88

Well line at 60 inches in trench. Ground placed but not connected yet. Pitless adaptor at 52 inches. House connection ok. JENadeau

ESTIMATE
G. DONALD DEMENT
REGISTERED PLUMBER

PLUMBING, HEATING AND PUMPS • BUSINESS — RESIDENTIAL
13200 COLUMBIA PIKE • SILVER SPRING, MARYLAND 20904
TELEPHONE 384-6493

.....1-25....., 19 89

To: *R.C.M.*.....

From: *Don Dement*.....

Subject: *Starrs Job*.....

Install Bruner Gould Iron Worker Plus ~~#~~1W900
Removes iron & softens water 964.00

Alternate — Bruner Iron Filter FE-10 only \$52.00