

RECEIVED

MAY 27 2020

LICENSES & PERMITS
DIVISION

PERMIT NUMBER: B 10001688

DATE ACCEPTED:

RESIDENTIAL BUILDING PERMIT APPLICATION			
HOWARD COUNTY DEPARTMENT OF INSPECTIONS, LICENSES, AND PERMITS 3430 COURT HOUSE DRIVE, ELLICOTT CITY, MD 21043 - PHONE: (410) 313-2455 OPTION #4 www.howardcountymd.gov			
BUILDING SITE ADDRESS			
Street Address: 2336 ROXBURY MILLS ROAD (RT 97)			Unit:
City: COOKSVILLE		State: MD	Zip Code: 21723
Subdivision/Village/Complex Name:			SDP/WP/BA #:
Lot:	Tax Map:	Parcel:	Grading Permit #:
DESCRIPTION OF WORK			
Existing Use: HOME		Proposed Use: SHED	
		Estimated Cost: \$8,000	
Trade Work to Be Completed (Separate Permits Required): ☐ Mechanical (HVACR) ☐ Electrical ☐ Plumbing ☒ None			
CONSTRUCT A BACKYARD OVERSIZED SHED, 22' X 30', SINGLE STORY			
PROPERTY OWNER INFORMATION			
Owner(s) Name(s) (As it appears on tax records): CORNERSTONE REMODELING LLC			Primary Residence: ☒ Yes ☐ No
Owner's Street Address: 2336 ROXBURY MILLS ROAD			
City: COOKSVILLE		State: MD	Zip Code: 21723
Phone: 301-401-9177		Email: AJ@CORNERSTONEREMODELING.COM	
APPLICANT NAME			
Business Name: CORNERSTONE REMODELING		Contact Name: A.J. BALLANTINE	
Street Address: SAME AS ABOVE			
City:		State:	Zip Code:
Phone: 301-401-9177		Email: AJ@CORNERSTONEREMODELING.COM	
CONTRACTOR INFORMATION			
Business Name: CORNERSTONE REMODELING			
Licensee's Name: A.J. BALLANTINE		License #: 129873	
Street Address: SAME AS ABOVE			
City:		State:	Zip Code:
Phone: 301-401-9177		Email: AJ@CORNERSTONEREMODELING.COM	
ARCHITECT/ENGINEER INFORMATION			
Business Name:		Name:	
Street Address:			
City:		State:	Zip Code:
Phone:		Email:	
BUILDING CHARACTERISTICS			
Primary Structure: ☒ SF Dwelling ☐ SF Townhouse ☐ SF Duplex ☐ Mobile Home ☐ Multi-Family Dwelling (MF*)			Condo: ☐ Yes ☐ No
Utilities: ☒ Electric ☐ Gas		Water Supply: ☐ Public ☒ Private (Well)	Sewage Disposal: ☐ Public ☒ Private (Septic)
Heating System: ☒ Electric ☐ Natural Gas ☐ Propane ☐ Other:			Roadside Tree Project: ☐ No ☐ Yes: #
Sprinkler System: ☐ NFPA 13 ☐ NFPA 13R ☐ NFPA 13D ☒ None		Fire Alarm System: ☐ Yes ☒ No ☐ Voice Evac	
ADDITIONAL RESIDENTIAL INFORMATION			
Model Name & Options:			
# of Bedrooms (SF): 2		# of efficiency units (MF*):	# of 1 BR (MF*):
# of 2 BR (MF*):		# of 3 BR (MF*):	
# Rooms:		# Full Baths: 1	# Half Baths:
		# Fireplaces:	
Garage/Carport Info: ☐ Attached Garage ☐ Detached Garage ☐ Integral Garage ☐ Carport ☒ None			
Basement/Foundation Info: ☐ Slab on Grade ☒ Post & Pier ☐ Unfinished Basement ☐ Finished Basement: ☐ Full or ☐ Partial			
1 st Fl Width:		1 st Fl Depth:	2 nd Fl Width:
2 nd Fl Depth:		Basmt Width:	Basmt Depth:
Energy Method: ☐ Prescriptive ☐ Performance ☐ UA Alternative ☐ ERI		Gross Area: 600	Occupable Area: 600
		sq ft	sq ft
AGREEMENT / DISCLAIMER			
THE UNDERSIGNED HEREBY CERTIFIES AND AGREES AS FOLLOWS: (1) THAT HE/SHE IS AUTHORIZED TO MAKE THIS APPLICATION; (2) THAT THE INFORMATION IS CORRECT; (3) THAT HE/SHE WILL COMPLY WITH ALL REGULATIONS OF HOWARD COUNTY WHICH ARE APPLICABLE THERETO; (4) THAT HE/SHE WILL PERFORM NO WORK ON THE ABOVE REFERENCED PROPERTY NOT SPECIFICALLY DESCRIBED IN THIS APPLICATION; (5) THAT HE/SHE GRANTS COUNTY OFFICIALS THE RIGHT TO ENTER ONTO THIS PROPERTY FOR THE PURPOSE OF INSPECTING THE WORK PERMITTED AND POSTING NOTICES.			
APPLICANT'S ORIGINAL SIGNATURE		DATE SIGNED	
FOR OFFICE USE ONLY			
AGENCIES REQUIRED/APPROVALS:			
☐ PR	☐ DPZ	☐ DED	☐ SHA
☐ Health		☐ CID	
SUBMITTAL FEES:		PAYMENT:	ACCEPTED BY:


no check

7500

Approved
B2001688
7/1/2
6/15/2002

HAMBRIC AMBER
CASANAS LAURA V
TAX MAP 14 PARCEL 109
L 1083 F. 450

MARYLAND ROUTE 97
ROXBURY MILLS ROAD

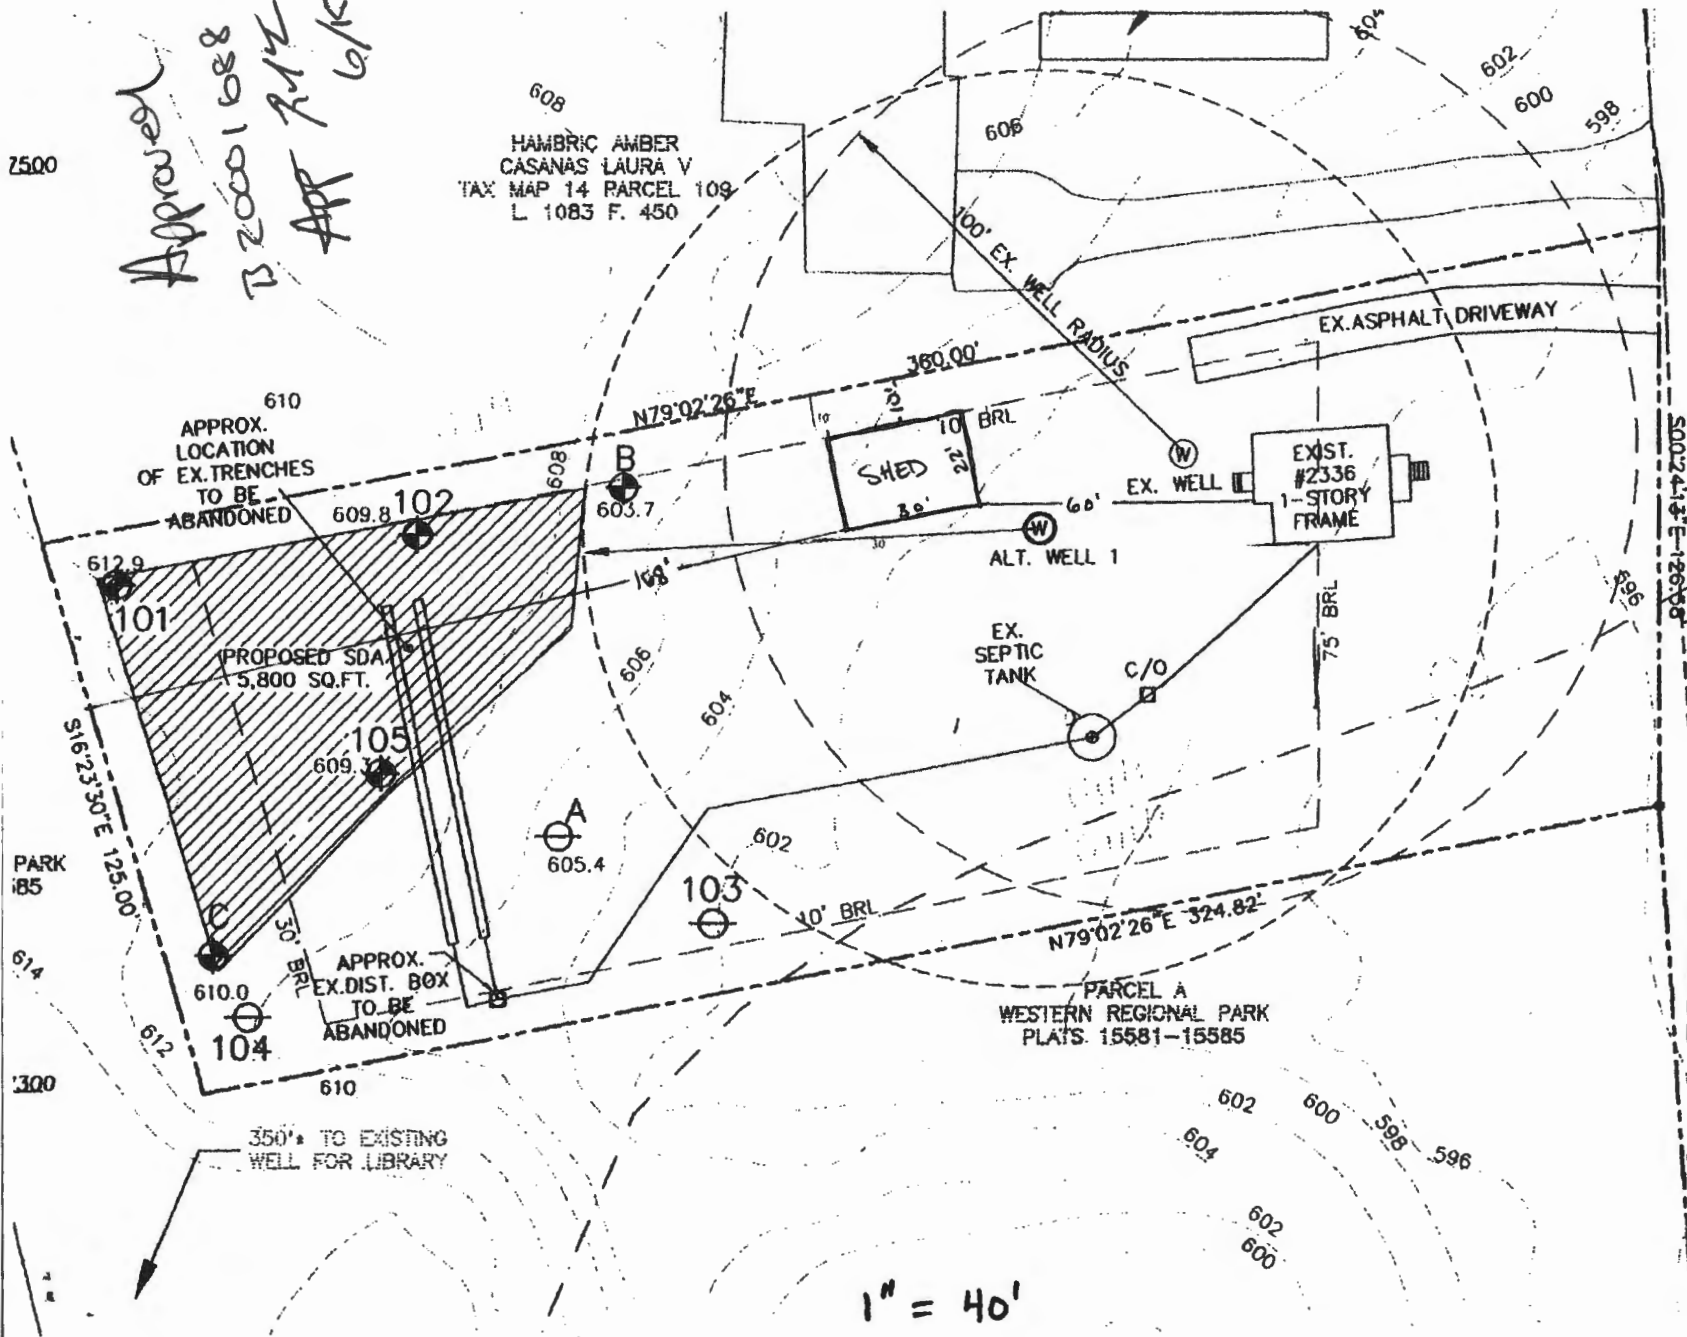

00490311
597300