


PROPERTY SURVEY OF:

LOT 31, GIVENLEE ESTATES, SECTION 3, AREA 1,
LOTS 30, 31 & 32, A RESUBDIVISION OF LOT 10,
HOWARD COUNTY, MARYLAND

FOR:

DAVID S. SLICK & ANN
D. HEAVNER

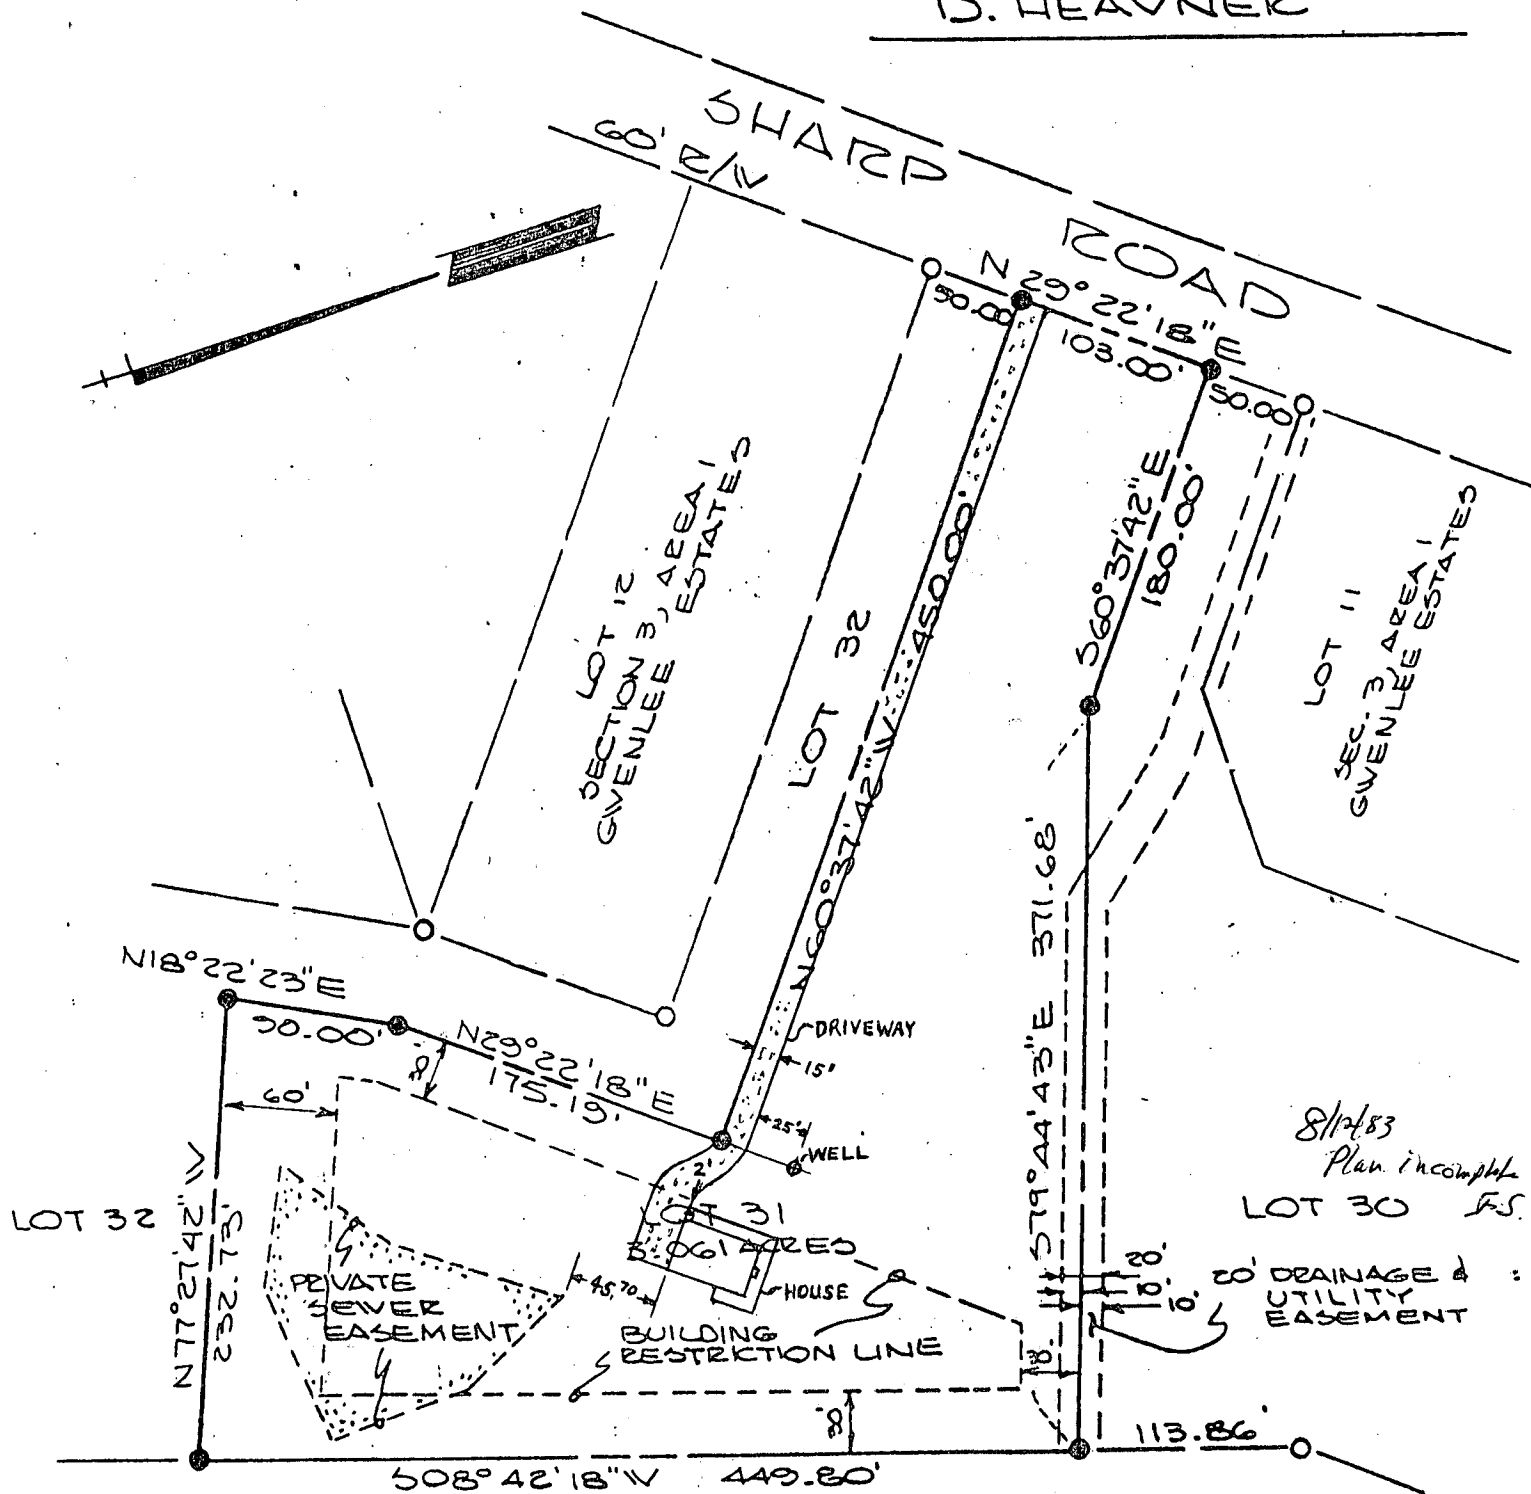


- IRON PIPE OR PIN FOUND
- 5/8" IRON PIN PLACED

SURVEYORS CERTIFICATE:

I, Donald E. Finch, hereby certify that I
have surveyed the lands described hereon
and that the plat shown above is a correct
representation of said survey.

Donald E. Finch 3-4-83
Donald E. Finch, R.L.S. No. 8657 Date

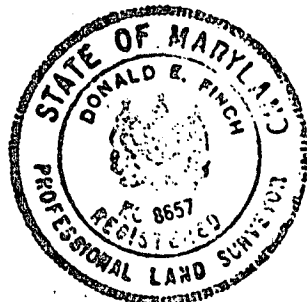

SCALE 1" = 100'

LOT 31, GIVENLEE ESTATES, SECTION 3, AREA 1,
LOTS 30, 31 & 32, A RESUBDIVISION OF LOT 10,
HOWARD COUNTY, MARYLAND

DAVID S. SLICK & ANN
D. HEAVNER



I, Donald E. Finch, hereby certify that I have surveyed the lands described hereon and that the plat shown above is a correct representation of said survey.

A circular professional seal for Donald E. Finch, a Registered Professional Land Surveyor in the State of Maryland. The seal features the text "STATE OF MARYLAND" at the top, "DONALD E. FINCH" in the center, and "REGISTERED PROFESSIONAL LAND SURVEYOR" at the bottom. The number "P.C. 8557" is also visible within the seal.

SCALE 1" = 100'

David S. Slick
5825. Richardson Mews Square
Baltimore, Md. - 21227

(301) 242-7737 Home

(301) 322-8500 Work

PROPERTY SURVEY OF: 3235 SHARP ROAD

LOT 31, GIVENLEE ESTATES, SECTION 3, AREA 1,
LOTS 30, 31 & 32, A RESUBDIVISION OF LOT 10,
HOWARD COUNTY, MARYLAND

FOR:

DAVID S. SLICK & ANN
D. HEAVNER


DAVID SLICK

410-489-4950

10/18/96

Shown propane
tank location will
have no impact to the
existing well or
septic. OK to
proceed

Amy McMill

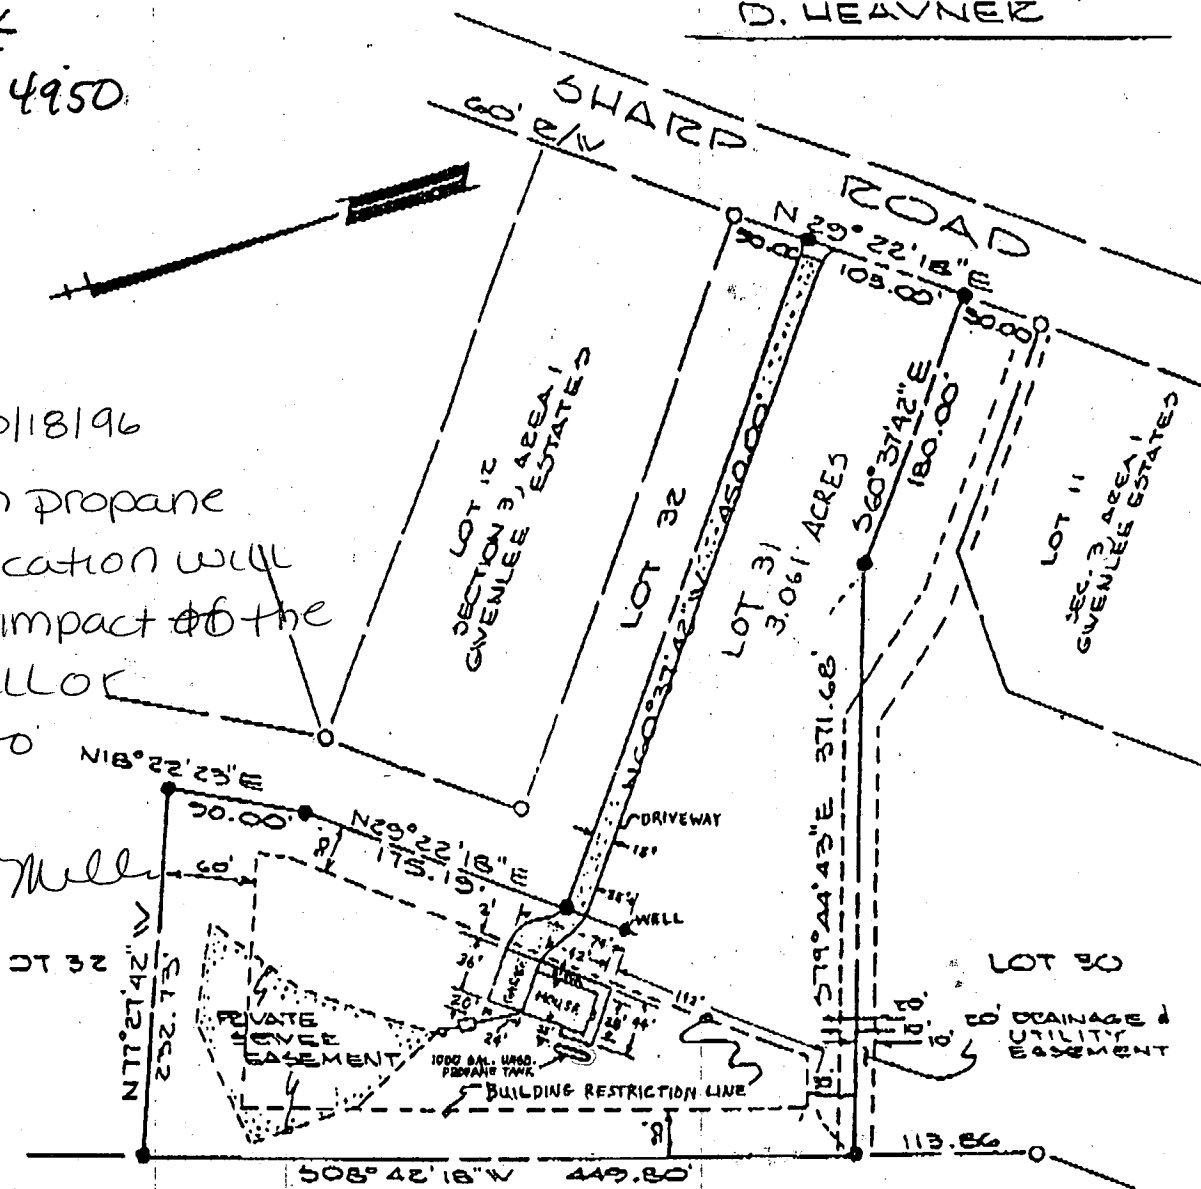

- 1/2\"/>

I, Donald E. Finch, hereby certify that on June 23, 1986, I again visited the site of the lands shown hereon and that the plat shown above is a correct representation of said survey.

SURVEYORS CERTIFICATE:

I, Donald E. Finch, hereby certify that I have surveyed the lands described hereon and that the plat shown above is a correct representation of said survey.

Donald E. Finch 3-4-83
Donald E. Finch, R.L.S. No. 8657 Date

