

PRELIMINARY

APPLICATION

SEWAGE DISPOSAL TESTING

STATE OF MARYLAND - DEPARTMENT OF HEALTH AND MENTAL HYGIENE

HOWARD COUNTY HEALTH DEPARTMENT
ENVIRONMENTAL HEALTH SERVICES

P. O. BOX 473 ELLICOTT CITY, MARYLAND 21043
TELEPHONE: 992-2330

A 31521

P _____

DISTRICT 4th

DATE 7/30/81

BP # 8/30/83
55159

TO: THE COUNTY HEALTH OFFICER
ELLICOTT CITY, MARYLAND

I, HEREBY, APPLY FOR THE NECESSARY TEST IN ORDER TO CONSTRUCT (OR RECONSTRUCT) A SEWAGE DISPOSAL SYSTEM.

PROPERTY OWNER NTT Associates, Inc.

ADDRESS Suite 108 Clark Building, Columbia, Md. 21044 PHONE _____

PROPERTY LOCATION:

SUBDIVISION Gwalee Estates LOT NO. 31, Sec. 3, Area 1

ROAD AND DESCRIPTION off Sharp Road

SIZE OF LOT (?) TYPE BLDG. 3 or 4 bedrooms
(NUMBER OF BEDROOMS)

THE SYSTEM INSTALLED UNDER THIS APPLICATION IS ACCEPTABLE ONLY UNTIL PUBLIC FACILITIES BECOME AVAILABLE. I FULLY UNDERSTAND THE
FEE CONNECTED WITH THE FILING OF THIS PERC TEST APPLICATION IS NON-REFUNDABLE UNDER ANY CIRCUMSTANCES. I ALSO AGREE TO COMPLY
WITH ALL M.O.S.H.A. REQUIREMENTS IN TESTING THIS LOT.

[Signature]
(SIGNATURE OF APPLICANT)

APPROVED BY _____ FOR _____ DATE _____

REJECTED BY _____ FOR _____ DATE _____

HOLD PENDING FURTHER TESTS _____ DATE _____

REASONS FOR REJECTION OR HOLDING _____

THIS IS NOT A PERMIT

SECRET

HOLE ELEVEN

SOIL PROFILE

② ① LOW
⑥ HIGHEST
④ ⑤ ③ ⑦ MEDIUM

INDICATE NORTH - NAME ADJOINING ROADWAY AS BASE LINE

DATE	TEST NO.	DEPTH	PRE-WET		TEST - 1" DROP		TIME
			START	STOP	START	STOP	
11/2/81	1 S	4 1/2	107	113	113	124	11
	1 D	9	107	122	122	133	11
	1 V	12 1/2	TOP 3 FT CLAY		BOT 9 1/2 SANDY		
			WATER 11 1/2				
	2 S	4	110	117	117	126	9
	2 D	8 1/2	111	127	127	151	24
			TOP 3 FT CLAY				
	2 V	14	BOT 21 FT		SILTY SANDY		DRY
	3 S	4 1/2	130	134	139	147	8
	3 D	9	136	153	153	204	21
			TOP 3 FT CLAY				
	4 V	12 1/2	BOT 9 1/2 FT		SANDY SILTY		
11/2/81	5 D	8	145	149	149	155	6
	5 S	4 1/2	146	149	149	155	6
	6 S	3 1/2	301	304	304	306	2
	6 D	7 1/2	301	304	304	308	4
			TOP 3 FT CLAY				
	7 V	12 1/2	BOT 9 1/2 FT		SANDY SILTY		DRY
7/14/82	1 V	1.3	WATER		COMES IN 1 FT		

SAME PLACE AS ①
SEE ATTACHED PLAT


REMARKS

TYPE OF SOIL

TESTED BY RAIDERS

ALSO PRESENT

J. C. HUGHES Surveyor
O. Kettner and Boefhoe

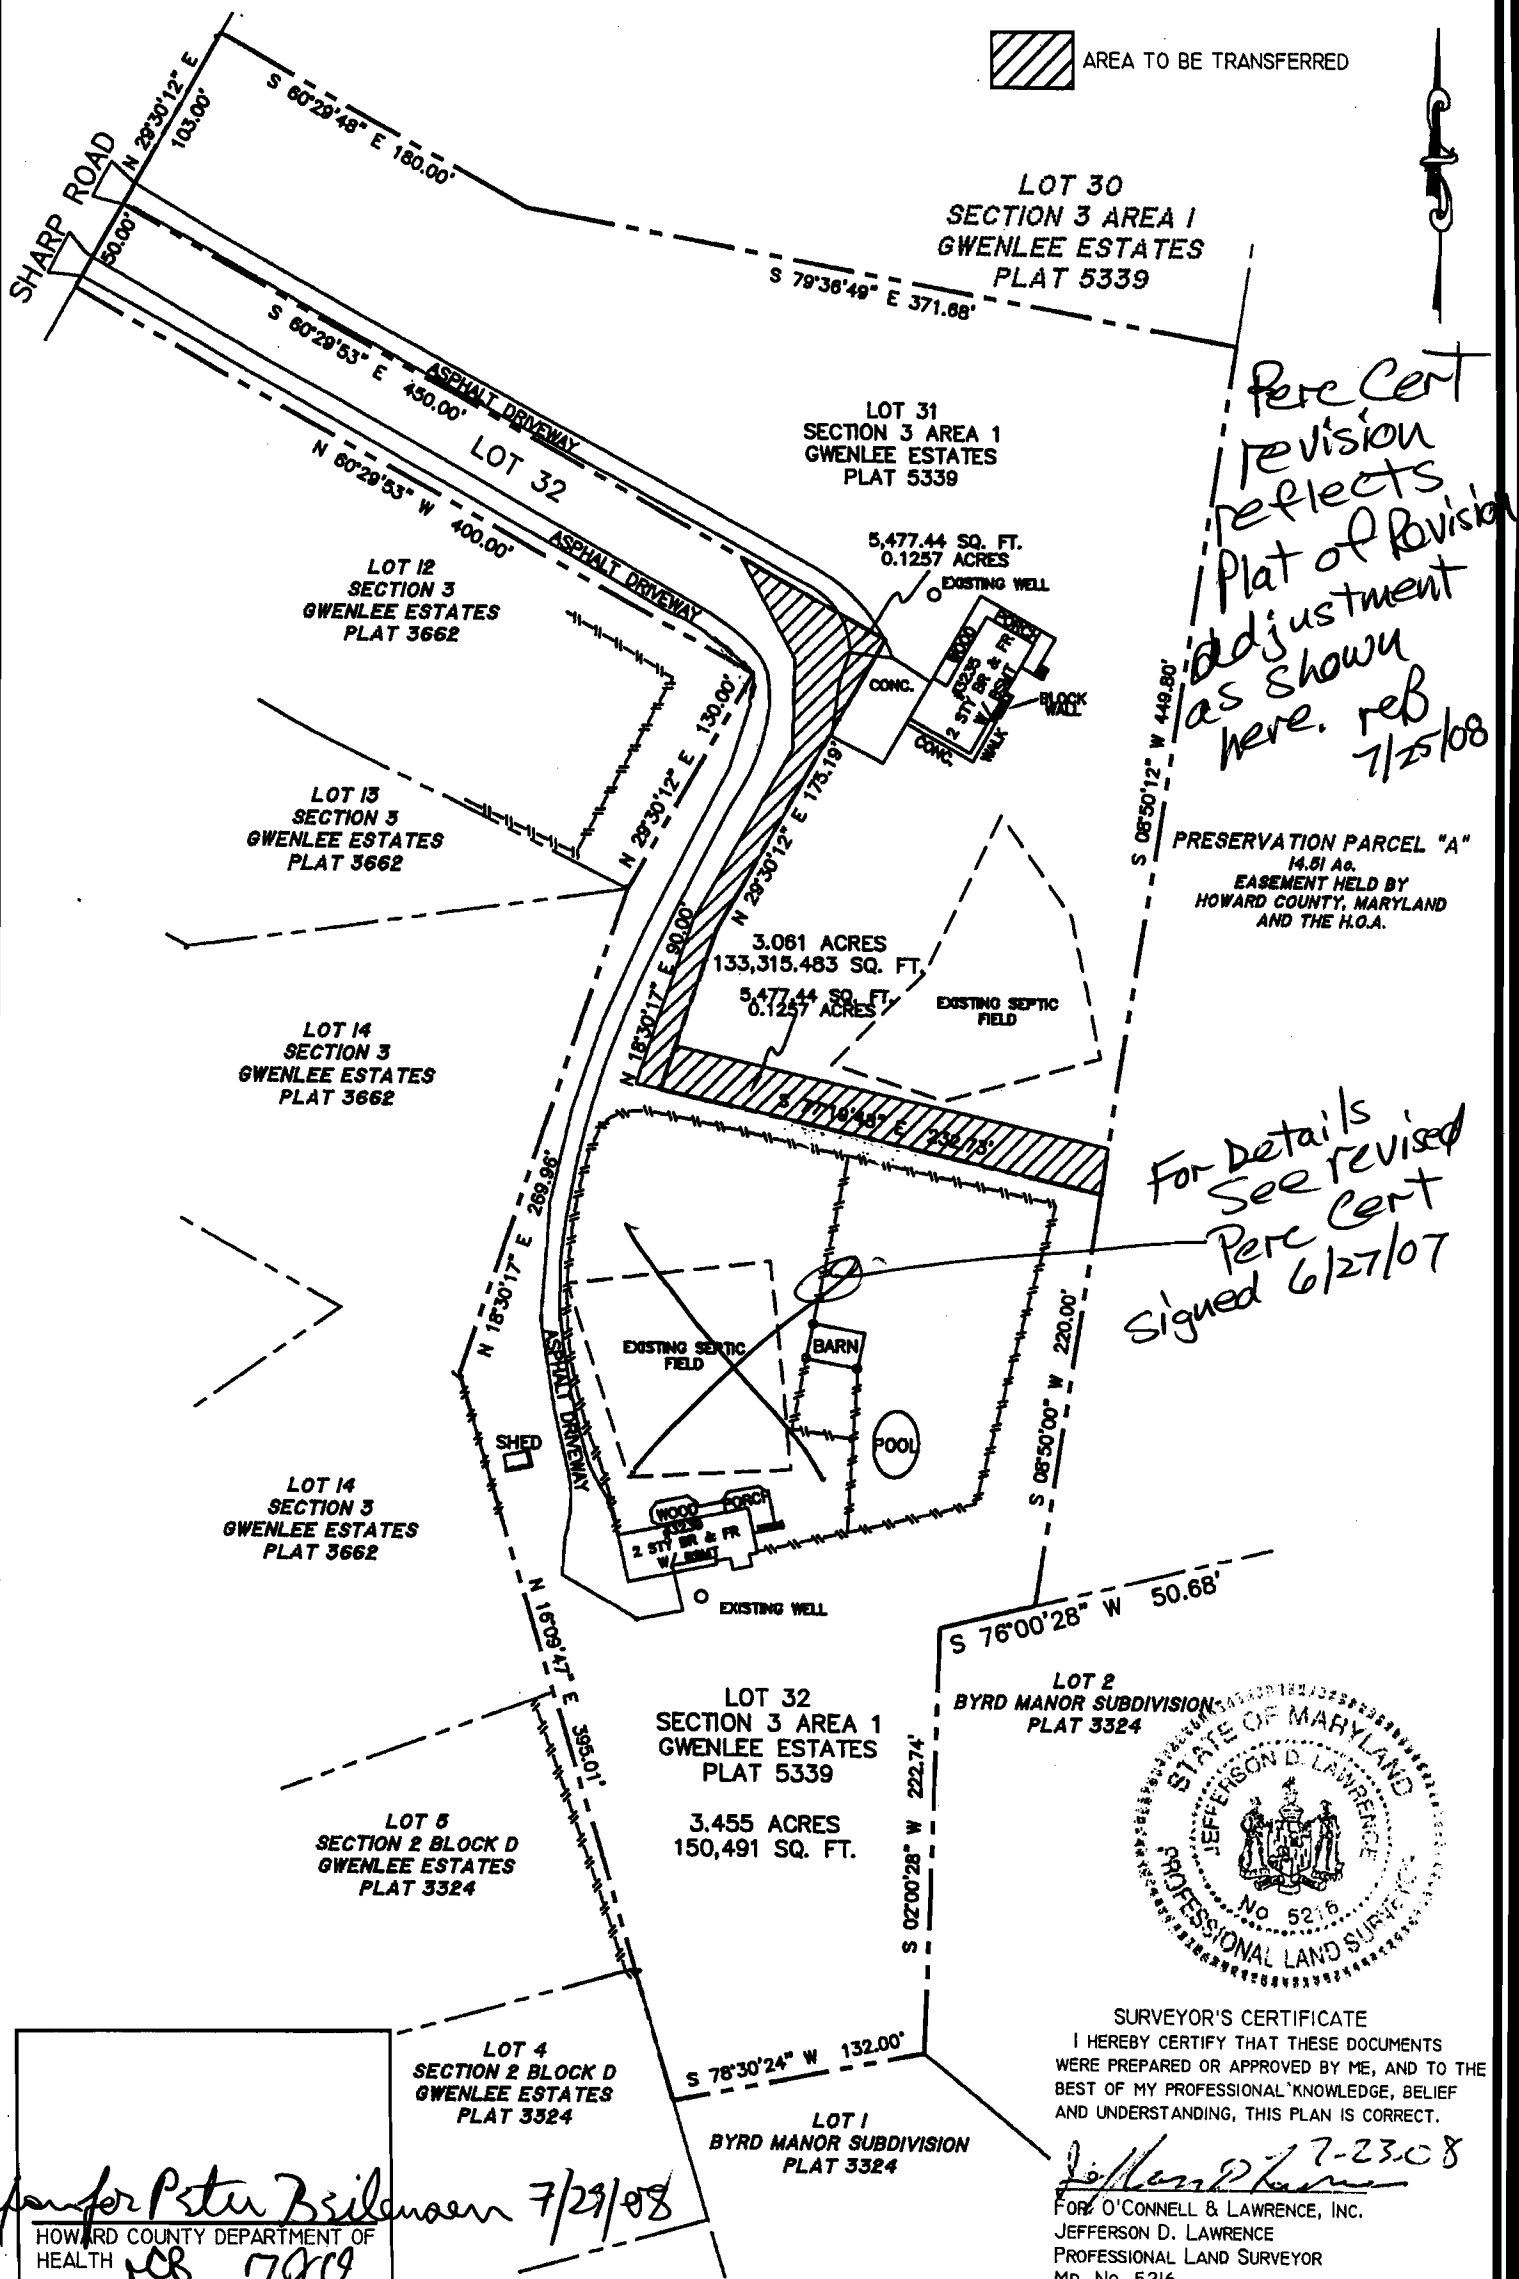

For details
See revised
Per Cent
Signed 6/27/07

SURVEYOR'S CERTIFICATE
I HEREBY CERTIFY THAT THESE DOCUMENTS
WERE PREPARED OR APPROVED BY ME, AND TO THE
BEST OF MY PROFESSIONAL KNOWLEDGE, BELIEF
AND UNDERSTANDING, THIS PLAN IS CORRECT.

7-2308
 FOR O'CONNELL & LAWRENCE, INC.
 JEFFERSON D. LAWRENCE
 PROFESSIONAL LAND SURVEYOR
 Md. No. 5216

Date 07/23/08

Date _____

Scale $1" = 100'$

Job No. 007-024

O'C & L

O'Connell & Lawrence, Inc.
Construction Consultants, Engineers, Surveyors
17904 Georgia Avenue, Suite 302
Olney, Maryland 20832
Tel: (301) 924-4570 * Fax: (301) 924-5872

REVISED PERCOLATION CERTIFICATION
LOTS 31 & 32, SECTION 3
GWENLEE ESTATES
PLAT 5339
(4TH) ELECTION DISTRICT
HOWARD COUNTY, MARYLAND