

HOWARD COUNTY
PERMIT APPLICATION

PERMIT NUMBER

B09000722

Building Address 3646 Sharp Road

Property Owner's Name Gary Parrish

Suite/Apt. #: SDP/WP/Petition #:

Address

3646 Sharp Road

Census Tract 6040.02 Subdivision Glenelyg

City Glenwood State MD Zip Code 21738

Section Area Lot

Home Phone 443-266-7502 cell

Work Phone 443-386-0746

Tax Map 21 Parcel 177 Grid 14

Applicant's Name & Mailing Address, (if other than stated hereon):

Zoning RR Map Coordinates Lot size 3.15Ac

Phone 443-266-7502 Fax

Existing Use

Contractor Company Horizons Unlimited Home Imp

Proposed Use front porch

Inc.

Estimated Construction Cost \$16,000.00

Contact Person

William L. Gmeinwieser, Sr.

Description of Work construct front porch with

Address

7387 Washington Blvd., Suite 104

roof

City Elkridge State MD Zip Code 21075

License No. 16606

Phone 410-796-1333 Fax 410-796-4144

Occupant or Tenant Gary Parrish

Engineer or Architect Company

Contact Name Gary Parrish

Contact Person

Address 3646 Sharp Road

Address

City Glenwood State MD Zip Code 21738

City State Zip Code

Phone 443-266-7502 Fax

Phone Fax

BUILDING DESCRIPTION - COMMERCIAL

BUILDING DESCRIPTION - RESIDENTIAL

Building Characteristics

Utilities

Height:

Water Supply:

No. of stories:

Public
Private

Gross area, sq. ft. per floor:

Sewage Disposal:

Use group:

Public
Private

Construction type:

Electric Yes ☐ No ☐
Gas Yes ☐ No ☐

Reinforced Concrete
Structural Steel
Masonry
Wood Frame

Heating System:

Electric ☐ Oil ☐
Natural Gas ☐
Propane Gas ☐

State Certified Modular

Sprinkler system: N/A ☐

Full
Partial
Other Suppression
of Heads

Building Characteristics

Utilities

SF Dwelling ☒ SF Townhouse ☐

Depth Width

1st floor:

2nd floor:

Basement:

Finished Basement ☐ Unfinished Basement ☐

Crawl space ☐ Slab on Grade ☐

No. of Bedrooms

Height:

Multi-family dwellings:

No. of efficiency units:

No. of 1 BR units:

No. of 2 BR units:

No. of 3 BR units:

Other Structure:

Dimensions:

Footings:

Roof Height:

State Certified Modular

Manufactured Home

Water Supply:

Public
Private

Sewage Disposal:

Public
Private

Electric Yes ☒ No ☐
Gas Yes ☒ No ☐

Heating System:

Electric ☐ Oil ☐
Natural Gas ☒
Propane Gas ☐

Sprinkler system: N/A ☐

NFPA #13D
NFPA #13R
Other:

THE UNDERSIGNED HEREBY CERTIFIES AND AGREES AS FOLLOWS: (1) THAT HE/SHE IS AUTHORIZED TO MAKE THIS APPLICATION; (2) THAT THE INFORMATION IS CORRECT; (3) THAT HE/SHE WILL COMPLY WITH ALL REGULATIONS OF HOWARD COUNTY WHICH ARE APPLICABLE THERE TO; (4) THAT HE/SHE WILL PERFORM NO WORK ON THE ABOVE REFERENCED PROPERTY NOT SPECIFICALLY DESCRIBED IN THIS APPLICATION; (5) THAT HE/SHE GRANTS COUNTY OFFICIALS THE RIGHT TO ENTER ONTO THIS PROPERTY FOR THE PURPOSE OF INSPECTING THE WORK PERMITTED AND POSTING NOTICES.

Applicant's Signature

Print Name

President/Horizons Unlimited Home Imp., Inc. April 15, 2009

Title/Company

Date

Checks payable to: DIRECTOR OF FINANCE OF HOWARD COUNTY

** PLEASE WRITE NEATLY AND LEGIBLY. **

- FOR OFFICE USE ONLY -

AGENCY DATE SIGNATURE APPROVAL
Land Development, DPZ 4/16/09
State Highways
Building Official
Dev. Engineering, DPZ
Health 4-16-09 Dana Bernard
Fire Protection
Is Sediment Control approval required prior to issuance?
YES ☐ NO ☐

DPZ SETBACK INFORMATION PROPERTY ID#:
Front: 75 FT Filing fee \$
Rear: 60 FT Permit fee \$
Side: 30 FT Excise tax \$
Side St.: NA Add'l per. fee \$
All minimum setbacks met? TOTAL FEES \$
YES ☒ NO ☐ Sub-total paid \$
Is Entrance Permit required? Balance due \$
YES ☐ NO ☒ Check \$
Historic District? Validation \$
YES ☐ NO ☒

CONTINGENCY CONSTRUCTION START: ☐

ONE STOP SHOP: ☐

Lot Coverage for New Town Zone

SDP/Red-line approval date

Accepted by

Distribution of Copies-

White: Building Official

Green: LDD, DPZ


Yellow: DED, DPZ

Pink: Health



Gold: SHA

T:\forms\PERMIT.FRM

Rev. 11/4/04

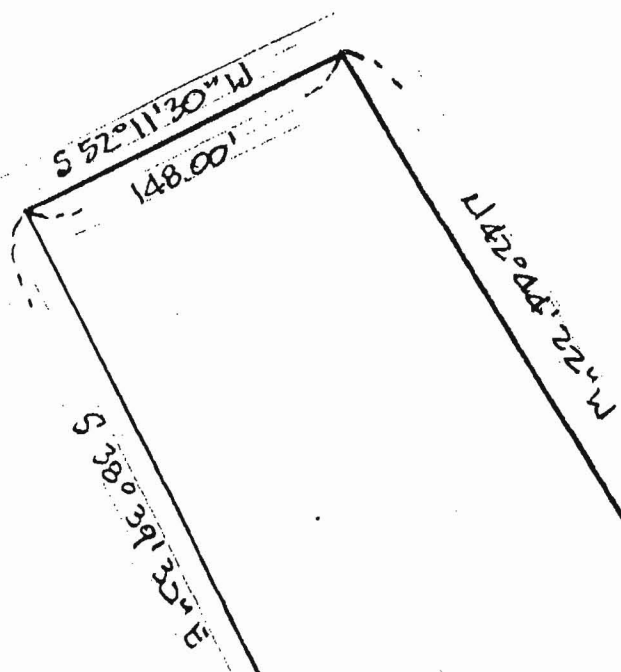

APPROVED
WALK-THRU BUILDING PERMIT
 BP# A#
 APP. SAN O Bernard DATE: 4-16-09
 DESC. OF WORK: Front Porch
w/ roof
**approved as shown*

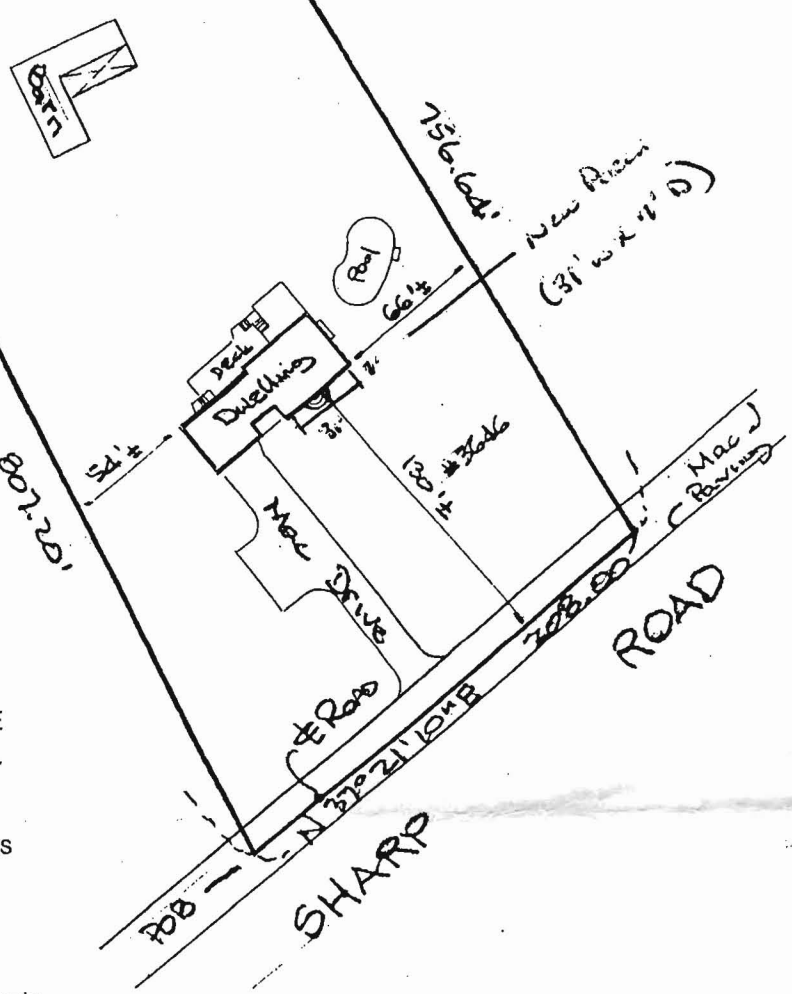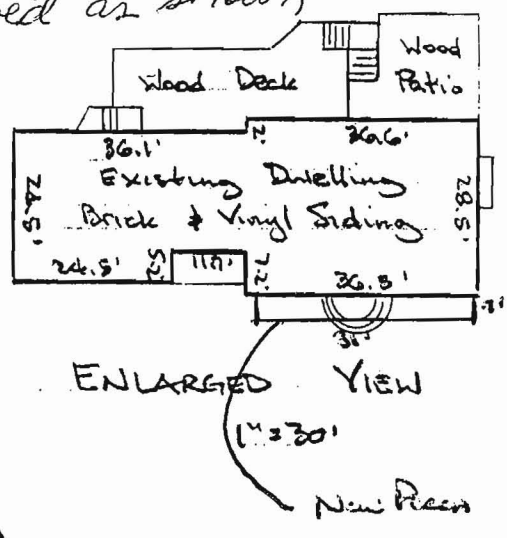

THE LOT SHOWN HEREON IS IN FLOOD
 ZONE C PER F.E.M.A. FLOOD INSURANCE
 RATE MAP PANEL# 240044-00208

The plat is of benefit to consumer only insofar as it is required by a lender or a title insurance company or its agent in connection with contemplated transfer, financing, or refinancing. The plat is not to be relied upon for the establishment or location of fences, garages, buildings, or other existing or future improvements. The plat does not provide for the accurate identification of property boundary lines, but such identification may not be required for the transfer of title or securing financing or refinancing. The plat contains a tolerance of accuracy of two feet, more or less.

Ertel Associates, Inc.

8425 Hallmark Circle
 Baltimore, Maryland 21234
 Phone: 410-882-0989 • Fax: 410-882-0842

LOCATION DRAWING
#3006 SHARP ROAD
LIBER 1288, FOLIO 196-PARCEL 1
HOWARD COUNTY, MD.

DATE: 8/2/08	SCALE: 1"=80'	FILE: 08-498 HT
---------------------	----------------------	------------------------