

Fill out in triplicate.
Make \$30.00 check payable:
Howard County Health Dept. - Sanitation

APPLICATION

A 23682(1)

SEWAGE DISPOSAL TESTING

P _____

STATE OF MARYLAND - DEPARTMENT OF HEALTH AND MENTAL HYGIENE

HOWARD COUNTY HEALTH DEPARTMENT
ENVIRONMENTAL HEALTH SERVICES

3BR

1000 gal. Septic tank

4 B.R.

1250 gal. Septic tank

DISTRICT

4

DATE

8/6/76

P. O. BOX 476, ELLICOTT CITY, MARYLAND 21043

TELEPHONE: 465-5000, EXT. 356

Drywell to have 130 SQ. FT. effective sidewall absorption area for Bedroom to begin below the first 5 foot of non-porous soil. Maximum depth permitted for drywell is 12 ft. below original grade. Place the drywell about 30 ft. EAST of house midway between perc. test holes 1 & 2.

TO: THE COUNTY HEALTH OFFICER
ELLICOTT CITY, MARYLAND

I, HEREBY, APPLY FOR THE NECESSARY TEST IN ORDER TO CONSTRUCT (OR RECONSTRUCT) A SEWAGE DISPOSAL SYSTEM.

PROPERTY OWNER Lawton T. Sharp, Inc.

ADDRESS 3779 Sharp Rd., Glenwood PHONE 489-4630

PROPERTY LOCATION: 3779 Sharp Rd., Glenwood

SUBDIVISION land not being subdivided LOT NO. _____

ROAD AND DESCRIPTION One mile south of Glenely High School on east side of Sharp Rd.

Lot-11 (F-88-104)

SIZE OF LOT part of 187 acre farm ~186 ac. TYPE BLDG. 2 3
NUMBER OF BEDROOMS

IF NOT SINGLE RESIDENCE DESCRIBE _____

THE SYSTEM INSTALLED UNDER THIS APPLICATION IS ACCEPTABLE ONLY UNTIL PUBLIC FACILITIES BECOME AVAILABLE.

SIGNATURE OF APPLICANT Francis L. Sharp BLDG. PERMIT SIGNED AND RETURNED _____

APPROVED BY Frank Sheiner FOR Drywell DATE 7/1/77
(KIND OF SYSTEM)



REJECTED BY _____ FOR _____ DATE _____
(KIND OF SYSTEM)

HOLD PENDING FURTHER TESTS _____ DATE _____

REASONS FOR REJECTION OR HOLDING _____

THIS IS NOT A PERMIT

A23682

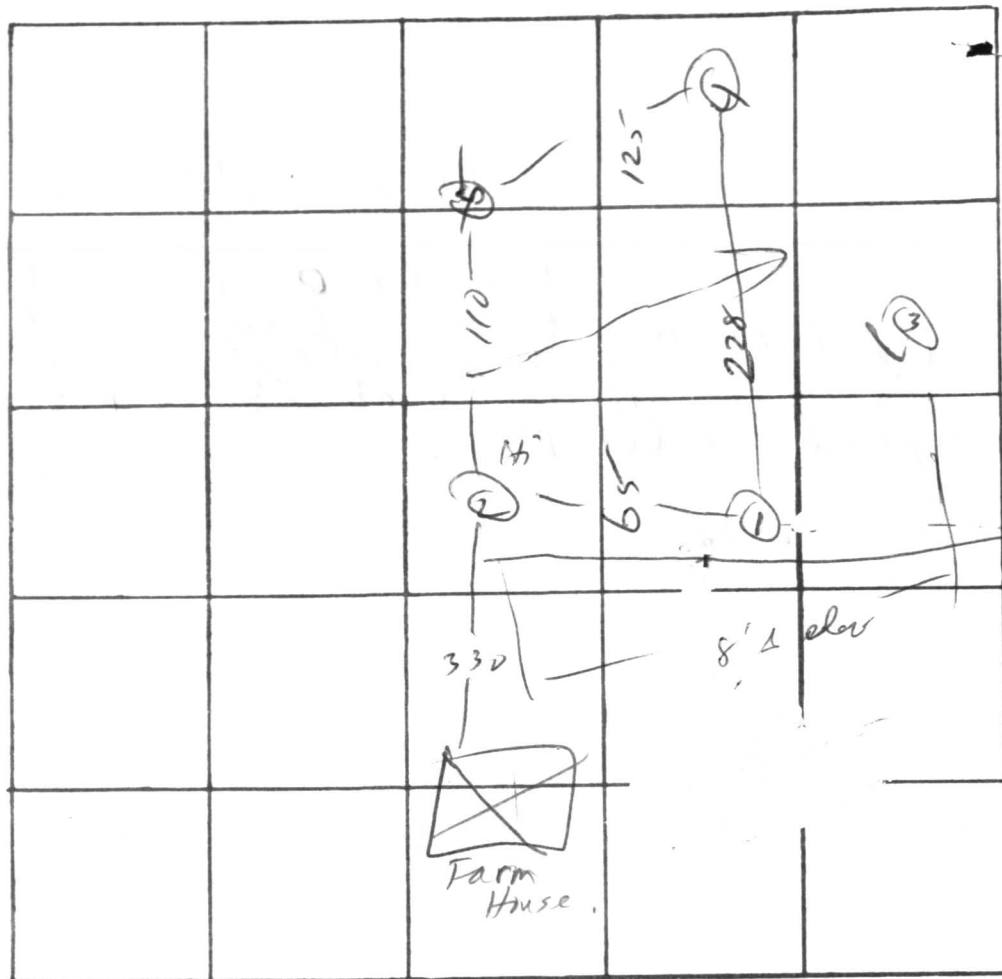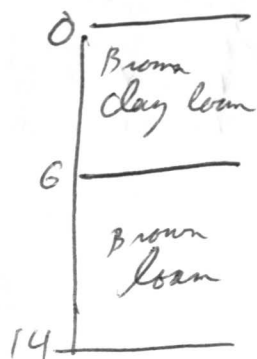

INDICATE NORTH. - NAME ADJOINING ROADWAY AS BASE LINE

DATE	TEST NO.	DEPTH	PRE-WET		TEST - 1" DROP		TIME
			START	STOP	START	STOP	
8/31/77	1	6	10 ²⁰	10 ²²	10 ²²	10 ³⁴	12
	1A	14	10 ²⁰	↓	↓	10 ²⁸	6
	2	6	10 ²⁴	10 ³³	10 ³³	10 ³⁷	4
	2A	14	10 ²⁴	10 ²⁹	10 ²⁹	10 ³⁵	6
	(3)	14'	water @ 14'				
	4	6	10 ⁴⁰	10 ⁴³	10 ⁴³	10 ⁴⁶	3
	4A	14	↓	10 ⁴²	10 ⁴²		
	5	14	vis	dry			

REMARKS perc for proposed house; R.B. & F.S. on 3/4/77TYPE OF SOIL TESTED BY ALSO PRESENT: