

04-351312

PERMIT

P 26394

A 23682 (1)

SEWAGE DISPOSAL SYSTEM

MARYLAND STATE DEPARTMENT OF HEALTH

HOWARD COUNTY

ELLICOTT CITY

DISTRICT 4th

DATE 7/6/77

INDEXED

Jack Fyock

~~Lawton T. Sharp~~IS PERMITTED TO INSTALL ☒ ALTERADDRESS ~~3779~~ Sharp Road, Glenwood, Md.

3755

PHONE 489-4630

A SEWAGE DISPOSAL SYSTEM LOCATED AT

SUBDIVISION

3755
ROAD Sharp Road

LOT

11

F-88-104

PROPERTY OWNER Lawton T. Sharp

ADDRESS same as above

SPECIFICATIONS 2 bedrooms

DRAIN FIELD DEPTH FEET, BOTTOM AREA SQ. FT.

SEEPAGE PITS ABSORBENT SIDE-WALL AREA SQ. FT.

SEPTIC TANK CAPACITY 1000 GALLONS

FOR GARBAGE GRINDER, INCREASE DISPOSAL AREA 22% & TANK CAPACITY 50%.

OTHER DRY WELL-to have 130 sq. ft. effective sidewall absorption area per bedroom to begin below the first 5 ft. of non-porous soil. Maximum depth permitted for dry well is 12 ft. below original grade. Place the dry well about 30 ft. east of house midway between perc test holes 1 & 2.

NOTE: ALL PIPE FROM HOSE TO DISPOSAL AREA MUST BE CAST IRON. PERMIT VOID AFTER 3 YEARS.
NOTE: INSTALL STAND PIPES ON SEPTIC TANK AND DRY WELL. STAND PIPES MUST BE 6 INCHES IN DIAMETER. CAST IRON, CONCRETE OR TERRA COTTA ACCEPTED.

PLANS APPROVED BY Frank Skinner


DATE 7/1/77

FILL SEPTIC TANK AND DISTRIBUTION BOX WITH WATER BEFORE CALLING FOR AN INSPECTION. COVER NO WORK UNTIL INSPECTED AND APPROVED.

NEITHER THE HOWARD COUNTY COMMISSIONERS NOR THE HEALTH DEPARTMENT IS RESPONSIBLE FOR THE SUCCESSFUL OPERATION OF ANY SYSTEM.

A 23682

A23682

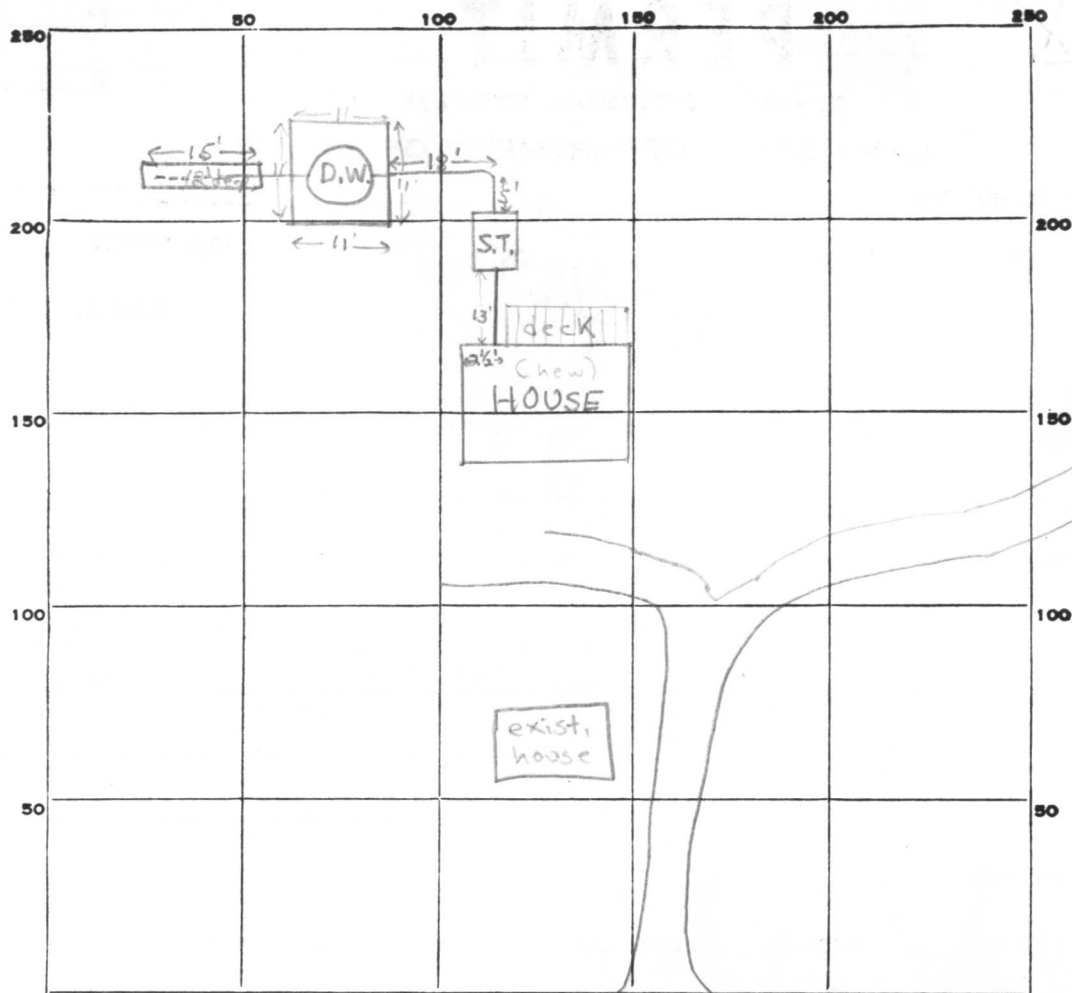

INDICATE NORTH. - NAME ADJOINING ROADWAY AS-BASE LINE.

Sharp Road

PERMIT CARD signed final O.K. F.S.

S.T. | D.W.


SEPTIC TANK, LEVEL ✓CLEANOUTS ✓ ✓DISTRIBUTION BOX, LEVEL n.a.TILE FIELD, DEPTH 12 FT. TRENCH WIDTH 2 FT.GRAVEL DEPTH 8 FT. TOTAL LENGTH 15 FT.NUMBER OF TRENCHES 1 $\frac{1}{2}$ SIDEWALL
TOTAL BOTTOM AREA 105 ft^2 SEEPAGE PITS, INSIDE DIAMETER 44 FT.DEPTH BELOW INLET 8 FT.Drywell abs. area 308 ft^2 ABSORBENT AREA ±413 SQ. FT.REMARKS 7/18/77 O.K. to put gravel in trench; drywell in. at 4' F.S.7/18/77 O.K. to backfill system F.S.

DATE SYSTEM APPROVED

7/18/77

INSPECTOR

Frank Skinner

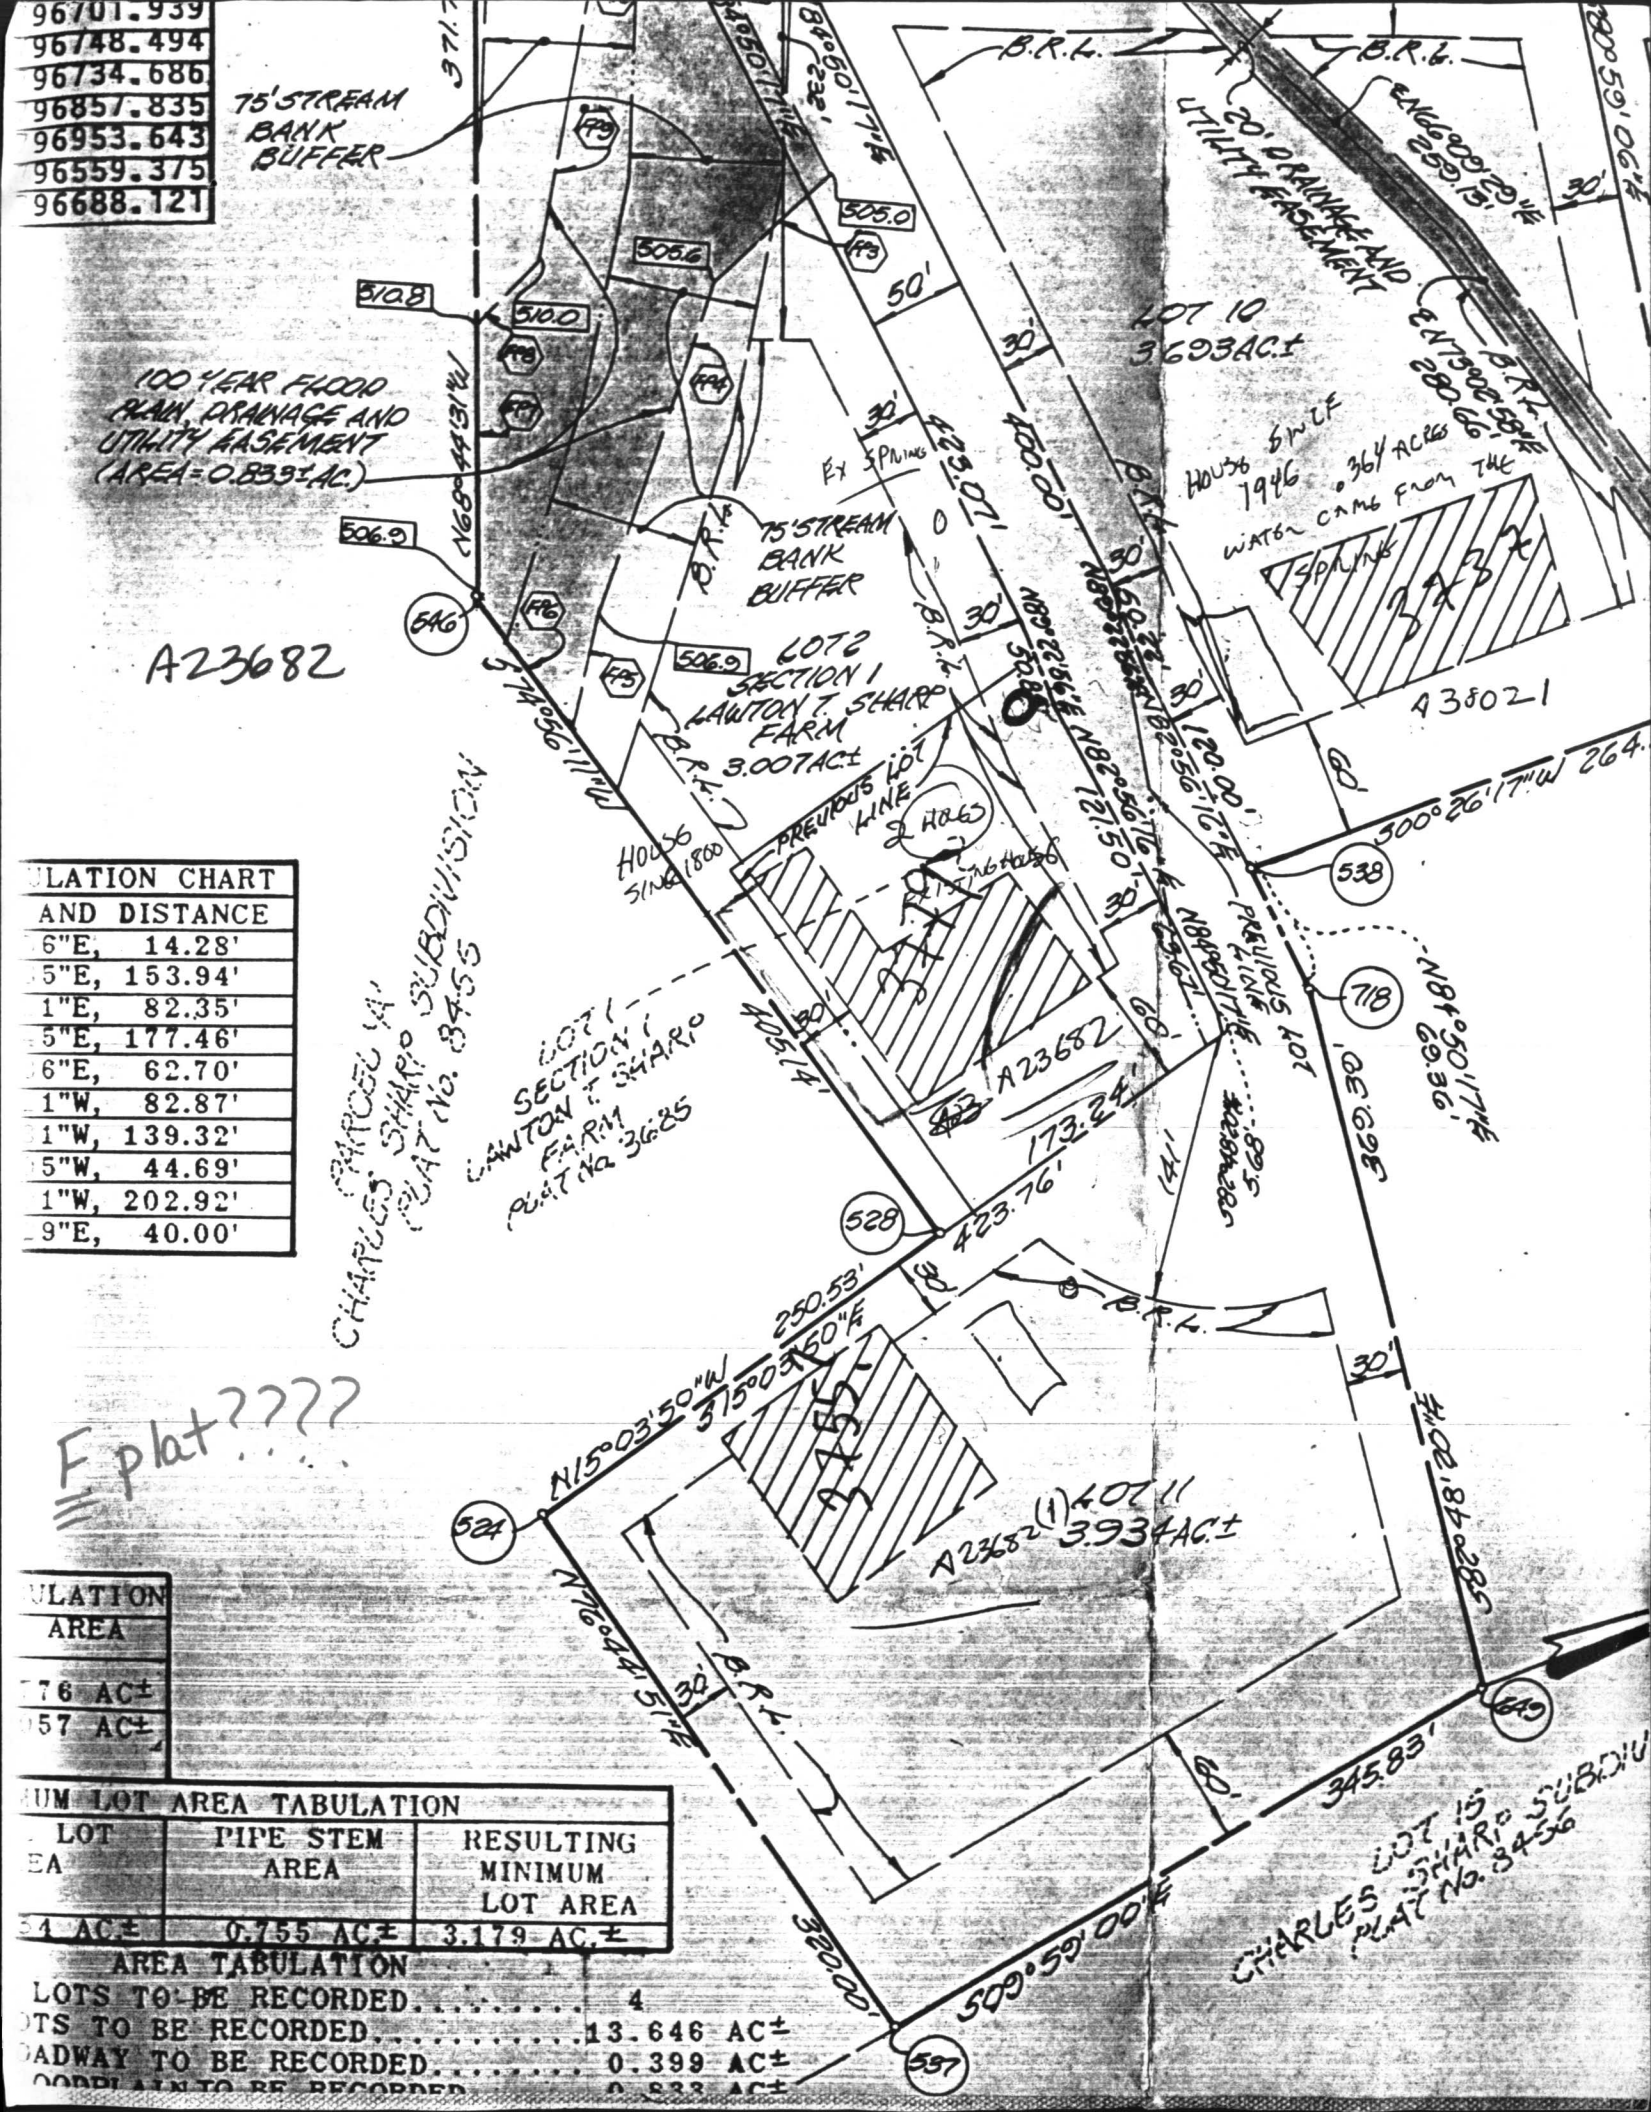

A23682

NORTH

1768'

1210'

TRIDELPHIA RD
906'

120 A.-PART
OF TOTAL-187 A.

STREAM

PROPOSED HOUSE
540' MSL

870'

345'

280'

HOUSES

600'

BARN

1725'
SHARP RD.

735'
SHARP RD.

990'

388'

195'

PLOT PLAN

CHARLES SHARP

7-20-76

SCALE
1" ≈ 345'

GLENWOOD, MD.