

HOWARD COUNTY
PERMIT APPLICATION

PERMIT NUMBER

Building Address 3779 Sharp Rd.
Glenwood, MD 21738
Suite/Apt. #: _____ SDPWP/Petition # Per 44520
Census Tract 004002 Subdivision LAWN T. SHAW
Section 1 Area _____ Lot 2
Tax Map 21 Parcel 179 Grid B
Zoning R100 Map Coordinates _____ Lot size 3.007ac

Property Owner's Name George T & Laura L Bergling
Address 3779 Sharp Rd.
City Glenwood State MD Zip Code 21738

Existing Use Single Family Home
Proposed Use Same w/ Detached Polebarn
Estimated Construction Cost \$ 16,000.

Home Phone 410-451-2314 Work Phone _____
Applicant's Name & Mailing Address, (if other than stated hereon):

Description of Work 1-story
Polebarn/Storage for
storage of lawn equipment
24x24 @ 8x24 ft.

Phone _____ Fax _____

Occupant or Tenant Owner

Contractor Company Owner

Contact Name _____

Contact Person _____

Address _____

Address _____

City _____ State _____ Zip Code _____

City _____ State _____ Zip Code _____

Phone _____ Fax _____

License No. _____

Phone _____ Fax _____

Engineer or Architect Company _____

Contact Person _____

Address _____

City _____ State _____ Zip Code _____

Phone _____ Fax _____

BUILDING DESCRIPTION - COMMERCIAL

BUILDING DESCRIPTION - RESIDENTIAL

Building Characteristics	Utilities
Height: _____	Water Supply: _____
No. of stories: _____	Public _____
Gross area, sq. ft. per floor: _____	Private _____
Use group: _____	Sewage Disposal: _____
Construction type: _____	Public _____
Reinforced Concrete _____	Private _____
Structural Steel _____	Electric Yes <input type="checkbox"/> No <input type="checkbox"/>
Masonry _____	Gas Yes <input type="checkbox"/> No <input type="checkbox"/>
Wood Frame _____	Heating System: _____
State Certified Modular _____	Electric <input type="checkbox"/> Oil <input type="checkbox"/>
	Natural Gas <input type="checkbox"/>
	Propane Gas <input type="checkbox"/>
	Sprinkler system: N/A <input type="checkbox"/>
	Full _____
	Partial _____
	Other Suppression _____
	# of Heads _____

Building Characteristics	Utilities
SF Dwelling <input type="checkbox"/> SF Townhouse <input type="checkbox"/>	Water Supply: _____
Depth _____ Width _____	Public _____
1st floor: _____	Private <input checked="" type="checkbox"/>
2nd floor: _____	Sewage Disposal: _____
Basement: _____	Public _____
Finished Basement <input type="checkbox"/> Unfinished Basement <input type="checkbox"/>	Private <input checked="" type="checkbox"/>
Crawl space <input type="checkbox"/> Slab on Grade <input type="checkbox"/>	Electric Yes <input type="checkbox"/> No <input type="checkbox"/>
No. of Bedrooms _____	Gas Yes <input type="checkbox"/> No <input type="checkbox"/>
Height: _____	Heating System: _____
Multi-family dwellings: _____	Electric <input type="checkbox"/> Oil <input type="checkbox"/>
No. of efficiency units: _____	Natural Gas <input type="checkbox"/>
No. of 1 BR units: _____	Propane Gas <input type="checkbox"/>
No. of 2 BR units: _____	Sprinkler system: N/A <input type="checkbox"/>
No. of 3 BR units: _____	NFPA #13D _____
Other Structure: _____	NFPA #13R _____
Dimensions: _____	Other: _____
Footings: _____	
Roof Height: _____	
State Certified Modular _____	
Manufactured Home _____	

THE UNDERSIGNED HEREBY CERTIFIES AND AGREES AS FOLLOWS: (1) THAT HE/SHE IS AUTHORIZED TO MAKE THIS APPLICATION; (2) THAT THE INFORMATION IS CORRECT; (3) THAT HE/SHE WILL COMPLY WITH ALL REGULATIONS OF HOWARD COUNTY WHICH ARE APPLICABLE THERETO; (4) THAT HE/SHE WILL PERFORM NO WORK ON THE ABOVE REFERENCED PROPERTY NOT SPECIFICALLY DESCRIBED IN THIS APPLICATION; (5) THAT HE/SHE GRANTS COUNTY OFFICIALS THE RIGHT TO ENTER ONTO THIS PROPERTY FOR THE PURPOSE OF INSPECTING THE WORK PERMITTED AND POSTING NOTICES.

Laura Lyne Bergling
Applicant's Signature
Owner
Title/Company

Laura Lyne Bergling
Print Name
Date _____

Checks payable to: **DIRECTOR OF FINANCE OF HOWARD COUNTY**
** PLEASE WRITE NEATLY AND LEGIBLY. **
- FOR OFFICE USE ONLY -

AGENCY DATE SIGNATURE APPROVAL
Land Development, DPZ
State Highways
Building Official
Dev. Engineering, DPZ
Health Shel A. Coughton 12/21/2005
Fire Protection
Is Sediment Control approval required prior to issuance?
YES ☐ NO ☐

DPZ SETBACK INFORMATION PROPERTY ID#:
Front: 150' Filing fee \$
Rear: 60' (20) Permit fee \$
Side: 30' (20) Excise tax \$
Side St: N/A Add'l per. fee \$
All minimum setbacks met? TOTAL FEES \$
YES ☐ NO ☐ Sub-total paid \$
Is Entrance Permit required? Balance due \$
YES ☐ NO ☐ Check #
Historic District? Validation #
YES ☐ NO ☐
Lot Coverage for NewTown Zone _____
SDP/Red-line approval date _____ Accepted by _____
Yellow: DED, DPZ Pink: Health Gold: SHA

Distribution of Copies: White: Building Official Green: LDD, DPZ
T:\Home\PERMIT.FRM

APPROVED


EXTERIOR BUILDING (FLOOR)

APPROVED BY: 0-46744

DATE: 12/21/05

WORK: 24x24 Garage / pole barn

w/ 8x24 open porch

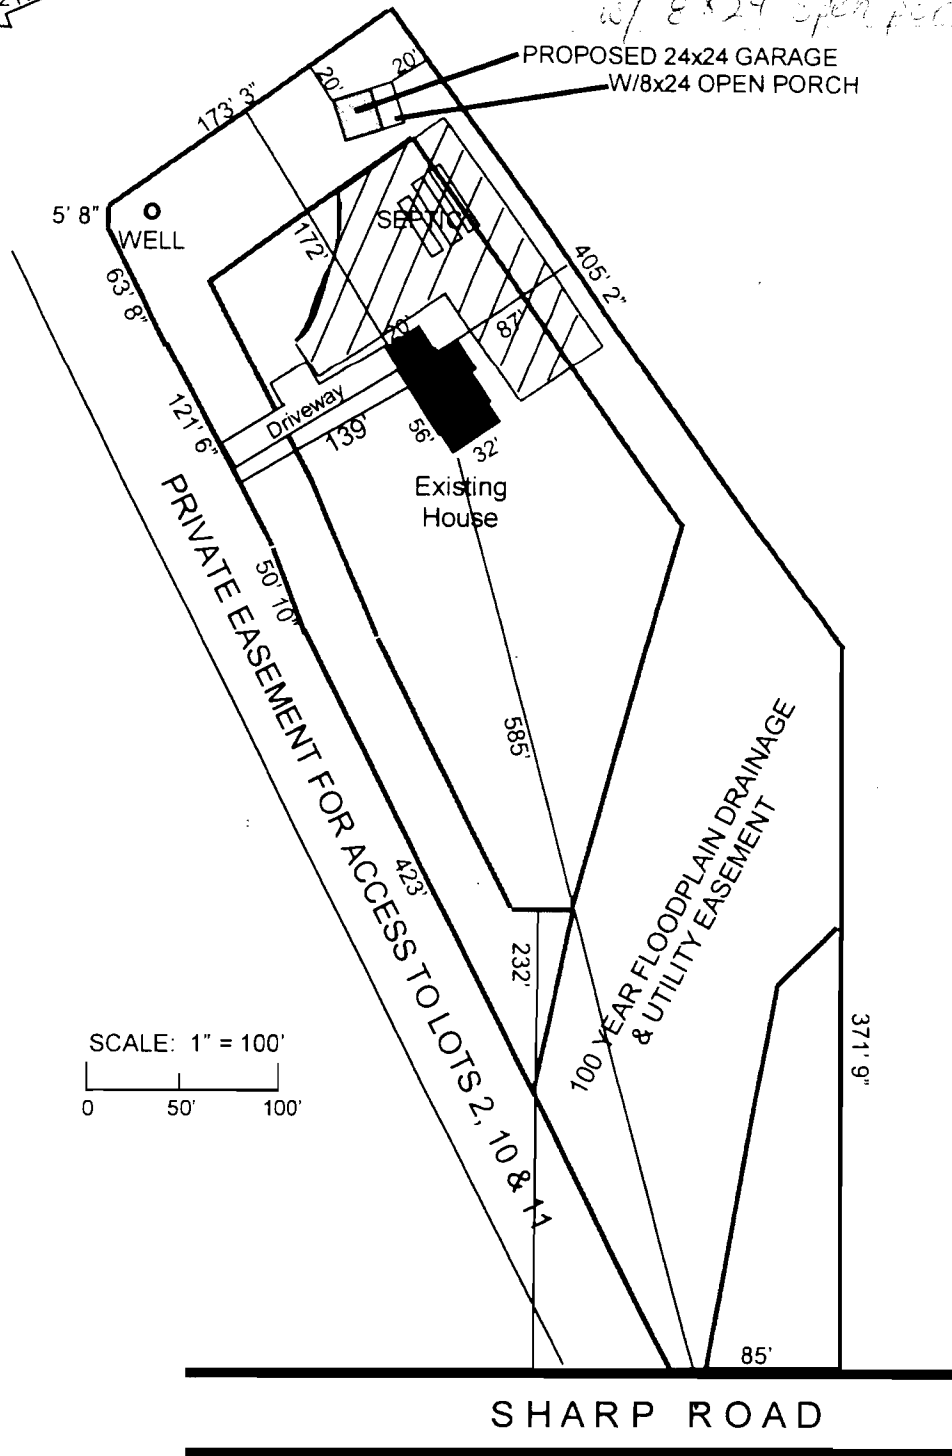

3779 Sharp Road
Tax Map 21 / Parcel 149 / Lot 2 3.007 acres
CHARLES SHARP SUBDIVISION (LOTS 9-11)
& LOT 2-SECTION I, LAWTON T. SHARP FARM

late,

I request of various of
the standard 20' setback
to 10' for our proposed
garage due to site
limitations

Lynne B. Uglitz

3779 Sharp Rd.
Glenwood, Md.

21738

Variance Request
granted 12/21/05

per Mike Davis.

Salvatore A. Uglitz