

4-13' Loes
12,000 ft.
Recorded

APPLICATION

SEWAGE DISPOSAL TESTING

STATE OF MARYLAND - DEPARTMENT OF HEALTH AND MENTAL HYGIENE

HOWARD COUNTY HEALTH DEPARTMENT
ENVIRONMENTAL HEALTH SERVICES

P. O. BOX 476, ELLICOTT CITY, MARYLAND 21043
TELEPHONE: 465-5000, EXT. 356

A 23682
Existing House
P _____
DISTRICT 4
DATE 8/6/76

Plat
F-77-116

8/31/76
9:30

TO: THE COUNTY HEALTH OFFICER
ELLICOTT CITY, MARYLAND

I, HEREBY, APPLY FOR THE NECESSARY TEST IN ORDER TO CONSTRUCT (OR RECONSTRUCT) A SEWAGE DISPOSAL SYSTEM.

PROPERTY OWNER Lawton T. Sharp, Inc.

ADDRESS 3779 Sharp Rd. Glenwood PHONE 489-4630

PROPERTY LOCATION: 3779 Sharp Rd. Glenwood

SUBDIVISION land not being subdivided LOT NO. Lot 2 on FINAL

ROAD AND DESCRIPTION One mile south of Glenely High School on east side of Sharp Rd.

SIZE OF LOT part of 187 acre farm TYPE BLDG. 2 ^{Lot 2} F-88-104
NUMBER OF BEDROOMS

IF NOT SINGLE RESIDENCE DESCRIBE _____

THE SYSTEM INSTALLED UNDER THIS APPLICATION IS ACCEPTABLE ONLY UNTIL PUBLIC FACILITIES BECOME AVAILABLE.

SIGNATURE OF APPLICANT Francis L. Sharp


APPROVED BY Frank Skinner FOR existing DATE 5/16/77
(KIND OF SYSTEM)

REJECTED BY _____ FOR _____ DATE _____
(KIND OF SYSTEM)

HOLD PENDING FURTHER TESTS _____ DATE _____

REASONS FOR REJECTION OR HOLDING _____

THIS IS NOT A PERMIT

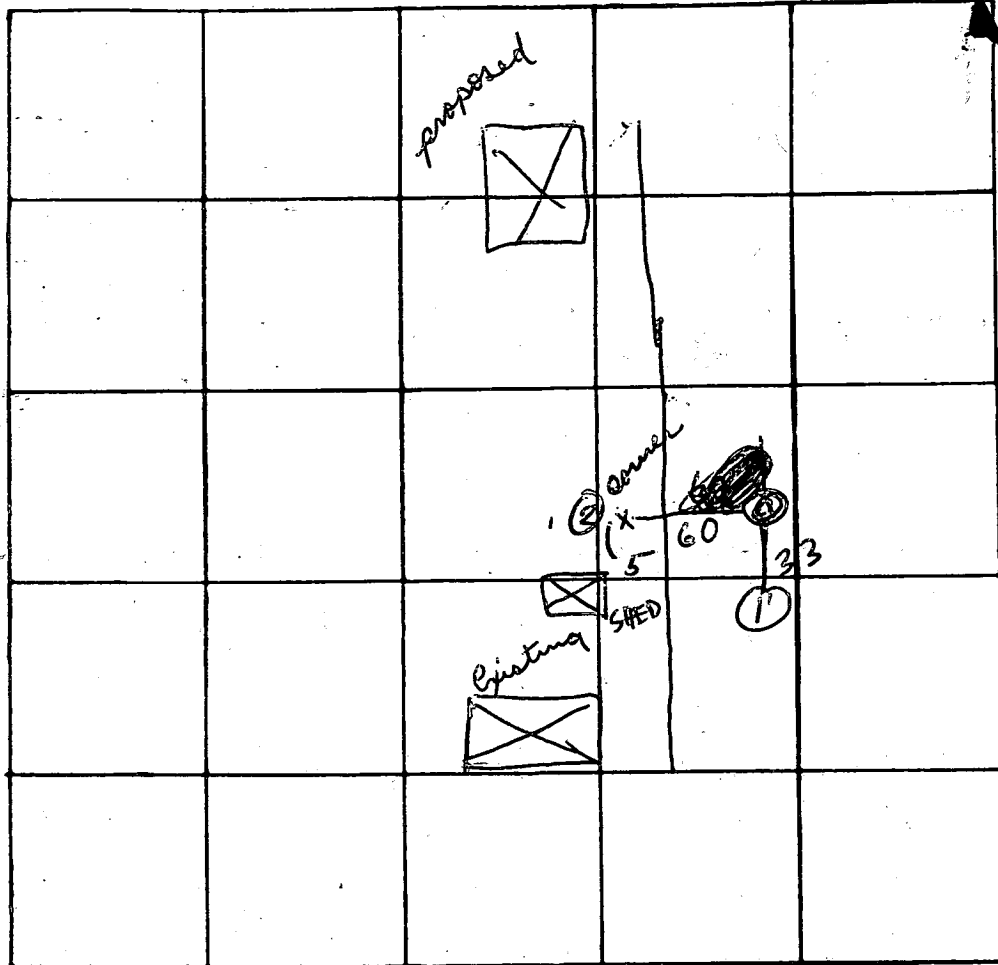

INDICATE NORTH. - NAME ADJOINING ROADWAY AS BASE LINE.

DATE	TEST NO.	DEPTH	PRE-WET		TEST - 1" DROP		TIME
			START	STOP	START	STOP	
3/4/77	1	12 ft	Clay to	4~	sandy	@ 12	
	2	17 ft	Clay to	4~	sandy	@ 17	

REMARKS existing house

TYPE OF SOIL

TESTED BY R.B. & F.S.

ALSO PRESENT: Brighthouse, Sharps