

DEPARTMENT OF INSPECTIONS, LICENSES AND PERMITS
3430 COURT HOUSE DRIVE
ELICOTT CITY, MD 21043
PERMITS (410) 313-2455 INSPECTIONS (410) 313-1810
AUTOMATED INFORMATION (410) 313-3800HOWARD COUNTY
PERMIT APPLICATION

PERMIT NUMBER

B08000958.

Building Address 21737
4070 Sharp Rd, Glen Elg MD

Suite/Apt. #: _____ SDP/WPI/Petition #: _____

Census Tract 62510 Subdivision The HeritageSection 1 Area 1 Lot 6Tax Map 21 Parcel 175 Grid 15Zoning R-1 Map 2 Coordinates _____ Lot size 1.7 ACExisting Use SFDProposed Use SFDEstimated Construction Cost \$ 250,000Description of Work New screened porchwith fireplace, 2 new decks,new mudroom, new porticonew kitchen, 3 new baths,finished basement,Occupant or Tenant ownerContact Name owner

Address _____

City _____ State _____ Zip Code _____

Phone 301-641-4063 Fax _____Property Owner's Name Jamie and ElliottAddress Whitten4070 Sharp Rd, Glen Elg,City Glen Elg State MD Zip Code 21737Home Phone 410-489-6099 Work Phone 410-489-6023

Applicant's Name & Mailing Address, (if other than stated hereon): _____

Phone _____ Fax _____

Contractor Company at bid

Contact Person _____

Address _____

City _____ State _____ Zip Code _____

License No. _____

Phone _____ Fax _____

Engineer or Architect Company Stewart McCreadyContact Person Architects PACraig StewartAddress 8329 Main St,City Ellicott City State MD Zip Code 21043Phone 410-465-7687 Fax 410-465-7737

BUILDING DESCRIPTION - COMMERCIAL

BUILDING DESCRIPTION - RESIDENTIAL

Building Characteristics

Utilities

Height: _____

No. of stories: _____

Gross area, sq. ft. per floor: _____

Use group: _____

Construction type:

____ Reinforced Concrete

____ Structural Steel

____ Masonry

____ Wood Frame

____ State Certified Modular

Water Supply:

____ Public

____ Private

Sewage Disposal:

____ Public

____ Private

Electric Yes ☐ No ☐Gas Yes ☐ No ☐

Heating System:

Electric ☐ Oil ☐Natural Gas ☐Propane Gas ☐Sprinkler system: N/A ☐

____ Full

____ Partial

____ Other Suppression

____ # of Heads

Building Characteristics

Utilities

SF Dwelling ☒ SF Townhouse ☐

Depth Width

1st floor: 30 50'2nd floor: 30 36Basement: 30 36Finished Basement ☒ Unfinished Basement ☐Crawl space ☐ Slab on Grade ☐No. of Bedrooms 3Height: 30'

Multi-family dwellings:

No. of efficiency units: ducksNo. of 1 BR units: 14 x 21.5'No. of 2 BR units: 5 x 28'No. of 3 BR units: 5 x 28'Other Structure: porchDimensions: 16 x 22Footings: contRoof Height: 19

____ State Certified Modular

____ Manufactured Home

Water Supply:

____ Public

☒ Private

Sewage Disposal:

____ Public

☒ PrivateElectric Yes ☐ No ☐Gas Yes ☐ No ☐

Heating System:

Electric ☒ Oil ☐Natural Gas ☐Propane Gas ☐Sprinkler system: N/A ☐

____ NFPA #13D

____ NFPA #13R

____ Other:

THE UNDERSIGNED HEREBY CERTIFIES AND AGREES AS FOLLOWS: (1) THAT HE/SHE IS AUTHORIZED TO MAKE THIS APPLICATION; (2) THAT THE INFORMATION IS CORRECT; (3) THAT HE/SHE WILL COMPLY WITH ALL REGULATIONS OF HOWARD COUNTY WHICH ARE APPLICABLE THERETO; (4) THAT HE/SHE WILL PERFORM NO WORK ON THE ABOVE REFERENCED PROPERTY NOT SPECIFICALLY DESCRIBED IN THIS APPLICATION; (5) THAT HE/SHE GRANTS COUNTY OFFICIALS THE RIGHT TO ENTER ONTO THIS PROPERTY FOR THE PURPOSE OF INSPECTING THE WORK PERMITTED AND POSTING NOTICES.

Craig Stewart ArchApplicant's Signature Stewart-McCready Arch

Title/Company

CRAIG L. STEWART,

Print Name

4-7-08 4/9/08

Date

Checks payable to: DIRECTOR OF FINANCE OF HOWARD COUNTY

** PLEASE WRITE NEATLY AND LEGIBLY. **

- FOR OFFICE USE ONLY -

AGENCY

DATE

SIGNATURE APPROVAL

☒ Land Development, DPZ☒ State Highways☒ Building Official☒ Dev. Engineering, DPZ☒ Health☒ Fire Protection☒ Is Sediment Control approval required prior to issuance?YES ☐ NO ☐CONTINGENCY CONSTRUCTION START: ☐ONE STOP SHOP: ☐

Distribution of Copies-

White: Building Official

Green: LDD, DPZ

Yellow: DED, DPZ

Pink: Health

Gold: SHA

T:\forms\PERMIT.FRM

PLANS RECEIVED

Rev. 11/4/04

DPZ SETBACK INFORMATION

PROPERTY ID#

Front: _____

Filing fee \$ 25.00

Rear: _____

Permit fee \$ 70.56

Side: _____

Excise tax \$ _____

Side St.: _____

Add'l per. fee \$ 7.06

All minimum setbacks met?

TOTAL FEES \$ _____

YES ☐ NO ☐

Sub-total paid \$ _____

Is Entrance Permit required?

Balance due \$ _____

YES ☐ NO ☐Check # 1450

Historic District?


Validation # _____

YES ☐ NO ☐

Lot Coverage for NewTown Zone _____

SDP/Red-line approval date _____

Accepted by 9

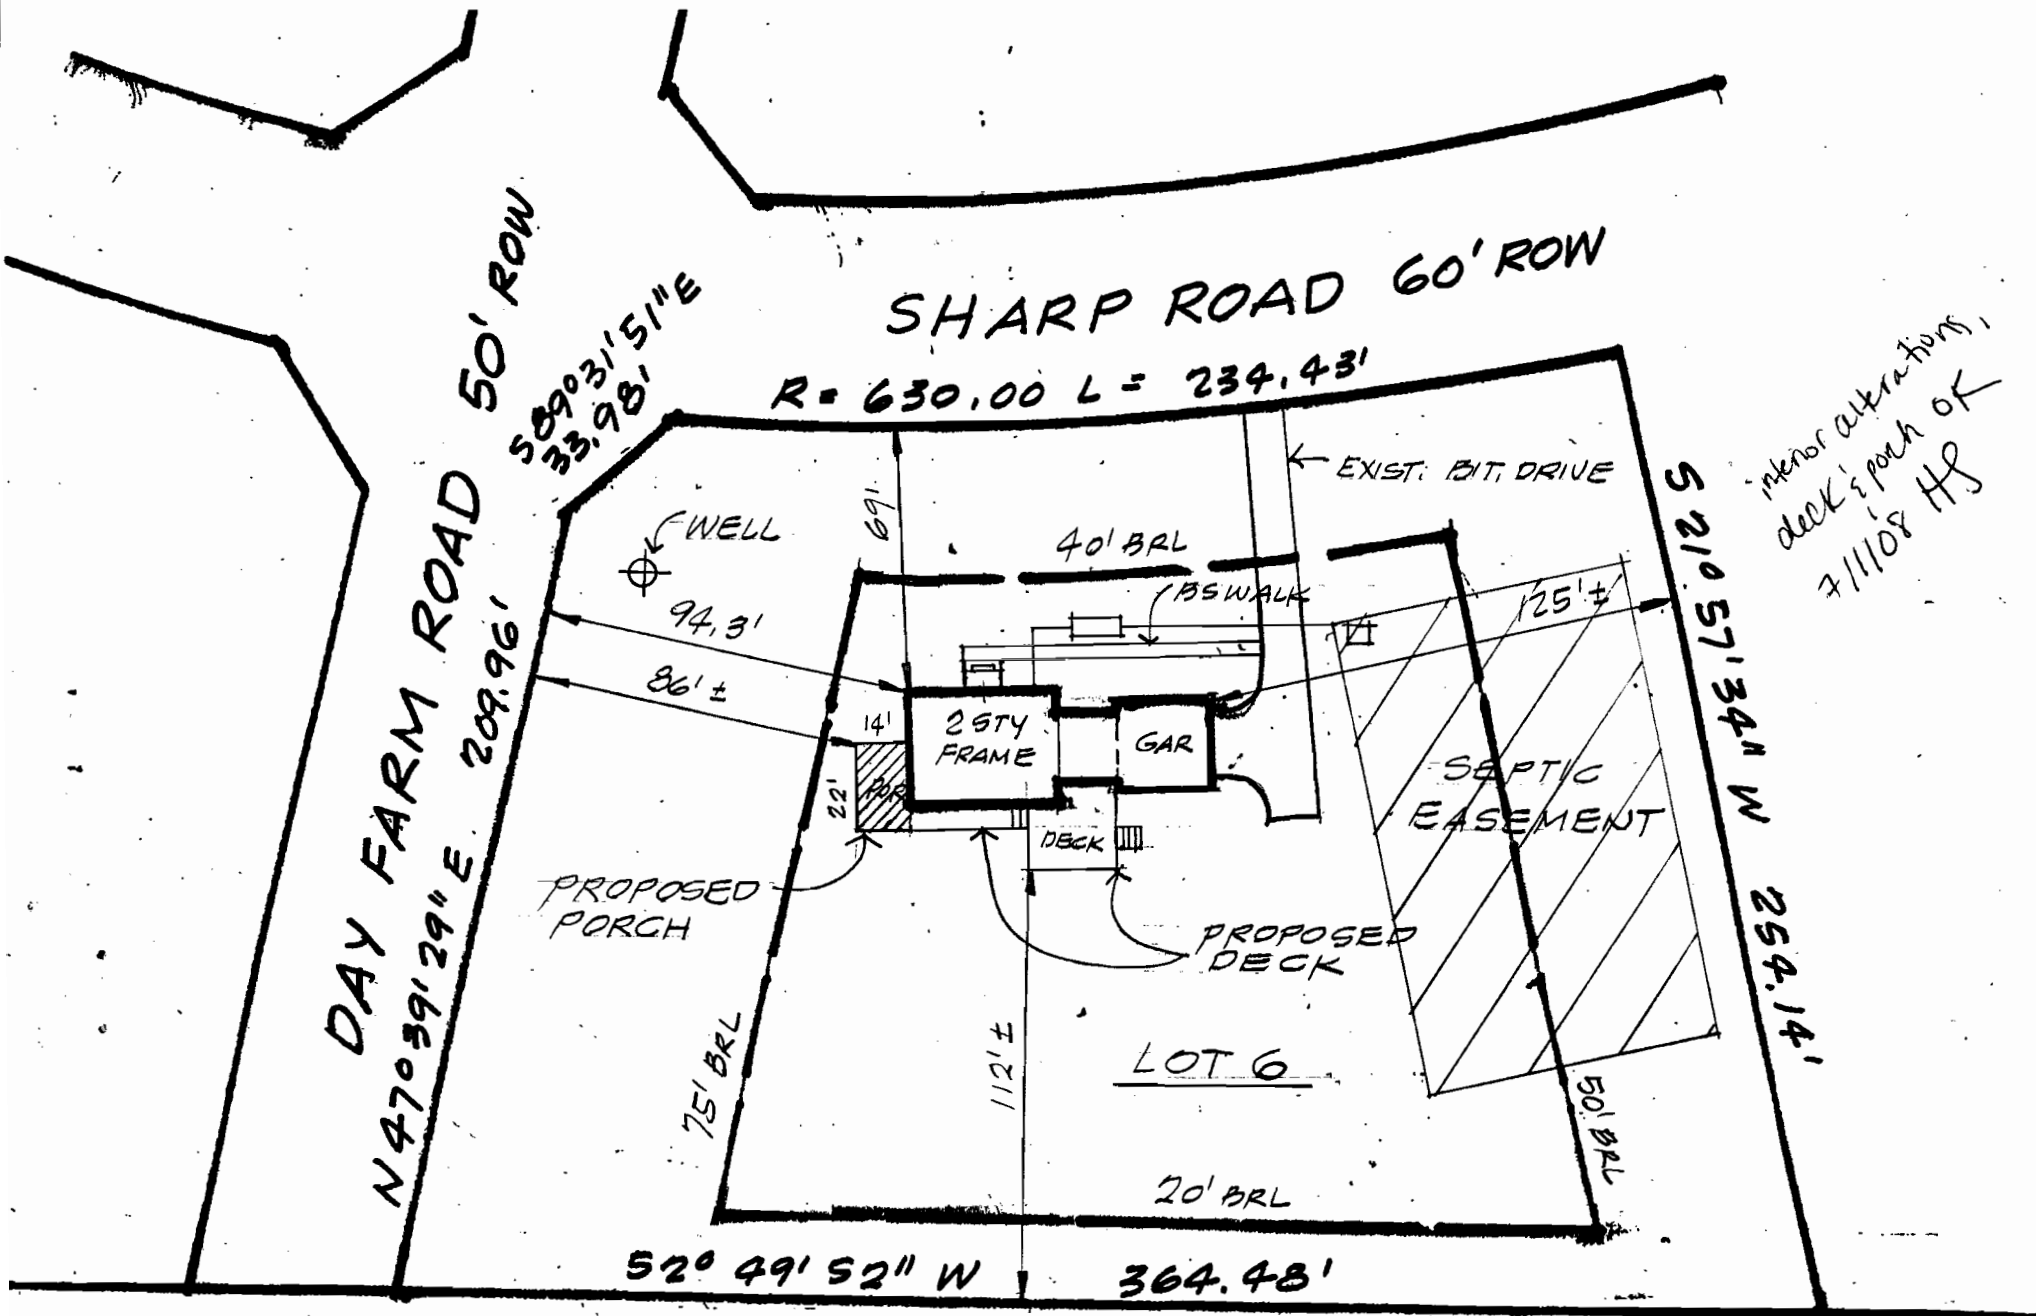

SITE PLAN 1" = 50'
 4070 SHARP ROAD, GLEN ELG, MD
 LOT 6 SEC 1 AREA 1 THE HERITAGE

3-14-08