

LAYOUT 3/20/07 INSP 4 _____
INSP 2 _____ INSP 5 _____
INSP 3 _____ INSP 6 _____

ISSUE DATE: 02/27/2007

APPROVAL DATE: 3/21/07

PERMIT

P 526253

A 525654 UPGRADE

TAX ID #

**ON-SITE SEWAGE DISPOSAL SYSTEM
HOWARD COUNTY HEALTH DEPARTMENT
BUREAU OF ENVIRONMENTAL HEALTH**

Fogles Septic Clean IS PERMITTED TO INSTALL ☒ ALTER ☐

ADDRESS: 580 Obrecht Road PHONE NUMBER: 410-795-5670

SUBDIVISION: _____ LOT NUMBER: _____

ADDRESS: 2600 Thompson Drive PROPERTY OWNER: Zaheer Chano

SEPTIC TANK CAPACITY (GALLONS): 2000 OUTLET BAFFLE FILTER REQUIRED ☐

PUMP CHAMBER CAPACITY (GALLONS): N/A COMPARTMENTED TANK REQUIRED ☒

NUMBER OF BEDROOMS: 7

APPLICATION RATE: 0.8

LINEAR FEET OF TRENCH REQUIRED: 374 262

TRENCHES:	Trench to be 2 feet wide. Inlet 3.5 feet below original grade. Bottom maximum depth 7 feet below original grade. Effective area begins at 5 feet below original grade. 3.5 feet of stone below distribution pipe.
LOCATION:	
NOTES:	Tank needs to be 20' from addition. Addition needs to be staked or clearly located prior to layout inspection. Call for a layout inspection.

PLANS APPROVED: SF DATE: 2/8/07

NOTE: PERMIT VOID AFTER 2 YEARS


NOTE: CONTRACTOR RESPONSIBLE FOR SCHEDULING A PRE-CONSTRUCTION INSPECTION FOR ALL INSTALLATIONS

NOTE: WATERTIGHT SEPTIC TANKS REQUIRED

NOTE: ALL PARTS OF SEPTIC SYSTEM SHALL BE 100 FEET FROM ANY WATER WELL

NOTE: MANHOLE RISERS REQUIRED ON ALL SEPTIC TANKS AND PUMP CHAMBERS UNLESS SPECIFICALLY AUTHORIZED

**NEITHER THE HOWARD COUNTY COUNCIL NOR THE HEALTH DEPARTMENT IS
RESPONSIBLE FOR THE SUCCESSFUL OPERATION OF ANY SYSTEM
PERMITTEE RESPONSIBLE FOR OBTAINING FINAL APPROVAL ON THIS PERMIT
CALL 410-313-1771 FOR INSPECTION OF SEPTIC SYSTEM**

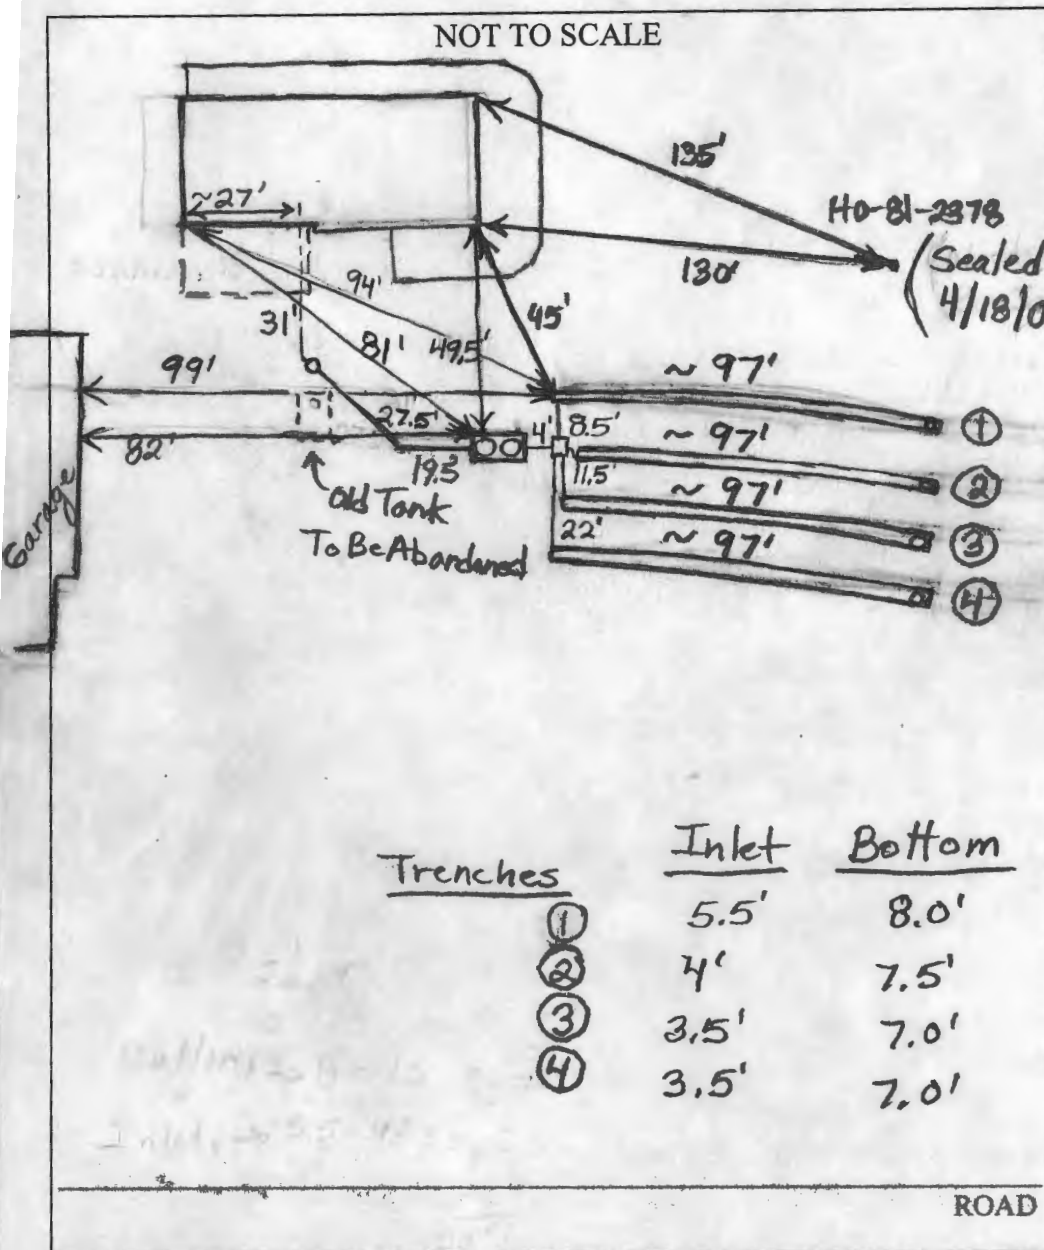

TRENCH/DRAINFIELD DATA		
WIDTH	INLET	BOTTOM
2'	3.5'-5.5'	7'-8'
NUMBER OF TRENCHES	4	
TOTAL LENGTH	388'	
ABSORPTION AREA	776+	
DISTRIBUTION BOX LEVEL	Levelers	
DISTRIBUTION BOX BAFFLE	Yes	
DISTRIBUTION BOX PORT	Yes	

SEPTIC TANK DATA		
SEPTIC TANK 1 LEVEL	Yes	
CAPACITY	2000	GAL
SEAM LOC	Top	
TANK LID DEPTH	2.5'-3.5'	
BAFFLES	Yes	
BAFFLE FILTER	No	
MANHOLE LOC	Front & Rear	
6" PORT LOC	None	
WATERTIGHT TEST	No	
SEPTIC TANK 2 LEVEL	N/A	
CAPACITY		GAL
SEAM LOC		
TANK LID DEPTH		
BAFFLES		
BAFFLE FILTER		
MANHOLE LOC		
6" PORT LOC		
WATERTIGHT TEST		

PRE-CONSTRUCTION 3/20/07 Flogles wants to install completely new system near the top perc. test holes. O.K. to make top

INSTALLATION 1 or 2 trenches as deep as 8' so that a pump isn't needed. Abandon old septic tank. (BB)

3/21/07 System installed. O.K. to backfill. Flogles said that old tank will be pumped out and filled in. (BB)

FINAL INSPECTOR B. Baker DATE OF APPROVAL 3/21/07



HOWARD COUNTY HEALTH DEPARTMENT

P5 26253

DATE

2 / 27 / 07

Received
From

Fogles Septic Clean

PHONE # 410-795-5670

580 Litchfield Rd, Sykesville MD 21784

for Septic Upgrade Permit

☐ CASH

☒ CHECK

2600 Thompson Drive

NO.

48323

Three hundred ninety-six and 00/100

Dollars

\$

396⁰⁰

Received By

Mary L. Bugge