

MARYLAND DEPARTMENT OF THE ENVIRONMENT, WATER MANAGEMENT ADMINISTRATION
1800 Washington Blvd., Baltimore, Maryland 21230 (410) 537-3784

WATER WELL ABANDONMENT-SEALING REPORT FORM

SUBMIT COPIES OF COMPLETED FORM TO:

- * COUNTY ENVIRONMENT AGENCY (contact MDE, WMA if address needed)
- * WELL OWNER
- * MDE, WATER MANAGEMENT ADMINISTRATION, WELL PROGRAM

DATE WELL ABANDONED: 4-18-07 (month/day/year)

5/16/07 O.K.

BB

HO - 81 - 2378

* PERMIT NUMBER OF ABANDONED WELL (if any)

* PERMIT NUMBER OF REPLACEMENT WELL

* PERSON ABANDONING WELL: Allen Compton


WELL DRILLERS LICENSE NUMBER: 009

CIRCLE: MWD MSD MGD

* OWNER'S NAME: Zahcer Chavo

SITE LOCATION MAP

* WELL LOCATION:
COUNTY: Howard
NEAREST TOWN: West Friendship
TAX MAP _____ BLOCK _____ PARCEL _____
SUBDIVISION: _____
SECTION: _____ LOT: _____
NEAREST ROAD: 2600 Thompson Dr.

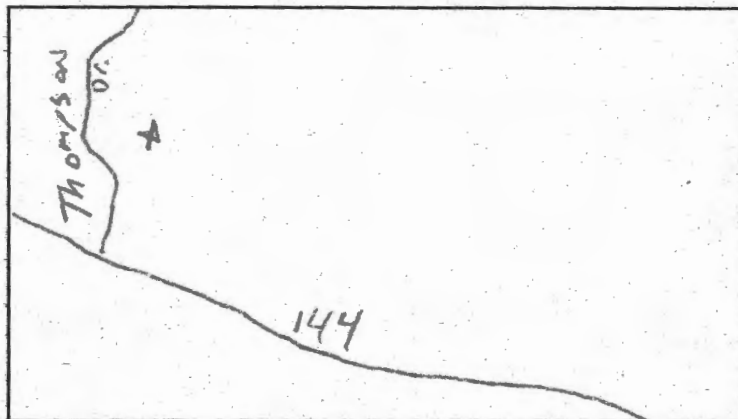

* TYPE OF WELL BEING ABANDONED:

☒ DRILLED ☐ JETTED
☐ BORED/AUGERED ☐ HAND DUG
☐ OTHER (specify) _____

* USE CODE:

☒ DOMESTIC ☐ MUNICIPAL/PUBLIC
☐ IRRIGATION ☐ INDUSTRIAL
☐ TEST/OBSERVATION ☐ GEOTHERMAL

* TYPE OF CASING:

☐ STEEL ☒ PLASTIC
☐ CONCRETE ☐ OTHER (specify) _____

* SIZE-OF CASING: 6" INCHES IN DIAMETER

* DEPTH OF WELL: 225 FEET DEEP

* WAS ANY CASING REMOVED? ☐ YES ☒ NO
if yes, length removed, in feet: _____

* WAS CASING RIPPED OR PERFORATED? ☐ YES ☒ NO

LOG OF SEALING MATERIAL

MATERIAL	FEET	
	FROM	TO
<u>Cement</u>	<u>0</u>	<u>225</u>
VOLUME OF MATERIAL USED		
<u>50 bags</u>		

SIGNATURE-MASTER WELL DRILLER OR SUPERVISING SANITARIAN

LICENSE #

CIRCLE ONE

DATE

HOWARD COUNTY HEALTH DEPARTMENT
Completed Septic System

P 42724 A 19617
DATE 10/9/88 3/4/74

LOCATION	<u>Wooded Acres</u>	APPLICATION	
	<u>2600 Thompson Drive</u>	HOLD	()
		APPROVED	()
		REJECTED	()
LOT	<u>1</u>		
APPLICANT	<u>Donald J. McDonald</u>	INSTALLATION	
OWNER	<u>Marvin Whittaker</u>	HOLD	()
		APPROVED	()
PERMITTEE	<u>Jack Fyock</u>	APPROVED	<u>10/3/88</u>
		DATE	

HD - 11

HOWARD COUNTY HEALTH DEPARTMENT
Completed Septic System

P 50161 A REPAIR
DATE 7/21/94

LOCATION	<u>2600 Thompson Drive</u>	APPLICATION	
		HOLD	()
		APPROVED	()
		REJECTED	()
LOT			
APPLICANT	<u>Mechanical Service P & H</u>	INSTALLATION	
OWNER	<u>MARVIN WHITTAKER</u>	HOLD	()
		APPROVED	()
PERMITTEE	<u>Mechanical Service P & H</u>	APPROVED	<u>7/25/94</u>
		DATE	

HD-11

+