



Howard County
Health Department

7178 Columbia Gateway Drive, Columbia, MD 21046

(410) 313-2640 Fax (410) 313-2648

TDD (410) 313-2323 Toll Free 1-866-313-6300

website: www.hchealth.org

Penny E. Borenstein, M.D., M.P.H., Health Officer

May 31, 2005

Mr. Timothy C. Eakle Sr.
2582 Thompson Dr.
Marriottsville Md 21104

RE: PERCOLATION TEST RESULTS-522430
Tax Map 16, Parcel 306
Lots 4 Eakle Property

Dear Mr. Eakle.

Percolation testing conducted May 26, 2005 on the referenced property satisfactory soil conditions. Copies of the test results are enclosed.

Further review is contingent upon submission by a registered engineer/surveyor of a percolation certification plan showing the following:


- 1) Actual locations and elevations of all excavated test holes
- 2) A suitable house and well site for each lot
- 3) Two replacement well sites or approximately 1500 square feet of approvable well area for each lot
- 4) All existing wells and septic reserve areas on the property
- 5) Locations of any other relevant features such as streams, swales, or existing structures
- 6) A note must be included certifying that all existing wells and septic systems within 100 feet of property boundaries have been shown
- 7) A note indicating that depicted topography reflects field-matched information
- 8) A health officer signature block stating "approved for private water and private sewerage systems"
- 9) A MDE sewage disposal area statement is required

The percolation certification plat should be submitted within 60 days to allow field verification if necessary. If you have any questions regarding this matter, please contact me at the above address or by calling (410) 313-1771.

Respectfully,

Peter A. Yencsik
Development Coordination Section
Well and Septic Program

PY
Enclosures
cc: BenchMark

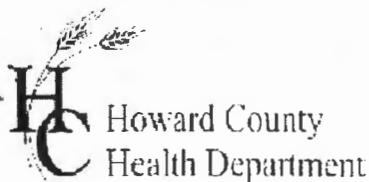

APPLICATION

FOR PERCOLATION TESTING AND SITE EVALUATION

TEST DATE(S) _____ TEST TIME _____

AP 522430

AGENCY REVIEW: _____

DATE 4/28/2005

DO NOT WRITE ABOVE THIS LINE

I HEREBY APPLY FOR THE NECESSARY TESTING/EVALUATION PRIOR TO ISSUANCE OF SEWAGE DISPOSAL SYSTEM PERMIT(S) TO:

CHECK AS NEEDED:

- ☒ CONSTRUCT NEW SEPTIC SYSTEM(S)
☐ REPAIR/ADD TO AN EXISTING SEPTIC SYSTEM
☐ REPLACE AN EXISTING SEPTIC SYSTEM

CHECK AS NEEDED:

- ☒ NEW STRUCTURE(S)
☐ ADDITION TO AN EXISTING STRUCTURE
☐ REPLACE AN EXISTING STRUCTURE

CHECK ONE:

- ☒ CREATE NEW LOT(S)
☐ BUILD ON AN EXISTING LOT IN A SUBDIVISION
☐ BUILD ON AN EXISTING PARCEL OF RECORD

IS THE PROPERTY WITHIN 2500' OF ANY RESERVOIR?

- ☐ YES
☒ NO

THE TYPE OF STRUCTURE IS:

- ☒ RESIDENTIAL WITH UNKNOWN PROPOSED BEDROOMS IN THE COMPLETED STRUCTURE (NOTE UNKNOWN IF APPROPRIATE)
☐ COMMERCIAL (PROVIDE DETAIL OF NUMBERS AND TYPES OF EMPLOYEES/CUSTOMERS ON ACCOMPANYING PLAN)
☐ INSTITUTIONAL/GOVERNMENT (PROVIDE DETAIL OF NUMBERS AND TYPES OF EMPLOYEES/USERS ON ACCOMPANYING PLAN)

PROPERTY OWNER(S) TIMOTHY C. EAKLE, SR.

DAYTIME PHONE 410-465-2044 CELL 443-864-6393 FAX _____

MAILING ADDRESS 2582 THOMPSON DR. MARRIOTTSVILLE MARYLAND 21104
STREET CITY/TOWN STATE ZIP

APPLICANT TIMOTHY C. EAKLE, SR.

DAYTIME PHONE 410-465-2044 CELL 443-864-6393 FAX _____

MAILING ADDRESS 2582 THOMPSON DR. MARRIOTTSVILLE MARYLAND 21104
STREET CITY/TOWN STATE ZIP

APPLICANT'S ROLE: DEVELOPER BUILDER BUYER RELATIVE/FRIEND REALTOR CONSULTANT

PROPERTY LOCATION
SUBDIVISION/PROPERTY NAME EAKLE PROPERTY LOT NO. 4

PROPERTY ADDRESS 2582 THOMPSON DR. MARRIOTTSVILLE MD 21104
STREET TOWN/POST OFFICE

TAX MAP PAGE(S) 16 GRID 8 PARCEL(S) 306 PROPOSED LOT SIZE _____

AS APPLICANT, I UNDERSTAND THE FOLLOWING: THE SYSTEM INSTALLED SUBSEQUENT TO THIS APPLICATION IS ACCEPTABLE ONLY UNTIL PUBLIC SEWERAGE IS AVAILABLE. THIS APPLICATION IS COMPLETE WHEN ALL APPLICABLE FEES AND A SUITABLE SITE PLAN HAVE BEEN RECEIVED. I ACCEPT THE RESPONSIBILITY FOR COMPLIANCE WITH ALL M.O.S.H.A. AND "MISS UTILITY" REQUIREMENTS. APPROVAL IS BASED UPON SATISFACTORY REVIEW OF A PERC CERTIFICATION PLAN. TEST RESULTS WILL BE MAILED TO APPLICANT.


SIGNATURE OF APPLICANT

HOWARD COUNTY HEALTH DEPARTMENT, BUREAU OF ENVIRONMENTAL HEALTH, WELL AND SEPTIC PROGRAM
3525 H'ELICOTT MILLS DRIVE, ELLICOTT CITY, MARYLAND 21043-4544 (410) 313-1771 FAX (410) 313-2648
TDD (410) 313-2323 TOLL FREE 1-877-4MD-DHMH

P7
Brown L ^{rooty}
orange brown
h sl
sbk
trau rock
4' yellow brown
f ls
trau rock
10' seepage
12'5" water

P6
Brown L
yellow brown
sl sbk
2'5" orange brown
sl sbk
4' orange brown
SL gr
micaceous
8'4" water seepage
9'5" water
10'

P5
Brown L
yellow brown
SL sbk
2'10" <5% quartz
orange brown
LS sbk
7'8" H₂O seepage
9'8" water
10'10"

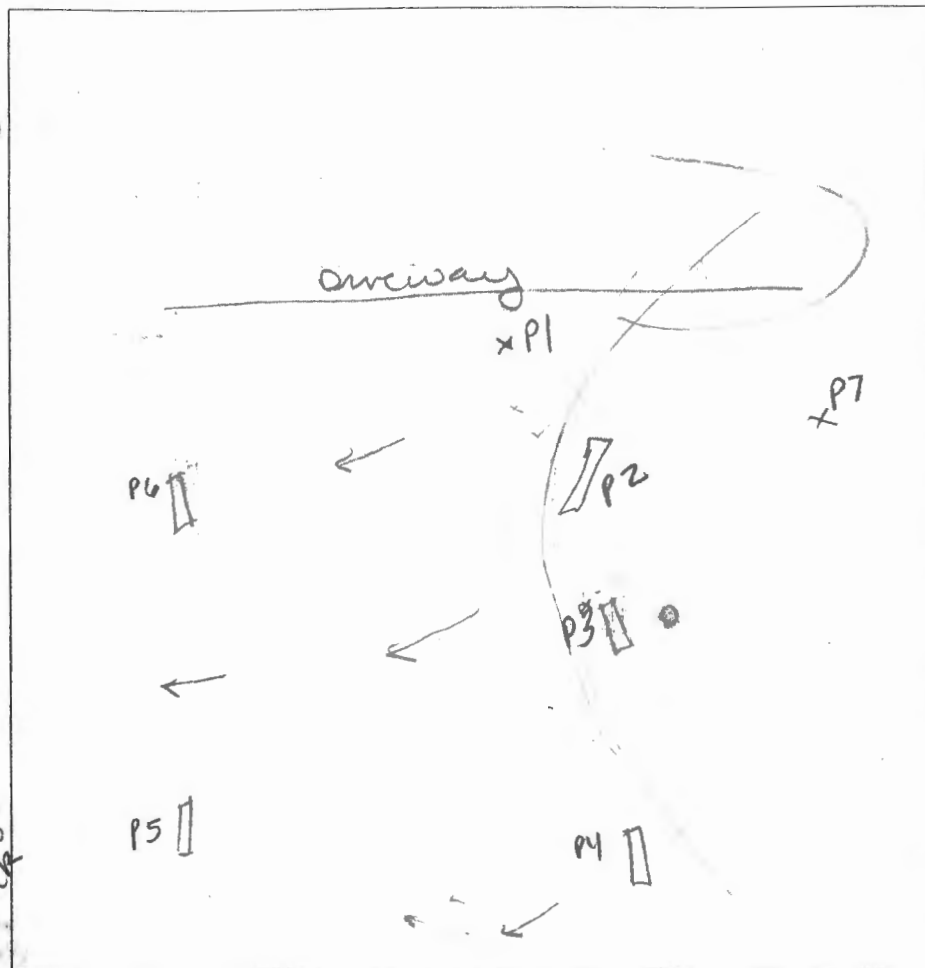

P3
Brown L
1 yellow brown
sl sbk
micaceous
3' yellow brown
f SL
12' seepage
13' water
14'

P4
Brown L
6' orange/red brown
h sl sbk
2'6" yellow brown
f SL
10' yellow brown
f LS
11' seepage
12' water

P2
Brown L
1' orange brown
w sl sbk
2'4' orange brown
h sl micaceous
moist tra rock
3'9" yellow gray
LS gr
micaceous (d) mottling
10'5" water
12' tra rock

DATE	TEST #	DEPTH	START	BREAK 1" DROP	STOP 2" DROP	TIME OF 2ND INCH	P/F/H
5/26/05	P6	10'		high H ₂ O			VF
	P5	10'10"		high H ₂ O			VF
	P3	5' / 14'	9:39	9:41	9:44	3	P
	P4	3' / 12'	9:41	9:42	9:43	1	F
	P4	repair	9:48	9:50	9:52 ¹⁰	2'5"	P
	P2	3' / 11'	11:10	11:37			
	2nd hole P2	4'3"	11:39	11:42	11:45	3	P
	P7	5' / 12'5"	11:50	11:51	too fast		
	repair P7	repair	11:52 ⁴⁰	11:54 ⁴⁰	11:57 ⁰⁰	2:20	P

REMARKS

No deeper than 4'

SANITARIAN

PAV/S/KN

BACKHOE

Harteds

OTHERS

TEST HOLES USED IN SDA

AVG. PERC TIME

SQ. FT/BR

TRENCH WIDTH

3

INLET DEPTH


1 1/2

MAX. BOT DEPTH

4

EFFECTIVE S/W

none

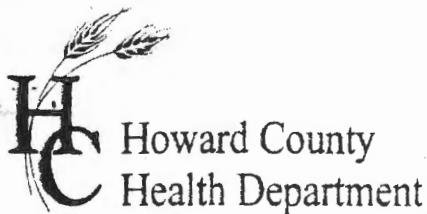

APPLICATION

FOR PERCOLATION TESTING AND SITE EVALUATION

TEST DATE(S) _____ TEST TIME _____ A/P _____

AGENCY REVIEW: _____ DATE _____

DO NOT WRITE ABOVE THIS LINE

I HEREBY APPLY FOR THE NECESSARY TESTING/EVALUATION PRIOR TO ISSUANCE OF SEWAGE DISPOSAL SYSTEM PERMIT(S) TO:

CHECK AS NEEDED:

- ☐ CONSTRUCT NEW SEPTIC SYSTEM(S)
- ☐ REPAIR/ADD TO AN EXISTING SEPTIC SYSTEM
- ☐ REPLACE AN EXISTING SEPTIC SYSTEM

CHECK AS NEEDED:

- ☐ NEW STRUCTURE(S)
- ☐ ADDITION TO AN EXISTING STRUCTURE
- ☐ REPLACE AN EXISTING STRUCTURE

CHECK ONE:

- ☐ CREATE NEW LOT(S)
- ☐ BUILD ON AN EXISTING LOT IN A SUBDIVISION
- ☐ BUILD ON AN EXISTING PARCEL OF RECORD

IS THE PROPERTY WITHIN 2500' OF ANY RESERVOIR?

- ☐ YES
- ☐ NO

THE TYPE OF STRUCTURE IS:

- ☐ RESIDENTIAL WITH _____ PROPOSED BEDROOMS IN THE COMPLETED STRUCTURE (NOTE *UNKNOWN* IF APPROPRIATE)
- ☐ COMMERCIAL (PROVIDE DETAIL OF NUMBERS AND TYPES OF EMPLOYEES/ CUSTOMERS ON ACCOMPANYING PLAN)
- ☐ INSTITUTIONAL/GOVERNMENT (PROVIDE DETAIL OF NUMBERS AND TYPES OF EMPLOYEES/USERS ON ACCOMPANYING PLAN)

PROPERTY OWNER(S) _____

DAYTIME PHONE _____ CELL _____ FAX _____

MAILING ADDRESS _____
STREET CITY/TOWN STATE ZIP

APPLICANT _____

DAYTIME PHONE _____ CELL _____ FAX _____

MAILING ADDRESS _____
STREET CITY/TOWN STATE ZIP

APPLICANT'S ROLE: DEVELOPER BUILDER BUYER RELATIVE/FRIEND REALTOR CONSULTANT

PROPERTY LOCATION
SUBDIVISION/PROPERTY NAME _____ LOT NO. _____

PROPERTY ADDRESS _____
STREET TOWN/POST OFFICE

TAX MAP PAGE(S) _____ GRID _____ PARCEL(S) _____ PROPOSED LOT SIZE _____

AS APPLICANT, I UNDERSTAND THE FOLLOWING: THE SYSTEM INSTALLED SUBSEQUENT TO THIS APPLICATION IS ACCEPTABLE ONLY UNTIL PUBLIC SEWERAGE IS AVAILABLE. THIS APPLICATION IS COMPLETE WHEN ALL APPLICABLE FEES AND A SUITABLE SITE PLAN HAVE BEEN RECEIVED. I ACCEPT THE RESPONSIBILITY FOR COMPLIANCE WITH ALL M.O.S.H.A. AND "MISS UTILITY" REQUIREMENTS. APPROVAL IS BASED UPON SATISFACTORY REVIEW OF A PERC CERTIFICATION PLAN.

TEST RESULTS WILL BE MAILED TO APPLICANT.

SIGNATURE OF APPLICANT _____

HOWARD COUNTY HEALTH DEPARTMENT, BUREAU OF ENVIRONMENTAL HEALTH, WELL AND SEPTIC PROGRAM
3525-H ELLICOTT MILLS DRIVE, ELLICOTT CITY, MARYLAND 21043-4544 (410) 313-1771 FAX (410) 313-2648
TDD (410) 313-2323 TOLL FREE 1-877-4MD-DHMH

Dark
brown
yellow
rocky
loam

Yellow
brown
black

med
scl -
ribbons &
leaves

P9

Brown
L

yellow brown
w scl
sbk

yellow orange
brown
gr sl

yellow brown
f is
(all mottles)

seepage
water

P10

Brown
L

yellow brown
cl sbk
very micaceous

yellow brown
sl

seepage
brown is
micaceous
± 15% seepage

water

Driveway

P11

Brown
L

yellow brown
scl

all mottles

seepage
yellow brown
sl

yellow brown
s
water

DATE	TEST #	DEPTH	START	BREAK 1" DROP	STOP 2" DROP	TIME OF 2nd INCH	P/F/H
5-26-05	9	5' / 13'	10:05	10:13	10:24	11	P
	10	3' 10' / 12'	10:27	10:51	pulled		F
	11	- / 10'		high H ₂ O @ 3'			V F
	SI		12:17	1:17 - 100' second log			F
		No	1"				

REMARKS

SANITARIAN

BACKHOE

OTHERS

TEST HOLES USED IN SDA

AVG. PERC TIME

SQ. FT/BR

TRENCH WIDTH

INLET DEPTH

MAX. BOT DEPTH

EFFECTIVE SW