



HOWARD COUNTY HEALTH DEPARTMENT

A+P5 26250

DATE
2 / 23 / 07

Received
From

Anthony R Peaks

PHONE # 410-531-8549

5484 Ten Oaks Rd, Clarksville MD 21029

For Repair Pile + Repair Permit

☐ CASH

☒ CHECK

same as above

NO.

801

Three hundred thirty and 00/100

Dollars

\$

330

00

Received By

Mary L Biggs

330.00 TOTAL

Fee Paid \$
Receipt #P 52 6250**SEPTIC SYSTEM REPAIR / UPGRADE / EVALUATION REQUEST****Please fill out this form completely and check off the reason for the request:**Date requested: 2/23/07**Reason for Request**

Failing System (includes surface discharge or inadequate treatment zone)

Yes DRYWELL SATURATEDHas the contractor verified through excavation/pumping evaluation, that there are no pipe blockages? YesIn support of a building permit. Type of building addition: N/A

*System relocation for proposed addition for setback compliance

*Verification of adequate system capacity per COMAR 26.04.02.02D (4)

To replace collapsed septic tank or upgrade tank capacity

To replace collapsed drywell

Septic Contractor:

Contractor's Address:

Contractor's Phone #:

Property Address:

Property (Subdivision) & Lot #

Owner's Name:

Is public sewer available/nearby:

Names of Any Previous Owners:

Year House Built:

of Existing Bedrooms:

of Bedrooms after completion of addition:

Has this request been discussed previously with a Sanitarian, who? No*If public sewer is close, further research will be performed to verify availability and possible hook up to public sewer.*

A Sanitarian will be in contact within three business days depending upon the urgency of the situation to coordinate the scheduling of the repair /upgrade/evaluation. No inspection will be performed without fee collection at the office.

Environmental Sanitarian tentatively assigned _____

FAX TO 410-313-2648

PUB. SEWER STATUS VERIFIED BY _____

ISSUE DATE: 02/23/07

PERMIT

P 526250

APPROVAL DATE: 3/15/07

A REPAIR

Tax ID # 05-392446

ON-SITE SEWAGE DISPOSAL SYSTEM HOWARD COUNTY HEALTH DEPARTMENT BUREAU OF ENVIRONMENTAL HEALTH

Anthony R Peake IS PERMITTED TO INSTALL ☐ ALTER ☒

ADDRESS: 5484 Ten Oaks Road PHONE NUMBER: 410-531-8549

SUBDIVISION: _____ LOT NUMBER: _____

ADDRESS: 5484 Ten Oaks Road PROPERTY OWNER: Anthony R Peake

SEPTIC TANK CAPACITY (GALLONS): _____ - Trenches 2' Wide
PUMP CHAMBER CAPACITY (GALLONS): _____ - Inlet $\leq 6'$
NUMBER OF BEDROOMS: 5 - Bottom 11'
SQUARE FEET PER BEDROOM: _____ - 5' of Stone Below Pipe
LINEAR FEET OF TRENCH REQUIRED: 225' - 3 Trenches of Close to
Same Length - (~75')


TRENCHES:	Trench to be _____ feet wide. Inlet _____ feet below original grade. Bottom _____ maximum depth _____ feet below original grade. Effective area begins at _____ feet below original grade. _____ feet of stone below distribution pipe.
LOCATION:	<u>Pump Out and Fill in Dry well</u>
PURPOSE:	Existing septic system has failed. Call for inspection when ground is opened so sanitarian can recommend repair.

PLANS APPROVED: B. Baker DATE: 3/13/07

- NOTE: PERMIT VOID AFTER 2 YEARS
NOTE: CONTRACTOR RESPONSIBLE FOR SCHEDULING A PRE-CONSTRUCTION INSPECTION FOR ALL INSTALLATIONS
NOTE: WATERTIGHT SEPTIC TANKS REQUIRED
NOTE: ALL PARTS OF SEPTIC SYSTEM SHALL BE 100 FEET FROM ANY WATER WELL
NOTE: MANHOLE RISERS REQUIRED ON ALL SEPTIC TANKS AND PUMP CHAMBERS

**NEITHER THE HOWARD COUNTY COUNCIL OR THE HEALTH DEPARTMENT IS
RESPONSIBLE FOR THE SUCCESSFUL OPERATION OF ANY SYSTEM
PERMITTEE RESPONSIBLE FOR OBTAINING FINAL APPROVAL ON THIS PERMIT
CALL 410-313-2640 FOR INSPECTION OF SEPTIC SYSTEM**

NOT TO SCALE

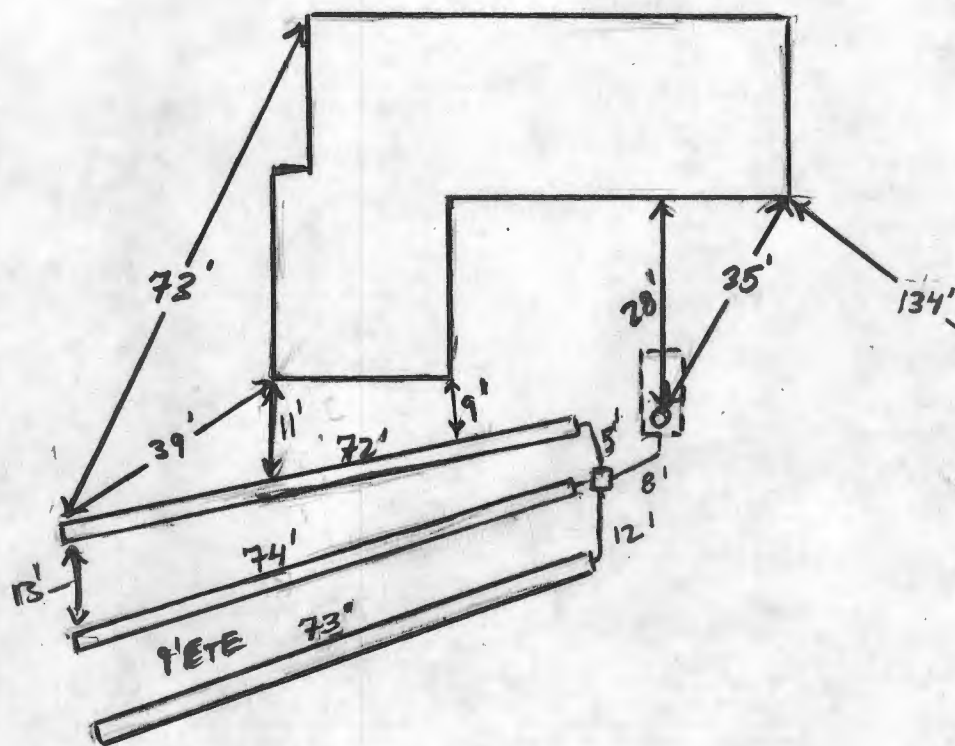

TRENCH/DRAINFIELD DATA

WIDTH 2 INLET 6' BOTTOM 11'
 NUMBER OF TRENCHES 3
 TOTAL LENGTH _____
 ABSORPTION AREA _____
 DISTRIBUTION BOX LEVEL Yes/level
 DISTRIBUTION BOX BAFFLE Yes
 DISTRIBUTION BOX PORT NO

SEPTIC TANK DATA

SEPTIC TANK 1 LEVEL Same what

Ex Tank CAPACITY _____ GAL
 SEAM LOC mid
 TANK LID DEPTH 4'
 BAFFLES yes, rear, rear

Ex Well BAFFLE FILTER _____

MANHOLE LOC Rear
 6" PORT LOC Front

WATERTIGHT TEST _____

SEPTIC TANK 2 LEVEL _____

CAPACITY _____ GAL

SEAM LOC _____

TANK LID DEPTH _____

BAFFLES _____

BAFFLE FILTER _____

MANHOLE LOC _____

6" PORT LOC _____

WATERTIGHT TEST _____

PRE-CONSTRUCTION _____

INSTALLATION 3/15/07 system complete. 3 Trenches
w/ 6' inlet. Rear baffle added on to Ex Tank.
Top trench slightly off center - not to fit above
huge oak tree @ end of trench. OK to
Backfill (K)

FINAL INSPECTOR _____

Karin Walf

DATE OF APPROVAL _____

3/15/07