

LAYOUT 9/14/07 (RW) INSP 4 _____
INSP 2 10/1/07 (RW) INSP 5 _____
INSP 3 10/4/07 (RW) INSP 6 _____

ISSUE DATE: 9/15/07

APPROVAL DATE: 10/4/07

PERMIT

P 527340

A 540507

TAX ID # 05-411661

**ON-SITE SEWAGE DISPOSAL SYSTEM
HOWARD COUNTY HEALTH DEPARTMENT
BUREAU OF ENVIRONMENTAL HEALTH**

Fogle's Septic Clean, Inc. IS PERMITTED TO INSTALL ☒ ALTER ☐
ADDRESS: 580 Obrecht Rd. PHONE NUMBER: 410-795-5670
SUBDIVISION: Hedgerow LOT NUMBER: 7
ADDRESS: 13606 Sheephead Court PROPERTY OWNER: Shahin John Korangy
SEPTIC TANK CAPACITY (GALLONS): 2000 OUTLET BAFFLE FILTER REQUIRED ☐
PUMP CHAMBER CAPACITY (GALLONS): _____ COMPARTMENTED TANK REQUIRED ☒
NUMBER OF BEDROOMS: 6
SQUARE FEET PER BEDROOM: 187.5
LINEAR FEET OF TRENCH REQUIRED: 230

TRENCHES:	Trench to be 3.0 feet wide. Inlet 5.0 feet below original grade. Bottom maximum depth 8.0 feet below original grade. Effective area begins at 6.0 feet below original grade. 3.0 feet of stone below distribution pipe.
LOCATION:	
NOTES:	2 nd & 3 rd systems only have 1.5' sidewall making total linear feet 230. Basement service by gravity

PLANS APPROVED: Robert Bricker DATE: 9/10/07

NOTE: PERMIT VOID AFTER 2 YEARS

NOTE: CONTRACTOR RESPONSIBLE FOR SCHEDULING A PRE-CONSTRUCTION INSPECTION FOR ALL INSTALLATIONS

NOTE: WATERTIGHT SEPTIC TANKS REQUIRED

NOTE: ALL PARTS OF SEPTIC SYSTEM SHALL BE 100 FEET FROM ANY WATER WELL

NOTE: MANHOLE RISERS REQUIRED ON ALL SEPTIC TANKS AND PUMP CHAMBERS UNLESS SPECIFICALLY AUTHORIZED

**NEITHER THE HOWARD COUNTY COUNCIL NOR THE HEALTH DEPARTMENT IS
RESPONSIBLE FOR THE SUCCESSFUL OPERATION OF ANY SYSTEM
PERMITTEE RESPONSIBLE FOR OBTAINING FINAL APPROVAL ON THIS PERMIT
CALL 410-313-1771 FOR INSPECTION OF SEPTIC SYSTEM**

HO-94-0324

NOT TO SCALE

TRENCH/DRAINFIELD DATA		
WIDTH	INLET	BOTTOM
8'	5'	8'
NUMBER OF TRENCHES		4
TOTAL LENGTH		256'
ABSORPTION AREA		768' + SW
DISTRIBUTION BOX LEVEL		Below
DISTRIBUTION BOX BAFFLE		Yes
DISTRIBUTION BOX PORT		Yes

SEPTIC TANK DATA

SEPTIC TANK 1 LEVEL		Yes
CAPACITY	2000	GAL
SEAM LOC	Top	
TANK LID DEPTH	1'-2.5'	
BAFFLES	Yes	
BAFFLE FILTER	—	
MANHOLE LOC	Front	
6" PORT LOC	Rear	
WATERTIGHT TEST	—	
Babylon 2-comp. slotted		
SEPTIC TANK 2 LEVEL		
CAPACITY		GAL
SEAM LOC		
TANK LID DEPTH		
BAFFLES		
BAFFLE FILTER		
MANHOLE LOC		
6" PORT LOC		
WATERTIGHT TEST		

PRE-CONSTRUCTION

9/17/07 Set tank
20' from house. Keep
D box Top center 504
run 4 x 60' trench
on contact. Running

opposite side of D box. OK to keep inlet @ 5' 9" edge to
edge separation on trenches. (KW)

INSTALLATION:

10/1/07 Tank set per installader. Plumbing installed
from house to tank, up to D box position. No one working (KW)
10/4/07 D box set. Right two trenches complete. Top left complete
digging bottom left trench now half-way stoned. Trenches cored
in @ Bot of bottom 2 trenches. Contractor just made one
continuous trench. OK to backfill when finished piping last trench

FINAL INSPECTOR

K. Whaley

DATE OF APPROVAL

10/4/07

BY THE ENGINEER: [Signature] DATE: 4/16/06

DEVELOPERS CERTIFICATE: I CERTIFY THAT ALL DEVELOPMENT AND CONSTRUCTION WILL BE DONE ACCORDING TO THIS PLAN AND THAT ANY RESPONSIBLE PERSONNEL EMPLOYED IN THE DESIGN AND CONSTRUCTION OF THIS PROJECT WILL BE AVAILABLE AT A DEPARTMENT OF THE ENVIRONMENT APPROVED TRAINING PROGRAM... [Signature] DATE: 4/16/06

THESE PLANS HAVE BEEN REVIEWED FOR THE HOWARD SOIL CONSERVATION DISTRICT AND MEETS TECHNICAL REQUIREMENTS. [Signature] DATE: 4/16/06

USDA - NATURAL RESOURCE CONSERVATION SERVICE DATE: 4/16/06


THIS DEVELOPMENT PLAN IS APPROVED FOR SOIL EROSION AND SEDIMENT CONTROL BY THE HOWARD SOIL CONSERVATION DISTRICT. [Signature] DATE: 4/16/06

HOWARD SOIL CONSERVATION DISTRICT DATE: 4/16/06

Standard Sediment Control Notes

1. A minimum of 48 hours notice must be given to the Howard County Department of Inspections, Licenses and Permits, Sediment Control Division prior to the start of any construction (9:15-10:55).
2. All vegetative and structural practices are to be installed according to the provisions of this plan and are to be in conformance with the most current MARYLAND STANDARDS AND SPECIFICATIONS FOR SOIL EROSION AND SEDIMENT CONTROL and revisions thereto.
3. Following initial soil disturbance or re-disturbance, permanent or temporary stabilization shall be completed within 30 calendar days for all permanent sediment control structures, dikes, perimeter slopes and all slopes greater than 3:1, 1:1 or 14 days as to all other disturbed or graded areas on the project site.
4. All sediment traps/basins shown must be fenced and warning signs posted around their perimeter in accordance with Vol. 1, Chapter 12 of the HOWARD COUNTY DESIGN MANUAL, Storm Drainage.
5. All disturbed areas must be stabilized within the time period specified above in accordance with the 1984 MARYLAND STANDARDS AND SPECIFICATIONS FOR SOIL EROSION AND SEDIMENT CONTROL, for permanent seeding (Sec. 5.1), sod (Sec. 5.4), temporary seeding (Sec. 5.0) and mulching (Sec. 5.2). Temporary stabilization with mulch alone can only be done when recommended seeding dates do not allow for proper germination and establishment of grasses.
6. All sediment control structures are to remain in place and are to be maintained in operative condition until permission for their removal has been obtained from the Howard County Sediment Control Inspector.
7. Site Analysis:
Total Area of Site: 3.075 Acres
Area Disturbed: 1.00 Acres
Area to be seeded or paved: 0.24 Acres
Area to be vegetatively stabilized: 0.16 Acres
Total Cul: 550 Cu Yds.
Total Fill: 850 Cu Yds.
Offsite waste/borrow area location: [Blank]
8. Any sediment control practice, which is disturbed by grading activity for placement of utilities, must be repaired on the same day of disturbance.
9. Additional sediment control must be provided, if deemed necessary by the Howard County Sediment Control Inspector.
10. On all sites with disturbed areas in excess of 2 acres, approval of the inspection agency shall be requested upon completion of installation of perimeter erosion and sediment controls, but before proceeding with any other earth disturbance or grading. Other building or grading inspection approvals may not be authorized until the initial approval by the inspection agency is made.
11. Trenches for the construction of utilities is limited to three pipe lengths or that which shall be back-filled and stabilized by the end of each workday, whichever is shorter.

DETAIL 22 - SILT FENCE

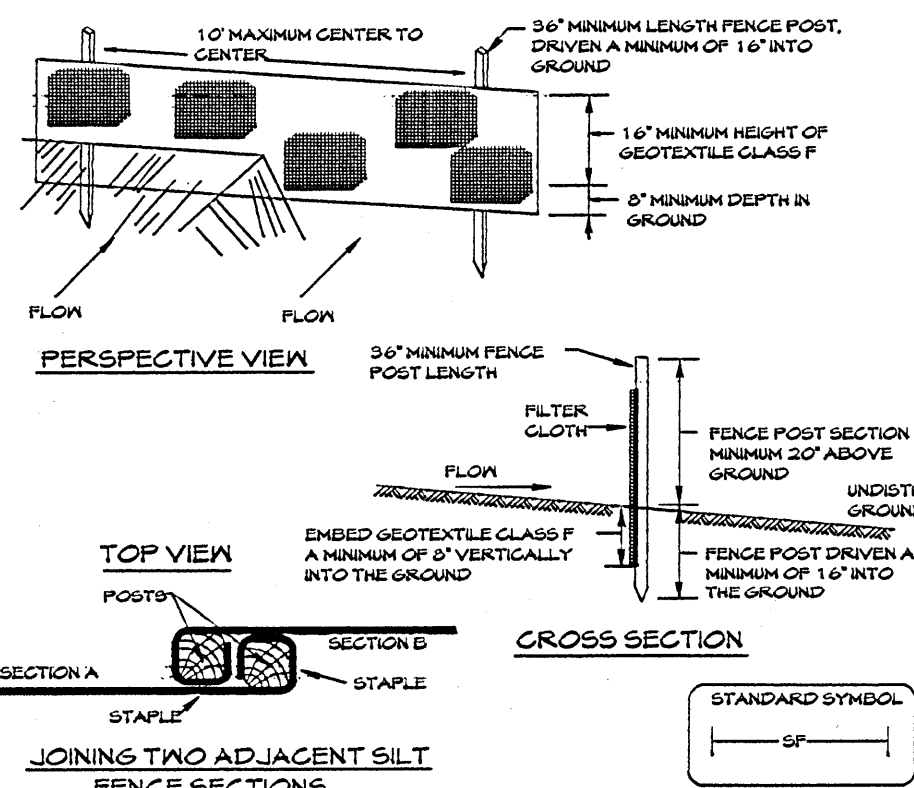

JOINING TWO ADJACENT SILT FENCE SECTIONS

Construction Specifications

1. FENCE POSTS SHALL BE A MINIMUM OF 36" LONG DRIVEN 16" MINIMUM INTO THE GROUND. WOOD POSTS SHALL BE 1 1/2" DIA. (MINIMUM) OR 1 1/2" DIA. (MINIMUM) ROUND AND SHALL BE OF SOUND QUALITY HARDWOOD. STEEL POSTS SHALL BE STANDARD TCR SECTION RESULTING NOT LESS THAN 1.20 POUND PER LINEAL FOOT.
2. GEOTEXTILE SHALL BE FASTENED SECURELY TO EACH FENCE POST WITH WIRE TIES OR STAPLES AT TOP AND MID-SECTION AND SHALL MEET THE FOLLOWING REQUIREMENTS FOR GEOTEXTILE CLASS F:
TENSILE STRENGTH: 50 LBS./IN. (MIN.) TEST: MSMT 504
TENSILE MODULUS: 20 LBS./IN. (MIN.) TEST: MSMT 504
FLOCH RATE: 0.3 GAL/FT² PER MINUTE (MAX.) TEST: MSMT 522
FILTERING EFFICIENCY: 75% (MIN.) TEST: MSMT 322
3. JOINTS OF GEOTEXTILE FABRIC COME TOGETHER, THEY SHALL BE OVERLAPPED, FOLDED AND STAPLED TO PREVENT SEDIMENT BYPASS.
4. SALT FENCE SHALL BE INSPECTED AFTER EACH RAINFALL EVENT AND MAINTAINED WHEN BULGES OCCUR OR WHEN SEDIMENT ACCUMULATION REACHED 50% OF THE FABRIC HEIGHT.

Silt Fence Design Criteria

Slope Steepness	(Maximum) Slope Length	(Maximum) Silt Fence Length
Flatter than 50:1	unlimited	unlimited
50:1 to 10:1	125 feet	1,000 feet
10:1 to 5:1	150 feet	750 feet
5:1 to 3:1	60 feet	500 feet
3:1 to 2:1	40 feet	250 feet
2:1 and steeper	20 feet	125 feet

NOTE: IN AREAS OF LESS THAN 2% SLOPE AND SANDY SOILS (USDA GENERAL CLASSIFICATION SYSTEM SOIL CLASS A) A MINIMUM SLOPE LENGTH AND SILT FENCE LENGTH SHALL BE UNLIMITED. IN THESE AREAS A SILT FENCE MAY BE THE ONLY PERIMETER CONTROL REQUIRED.

STANDARDS AND SPECIFICATIONS FOR TOPSOIL CONSTRUCTION AND MATERIAL SPECIFICATIONS

- I. Topsoil salvaged from the existing site may be used provided that it meets the standards as set forth in these specifications. Typically, the depth of topsoil to be salvaged for a given soil type can be found in the following table. Representative soil type section in the Soil Survey published by USDA-SCS in cooperation with Maryland Agricultural Experiment Station.
- II. Topsoil specifications - Soil to be used as topsoil must meet the following:
1. Topsoil shall be a loam, sandy loam, clay loam, silt loam, sandy clay loam, loamy sand. Other soils may be used if recommended by an agronomist or soil scientist and approved by the appropriate approval authority. Regardless, topsoil shall not be a mixture of contrasting textures and soils and shall contain less than 5% by volume of cinders, stones, slag, coarse fragments, gravel, sticks, roots, trash, or other materials larger than 1" in diameter.
 2. Topsoil must be free of plants or plant parts such as Bermuda grass, quack grass, Johnson grass, nutgrass, poison ivy, thistle, or others as specified.
 3. Where the subsoil is either highly acidic or composed of heavy clay, ground limestone shall be spread at the rate of 4-8 tons/acre (200-400 pounds per 1,000 square feet) prior to the placement of topsoil. Lime shall be distributed uniformly over designated areas and worked into the soil in conjunction with tillage operations as described in the following procedures.
 4. For sites having disturbed areas under 5 acres:
a) Place topsoil (if required) and apply soil amendments as specified in 2.0.0 Vegetative Stabilization - Section 1 - Vegetative Stabilization Methods and Materials.
b) For sites having disturbed areas over 5 acres:
i. On soil meeting Topsoil specifications, obtain test results dictating fertilizer and lime amendments required to bring the soil into compliance with the following:
a) pH for topsoil shall be between 6.0 and 7.5. If the tested soil demonstrates a pH of less than 6.0, sufficient lime shall be prescribed to raise the pH to 6.5 or higher.
b) Organic content of topsoil shall be not less than 1.5 percent by weight.
c) Topsoil having soluble salt content greater than 500 parts per million shall not be used.
d) No sod or seed shall be placed on soil which has been treated with soil sterilants or chemicals used for weed control until sufficient time has elapsed (14 days min.) to permit dissipation of phytotoxic materials.
e) Topsoil substitutes or amendments, as recommended by a qualified agronomist or soil scientist and approved by the appropriate approval authority, may be used in lieu of natural topsoil.
 5. Place topsoil (if required) and apply soil amendments as specified in 2.0.0 Vegetative Stabilization - Section 1 - Vegetative Stabilization Methods and Materials.

- IV. For sites having disturbed areas over 5 acres:
1. On soil meeting Topsoil specifications, obtain test results dictating fertilizer and lime amendments required to bring the soil into compliance with the following:
a) pH for topsoil shall be between 6.0 and 7.5. If the tested soil demonstrates a pH of less than 6.0, sufficient lime shall be prescribed to raise the pH to 6.5 or higher.
b) Organic content of topsoil shall be not less than 1.5 percent by weight.
c) Topsoil having soluble salt content greater than 500 parts per million shall not be used.
d) No sod or seed shall be placed on soil which has been treated with soil sterilants or chemicals used for weed control until sufficient time has elapsed (14 days min.) to permit dissipation of phytotoxic materials.
e) Topsoil substitutes or amendments, as recommended by a qualified agronomist or soil scientist and approved by the appropriate approval authority, may be used in lieu of natural topsoil.
 2. Place topsoil (if required) and apply soil amendments as specified in 2.0.0 Vegetative Stabilization - Section 1 - Vegetative Stabilization Methods and Materials.

- V. Topsoil Application
1. When topsoiling, maintain needed erosion and sediment control practices such as divisions, grade stabilization structures, earth dikes, slope silt fence and sediment traps and basins.
 2. Grades on the areas to be topsoiled, which have been previously established, shall be maintained, albeit 4"-6" higher in elevation.
 3. Topsoil shall be uniformly distributed in a 4"-6" layer and lightly compacted to a minimum thickness of 1" before seeding shall be performed in such a manner that sodding or seeding can proceed with a minimum of additional soil.
 4. Preparation and tillage. Any irregularities in the surface resulting from topsoiling or other operations shall be corrected in order to prevent the formation of depressions or water pockets.

- VI. Alternative for Permanent Seeding - Instead of applying the full amounts of lime and commercial fertilizer, composted sludge and amendments may be applied as specified below:
1. Composted Sludge Material for use as a soil conditioner for sites having disturbed areas over 5 acres shall be tested to prescribe amendments and for sites having disturbed areas under 5 acres shall conform to the following requirements:
a) Composted sludge shall be supplied by, or originate from, a person or persons that are permitted (at the time of acquisition of the compost) by the Maryland Department of the Environment under COMAR 2.02.04.02a.
b) Composted sludge shall contain at least 1 percent nitrogen, 1.5 percent phosphorus, and 0.5 percent potassium and have a pH of 7.0 to 9.0. If compost does not meet these requirements, the appropriate constituents must be added to meet the requirements prior to use.
c) Composted sludge shall be applied at a rate of 1 ton/1,000 square feet.
 2. Composted sludge shall be amended with a potassium fertilizer applied at the rate of 4 lb/1,000 square feet, and 1/2 the normal lime application rate.

HOWARD SOIL CONSERVATION DISTRICT PERMANENT SEEDING NOTES

- APPLY TO GRADED OR CLEARED AREAS NOT SUBJECT TO IMMEDIATE EROSION DISTURBANCE WHERE A PERMANENT LONG-VEGETATIVE COVER IS NEEDED.
- SEEDBED PREPARATION: LOOSEN UPPER THREE INCHES OF SOIL BY RAKING, DISKING OR OTHER ACCEPTABLE MEANS BEFORE SEEDING. IF NOT PREVIOUSLY LOOSENED.
- SOIL AMENDMENTS IN LIEU OF SOIL TEST RECOMMENDATIONS, USE ONE OF THE FOLLOWING GUIDELINES:
1. PREFERRED - APPLY 2 TONS PER ACRE DOLOMITIC LIMESTONE (12 LBS./1,000 SQ. FT.) AND 1,000 LBS. PER ACRE 10-10-10 FERTILIZER (14 LBS./1,000 SQ. FT.) BEFORE SEEDING. NARROW OR DISK INTO UPPER THREE INCHES OF SOIL AT TIME OF SEEDING. APPLY 400 LBS. PER ACRE 30-0-0 UREA OR FERTILIZER (14 LBS./1,000 SQ. FT.)
 2. ACCEPTABLE - APPLY 2 TONS PER ACRE DOLOMITIC LIMESTONE (12 LBS./1,000 SQ. FT.) AND 1,000 LBS. PER ACRE 10-10-10 FERTILIZER (14 LBS./1,000 SQ. FT.) BEFORE SEEDING. NARROW OR DISK INTO UPPER THREE INCHES OF SOIL.
- SEEDING - FOR PERIODS MARCH 1 THROUGH APRIL 30, AND AUGUST 1 THROUGH OCTOBER 15, SEED WITH 60 LBS. PER ACRE (14 LBS./1,000 SQ. FT.) OF KENTUCKY 311 TALL FESCUE FOR THE PERIOD MAY 1 THROUGH JULY 31. SEED WITH 60 LBS. KENTUCKY 311 TALL FESCUE PER ACRE AND 2 LBS. PER ACRE (0.5 LBS./1,000 SQ. FT.) OF PERENNIAL BUCKWHEAT DURING THE PERIOD OF OCTOBER 16 THROUGH FEBRUARY 28. PROTECT SITE BY OPTION (1) 2 TONS PER ACRE OF WELLS-ANCHORED STRAW MULCH AND SEED AS SOON AS POSSIBLE IN THE SPRING. OPTION (2) - USE SOD MULCH (1) 2 TONS PER ACRE OF KENTUCKY 311 TALL FESCUE AND MULCH WITH 2 TON/ACRE WELLS-ANCHORED STRAW.
- MULCHING - APPLY 1-1/2 TO 2 TONS PER ACRE (70 TO 40 LBS./1,000 SQ. FT.) OF UNROTTED REED FREE SMALL GRASS STRAW IMMEDIATELY AFTER SEEDING. ANCHOR MULCH IMMEDIATELY AFTER APPLICATION USING MULCH ANCHORING TOOL OR 2 1/2 GALLONS PER ACRE (5 GAL/1,000 SQ. FT.) OF EMULSIFIED ASPHALT ON FLAT AREAS OR SLOPES 3 FEET OR HIGHER. USE 3-4 GALLONS PER ACRE (6 GAL/1,000 SQ. FT.) FOR ANCHORING.
- MAINTENANCE - INSPECT ALL SEEDING AREAS AND MAKE NEEDED REPAIRS, REPLACEMENTS AND RESEEDINGS.

TEMPORARY SEEDING NOTES


- APPLY TO GRADED OR CLEARED AREAS LIKELY TO BE REDISTURBED WHERE A SHORT TERM VEGETATIVE COVER IS NEEDED.
- SEEDBED PREPARATION: LOOSEN UPPER THREE INCHES OF SOIL BY RAKING, DISKING OR OTHER ACCEPTABLE MEANS BEFORE SEEDING. IF NOT PREVIOUSLY LOOSENED.
- SOIL AMENDMENTS: APPLY 600 LBS. PER ACRE 10-10-10 FERTILIZER (14 LBS./1,000 SQ. FT.)
- SEEDING - FOR PERIODS APRIL 1 THROUGH APRIL 30 AND AUGUST 1 THROUGH OCTOBER 15, SEED WITH 2-1/2 BUSHEL PER ACRE OF ANNUAL RYE (12 LBS./1,000 SQ. FT.) FOR THE PERIOD OF MAY 1 THROUGH AUGUST 14. SEED WITH 3 LBS. PER ACRE OF PERENNIAL BUCKWHEAT (0.5 LBS./1,000 SQ. FT.) FOR THE PERIOD OF NOVEMBER 16 THROUGH NOVEMBER 28. PROTECT SITE BY OPTION (1) 2 TONS PER ACRE OF WELLS-ANCHORED STRAW MULCH AND SEED AS SOON AS POSSIBLE IN THE SPRING. OR USE SOD.
- MULCHING - APPLY 1-1/2 TO 2 TONS PER ACRE (70 TO 40 LBS./1,000 SQ. FT.) OF UNROTTED REED FREE SMALL GRASS STRAW IMMEDIATELY AFTER SEEDING. ANCHOR MULCH IMMEDIATELY AFTER APPLICATION USING MULCH ANCHORING TOOL OR 2 1/2 GALLONS PER ACRE (5 GAL/1,000 SQ. FT.) OF EMULSIFIED ASPHALT ON FLAT AREAS OR SLOPES 3 FEET OR HIGHER. USE 3-4 GALLONS PER ACRE (6 GAL/1,000 SQ. FT.) FOR ANCHORING.

SEPTIC SYSTEM NOTES

1. SEPTIC EASEMENT SUBJECT TO HOWARD COUNTY HEALTH DEPARTMENT NO. 2.
2. PROPOSED 1750 GALLON SEPTIC TANK.
3. A. FIRST FLOOR ELEVATION: 54.50
B. BASEMENT ELEVATION: 53.00
C. INVERT OF SEPTIC SYSTEM AT HOUSE: 55.15
D. INVERT AT SEPTIC TANK: 54.45
E. INVERT OUT AT SEPTIC TANK: 54.45
F. PROPOSED GRADE OVER SEPTIC TANK: 55.15
G. INVERT AT DISTRIBUTION BOX: 54.25
H. EXISTING GROUND OVER DISTRIBUTION BOX: 55.02
I. LENGTH OF TRENCH TO BE DETERMINED AT THE TIME OF SEPTIC PERMIT ISSUANCE.
J. CONTRACTOR / BUILDER TO VERIFY ELEVATIONS IN FIELD BEFORE BEGINNING ANY CONSTRUCTION.
4. BUILDER TO VERIFY AVAILABILITY OF BASEMENT SEWER SERVICE PRIOR TO DWELLING STANDOUT.


SEQUENCE OF CONSTRUCTION

1. OBTAIN GRADING PERMIT.
2. INSTALL SEDIMENT CONTROLS AS SHOWN ON PLAN. (1 DAY)
3. PERFORM NECESSARY GRADING AND STABILIZE THE SITE. BUILD HOUSE (6 MOS.)
4. AFTER THE SITE IS STABILIZED AND PERMISSION IS GRANTED FROM THE SEDIMENT CONTROL INSPECTOR, REMOVE SEDIMENT CONTROLS AND STABILIZE ANY REMAINING DISTURBED AREAS. (2 DAYS)

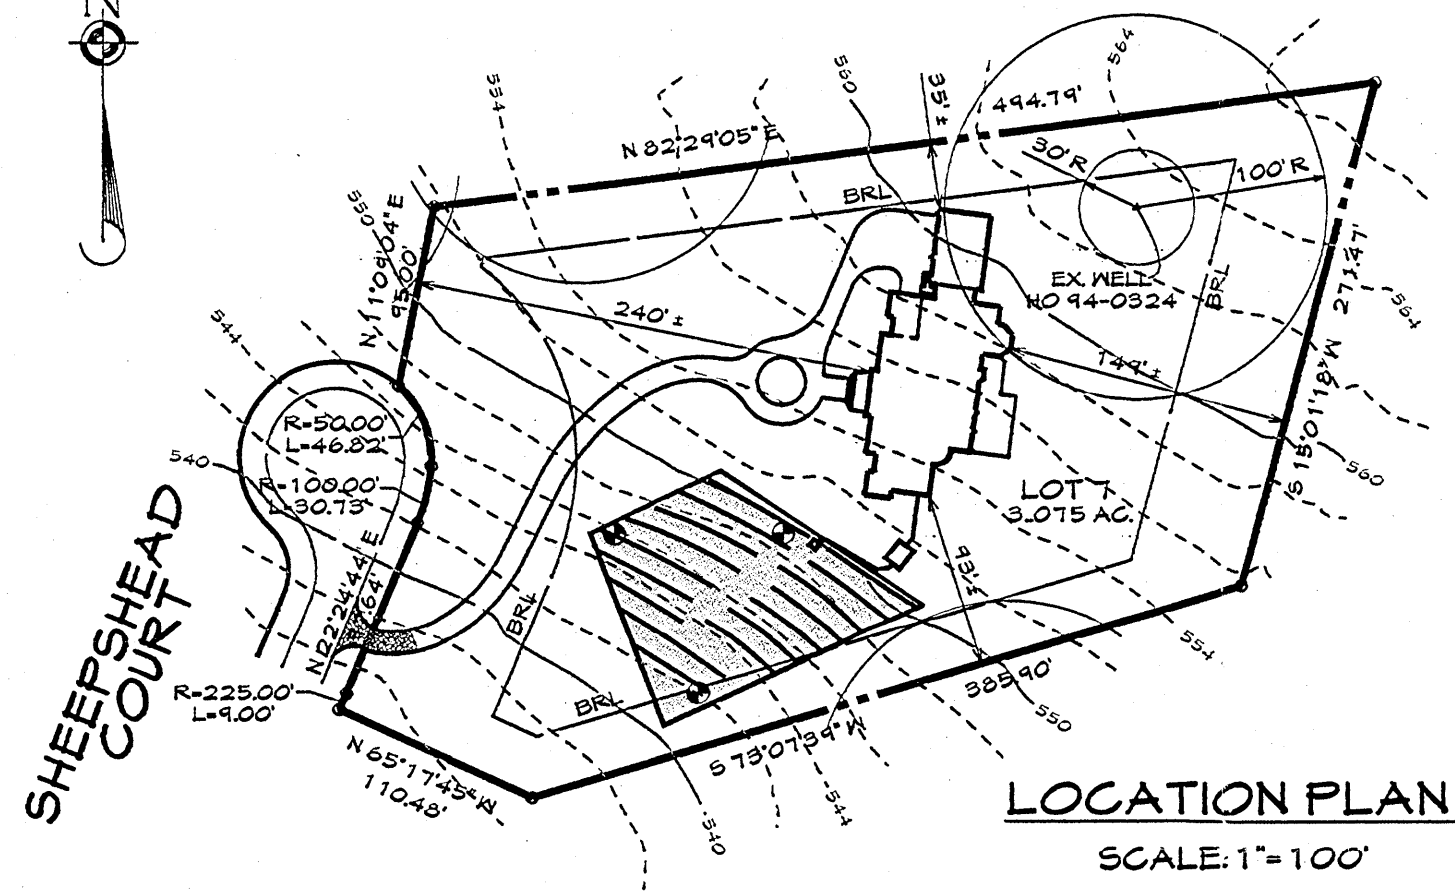

HOUSE DETAIL

SCALE: 1"=30'

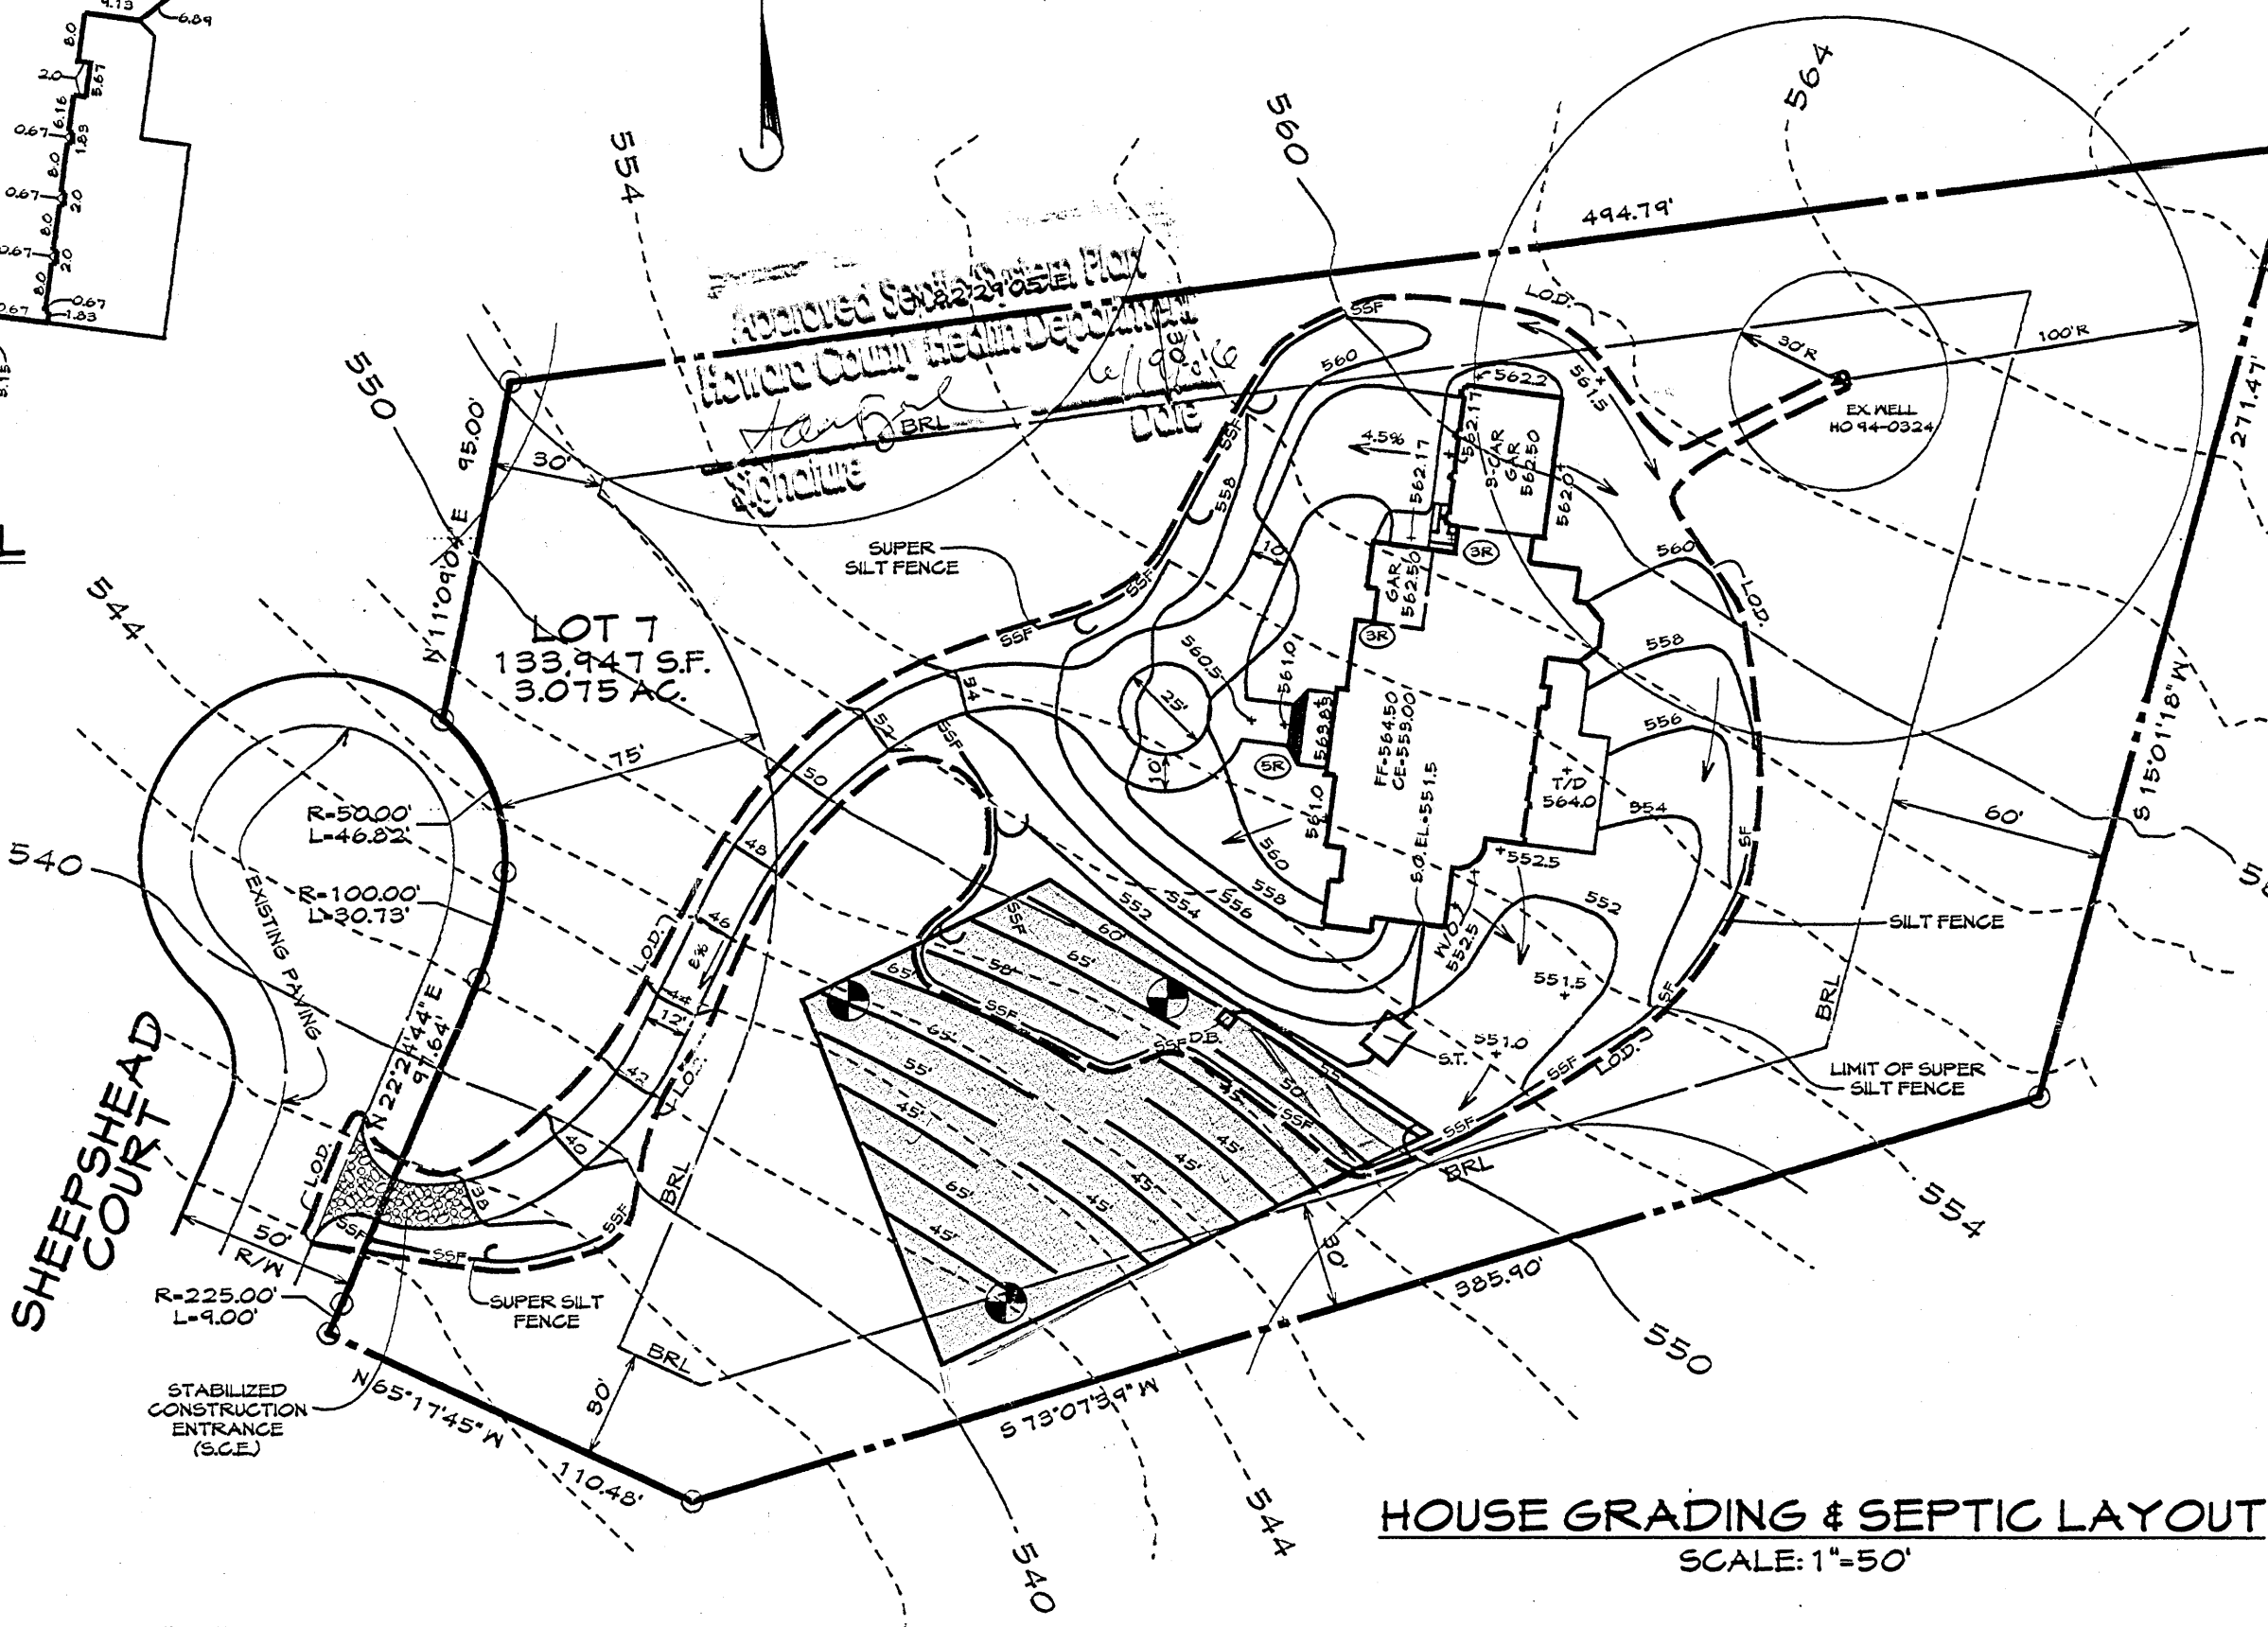

LEGEND

- ▲ - DENOTES EXISTING WELL
- SF - SF - DENOTES SILT FENCE
- SSF - SSF - DENOTES SUPER SILT FENCE
- [Pattern] - DENOTES STABILIZED CONSTRUCTION ENTRANCE (S.C.E.)
- [Pattern] - DENOTES SEPTIC AREA
- - DENOTES L.O.D. LIMIT OF DISTURBANCE
- S.O. - DENOTES SEWER OUT

L.O.D. - DENOTES LIMIT OF DISTURBANCE TOTAL AREA=43,600 S.F.

PLAN TO ACCOMPANY APPLICATION FOR BUILDING PERMIT PLOT PLAN


LOT 7
SHEPSCHEAD COURT
HEDGEROW
TAX MAP: 28 PARCEL: 30
5TH ELECTION DISTRICT HOWARD COUNTY, MD.
PLAT NO. 8435

NOTE: "The existing well(s) shown on this plan (identified with the attached well tag number ex. HO-94-0324) has been field located by John Koranby professional land surveyor(s) and its accuracy shown."

BUILDING SETBACKS

FRONT	30'
SIDE	30'
REAR	60'

DETAIL 24 - STABILIZED CONSTRUCTION ENTRANCE

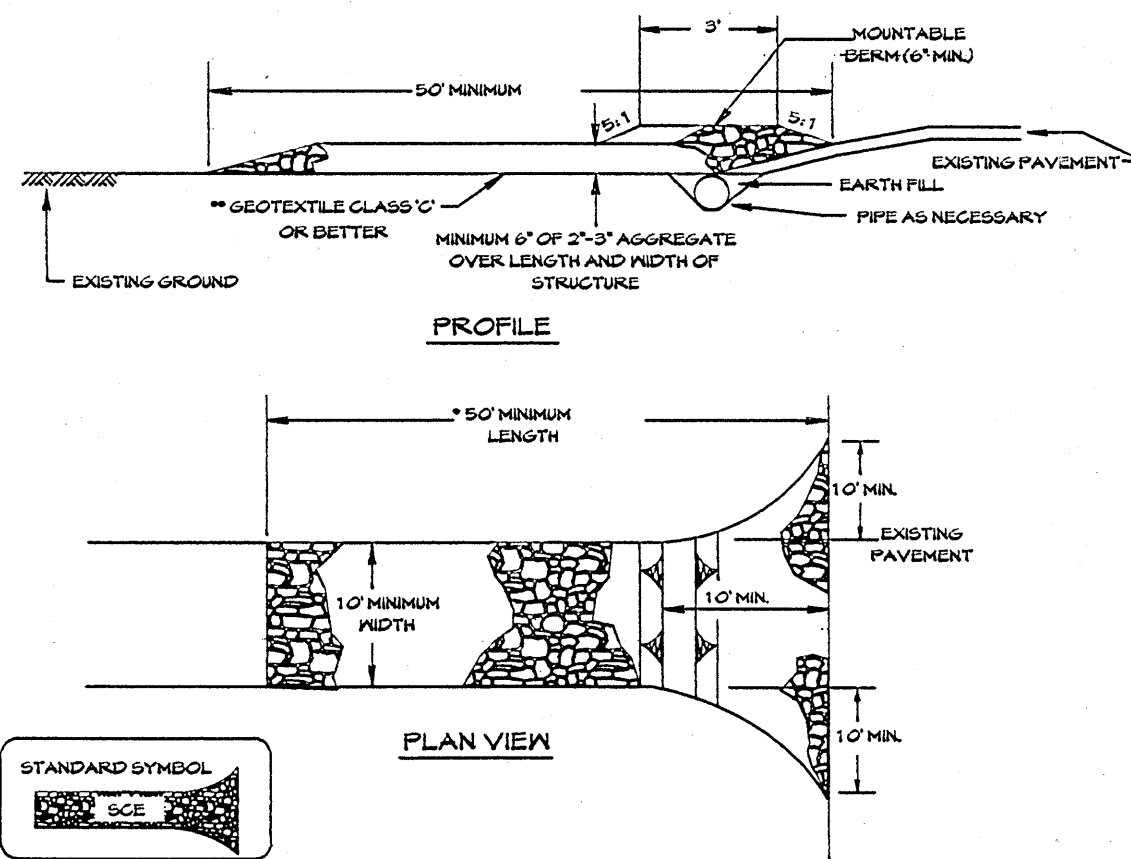


1. LENGTH - MINIMUM OF 50' (50' FOR SINGLE RESIDENCE LOT).
2. WIDTH - 10' MINIMUM, SHOULD BE FLARED AT THE EXISTING ROAD TO PROVIDE A TURNING RADIUS.
3. GEOTEXTILE FABRIC (FILTER CLOTH) SHALL BE PLACED OVER THE EXISTING GROUND PRIOR TO PLACING STONE. *THE PLAN APPROVAL AUTHORITY MAY NOT REQUIRE SINGLE FAMILY RESIDENCES TO USE GEOTEXTILE.
4. STONE - CRUSHED AGGREGATE (2" TO 3") OR RECLAIMED OR RECYCLED CONCRETE. EQUIVALENT SHALL BE PLACED AT LEAST 6" DEEP OVER THE LENGTH AND WIDTH OF THE ENTRANCE.
5. SURFACE WATER - ALL SURFACE WATER FLOWING TO OR DIVERTED TOWARD CONSTRUCTION ENTRANCES SHALL BE PIPED THROUGH THE ENTRANCE, MAINTAINING POSITIVE DRAINAGE. PIPE INSTALLED THROUGH THE STABILIZED CONSTRUCTION ENTRANCE SHALL BE PROTECTED WITH A MOUNTABLE BERM WITH 5:1 SLOPES AND A MINIMUM OF 6" OF STONE OVER THE PIPE. PIPE HAS TO BE DEEP SEED ACCORDING TO THE DRAINAGE. WHEN THE S.C.E. IS LOCATED AT A HIGH-POINT AND HAS NO DRAINAGE TO CONVEY A PIPE WILL NOT BE NECESSARY. PIPE SHOULD BE SIZED ACCORDING TO THE AMOUNT OF RUNOFF TO BE CONVEYED. A 6" MINIMUM WILL BE REQUIRED.
6. LOCATION - A STABILIZED CONSTRUCTION ENTRANCE SHALL BE LOCATED AT EVERY POINT WHERE CONSTRUCTION TRAFFIC ENTERS OR LEAVES A CONSTRUCTION SITE, VEHICLES LEAVING THE SITE MUST TRAVEL OVER THE ENTIRE LENGTH OF THE STABILIZED CONSTRUCTION ENTRANCE.

GENERAL NOTES

1. THIS AREA DESIGNATES A PRIVATE SEWERAGE EASEMENT AT LEAST 10,000 SQUARE FEET AS REQUIRED BY THE MARYLAND STATE DEPARTMENT OF THE ENVIRONMENT FOR INDIVIDUAL SEWERAGE DISPOSAL IMPROVEMENTS OF ANY NATURE IN THIS AREA ARE RESTRICTED UNTIL PUBLIC SEWERAGE IS AVAILABLE. THESE EASEMENTS SHALL BECOME NULL AND VOID UPON CONNECTION TO A PUBLIC SEWERAGE SYSTEM. THE COUNTY HEALTH OFFICER SHALL HAVE THE AUTHORITY TO GRANT ADJUSTMENTS TO THE PRIVATE SEWERAGE EASEMENT. RECORDATION OF A MODIFIED SEWERAGE EASEMENT SHALL NOT BE NECESSARY.
2. THE LOT SHOWN HEREON COMPLIES WITH THE MINIMUM OWNERSHIP WIDTH AND LOT AREA AS REQUIRED BY THE MARYLAND STATE DEPARTMENT OF THE ENVIRONMENT.
3. EXISTING WELLS AND/OR SEWERAGE EASEMENTS WITHIN 100 FEET OF THE PROPERTY HAVE BEEN SHOWN FROM THE BEST AVAILABLE INFORMATION.
4. ALL HOUSE SITES SHOWN COMPLY WITH MINIMUM BUILDING RESTRICTION REGULATIONS.
5. ALL WELLS SHALL BE DRILLED PRIOR TO FINAL PLAT RECORDATION. IT IS THE DEVELOPERS RESPONSIBILITY TO SCHEDULE THE WELL DRILLING PRIOR TO FINAL PLAT SUBMISSION. IT WILL NOT BE CONSIDERED GOVERNMENT DELAY IF THE WELL DRILLING HOLDS-UP THE HEALTH DEPARTMENT SIGNATURE OF THE RECORD PLAT.

DETAIL 23 - SUPER SILT FENCE

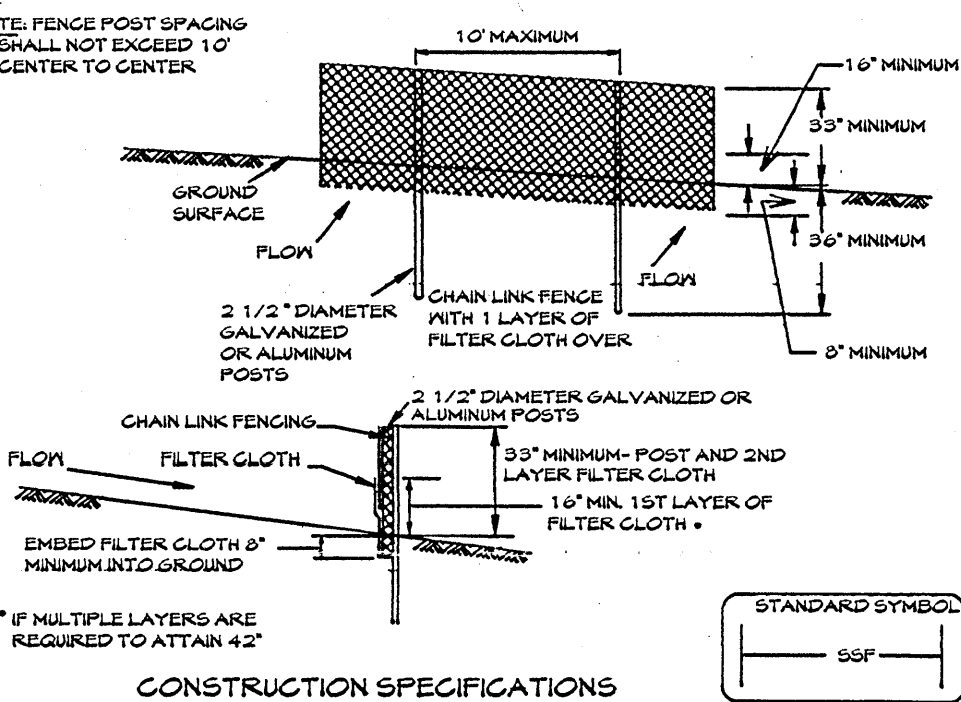

CONSTRUCTION SPECIFICATIONS

- FENCING SHALL BE 42" IN HEIGHT AND CONSTRUCTED IN ACCORDANCE WITH THE LATEST MARYLAND STATE HIGHWAY DETAILS FOR CHAIN LINK FENCING. THE SPECIFICATION FOR A 6 FENCE SHALL BE USED, SUBSTITUTING 42" FABRIC AND 6" LENGTH POSTS.
1. THE POSTS DO NOT NEED TO SET IN CONCRETE.
 2. CHAIN LINK FENCE SHALL BE FASTENED SECURELY TO THE FENCE POSTS WITH WIRE TIES. THE LOWER TENSION WIRE BRACE AND TRUSS RODS, DRIVE ANCHORS AND POST CAPS ARE NOT REQUIRED EXCEPT ON THE ENDS OF THE FENCE.
 3. FILTER CLOTH SHALL BE FASTENED SECURELY TO THE CHAIN LINK FENCE WITH TIES SPACED EVERY 24" AT THE TOP AND MID SECTION.
 4. FILTER CLOTH SHALL BE EMBEDDED A MINIMUM OF 8" INTO THE GROUND.
 5. WHEN TWO SECTIONS OF FILTER CLOTH ADJOIN EACH OTHER, THEY SHALL BE OVERLAPPED BY 6" AND FOLDED.
 6. MAINTENANCE SHALL BE PERFORMED AS NEEDED AND SILT BUILDUPS REMOVED WHEN 'BULGES' DEVELOP IN THE SILT FENCE, OR WHEN SILT REACHES 50% OF FENCE HEIGHT.
 7. FILTER CLOTH SHALL BE FASTENED SECURELY TO EACH FENCE POST WITH WIRE TIES OR STAPLES AT TOP AND MID SECTION AND SHALL MEET THE FOLLOWING REQUIREMENTS FOR GEOTEXTILE CLASS F:

TENSILE STRENGTH	50 LBS./IN. (MIN.)	TEST: MSMT 504
TENSILE MODULUS	20 LBS./IN. (MIN.)	TEST: MSMT 504
FLOCH RATE	0.3 GAL/FT ² PER MINUTE (MAX.)	TEST: MSMT 522
FILTERING EFFICIENCY	75% (MIN.)	TEST: MSMT 322

DESIGN CRITERIA

SLOPE	SLOPE STEEPNESS	SLOPE LENGTH (MAXIMUM)	SILT FENCE LENGTH (MAXIMUM)
0 - 10%	0 - 10:1	UNLIMITED	UNLIMITED
10 - 20%	10:1 - 5:1	200 FEET	1,500 FEET
20 - 33%	5:1 - 3:1	100 FEET	1,000 FEET
33 - 50%	3:1 - 2:1	100 FEET	500 FEET
50% +	2:1 +	50 FEET	250 FEET


DATE	REVISIONS	
3/28/06	REVISE HOUSE DIMENSIONS AS PER CLIENT	JEP
4/26/06	REVISED SILT FENCE TO SUPER SILT FENCE & SIZE AS PER COUNTY COMMENTS	JEP
6/15/06	REVISED SEPTIC AREA BY SHOWING ALL TRENCHES TO PLAN FOR A (6) BEDROOM HOUSE & L.O.D. PER COUNTY COMMENTS	JEP



FREDERICK OFFICE: 5713 Poplar Court, Suite 2 Frederick, MD 21703-5376 (410) 662-1799 FAX (410) 662-8004	WESTMINSTER OFFICE: 439 East Main Street Westminster, MD 21157-5339 (410) 846-1791 FAX (410) 846-1791	Professional Engineer Registration No. 23448 Date: 3/21/2006 Drawing No: 48144A County File No:
Surveyed By: [Blank]	Drawn By: MSB	Checked By: JEP
Computed By: [Blank]		



LINDEN CHAPEL HILLS
SECTION 4
FLAT NO. 3330
BLOCK 'C'

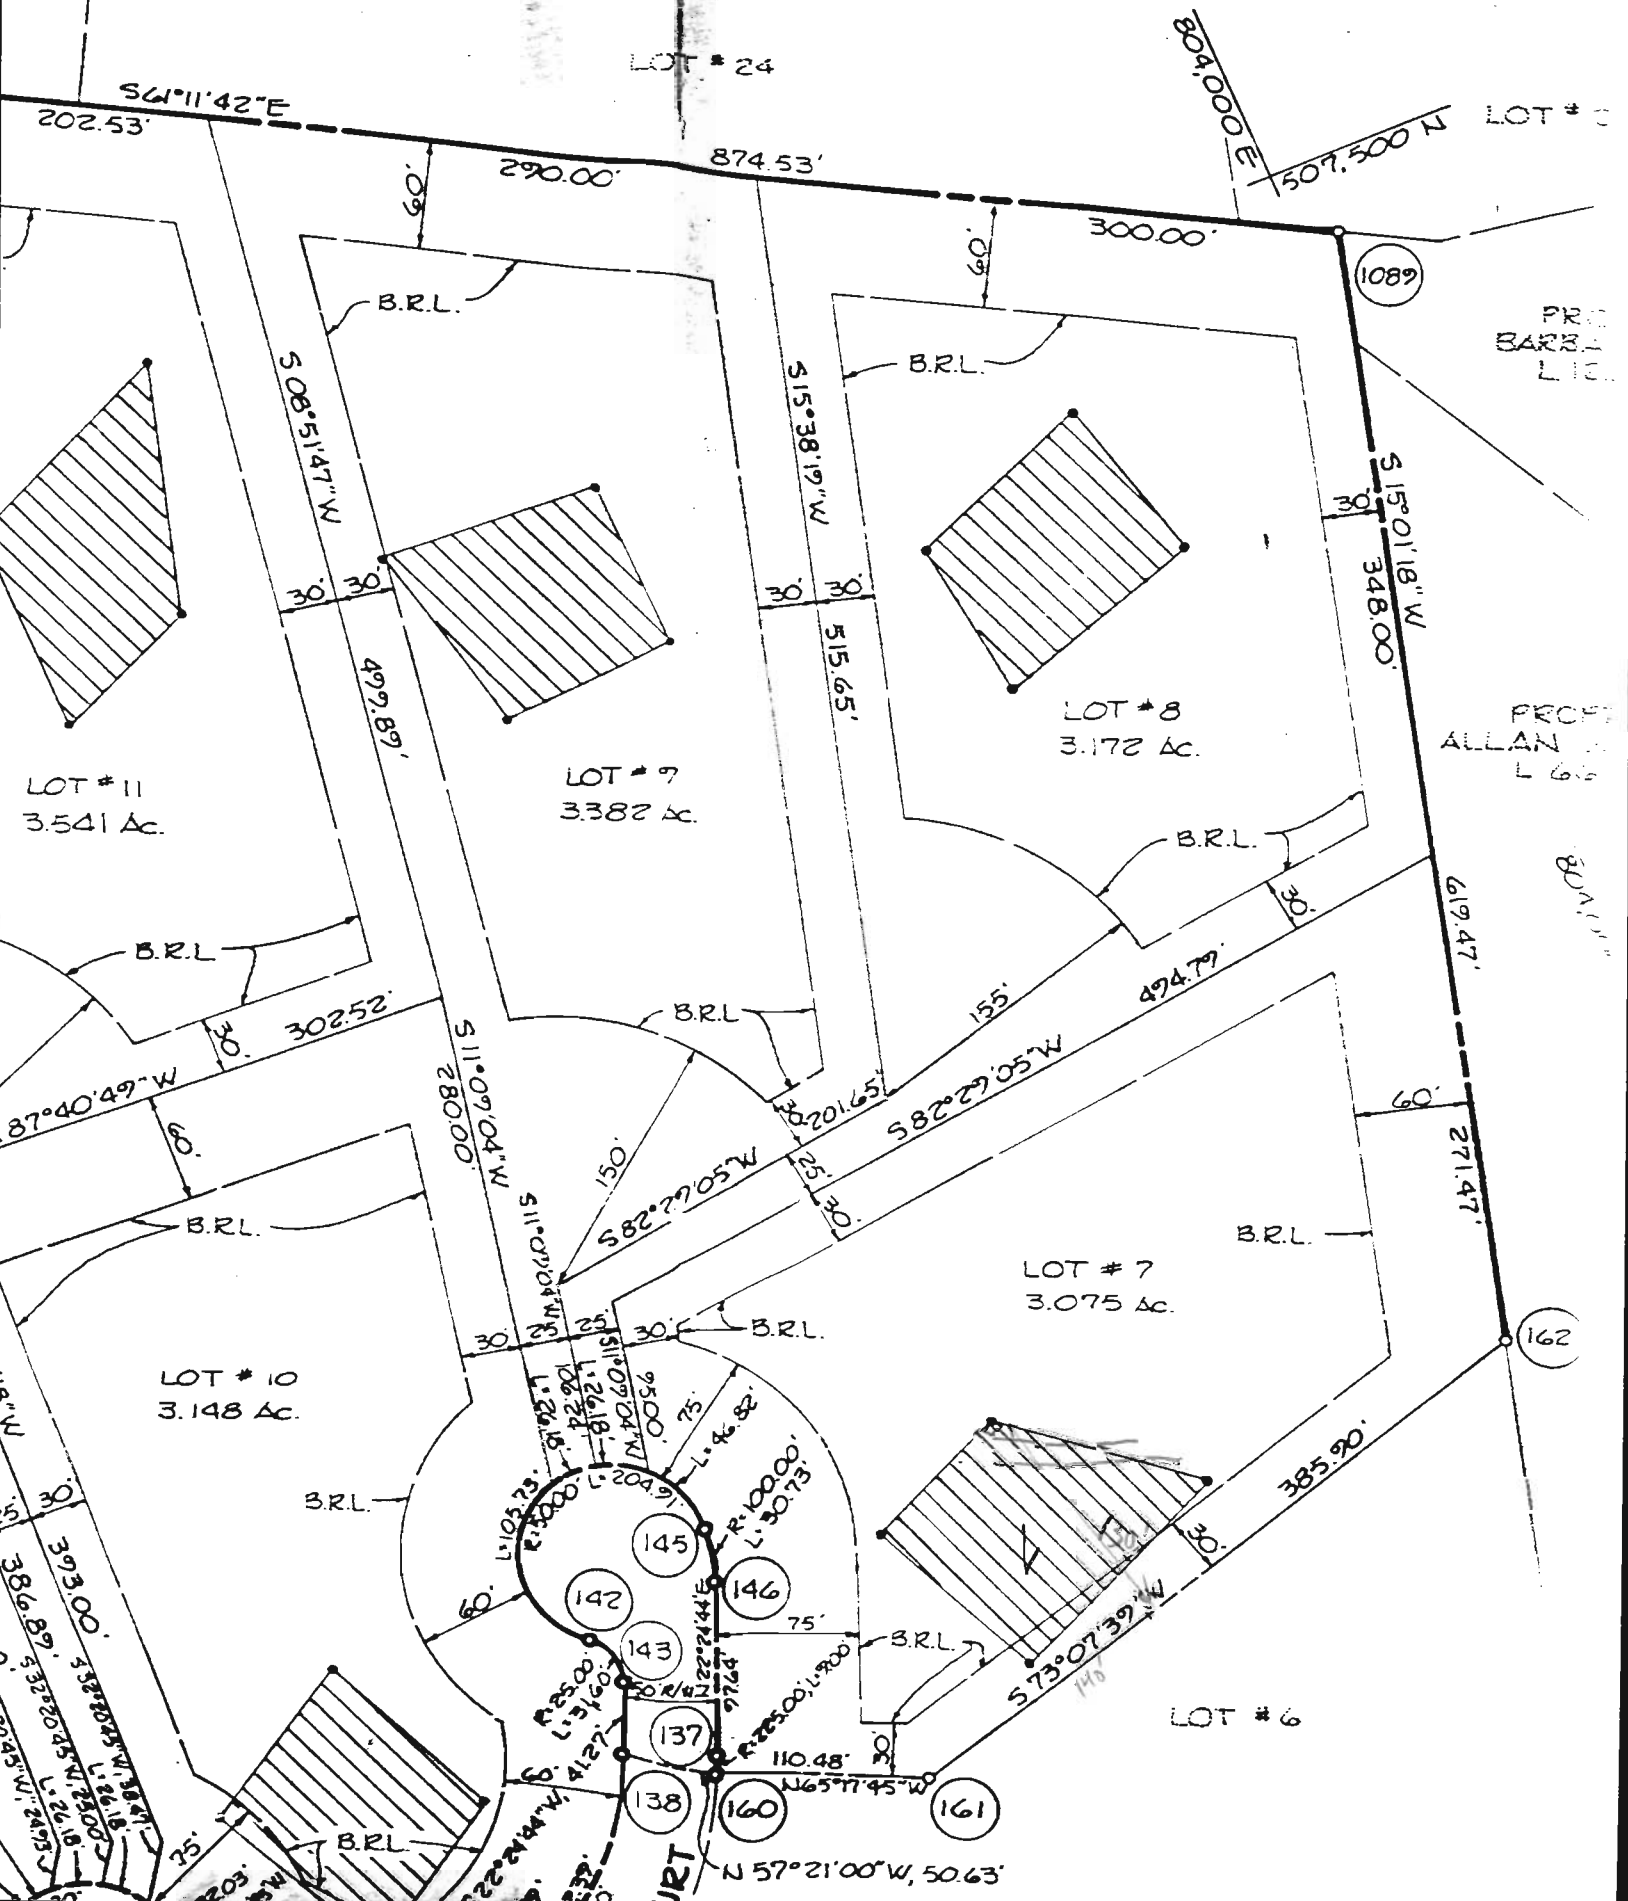

LOCATION OF PROPERTY KNOWN AS 13606 SHEEPSHEAD COURT, ALSO KNOWN AS LOT 7 AS SHOWN ON PLAT OF HEDGEROW, SECTION 1 AND RECORDED AMONG THE LAND RECORDS OF HOWARD COUNTY, MARYLAND, IN PLAT # 8935.


THIS DRAWING DOES NOT PROVIDE FOR THE ACCURATE IDENTIFICATION OF PROPERTY BOUNDARY LINES, BUT THIS IDENTIFICATION MAY BE REQUIRED, BUT NEED NOT BE REQUIRED, FOR THE TRANSFER OF TITLE OR SECURING FINANCING OR REFINANCING.

THIS DRAWING IS OF BENEFIT TO A CONSUMER ONLY INSOFAR AS IT IS REQUIRED BY A LENDER OR A TITLE INSURANCE COMPANY OR ITS AGENT IN CONNECTION WITH CONTEMPLATED TRANSFER, FINANCING OR REFINANCING


THIS DRAWING IS NOT TO BE RELIED UPON FOR THE ESTABLISHMENT OR LOCATION OF FENCES, GARAGES, BUILDINGS, OR OTHER EXISTING OR FUTURE IMPROVEMENTS.

THE DISTANCES SHOWN HEREON ARE ±1 FOOT.

A LICENSED SURVEYOR WAS IN RESPONSIBLE CHARGE OVER THE PREPARATION OF THIS PLAT AND THE SURVEYING WORK REFLECTED IN IT, ALL IN COMPLIANCE WITH REQUIREMENTS SET FORTH IN REGULATION 09.13.06.12. BEARINGS AND DISTANCES SHOWN HEREON ARE BASED ON THE PLAT OF HEDGEROW, SECTION 1, RECORDED IN PLAT # 8935.

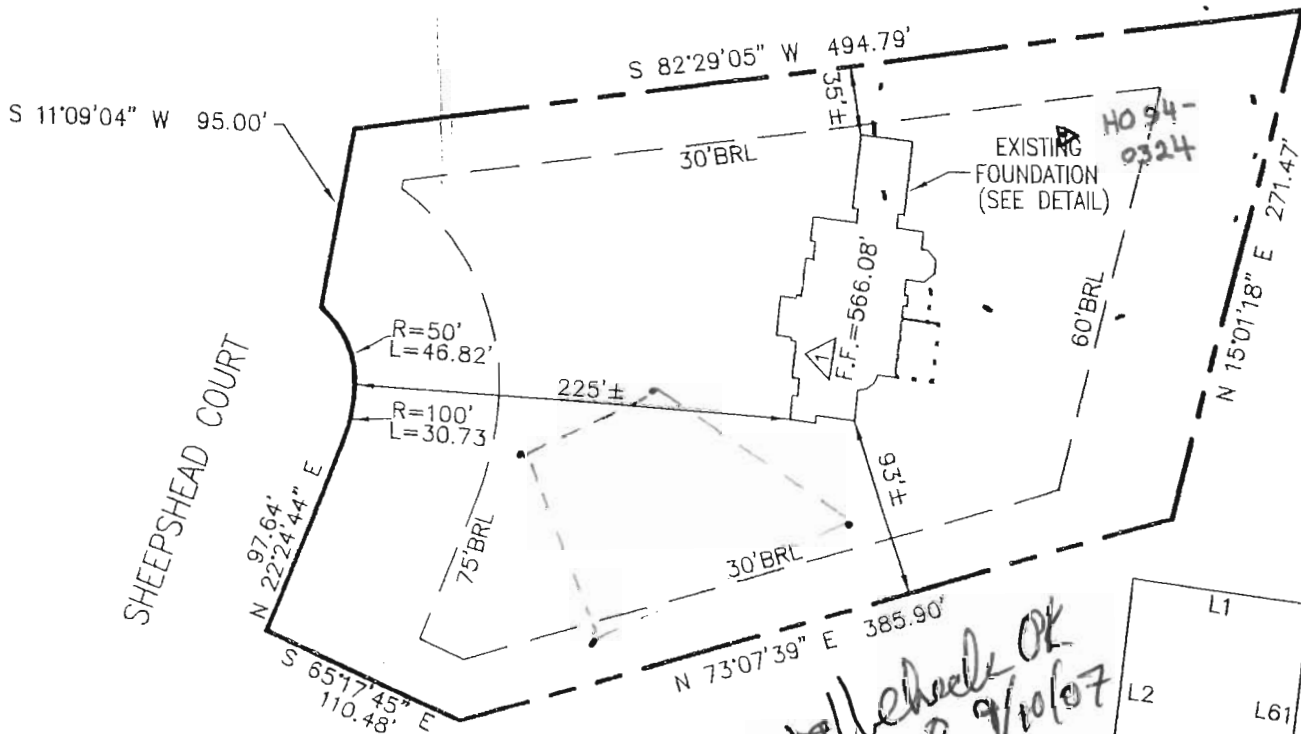

LINE	DIST.	LINE	DIST.	LINE	DIST.
L1	26.7'	L21	2.7'	L41	2.0'
L2	38.7'	L22	12.7'	L42	0.7'
L3	3.0'	L23	13.3'	L43	7.9'
L4	7.3'	L24	4.0'	L44	0.7'
L5	22.7'	L25	20.0'	L45	2.0'
L6	12.7'	L26	16.5'	L46	0.7'
L7	2.7'	L27	1.1'	L47	6.2'
L8	9.3'	L28	3.9'	L48	2.0'
L9	4.0'	L29	3.9'	L49	5.7'
L10	19.3'	L30	3.9'	L50	2.0'
L11	2.7'	L31	1.1'	L51	8.0'
L12	1.7'	L32	9.7'	L52	9.1'
L13	8.0'	L33	2.0'	L53	6.9'
L14	20.7'	L34	0.7'	L54	6.9'
L15	8.0'	L35	7.9'	L55	6.9'
L16	1.7'	L36	0.7'	L56	3.1'
L17	2.7'	L37	2.0'	L57	9.0'
L18	19.3'	L38	0.7'	L58	14.0'
L19	4.0'	L39	7.9'	L59	7.3'
L20	9.3'	L40	0.7'	L60	3.0'
				L61	38.7'

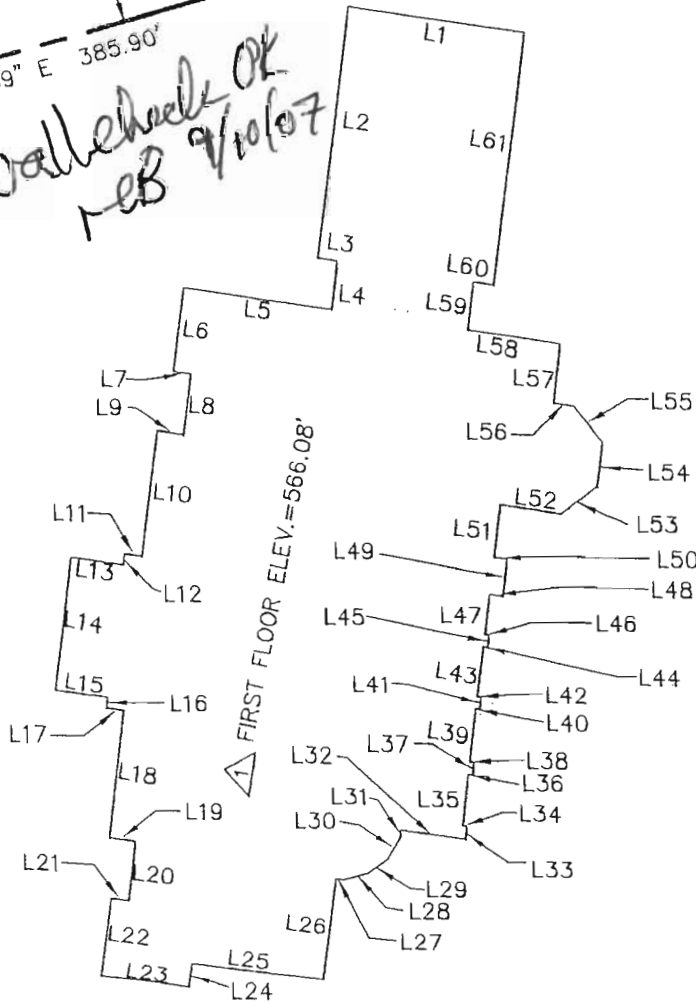

1 REVISION 07/19/2007 ADDED FIRST FLOOR ELEVATION

SCALE	DATE
1" = 100'	DEC. 2006
DR. BY	CHK. BY
BCH	BJH
PLAT NO.	JOB No.
8935	26198.00



CENTURY ENGINEERING, INC.
CONSULTING ENGINEERS - SURVEYORS
10710 GILROY ROAD
HUNT VALLEY, MARYLAND
(410) 823-8070

FOUNDATION CERTIFICATION

HEDGEROW
SECTION 1
LOT 7

13606 SHEEPSHEAD COURT
CLARKSVILLE, MD. 21029