



Bureau of Environmental Health

8930 Stanford Boulevard, Columbia, MD 21045

Main: 410-313-2640 | Fax: 410-313-2648

TDD 410-313-2323 | Toll Free 1-866-313-6300

www.hchealth.org

Facebook: www.facebook.com/hocohealth

Twitter: HowardCoHealthDep

Maura J. Rossman, M.D., Health Officer

SEWAGE DISPOSAL SYSTEM SPECIFICATIONS WORKSHEET

Address: 3615 School Drive

Subdivision: _____ Lot: _____

Initial system:	Application rate: <u>0.8</u>	Effective area beginning depth: <u>3</u>	Bottom maximum depth: <u>6</u>
1 st Replacement:	Application rate: <u>0.8</u>	Effective area beginning depth: <u>3</u>	Bottom maximum depth: <u>6</u>
2 nd Replacement:	Application rate: <u>0.8</u>	Effective area beginning depth: <u>3</u>	Bottom maximum depth: <u>6</u>

Design Flow = 150 gallons per day per bedroom

Design flow ÷ application rate = square footage of drainfield required

Linear length of trench required = drainfield square footage x sidewall reduction percentage ÷ trench width

Sidewall reduction credit formula:

$$\frac{W + 2}{W + 1 + 2D} \times 100 = \text{Percent of length of standard trench where } W = \text{trench width and } D = \text{depth between effective area beginning depth and trench bottom.}$$

Standard design requirements:

- Trenches must be located to provide room for 3 systems in the disposal area
- All trenches must be equal length unless low pressure dosed
- All trenches must be on contour
- Minimum trench spacing: 10' for all trenches utilizing sidewall reduction credit. Additional spacing may be necessary for any trench using over 3.5' of effective sidewall. In those cases, the spacing formula is $2D + W$ up to a maximum spacing of 18'.
- Minimum trench spacing for trenches with no sidewall credit (bottom area only) is 6' for a 2' wide trench and 9' for a 3' wide trench (spacing is measured edge to edge)
- Maximum trench length is 100'
- Maximum pipe depth is 4'


Additional requirements:

Approved: E'SF Date: 5/24/2019

SITE INSPECTION SHEET

OWNER: _____ PHONE #: _____
ADDRESS: 7613 Shal CONTRACTOR: _____
SUBDIVISION: _____ LOT: _____ WELL TAG #: _____
PROPOSAL: _____ COUNTY #: _____



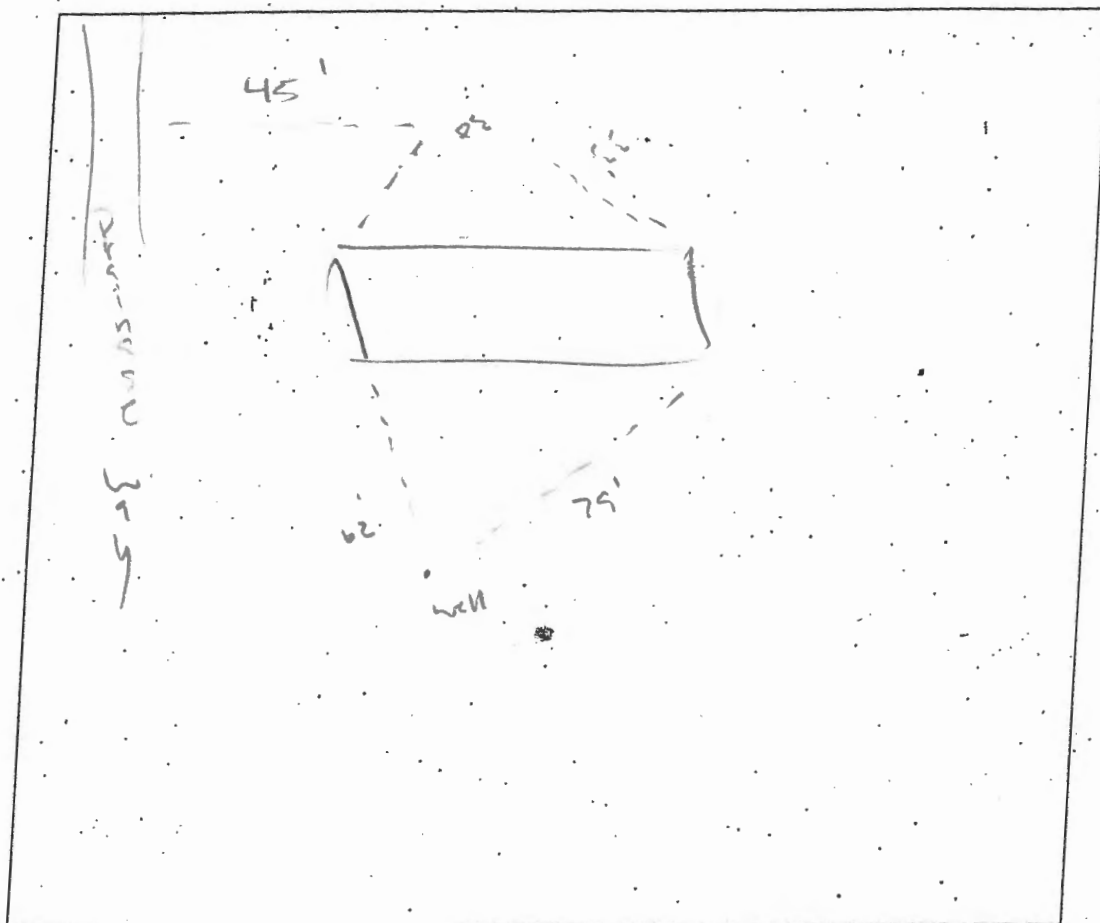


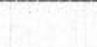
LOCATION DIAGRAM






COMMENTS: Well satisfactory slightly buried, only cap sticking
out. Septic good not failing. Septic Tank ok.

DATE: _____ INSPECTOR: _____

LEGEND:

-  ORIGINAL PRIVATE SEWAGE EASEMENT AREA
 PROPOSED PRIVATE SEWAGE EASEMENT AREA
 TOPOGRAPHY LINES
 LOT LINES
 SOIL BOUNDARY LINE
 SEPTIC & WELL SETBACK

-  PASSING PERC HOLES
 SEPTIC TANK
 WATER WELL

GENERAL NOTES:

- TOTAL AREA OF PROPERTY 40,053 SQ. FT.
- PRIVATE WATER AND PRIVATE SEWER WILL BE USED WITH THIS SITE
- THIS AREA DESIGNATES A PRIVATE SEWAGE DISPOSAL AREA OF 10,000 SF. FT. AS REQUIRED BY THE MARYLAND DEPARTMENT OF ENVIRONMENT FOR INDIVIDUAL SEWAGE DISPOSAL. FOR LOTS CREATED PRIOR TO MARCH OF 1972 IT PROVIDES AT LEAST ENOUGH AREA TO ACCOMMODATE AN INITIAL AND TWO REPLACEMENT SEPTIC SYSTEMS AS REQUIRED BY THE HOWARD COUNTY HEALTH DEPARTMENT. IMPROVEMENTS OF ANY NATURE WITHIN THIS AREA ARE RESTRICTED UNTIL PUBLIC SEWERAGE IS AVAILABLE. THIS AREA SHALL BECOME NULL AND VOID UPON CONNECTION TO A PUBLIC SEWERAGE SYSTEM. THE COUNTY HEALTH OFFICER SHALL HAVE AUTHORITY TO GRANT ADJUSTMENTS TO THE PRIVATE SEWAGE EASEMENT RECORDATION OF A REVISED SEWAGE EASEMENT SHALL NOT BE NECESSARY.
- BOUNDARY SHOWN HEREON IS BASED ON HOWARD COUNTY TAX MAP INFORMATION
- THE TOPOGRAPHY OF THIS PLAT IS TAKEN FROM HOWARD COUNTY AERIAL PHOTOGRAPHY FLOWN IN 2011 AND IS VERIFIED TO ACCURATELY REPRESENT THE RELATIVE CHANGES ON THE SUBJECT PROPERTY.
- ANY CHANGES TO A PRIVATE SEWAGE EASEMENT SHALL REQUIRE A REVISED PERCOLATION CERTIFICATION PLAN.
- ALL WELLS AND SEPTIC SYSTEMS LOCATED WITHIN 100' OF THE PROPERTY BOUNDARIES AND 200' DOWN GRADIENT OF ANY WELLS AND/OR SEPTIC SYSTEMS HAVE BEEN SHOWN.
- THE PURPOSE OF THIS PLAN IS TO ESTABLISH A WELL AND SEPTIC EASEMENT TO ACCOMMODATE THE PROPOSED ADDITION AND FUTURE ADDITION TO A 3 BEDROOMS HOUSE.

PERC CERT CALCULATION

Number of bedroom : 3		2'		3'		2'		3'	
Design Flow (150 gallons per day per bedroom) : 450									
	Application rate (gal/day/sq. ft.)	Square footage of drainfield required (Design flow/application rate)	Effective area beginning depth (ft)	Bottom max. depth (ft)	Sidewall reduction credit	Required trench length (ft)		Required trench length (ft)	
Initial System	0.8	563	3	6	44%	50%	123	93	
1ST Replacement	0.8	563	3	6	44%	50%	123	93	
2nd Replacement	0.8	563	3	6	44%	50%	123	93	

sidewall reduction credit = $(W+2/(W+1+2D)) \times 100$
 Where W is trench width and D is Bottom max depth less Beginning depth

I certify that the information shown herein is based on field work performed by me or under my direct supervision, and is correct, to the best of my knowledge and belief.
 Hayman Z. Elashry
 Architect


07-01-2019
 Date

PERCOLATION CERTIFICATION PLAN
3615 SCHEEL DRIVE ELLICOTT CITY, MD 21042 - LOT 17
OWNERS: HAYMAN ELASHRY TEL: 202-492-8548

approved For Private water and private Sewerage Systems

Health Officer, Howard County Health Dept.

7/1/19
 Date

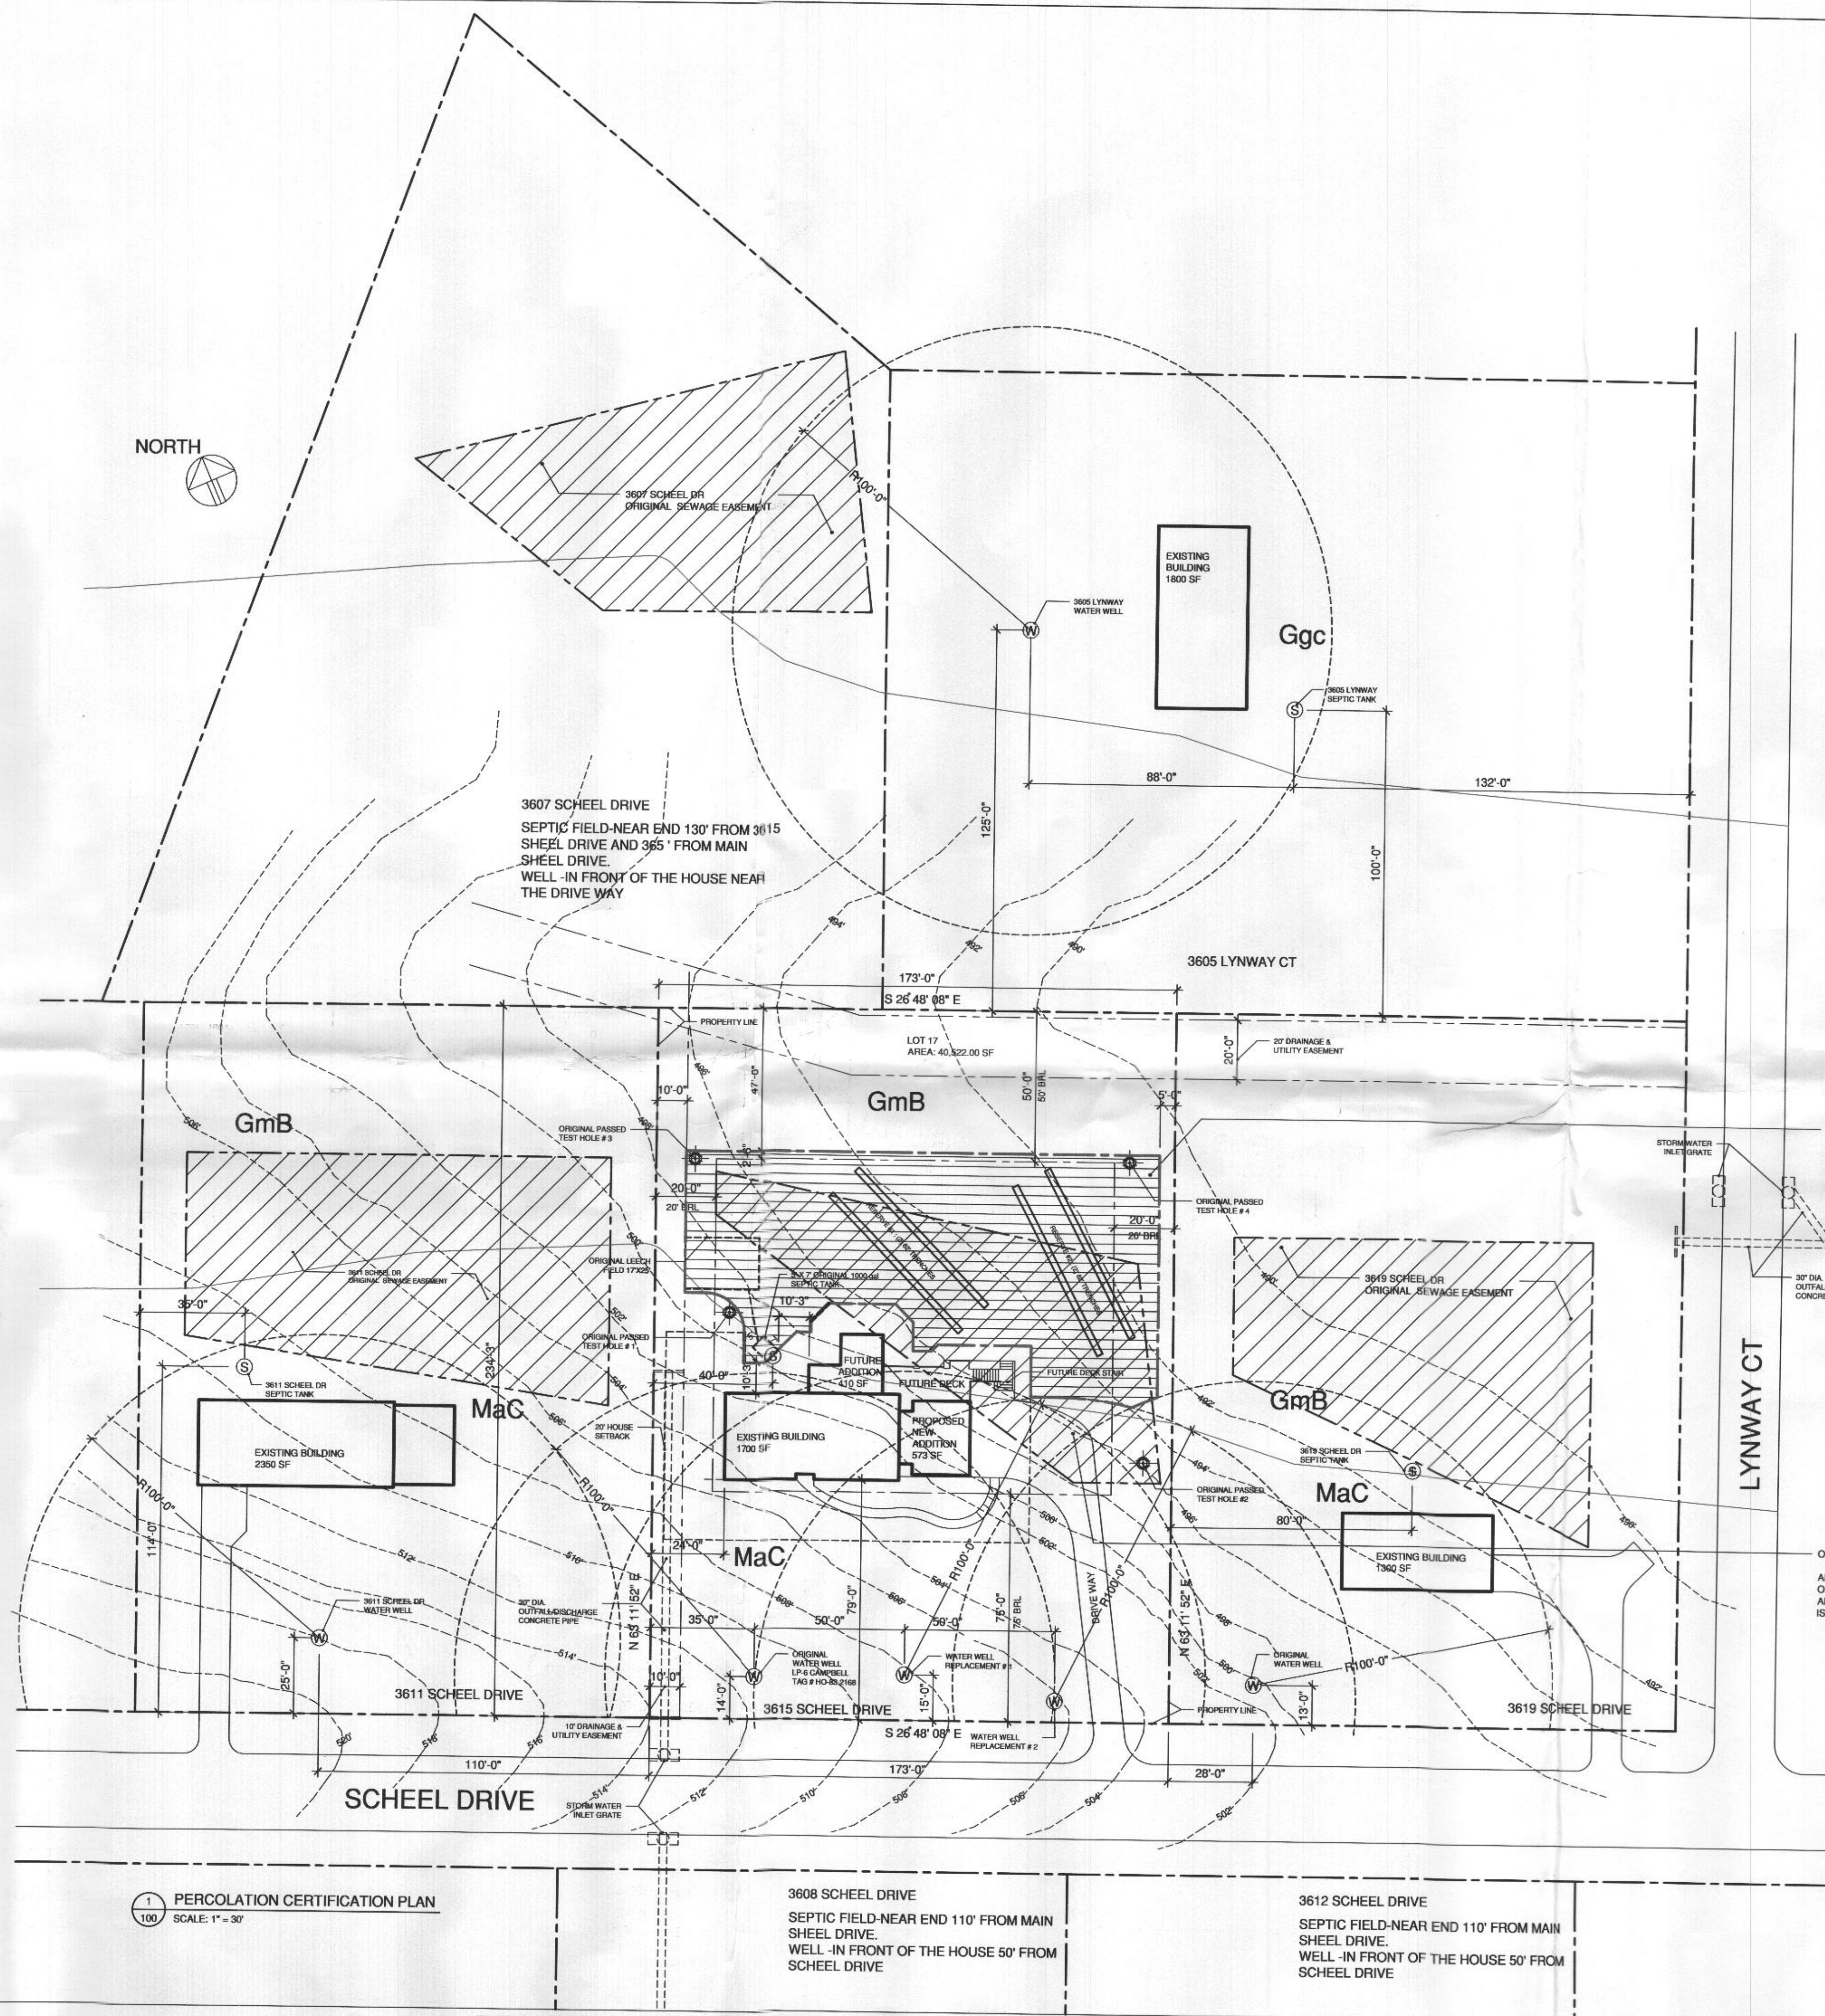

LEGEND:

ORIGINAL PRIVATE SEWAGE EASEMENT AREA

PROPOSED PRIVATE SEWAGE EASEMENT AREA

TOPOGRAPHY LINES

LOT LINES

SOIL BOUNDARY LINE

SEPTIC & WELL SETBACK

PASSING PERC HOLES

SEPTIC TANK

WATER WELL

- GENERAL NOTES:
- TOTAL AREA OF PROPERTY 40,053 SQ. FT.
 - PRIVATE WATER AND PRIVATE SEWER WILL BE USED WITH THIS SITE
 - THIS AREA DESIGNATES A PRIVATE SEWAGE DISPOSAL AREA OF 10,000 SF. AS REQUIRED BY THE MARYLAND DEPARTMENT OF ENVIRONMENT FOR INDIVIDUAL SEWAGE DISPOSAL. FOR LOTS CREATED PRIOR TO MARCH OF 1972 IT PROVIDES AT LEAST ENOUGH AREA TO ACCOMMODATE AN INITIAL AND TWO REPLACEMENT SEPTIC SYSTEMS AS REQUIRED BY THE HOWARD COUNTY HEALTH DEPARTMENT. IMPROVEMENTS OF ANY NATURE WITHIN THIS AREA ARE RESTRICTED UNTIL PUBLIC SEWERAGE IS AVAILABLE. THIS AREA SHALL BECOME NULL AND VOID UPON CONNECTION TO A PUBLIC SEWERAGE SYSTEM. THE COUNTY HEALTH OFFICER SHALL HAVE AUTHORITY TO GRANT ADJUSTMENTS TO THE PRIVATE SEWAGE EASEMENT RECORDATION OF A REVISED SEWAGE EASEMENT SHALL NOT BE NECESSARY.
 - BOUNDARY SHOWN HEREON IS BASED ON HOWARD COUNTY TAX MAP INFORMATION
 - THE TOPOGRAPHY OF THIS PLAT IS TAKEN FROM HOWARD COUNTY AERIAL PHOTOGRAPHY FLOWN IN 2011 AND IS VERIFIED TO ACCURATELY REPRESENT THE RELATIVE CHANGES ON THE SUBJECT PROPERTY.
 - ANY CHANGES TO A PRIVATE SEWAGE EASEMENT SHALL REQUIRE A REVISED PERCOLATION CERTIFICATION PLAN.
 - ALL WELLS AND SEPTIC SYSTEMS LOCATED WITHIN 100' OF THE PROPERTY BOUNDARIES AND 200' DOWN GRADIENT OF ANY WELLS AND/OR SEPTIC SYSTEMS HAVE BEEN SHOWN.
 - THE PURPOSE OF THIS PLAN IS TO ESTABLISH A WELL AND SEPTIC EASEMENT TO ACCOMMODATE THE PROPOSED ADDITION AND FUTURE ADDITION TO A 3 BEDROOMS HOUSE.

PERC CERT CALCULATION

Number of bedroom : 3					2'	3'	2'	3'
Design Flow (150 gallons per day per bedroom) : 450								
	Application rate (gal/day/sq. ft.)	Square footage of drainfield required (Design flow/application rate)	Effective area beginning depth (ft)	Bottom max. depth (ft)	Sidewall reduction credit		Required trench length w/sidewall credit	
Initial System	0.8	563	3	6	44%	50%	123	93
1ST Replacement	0.8	563	3	6	44%	50%	123	93
2nd Replacement	0.8	563	3	6	44%	50%	123	93


sidewall reduction credit + (W+2)/(W+1+2D) X 100

Where W is trench width and D is Bottom max depth less Beginning depth

I certify that the information shown herein is based on field work performed by me or under my direct supervision, and is correct, to the best of my knowledge and belief.

Hayman Z. Elashry
Architect

07-01-2019
Date

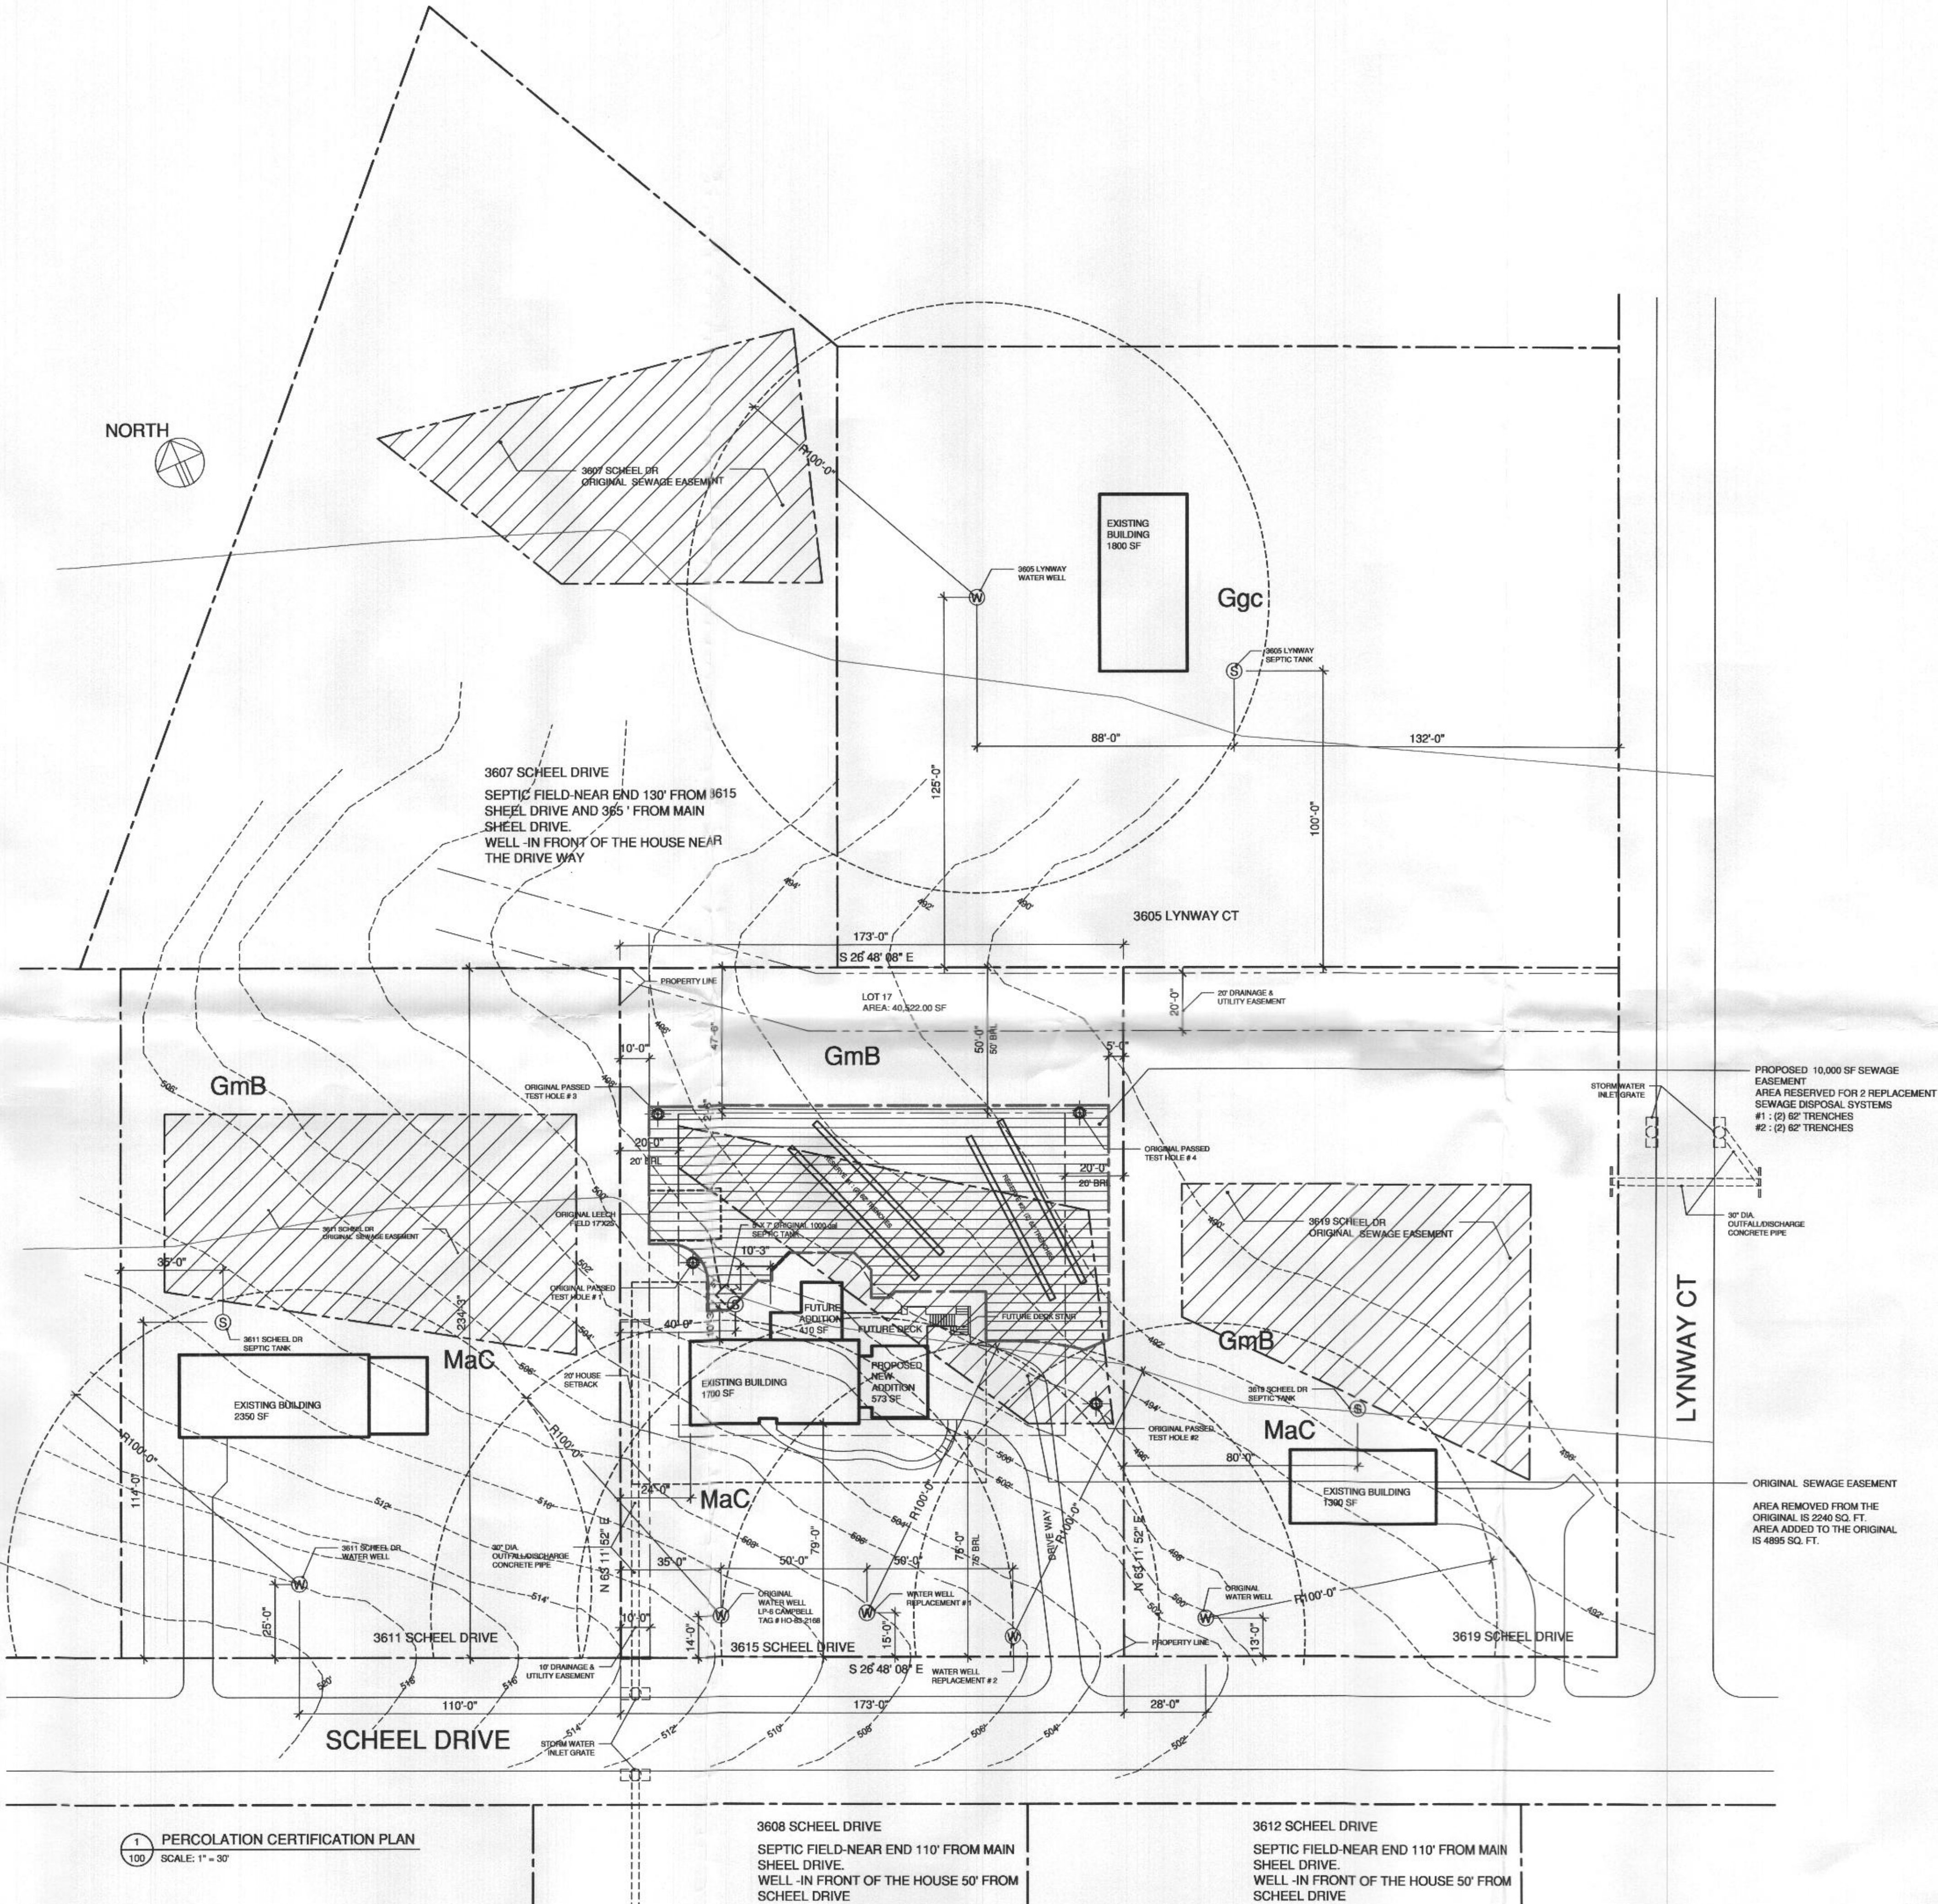

PERCOLATION CERTIFICATION PLAN

3615 SCHEEL DRIVE ELLICOTT CITY, MD 21042 - LOT 17

OWNERS: HAYMAN ELASHRY TEL: 202-492-8548

approved For Private water and private Sewerage Systems

Health Officer, Howard County Health Dept.

7/1/19
Date