


Maura J. Rossman, M.D., Health Officer

## **MEMORANDUM**

*Sent via email to [Jjlink@handhrock.com](mailto:Jjlink@handhrock.com)*

**TO:** Joseph Link  
H and H Rock

**FROM:** Kevin M. Wolf, LEHS, REHS/RS, Supervisor   
Groundwater Mgmt. Sec.  
Well & Septic Program

**DATE:** April 5, 2019

**RE:** 1120 Shaffersville Road  
Mt. Airy, MD 21771  
M. 06 G.12 P. 97 .82AC  
(Demolition of existing sfd – rebuild new sfd)

This is to advise that the Howard County Health Department recommends issuance of the demolition permit for the above referenced property.

The current drilled well (tag unknown) that was utilized for the above referenced property was properly located, abandoned and sealed. This process was completed on 7/9/2018 by Robert Copsey (MSD 161). The MDE well abandonment report was submitted for review to our office. A new well will be drilled for use of the sfd.

The current septic system (tank and trench) was properly located. The system components were pumped out by Hatfield's Equipment on 7/3/2018 (respectively). The tank will be collapsed and filled in with clean fill. The septic trenches were cut off and abandoned. Documentation of this process has been received by our office for review of compliance.

Plans to rebuild on this parcel will require you to install a new well and septic per the approved percolation certification plan.

**IF ANY WELL OR SEPTIC COMPONENTS ARE FOUND DURING SITE WORK, YOU MUST NOTIFY THIS OFFICE IMMEDIATELY!!**

KMW  
Cc: File

# *Hatfield's Equipment and Dedication Services, Inc.*

P.O. Box 519 • Annapolis Junction, MD 20701-0519  
Office: 301-490-4289 / 888-490-4289 • Fax: 301-490-5794

Howard County Health Department  
8930 Stanford Blvd.  
Columbia, MD 21045


7/13/18

RE: Property Located @ 1120 Shaffersville Road Mt. Airy MD 21771

Owner: Yough Associates II LLC  
6800 Deerpath Road  
Suite 100  
Elkridge, MD 21075

Hatfield's Equipment has completed the demo of the septic tank in the rear yard of property.  
The tank was 1000 gallon concrete tank with 6" terracotta clean out.  
The tank was pumped, crushed and filled per specifications.  
We located the drainfields off the tank for drainage.

Regards,

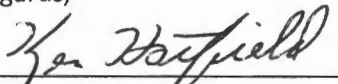  
\_\_\_\_\_  
Ken Hatfield, president

MARYLAND DEPARTMENT OF THE ENVIRONMENT, WATER MANAGEMENT ADMINISTRATION  
1800 Washington Blvd., Baltimore, Maryland 21230 (410) 537-3784

\*\*\*\*\*  
WATER WELL ABANDONMENT-SEALING REPORT FORM  
\*\*\*\*\*

SUBMIT COPIES OF COMPLETED FORM TO:

- \* COUNTY ENVIRONMENTAL AGENCY (contact MDE, WMA if address needed)
- \* WELL OWNER
- \* MDE, WATER MANAGEMENT ADMINISTRATION, WELL PROGRAM

DATE WELL ABANDONED: 7/09/18 (month/day/year)

\* PERMIT NUMBER OF ABANDONED WELL (if any) \_\_\_\_\_

\* PERMIT NUMBER OF REPLACEMENT WELL: \_\_\_\_\_

\* PERSON ABANDONING WELL: Robert Corsey

WELL DRILLER'S LICENSE NUMBER: \_\_\_\_\_


\* OWNER'S NAME: Yough Associates II LLC

CIRCLE: MWD / MSD / MGD

\* WELL LOCATION:

COUNTY: Howard County  
NEAREST TOWN: MIT A. 24  
TAX MAP 0006 BLOCK — PARCEL —  
SUBDIVISION: 0000  
SECTION: — LOT: —  
STREET ADDRESS: 1120 SHAFFERSVILLE RD

SITE LOCATION MAP

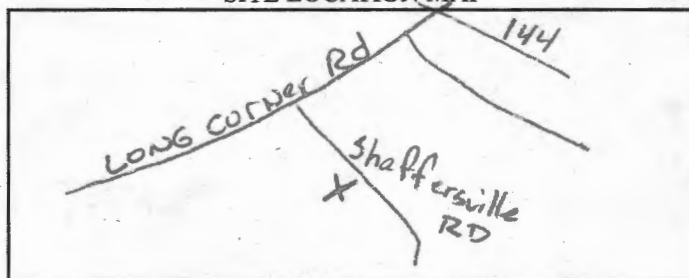

LATITUDE 39.340753

LONGITUDE 77.132774

LOG OF SEALING MATERIAL

MATERIAL	FEET	
	FROM	TO
<u>Bentonite clay</u>	<u>86</u>	<u>5</u>
<u>clean fill</u>	<u>5</u>	<u>0</u>

\* TYPE OF WELL BEING ABANDONED:

☒ DRILLED ☐ JETTED  
☐ BORED ☐ HAND DUG  
☐ OTHER (specify) \_\_\_\_\_

\* USE CODE:

☒ DOMESTIC ☐ MUNICIPAL/PUBLIC  
☐ IRRIGATION ☐ INDUSTRIAL  
☐ TEST/OBSERVATION ☐ GEOTHERMAL

VOLUME OF MATERIAL USED

\* TYPE OF CASING:

☒ STEEL ☐ PLASTIC  
☐ CONCRETE ☐ OTHER (specify) \_\_\_\_\_

1100 lbs Bentonite plug

SIZE OF CASING: 6" INCHES IN DIAMETER

DEPTH OF WELL: 86' FEET DEEP

WAS ANY CASING REMOVED? ☒ YES ☐ NO

If yes, length removed, in feet: 6

WAS CASING RIPPED OR PERFORATED? ☐ YES ☒ NO

SIGNATURE-MASTER WELL DRILLER OR SUPERVISING SANITARIAN LICENSE#

161 MWD / MSD / MGS

CIRCLE ONE

DATE

COUNTY

Pursuant to § 10-624 of the State Govt. Article of the Maryland Code, personal info requested on this form is used in processing this form pursuant to COMAR 26.04.04. Failure to provide the info may result in this form not being processed. You have the right to inspect, amend, or correct this form. The Maryland Department of the Environment is subject to the Maryland Public Information Act. This form may be made available on the Internet via MDE's website and is subject to inspection or copying, in whole or in part, by the public and other governmental agencies, if not protected by federal or State Law.



Bureau of Environmental Health  
7178 Columbia Gateway Drive, Columbia, MD 21046-2147  
Main: 410-313-2640 | Fax: 410-313-2648  
TDD 410-313-2323 | Toll Free 1-866-313-6300  
www.hchealth.org  
Facebook: www.facebook.com/hocohealth  
Twitter: HowardCoHealthDep

Maura J. Rossman, M.D., Health Officer

## DEMOLITION REQUEST FORM

(Please fill in all blanks)

### Information of Property to be Demolished:

Yough Associates, LLC

Current Owner's Name

1120 Shaffersville Rd, Mt. Airy

Property Address

21771

N/A

Subdivision (if applicable)

Lot #

Estate of:

John Lawrence Jones

All Prior Owners' Names (if requested or known)

006

Tax Map

0097

Parcel #

313526

Tax ID #

Dilapidated structure with no chance of rehab

Purpose/Reason for Demolition

Future new residence.

Future plans of property after demo (i.e. subdivision, parking lot, re-build new house, etc...)

If a subdivision, SDP#

N/A

Has the structure(s) been deemed unsafe by DILP

YES ☒ NO

### UTILITY RECORDS:

Property currently connected to public water YES ☒ NO

Property currently connected to public sewer YES ☒ NO

Does the property currently have any wells and/or septic systems ☒ YES ☐ NO

→ Explain: well and septic abandoned by Hatfield's 7/2018

\*Note: Any wells and/or septic systems that are to remain may require an approved percolation certification plan under Howard County Code Sec. 3.805

\*Note: Any septic systems that are to be abandoned must be done by a septic contractor with documentation of the process.

\*Note: All abandoned wells are to be sealed by a well driller licensed by the Maryland State Board of Well Drillers COMAR Sec 26.04.04.11 Abandonment Standards D (3)

### COMMENTS:

Joseph Link

Applicant's Name (please print)

jlink@handhrock.com

Applicant's Email

[Signature]

Applicant's Signature

443-831-0606

Applicant's Phone #

410-579-1441

Applicant's Fax #

7/19/18

Date