

APPLICATION

SEWAGE DISPOSAL TESTING

STATE OF MARYLAND - DEPARTMENT OF HEALTH AND MENTAL HYGIENE

HOWARD COUNTY HEALTH DEPARTMENT
ENVIRONMENTAL HEALTH SERVICES

P. O. BOX 473 ELLICOTT CITY, MARYLAND 21043
TELEPHONE: 992-2330

A 37514

P _____

DISTRICT _____

DATE 8/14/86

TO: THE COUNTY HEALTH OFFICER
ELLICOTT CITY, MARYLAND

I HEREBY APPLY FOR THE NECESSARY TEST IN ORDER TO CONSTRUCT (OR RECONSTRUCT) A SEWAGE DISPOSAL SYSTEM.

PROPERTY OWNER J.J.M. Partnership

ADDRESS 5570-201 Sterrett Place PHONE 740-4466
Columbia, Maryland 21045

PROPERTY LOCATION:

SUBDIVISION Chapel Woods II LOT NO. LOT 21 on prelin
20 on 2ND Prelim

ROAD AND DESCRIPTION West side of Middle Patuxent; North of Route 108

SIZE OF LOT 4.55 ac. TYPE BLDG. residential
(NUMBER OF BEDROOMS)

THE SYSTEM INSTALLED UNDER THIS APPLICATION IS ACCEPTABLE ONLY UNTIL PUBLIC FACILITIES BECOME AVAILABLE. I FULLY UNDERSTAND THE
FEE CONNECTED WITH THE FILING OF THIS PERC TEST APPLICATION IS NON-REFUNDABLE UNDER ANY CIRCUMSTANCES. I ALSO AGREE TO COMPLY
WITH ALL M.O.S.H.A. REQUIREMENTS IN TESTING THIS LOT.

APPROVED BY Richard Allen FOR John Mikolasko (SIGNATURE OF APPLICANT)
Deputy Health Officer DATE 7-29-89


REJECTED BY _____ FOR _____ DATE _____

HOLD PENDING FURTHER TESTS _____ DATE _____

REASONS FOR REJECTION OR HOLDING 9-10-86 Perc. Satisfactory, Hold for Subdivision Plat. S. Abel

THIS IS NOT A PERMIT

LOT 20

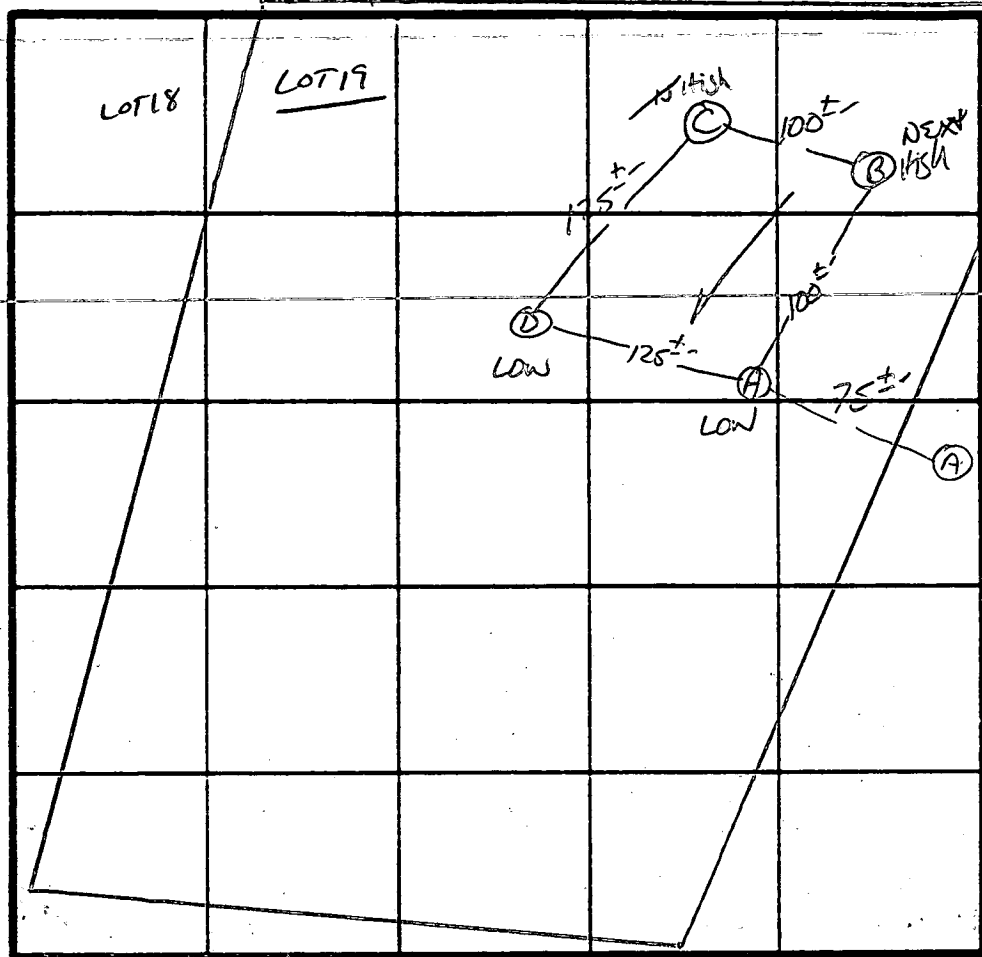

$\bar{x} = 9 \text{ MIN}$
 MLEST 4
 MAX D $6\frac{1}{2}'$

INDICATE NORTH - NAME ADJOINING ROADWAY AS BASE LINE.

(A) (B)

SOIL PROFILE

4" 0
A 1-3
RED BROWN
S. FLOAM
9-12% CLAY
100% FRAGS
1-
YELLOW BR
SAND LOAM
10-15%
FRAGMENTS
INCREASING
TO
20-25%
FRAGMENTS

12-13'

⑤ ⑥

4" AT 1-3
yellow BL
Silt LOAM 9-12%
CLAY 10-15%
FRAGS

3" yellow BL
SAND LOAM
20-25%
FRAGMENTS:
SMALL VEIN
OF ROCK
AT 4, 5 -
S. S FE
SAND Below

125

DATE	TEST NO.	DEPTH	PRE-WET		TEST - 1" DROP		TIME
			START	STOP	START	STOP	
9/10/86	A S V	3.5' 12' UNIFORM SOIL below	11:53	12:10	12:10	12:37	27min
	B S M	4' 7.5'	12:00	12:01	12:01	12:02	1min
			11:57	11:58	11:58	11:59	1min
	B V	13' UNIFORM SOIL below			35'		
	D S V	3.5' 12' UNIFORM SOIL below	12:04	12:05	12:05	12:08	3min
	C S V	3' 13' UNIFORM SOIL below	12:09	12:12	12:12	12:25	13min

REMARKS

Holes Approx to PLAT

TYPE OF SOIL

CHESTER


TESTED BY

5. Abel

ALSO PRESENT


RLO / OWNER / Developer

EM-12-1079

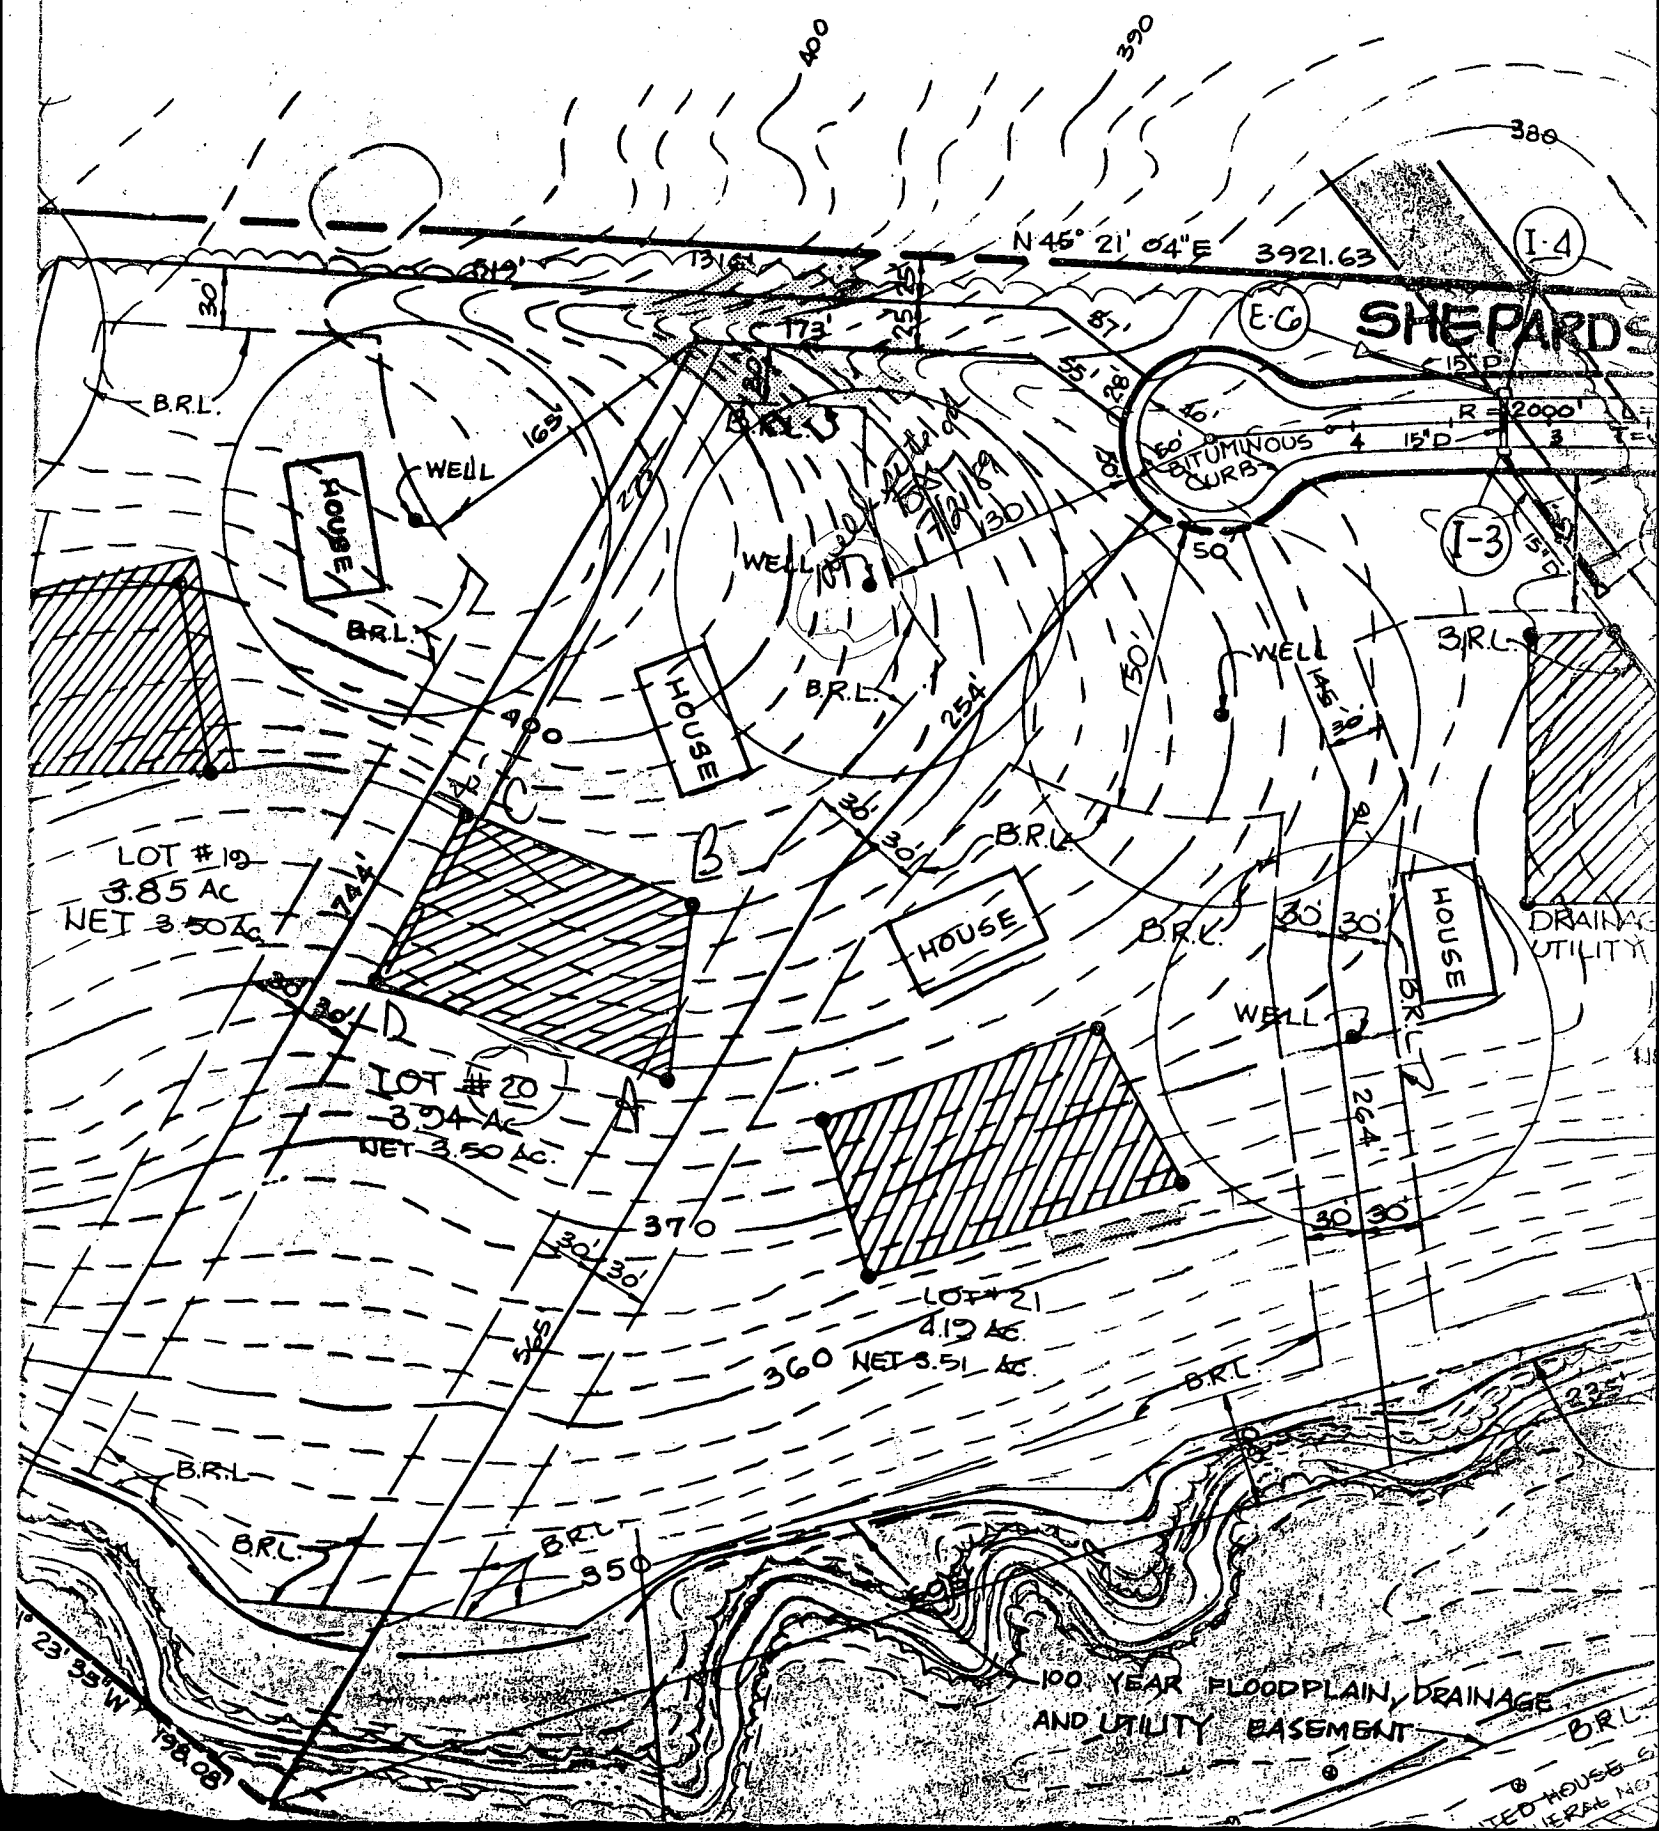

141.03'	773.00'	20° 37' 31"	251.01'	01° 25' 43"	N 70° 18' 21" W	308.03'
204.15'	423.00'	51° 15' 50"	280.63'	13° 28' 53"	S 40° 34' 42" W	84.00'
42.31'	1975.00'	02° 27' 16"	84.61'	02° 34' 04"	S 71° 54' 02" W	20.41'
11.12'	25.00'	48° 11' 23"	21.03'	22° 11' 00"	S 42° 11' 40" E	60.57'
11.18'	50.00'	27° 22' 40"	21.19'	114° 35' 30"	N 23° 42' 30" E	20.41'
43.32'	25.00'	48° 11' 23"	21.03'	22° 11' 00"	N 40° 34' 42" E	80.74'
	2026.00'	02° 27' 16"	80.75'	02° 40' 40"		

Signed Final

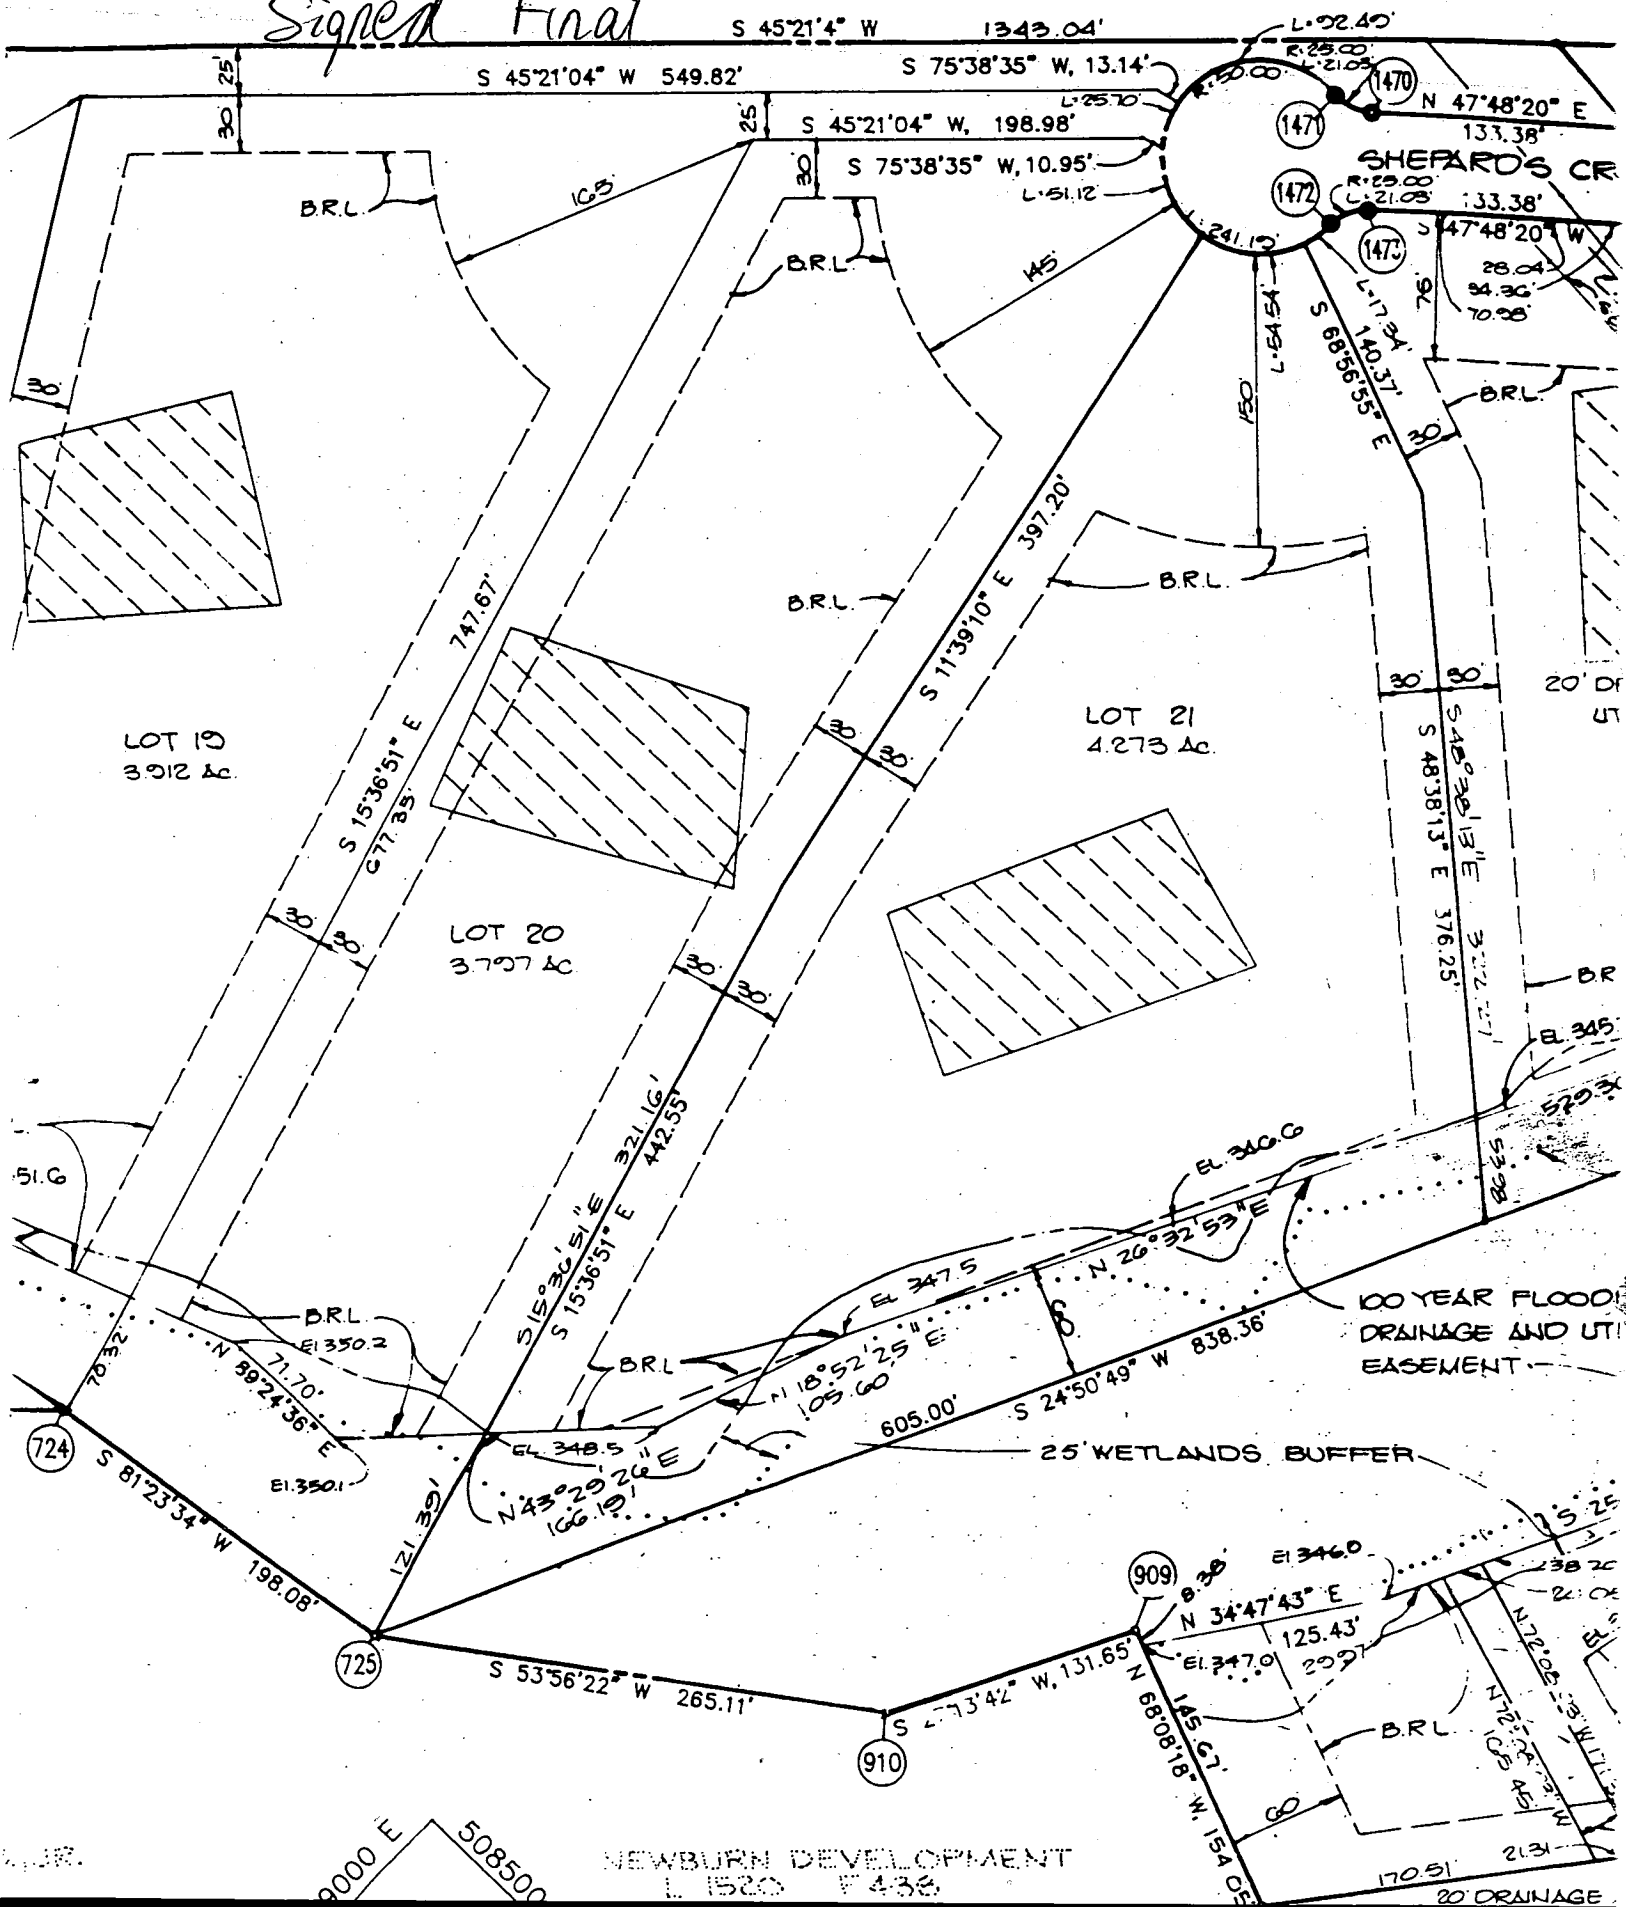

NEWBURN DEVELOPMENT
L 1520 F 438