

HOWARD COUNTY
PERMIT APPLICATION

PERMIT NUMBER

B08003183

Building Address 5205 Sheppard Ln
Clarksville Md 21029
Suite/Apt. #: _____ SDP/WP/Petition #: _____
Census Tract _____ Subdivision _____
Section _____ Area 5.79 AC Lot 13
Tax Map 29 Parcel 356 Grid 19
Zoning _____ Map Coordinates _____ Lot size 5.79 AC

Property Owner's Name David Schwartz
Address 5205 Sheppard Ln
City Clarksville State Md Zip Code 21029
Home Phone _____ Work Phone _____
Applicant's Name & Mailing Address, (if other than stated hereon): _____
Phone _____ Fax _____

Existing Use SFD
Proposed Use SFD WITH TANK
Estimated Construction Cost \$ 1000

Contractor Company Michael Webling & Mechanical
Contact Person Robert J. Michel, Sr

Description of Work
Install (1) 500 UG Propane
tank and run 1/2" lines as per
NFPA 54.58

Address 2518 Greene Rd
City Bethesda State Md Zip Code 20813
License No. 73061
Phone 404-254-116 Fax _____

Occupant or Tenant David Schwartz
Contact Name David Schwartz
Address 5205 Sheppard Ln
City Clarksville State Md Zip Code 21029
Phone _____ Fax _____

Engineer or Architect Company _____
Contact Person _____
Address _____
City _____ State _____ Zip Code _____
Phone _____ Fax _____

BUILDING DESCRIPTION - COMMERCIAL

BUILDING DESCRIPTION - RESIDENTIAL

Building Characteristics
Height: _____
No. of stories: _____
Gross area, sq. ft. per floor: _____
Use group: _____
Construction type:
☐ Reinforced Concrete
☐ Structural Steel
☐ Masonry
☐ Wood Frame
☐ State Certified Modular

Utilities
Water Supply:
☐ Public
☐ Private
Sewage Disposal:
☐ Public
☐ Private
Electric Yes ☐ No ☐
Gas Yes ☐ No ☐
Heating System:
Electric ☐ Oil ☐
Natural Gas ☐
Propane Gas ☐
Sprinkler system: N/A ☐
☐ Full
☐ Partial
☐ Other Suppression
of Heads _____

Building Characteristics
SF Dwelling ☐ SF Townhouse ☐
Depth Width
1st floor: _____
2nd floor: _____
Basement: _____
Finished Basement ☐ Unfinished Basement ☐
Crawl space ☐ Slab on Grade ☐
No. of Bedrooms: _____
Height: _____
Multi-family dwellings:
No. of efficiency units: _____
No. of 1 BR units: _____
No. of 2 BR units: _____
No. of 3 BR units: _____
Other Structure: _____
Dimensions: _____
Footings: _____
Roof Height: _____
☐ State Certified Modular
☐ Manufactured Home

Utilities
Water Supply:
☐ Public
☒ Private
Sewage Disposal:
☐ Public
☒ Private
Electric Yes ☐ No ☐
Gas Yes ☒ No ☐
Heating System:
Electric ☐ Oil ☐
Natural Gas ☐
Propane Gas ☒
Sprinkler system: N/A ☐
☐ NFPA #13D
☐ NFPA #13R
☐ Other: _____

THE UNDERSIGNED HEREBY CERTIFIES AND AGREES AS FOLLOWS: (1) THAT HE/SHE IS AUTHORIZED TO MAKE THIS APPLICATION; (2) THAT THE INFORMATION IS CORRECT; (3) THAT HE/SHE WILL COMPLY WITH ALL REGULATIONS OF HOWARD COUNTY WHICH ARE APPLICABLE HEREON; (4) THAT HE/SHE WILL PERFORM NO WORK ON THE ABOVE REFERENCED PROPERTY NOT SPECIFICALLY DESCRIBED IN THIS APPLICATION; (5) THAT HE/SHE GRANTS COUNTY OFFICIALS THE RIGHT TO ENTER AND INSPECT THE PROPERTY FOR THE PURPOSE OF INSPECTING THE WORK PERMITTED AND POSTING NOTICES.

Applicant's Signature
Michael Webling & Mechanical Repair
Title/Company

Print Name
Robert J. Michel
Date
10/3/08

Checks payable to: **DIRECTOR OF FINANCE OF HOWARD COUNTY**
** PLEASE WRITE NEATLY AND LEGIBLY. **
- FOR OFFICE USE ONLY -

AGENCY DATE SIGNATURE APPROVAL
Land Development DPZ
State Highways
Building Official
Dev. Engineering DPZ
Health 10/22/08
Fire Protection
Is Sediment Control approval required prior to issuance?
YES ☐ NO ☐

DPZ SETBACK INFORMATION
Front: _____ Filing fee \$ 110.00
Rear: _____ Permit fee \$ _____
Side: _____ Excise tax \$ _____
Side St.: _____ Add'l per. fee \$ _____
All minimum setbacks met? TOTAL FEES \$ _____
YES ☐ NO ☐ Sub-total paid \$ _____
Is Entrance Permit required? Balance due \$ _____
YES ☐ NO ☐ Check \$ _____
Validation \$ _____
Historic District? YES ☐ NO ☐
Lot Coverage for NewTown Zone _____
SDP/Red-line approval date _____ Accepted by _____


CONTINGENCY CONSTRUCTION START: ☐
ONE STOP SHOP: ☐
Distribution of Copies: White: Building Official Green: LDD, DPZ
T: Home/PERMIT.FRM

Yellow: DED, DPZ Pink: Health Gold: SHA

23:53

4184421575

ION DRAWING

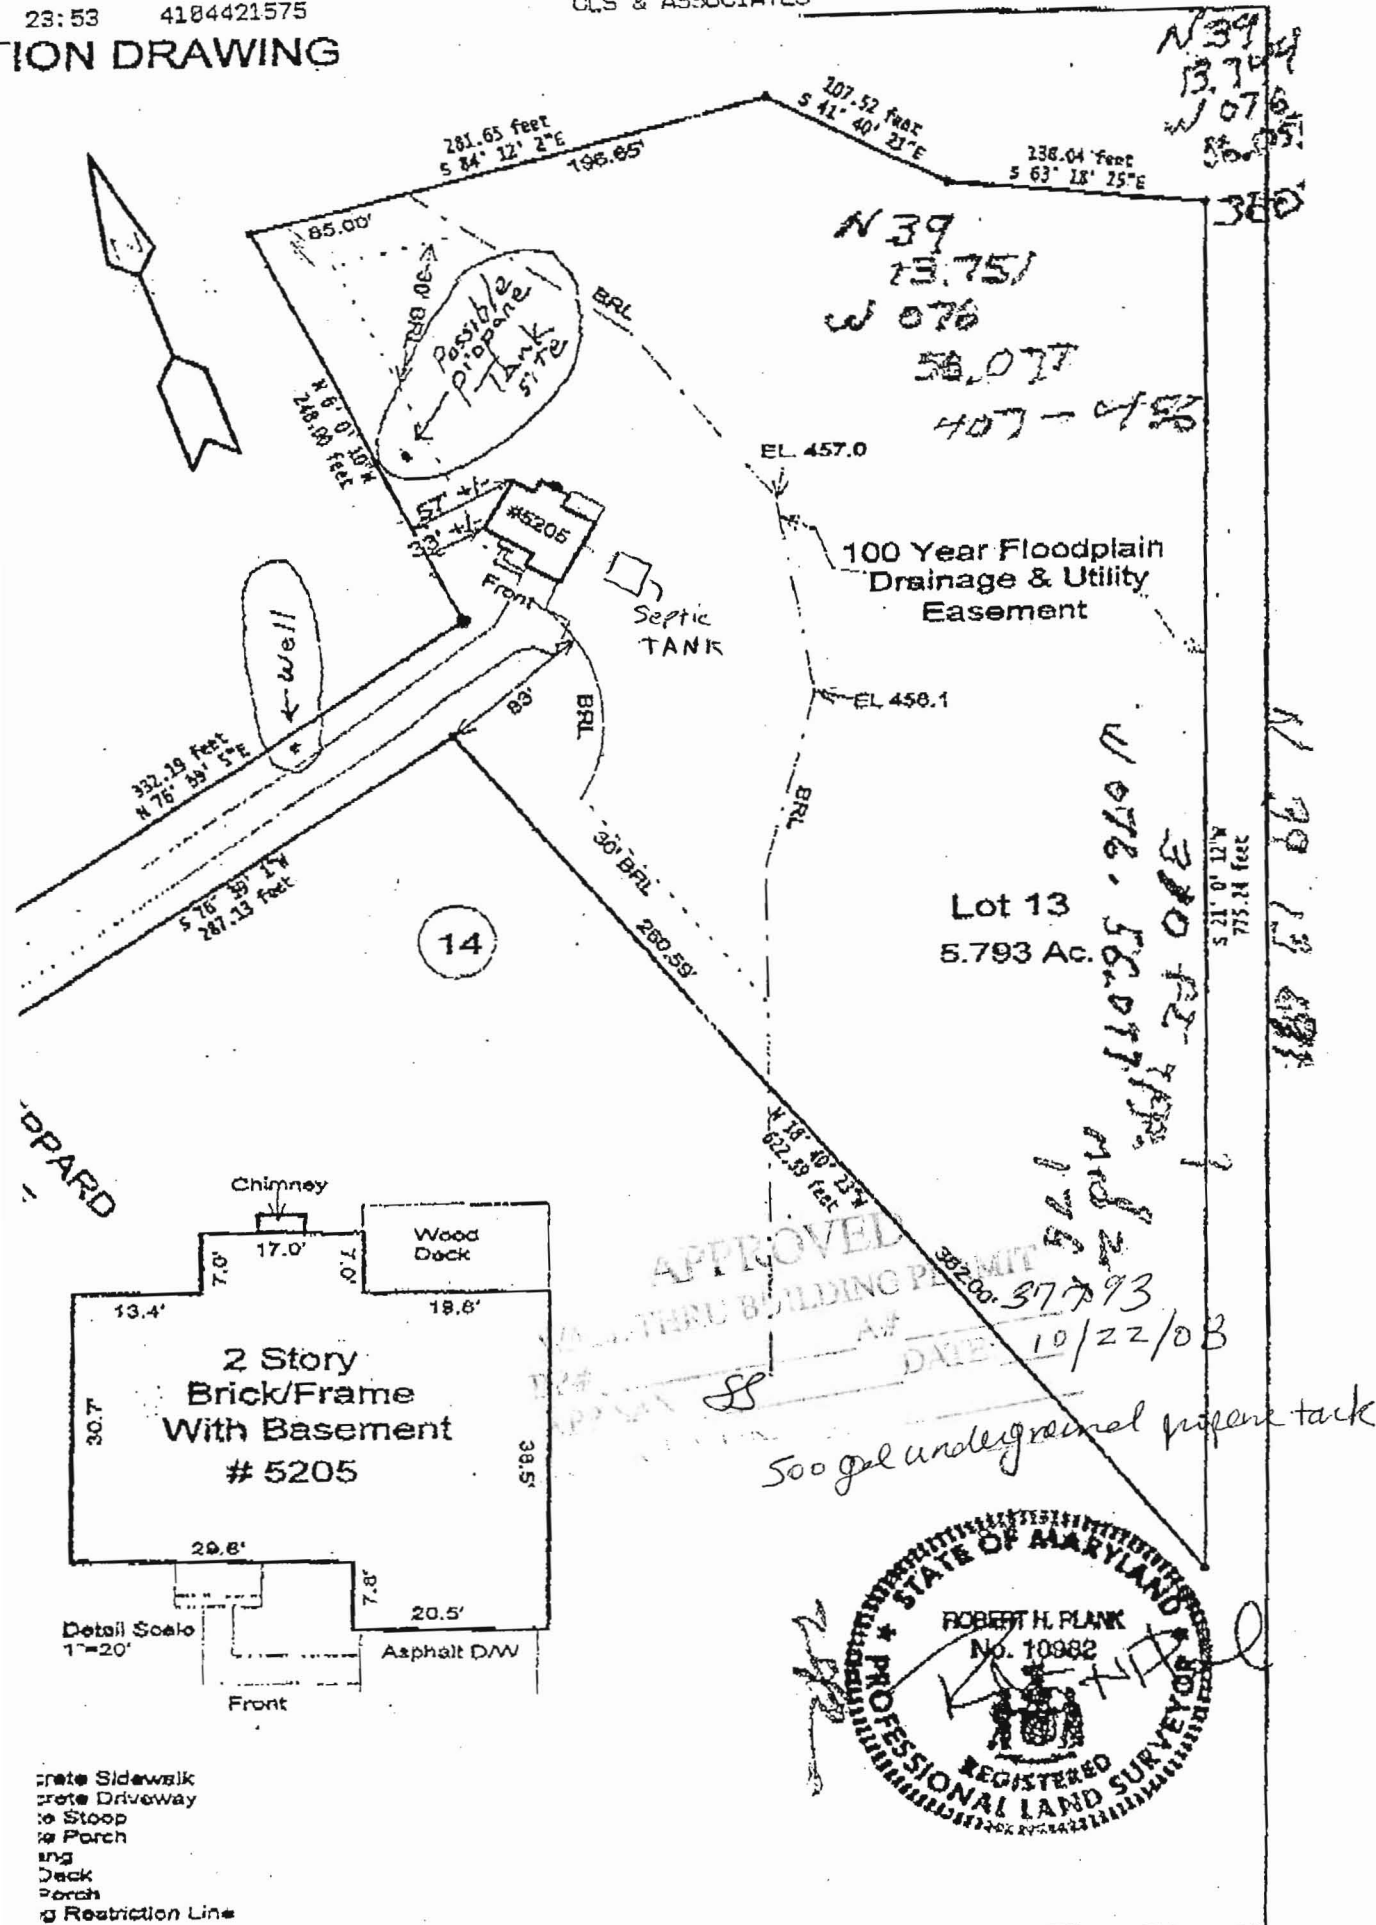

HOWARD COUNTY PERMIT APPLICATION

PERMIT NUMBER

B09002298

Building Address 5205 Sheppard La.
Clarks ville, MD 21029

Suite/Apt. #: _____ SDP/WP/Petition # _____

Census Tract 605101 Subdivision Clearview Estates

Section 1 Area _____ Lot 13

Tax Map 29 Parcel 356 Grid 19

Zoning RC Map Coordinates _____ Lot size _____

Existing Use SFD

Proposed Use SFD w/ sunroom addn. & extend deck

Estimated Construction Cost \$ 60,000

Description of Work Bld sunroom w/ cold room
beneath And ext. deck to end of sunroom

Occupant or Tenant _____

Contact Name _____

Address _____

City _____ State _____ Zip Code _____

Phone _____ Fax _____

Property Owner's Name DAVID SWARTZ

Address 5205 Sheppard La.

City Clarks ville State MD Zip Code 21029

Home Phone 410-463-8002 Work Phone _____

Applicant's Name & Mailing Address, (if other than stated hereon): _____

Phone _____ Fax _____

Contractor Company NU-Homes Inc

Contact Person Judy Filcheck

Address 10630 Little Patuxent Pkwy #146

City Columbia State MD Zip Code 21044

License No. MHBRE 311

Phone 410-730-2100 Fax 410-730-2011

Engineer or Architect Company _____

Contact Person _____

Address _____

City _____ State _____ Zip Code _____

Phone _____ Fax _____

BUILDING DESCRIPTION - COMMERCIAL

BUILDING DESCRIPTION - RESIDENTIAL

Building Characteristics

Height: _____

No. of stories: _____

Gross area, sq. ft. per floor: _____

Use group: _____

Construction type: _____

____ Reinforced Concrete

____ Structural Steel

____ Masonry

____ Wood Frame

____ State Certified Modular

Utilities

Water Supply: _____

____ Public

____ Private

Sewage Disposal: _____

____ Public

____ Private

Electric: Yes ☐ No ☐

Gas: Yes ☐ No ☐

Heating System: _____

____ Electric ☐ Oil ☐

____ Natural Gas ☐

____ Propane Gas ☐

Sprinkler system: N/A ☐

____ Full

____ Partial

____ Other Suppression

____ # of Heads

Building Characteristics

SF Dwelling ☐ SF Townhouse ☐

____ Depth _____ Width _____

1st floor: _____

2nd floor: _____

Basement: _____

Finished Basement ☐ Unfinished Basement ☐

Crawl space ☐ Slab on Grade ☐

No. of Bedrooms: _____

Height: _____

Multi-family dwellings: _____

No. of efficiency units: _____

No. of 1 BR units: _____

No. of 2 BR units: _____

No. of 3 BR units: _____

Other Structure: _____

Dimensions: _____

Footings: _____

Roof Height: _____

____ State Certified Modular

____ Manufactured Home

Utilities

Water Supply: _____

____ Public

____ Private

Sewage Disposal: _____

____ Public

____ Private

Electric: Yes ☐ No ☐

Gas: Yes ☐ No ☐

Heating System: _____

____ Electric ☐ Oil ☐

____ Natural Gas ☐

____ Propane Gas ☐

Sprinkler system: N/A ☐

____ NFPA #13D

____ NFPA #13R

____ Other: _____

THE UNDERSIGNED HEREBY CERTIFIES AND AGREES AS FOLLOWS: (1) THAT HE/SHE IS AUTHORIZED TO MAKE THIS APPLICATION; (2) THAT THE INFORMATION IS CORRECT; (3) THAT HE/SHE WILL COMPLY WITH ALL REGULATIONS OF HOWARD COUNTY WHICH ARE APPLICABLE THERETO; (4) THAT HE/SHE WILL PERFORM NO WORK ON THE ABOVE REFERENCED PROPERTY NOT SPECIFICALLY DESCRIBED IN THIS APPLICATION; (5) THAT HE/SHE GRANTS COUNTY OFFICIALS THE RIGHT TO ENTER ONTO THIS PROPERTY FOR THE PURPOSE OF INSPECTING THE WORK PERMITTED AND POSTING NOTICES.

Judy Filcheck, office mgr.

Applicant's Signature

NU-Homes, Inc

Title/Company

Judy Filcheck

Print Name

9-2-2009

Date

Checks payable to: **DIRECTOR OF FINANCE OF HOWARD COUNTY**

** PLEASE WRITE NEATLY AND LEGIBLY. **

- FOR OFFICE USE ONLY -

AGENCY DATE SIGNATURE APPROVAL

Land Development, DPZ _____

State Highways _____

Building Official _____

Dev. Engineering, DPZ _____

Health 9/2/09 Jad

Fire Protection _____

Is Sediment Control approval required prior to issuance?

YES ☐ NO ☐

CONTINGENCY CONSTRUCTION START: ☐

ONE STOP SHOP: ☐

DPZ SETBACK INFORMATION

Front: _____ Filing fee \$ _____

Rear: _____ Permit fee \$ _____

Side: _____ Excise tax \$ _____

Side St.: _____ Add'l per. fee \$ _____

All minimum setbacks met? TOTAL FEES \$ _____

YES ☐ NO ☐ Sub-total paid \$ _____

Is Entrance Permit required? Balance due \$ _____

YES ☐ NO ☐ Check # _____

Historic District? Validation # _____

YES ☐ NO ☐

Lot Coverage for NewTown Zone _____

SDP/Red-line approval date _____ Accepted by _____

Distribution of Copies-

White: Building Official

Green: LDD, DPZ

Yellow: DED, DPZ

Pink: Health

Gold: SHA

T:\home\PERMIT.FRM