

# APPLICATION

## FOR PERCOLATION TESTING AND SITE EVALUATION

TEST DATE(S) \_\_\_\_\_ TEST TIME \_\_\_\_\_

AP 555362

AGENCY REVIEW: \_\_\_\_\_

DATE 12-10-14

DO NOT WRITE ABOVE THIS LINE

I HEREBY APPLY FOR THE NECESSARY TESTING/EVALUATION PRIOR TO ISSUANCE OF SEWAGE DISPOSAL SYSTEM PERMIT(S) TO:

CHECK AS NEEDED:

- ☐ CONSTRUCT NEW SEPTIC SYSTEM(S)
- ☐ REPAIR/ADD TO AN EXISTING SEPTIC SYSTEM
- ☐ REPLACE AN EXISTING SEPTIC SYSTEM

CHECK AS NEEDED:

- ☐ NEW STRUCTURE(S)
- ☐ ADDITION TO AN EXISTING STRUCTURE
- ☐ REPLACE AN EXISTING STRUCTURE

CHECK ONE:

- ☐ CREATE NEW LOT(S)
- ☐ BUILD ON AN EXISTING LOT IN A SUBDIVISION
- ☐ BUILD ON AN EXISTING PARCEL OF RECORD

IS THE PROPERTY WITHIN 2500' OF ANY RESERVOIR?

- ☐ YES
- ☐ NO

THE TYPE OF STRUCTURE IS:

- ☐ RESIDENTIAL WITH 3 PROPOSED BEDROOMS IN THE COMPLETED STRUCTURE (NOTE UNKNOWN IF APPROPRIATE)
- ☐ COMMERCIAL (PROVIDE DETAIL OF NUMBERS AND TYPES OF EMPLOYEES/ CUSTOMERS ON ACCOMPANYING PLAN)
- ☐ INSTITUTIONAL/GOVERNMENT (PROVIDE DETAIL OF NUMBERS AND TYPES OF EMPLOYEES/USERS ON ACCOMPANYING PLAN)

PROPERTY OWNER(S) Louis P & Deborah Tringali

DAYTIME PHONE 410-442-1396 CELL \_\_\_\_\_ FAX \_\_\_\_\_

MAILING ADDRESS 11857 Ramsburg Rd Marriottsville MD 21104  
STREET CITY/TOWN STATE ZIP

APPLICANT Freedom Septic - Bruce Bopst

DAYTIME PHONE 410-795-2947 CELL 410-984-6843 FAX 410-549-1143

MAILING ADDRESS 2809 Liberty Rd Sykesville MD 21784  
STREET CITY/TOWN STATE ZIP

APPLICANT'S ROLE: DEVELOPER BUILDER BUYER RELATIVE/FRIEND REALTOR CONSULTANT

PROPERTY LOCATION

SUBDIVISION/PROPERTY NAME Henricton Heights sec 1 LOT NO. 8

PROPERTY ADDRESS 11857 Ramsburg Rd Marriottsville  
STREET TOWN/POST OFFICE

TAX MAP PAGE(S) 10 GRID 14 PARCEL(S) 0240 PROPOSED LOT SIZE 1.06 acres

AS APPLICANT, I UNDERSTAND THE FOLLOWING: THE SYSTEM INSTALLED SUBSEQUENT TO THIS APPLICATION IS ACCEPTABLE ONLY UNTIL PUBLIC SEWERAGE IS AVAILABLE. THIS APPLICATION IS COMPLETE WHEN ALL APPLICABLE FEES AND A SUITABLE SITE PLAN HAVE BEEN RECEIVED. I ACCEPT THE RESPONSIBILITY FOR COMPLIANCE WITH ALL M.O.S.H.A. AND "MISS UTILITY" REQUIREMENTS. APPROVAL IS BASED UPON SATISFACTORY REVIEW OF A PERC CERTIFICATION PLAN.

TEST RESULTS WILL BE MAILED TO APPLICANT.

Bruce Bopst  
SIGNATURE OF APPLICANT

HOWARD COUNTY HEALTH DEPARTMENT, BUREAU OF ENVIRONMENTAL HEALTH, WELL AND SEPTIC PROGRAM  
7178 COLUMBIA GATEWAY DRIVE COLUMBIA, MARYLAND 21046 (410) 313-2640 FAX (410) 313-2648  
TDD (410) 313-2323 TOLL FREE 1-877-4MD-DHMH

# Ramsburg Road

A/P 555362

(A)

1.5'-2'

Br Si Cl  
Loam

3.5'-4.5'

Red Cl  
Loam

Fine Br  
Loamy Sa

Turning

Tan Deeper  
~ 25%

Saprolite

8'

Gray

9'

Discoloration

9.5'

Water  
Seepage

10'

Water

(B)

Br Cl  
Loam

2'

Red Sa  
Cl Loam

Sa Loam


3.5'-4.5'

Red

Fine  
Loamy

Sa

5'

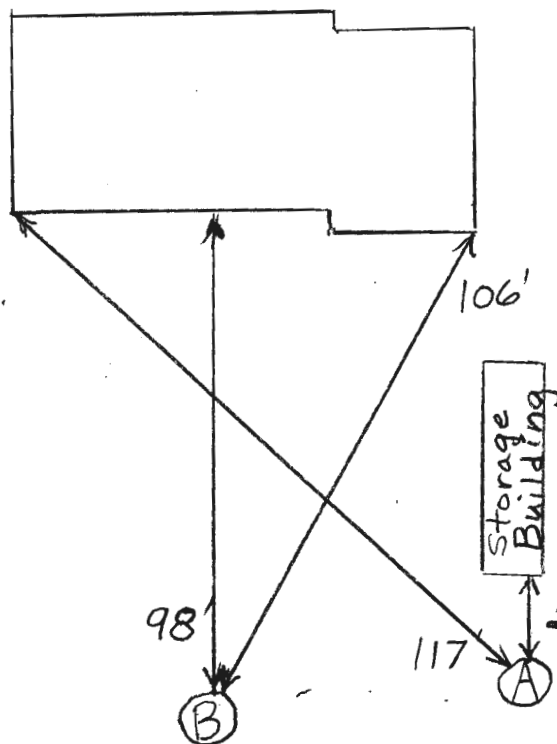

DATE	TEST #	DEPTH	START	BREAK 1" DROP	STOP 2" DROP	TIME OF 2ND INCH	P/F/H
11/7/2015	A	5'10"	11:13	11:27:30	11:52:30	25	P
	B	5.5'	12:13	12:18	12:25	7	P

REMARKS Hole A Dug Around Center of Swale  
 SANITARIAN B. Baker BACKHOE Freedom OTHERS Mr. Tringali  
 TEST HOLES USED IN SDA A+B AVG. PERC TIME <16 SQ. FT/BR  
 TRENCH WIDTH 3' INLET DEPTH 3.5' MAX. BOT DEPTH 5.5' EFFECTIVE SW 1.0+