

DEPT. OF INSPECTIONS, LICENSES AND PERMITS 3430 COURT HOUSE DRIVE ELLICOTT CITY, MD 21043 PERMITS (410) 313-2455 INSPECTIONS (410) 313-1810 AUTOMATED INFORMATION (410) 313-3800		HOWARD COUNTY PERMIT APPLICATION		PERMIT NUMBER B10001017	
Building Address 12673 Suggswell Rd Hagerstown Md 20777			Property Owner's Name Connie Kolpach		
Suite/Apt. #: SDP/WP/Petition #:			Address 12673 Suggswell Rd Hagerstown		
Census Tract Subdivision			City Hagerstown State MD Zip Code 20777		
Section Area Lot			Home Phone 301-318-5739 Work Phone 410		
Tax Map Parcel Grid			Applicant's Name & Mailing Address, (if other than stated herein):		
Zoning Map Coordinates Lot Size			Richard M. Kolpach & Son		
Existing Use S/F Family home			5731 Elmdale Rd Elmdale		
Proposed Use S/F Family home w/ detached garage			MD		
Estimated Construction Cost \$ 33,000			Phone Fax		
Description of Work 30' x 24' 1 story single			Contractor Company Richard M. Kolpach		
30' concrete porch 12' thick w/ 4" rebar			Contact Person Dick		
30' concrete porch 12' thick w/ 4" rebar			Address 5731 Elmdale Rd Elmdale		
30' concrete porch 12' thick w/ 4" rebar			City Elmdale State MD Zip Code 20777		
30' concrete porch 12' thick w/ 4" rebar			License No. 41888		
30' concrete porch 12' thick w/ 4" rebar			Phone 410-743-0769 Fax		
Occupant or Tenant Connie Kolpach			Engineer or Architect Company		
Contact Name Richard M. Kolpach & Son			Contact Person		
Address 12673 Suggswell Rd			Address		
City Hagerstown State MD Zip Code 20777			City State Zip Code		
Phone 301-318-5739 Fax 410			Phone Fax		

BUILDING DESCRIPTION - COMMERCIAL				BUILDING DESCRIPTION - RESIDENTIAL			
Building Characteristics		Utilities		Building Characteristics		Utilities	
Height:		Water Supply:		SF Dwelling ☐ SF Townhouse ☐		Water Supply:	
No. of stories: 2		☐ Public		Depth Width		☐ Public	
Gross area, sq. ft. per floor:		☐ Private		1st floor:		☒ Private	
Use group:		Sewage Disposal:		2nd floor:		Sewage Disposal:	
Construction type:		☐ Public		Basement:		☐ Public	
☐ Reinforced Concrete		☐ Private		Finished Basement ☐ Unfinished Basement ☐ Crawl space ☐ Slab on Grade ☐		☒ Private	
☐ Structural Steel		Electric Yes ☐ No ☐		No. of Bedrooms		Electric Yes ☒ No ☐	
☐ Masonry		Gas Yes ☐ No ☐		Multi-family dwellings:		Gas Yes ☐ No ☐	
☐ Wood Frame		Heating System:		No. of efficiency units:		Heating System:	
☐ State Certified Modular		Electric ☐ Oil ☐		No. of 1 BR units:		Electric ☒ Oil ☐	
		Natural Gas ☐		No. of 2 BR units:		Natural Gas ☐	
		Propane Gas ☐		No. of 3 BR units:		Propane Gas ☐	
		Sprinkler system: N/A ☐		Other Structure:		Sprinkler system: N/A ☐	
		☐ Full		Dimensions:		☐ NFPA #13D	
		☐ Partial		Footings:		☐ NFPA #13R	
		☐ Other Suppression		Roof:		☐ Other:	
		☐ # of Heads		☐ State Certified Modular			
				☐ Manufactured Home			

THE UNDERSIGNED HEREBY CERTIFIES AND AGREES AS FOLLOWS: (1) THAT HE/SHE IS AUTHORIZED TO MAKE THIS APPLICATION; (2) THAT THE INFORMATION IS CORRECT; (3) THAT HE/SHE WILL COMPLY WITH ALL REGULATIONS OF HOWARD COUNTY WHICH ARE APPLICABLE THERETO; (4) THAT HE/SHE WILL PERFORM NO WORK ON THE ABOVE REFERENCED PROPERTY NOT SPECIFICALLY DESCRIBED IN THIS APPLICATION; (5) THAT HE/SHE GRANTS COUNTY OFFICIALS THE RIGHT TO ENTER ONTO THIS PROPERTY FOR THE PURPOSE OF INSPECTING THE WORK PERMITTED AND POSTING NOTICES.

Applicant's Signature	Print Name
Email Address	Date
	4/15/10
Title/Company	

Checks payable to: DIRECTOR OF FINANCE OF HOWARD COUNTY
PLEASE WRITE NEATLY AND LEGIBLY.
- FOR OFFICE USE ONLY -

AGENCY	DATE	SIGNATURE APPROVAL	DPZ SETBACK INFORMATION	PROPERTY ID #
Land Development, DPZ			Front:	\$ 25.00
State Highways			Rear:	\$
Building Officials			Side:	\$
Dev. Engineering, DPZ			Side St.:	\$
Health	5-12-10	DBernard	All minimum setbacks met?	TOTAL FEES \$
Fire Protection			YES ☐ NO ☐	Sub-total paid \$
Is Sediment Control approval required prior to issuance?			Is Entrance Permit Required?	Balance due \$
YES ☐ NO ☐			YES ☐ NO ☐	Check # 116
			Historic District?	Validation #
			YES ☐ NO ☐	
			Lot Coverage for New Town Zone	Accepted by
			SDP/Red-line approval date	
CONTINGENCY CONSTRUCTION START: ☐				
ONE STOP SHOP: ☐				

SITE INSPECTION SHEET

OWNER: Connie Kolpack

DATE REQUESTED: 8/31/99 11:00

ADDRESS: 12672 Route 216
Highland, MD


DRILLER: Joseph Mayne

WELL TAG #

(Tract 40 Parcel 19 Gd 11 lot 4) COUNTY # No record found

PROPOSAL: existing spring has run dry - approval of repl.
well site requested

LOCATION DIAGRAM

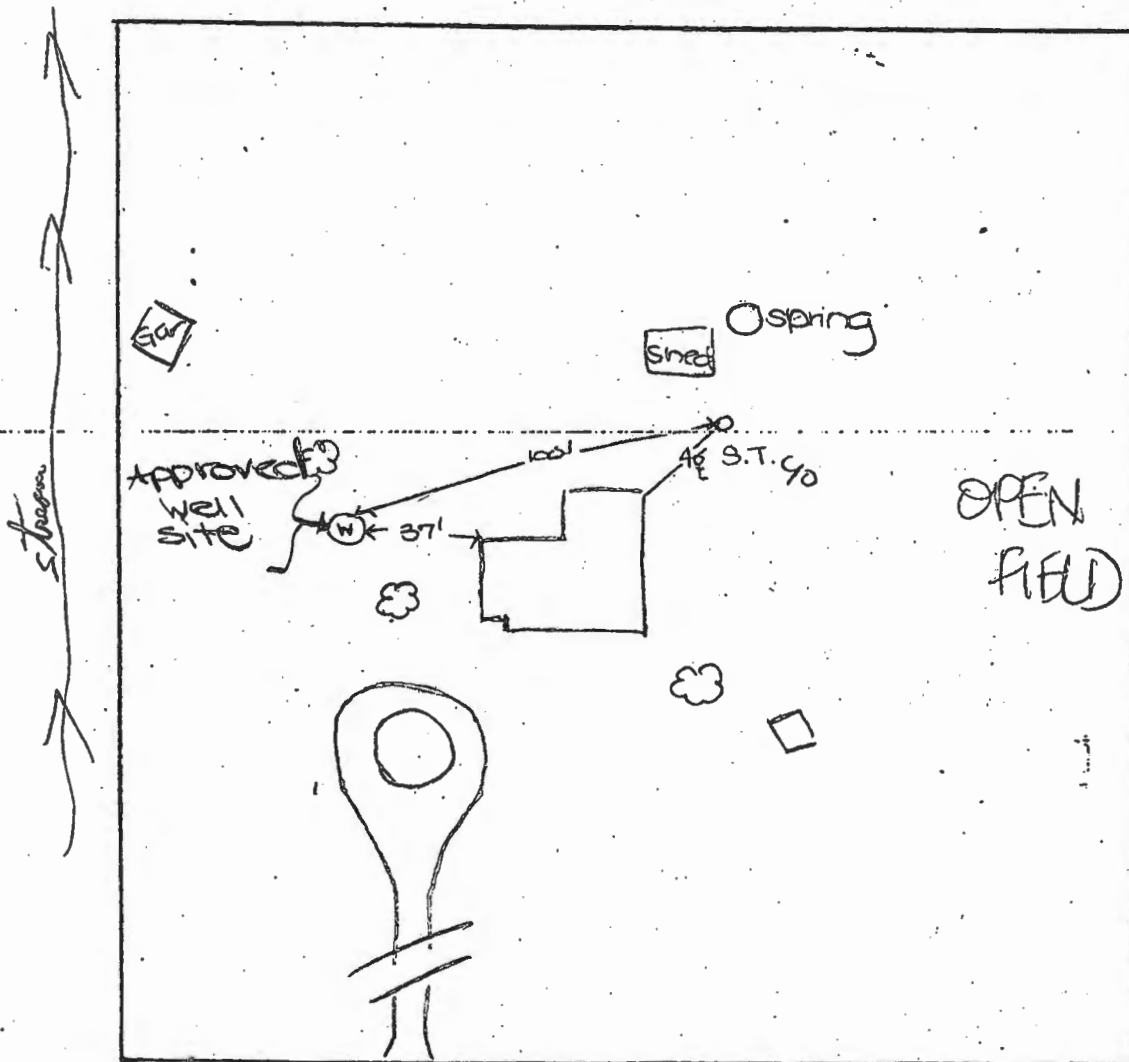


COMMENTS: Met driller and owner at site. Approved well
site as indicated - spring to be abandoned/disconn.
from drinking supply. Well drilled as proposed, has 2 piece cap. No brat test 9/2/99

station

NO

12672 Scaggswell RD,
HIGHLAND MD 20777
Conni Kolpack

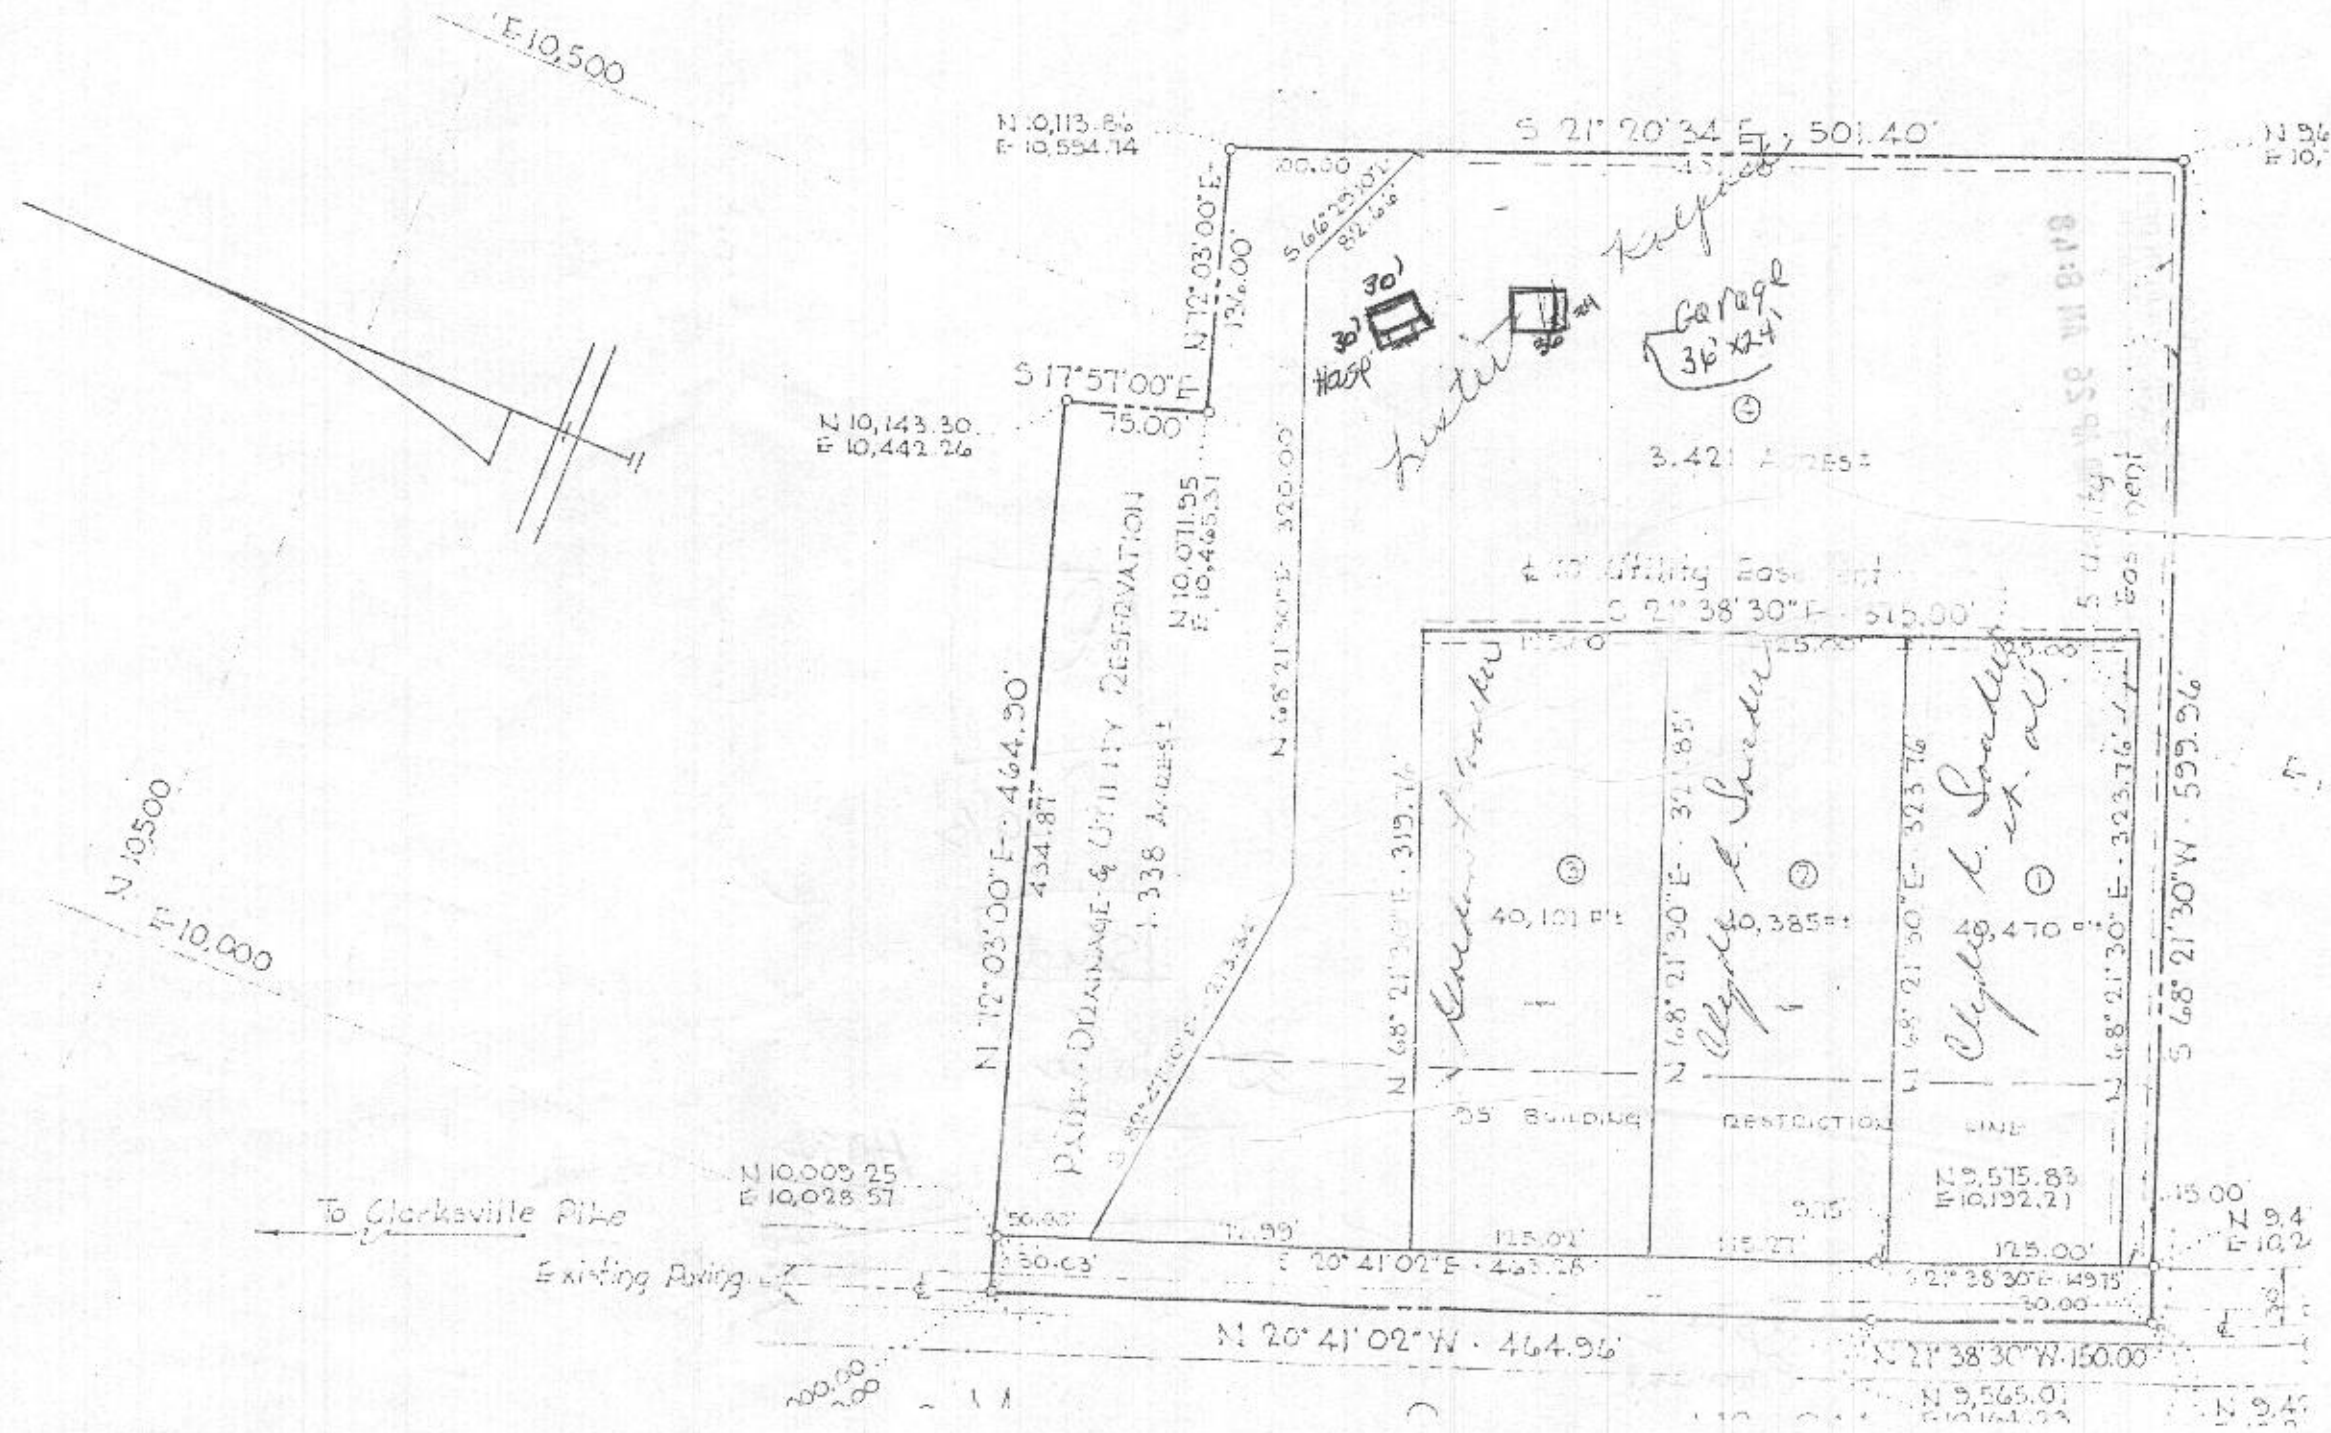

RECEIVED
HOWARD COUNTY HEALTH DEPT.
ENVIRONMENTAL HEALTH

2010 APR 26 AM 8:48

