

PUBLIC SEWER STATUS VERIFIED BY

ISSUE DATE: 3/2/11

APPROVAL DATE: 3/3/11

PERMIT

P 534480

A REPAIR

Septic Repair ON-SITE SEWAGE DISPOSAL SYSTEM HOWARD COUNTY HEALTH DEPARTMENT BUREAU OF ENVIRONMENTAL HEALTH

J.M. Contracting, LLC

IS PERMITTED TO INSTALL ☐ ALTER ☒

ADDRESS: 425 Obrecht Road, Sykesville, MD 21784 PHONE NUMBER: 443-277-7526

SUBDIVISION: Wayside Estates LOT NUMBER: 2

ADDRESS: 3584 Scheel Drive PROPERTY OWNER: William G. Berg

SEPTIC TANK CAPACITY (GALLONS): N/A

PUMP CHAMBER CAPACITY (GALLONS): —

NUMBER OF BEDROOMS: 4

SQUARE FEET OF HOUSE: —

LINEAR FEET OF TRENCH REQUIRED: 140LF

TRENCHES:	<u>2' wide Inlet 4' below grade. Bottom @ 9'. Eff line starts @ 6'.</u>
LOCATION:	<u>Trenches to start just below garden area. Install 2x70' trenches on contour.</u>
PURPOSE:	<u>Ex. Trenches to be abandoned. obs. pipe required on ends of trenches. clean stone only!!</u>

PLANS APPROVED: K. Wolf DATE: 3/2/11

NOTE: PERMIT VOID AFTER 2 YEARS

NOTE: CONTRACTOR RESPONSIBLE FOR SCHEDULING A PRE-CONSTRUCTION INSPECTION FOR ALL INSTALLATIONS

NOTE: WATERTIGHT SEPTIC TANKS REQUIRED


NOTE: ALL PARTS OF SEPTIC SYSTEM SHALL BE 100 FEET FROM ANY WATER WELL

NOTE: MANHOLE RISERS REQUIRED ON ALL SEPTIC TANKS AND PUMP CHAMBERS

NOTE: AN ELECTRICAL PERMIT IS REQUIRED FOR INSTALLATION OF ANY ELECTRICAL COMPONENTS OF THE SYSTEM

NEITHER THE HOWARD COUNTY COUNCIL OR THE HEALTH DEPARTMENT IS
RESPONSIBLE FOR THE SUCCESSFUL OPERATION OF ANY SYSTEM
PERMITTEE RESPONSIBLE FOR OBTAINING FINAL APPROVAL ON THIS PERMIT
CALL 410-313-1771 FOR INSPECTION OF SEPTIC SYSTEM

NOT TO SCALE

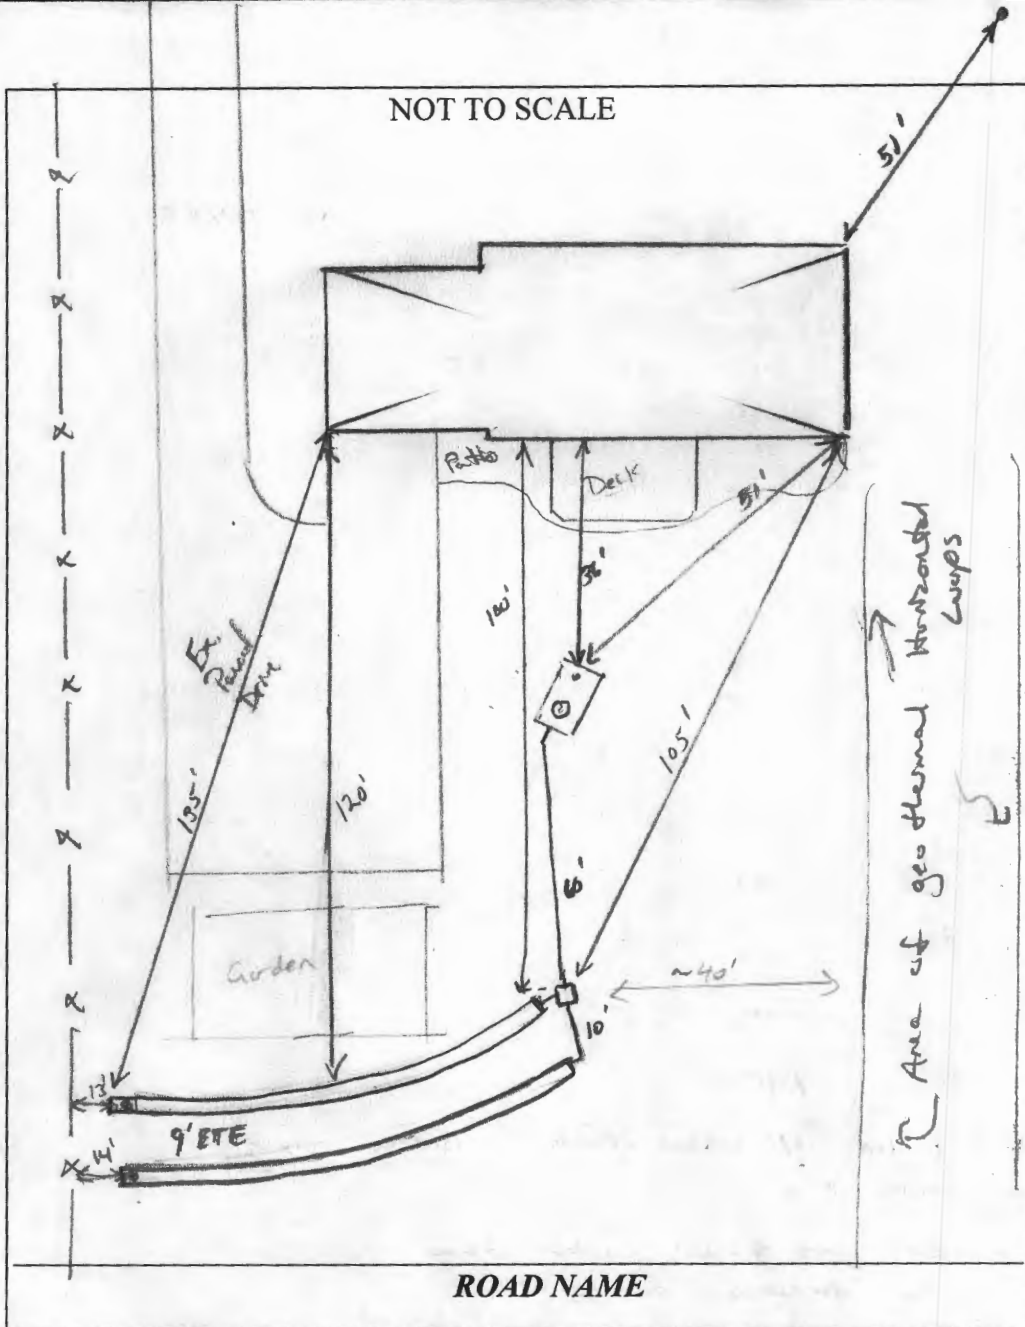

TRENCH/DRAINFIELD DATA

WIDTH	INLET	BOTTOM
2'	4'	9'
NUMBER OF TRENCHES _____		
TOTAL LENGTH _____		
ABSORPTION AREA _____		
DISTRIBUTION BOX LEVEL <u>Level's</u>		
DISTRIBUTION BOX BAFFLE <u>Yes</u>		
DISTRIBUTION BOX PORT <u>No</u>		

SEPTIC TANK DATA

SEPTIC TANK 1 LEVEL Ex.

MANUFACTURER _____

CAPACITY 1250 ? GAL

SEAM LOC Mid

TANK LID DEPTH 2'

BAFFLES Yes - New outlet.

BAFFLE FILTER _____

MANHOLE LOC Rear

6" PORT LOC none

WATERTIGHT TEST _____

SLOTTED no

DATE ON LID _____

PUMP/SEPTIC TANK LEVEL N/A

MANUFACTURER _____

CAPACITY _____ GAL

SEAM LOC _____

TANK LID DEPTH _____

BAFFLES _____

BAFFLE FILTER _____

MANHOLE LOC _____

6" PORT LOC _____

WATERTIGHT TEST _____

SLOTTED _____

DATE ON LID _____

PRE-CONSTRUCTION:

3/2/11 Contractor to install 2x 70' trenches on contour as pointed out in field just above perc test hole (A). Follow trencher spec's on permit.

3/2/11 (pm) New outlet baffle installed on tank. 60' of new sch 40 installed up to D box. No trenches started. (pm)

INSTALLATION: 3/3/11 Trenches complete. Stone from Savage, looks OK. somewhat dirty, clay and fines mixed in, but should be OK. D box leveled. OK to backfill all work.

FINAL INSPECTOR

J. Way

DATE OF APPROVAL

3/3/11



HOWARD COUNTY HEALTH DEPARTMENT

34480

DATE

2 / 23 / 2011

repair

Received
From

William G. Berg-

PHONE # 443-277-7526

(J.M. Contracting LLC.) - 425 Obrecht Rd.

For

Septic Repair & PERC - (2) \$165.00.

3584 Scheel Dr. - Elliott City, MD 21042

☐ CASH

☒ CHECK

NO.

1361

three hundred and thirty dollars

**

Dollars

\$

330

00

Received By

Antonia Hys