

Per/Repair

Bureau of Environmental Health

8930 Stanford Boulevard, Columbia, MD 21045

Main: 410-313-2640 | Fax: 410-313-2648

TDD 410-313-2323 | Toll Free 1-866-313-6300

www.hchealth.org

Facebook: www.facebook.com/hocohealth

Twitter: HowardCoHealthDep

Dr. Maura J. Rossman, M.D., Health Officer

A/R 546352

INFORMATION FORM - SEPTIC SYSTEM REPAIR/UPGRADE

Reason for Request:

- ☒ Failing System
☐ System relocation for proposed addition
☐ System upgrade for proposed addition
☐ Inadequate treatment zone
☐ Collapsed septic tank
☐ Collapsed drywell

Has the septic tank been pumped within the last month?

- ☒ Yes Date pumped: 4/30/14
☐ No

Was a visual inspection of the septic tank and/or drain fields conducted?

- ☒ Yes Explain observations: TANK OVERFILL
☐ No Flowing back into tank after
pumping

Was a visual inspection of the sewage line conducted?

- ☒ Yes
Blockage leading to the tank
☐ Yes Explain: _____
☒ No
Blockage leading to the field
☐ Yes Explain: _____
☒ No

Existing system design

- ☒ Drywell
☐ Trench
☐ Mound
☐ Unknown
☐ Other: _____

Is discharge surfacing on the ground?

- ☐ Yes
☐ No

Additional Comments: failing

*For REPAIRS, are the owners proposing, or do they plan to add in the future, any additions or modifications to the property, i.e. pools, living space additions, garages, etc? This information must be disclosed at the time of this application. The Health Department will not be able to accommodate requests in the field for property modifications unrelated to the repair request. Such requests may require an additional fee, testing, and submittal of a Percolation Certification Plan, if the property does not meet current Code and Regulation.

Septic Contractor: Fogles #64 Contractor's Phone: 410-795-5670

Contractor's Address: 580 OBRECHT RD. Sykesville MD 21784

Property Address: 11865 Ramsburg Rd County file: _____

Subdivision: Henryton Heights Lot: 10 Year Built: 1976

Owner's Name: Joe Dicarrio Owner's Phone: 410-442-1741

Name of previous owners: _____ Existing bedrooms: 3

Proposed bedrooms: _____

Has this request been previously discussed with a Sanitarian? (Name): NO

Public Sewer available/nearby: NO

*A Sanitarian will be in contact within three business days, depending upon the urgency of the situation, to coordinate the scheduling/review of the repair or upgrade.

Prior to scheduling inspections, scaled plans should be submitted to clarify the nature of the addition.

Print out a copy of Real Property Data via Dept. of Taxation website _____ Indexed file found _____

If public sewer may be nearby, verify whether sewer is technically "available" through the Bureau of Engineering.

If sewer is available and the property is within the Metropolitan District, connection to sewer is required. If the owner believes reason for exemption exists, the owner should justify the request in writing.


If soil/site conditions are limited and sewer and/or Metro District status is not conducive to connection, the Sanitarian may recommend pursuit of Emergency Sewer Extension or Emergency Metro District Inclusion. The Owner should contact the Bureau of Utilities for details.

No permit is to be issued nor inspection to be scheduled without prior fee collection at the office unless an emergency situation exists.

The contractor is to notify office of the emergency situation as soon as possible.

99 → Henryton → Ramsburg Rd.

map 10
Grid 14
Parcel 263
1.08 Acres

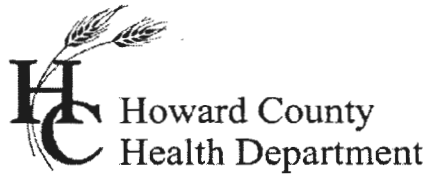

Bureau of Environmental Health
7178 Gateway Drive Columbia, MD 21046
(410) 313-2640 Fax (410) 313-2648
TDD (410) 313-2323 Toll Free 1-866-313-6300
website: www.hchealth.org

Maura J. Rossman, M.D., Health Officer

RECEIPT DATE: 5/8/2014
INSTALLATION
APPROVAL
DATE: 5/30/14

ONSITE SEWAGE DISPOSAL SYSTEM

P 546352

PERMIT

A Repair

REPAIR

PROPERTY ADDRESS: 11865 Ramsburg Road
SUBDIVISION: Henyton Heights LOT: 10 TAX ID: 03-302644
CONTRACTOR: Fogle's Septic Clean Inc. EMAIL: kurt@foglesinc.com
CONTRACTOR ADDRESS: 580 Obrecht Road, Sykesville, MD 21784 PHONE: 410-795-5670
PROPERTY OWNER: Joe Dicarlo EMAIL: _____
OWNER ADDRESS: 11865 Ramsburg Road, Marriottsville, MD 21104 PHONE: 410-442-1742

SEPTIC TANK SIZE (GALLONS): Existing
PUMP CHAMBER CAPACITY (GALLONS): N/a (future) STATIC HEAD (FEET): N/a
NUMBER OF BEDROOMS: 3 ✓ HOUSE SQ. FT. N/a APPLICATION RATE: 0.8
DISTRIBUTION SYSTEM: GRAVITY FED ☒ LOW PRESSURE DOSED ☐ ~70 ton #2 stone

TRENCHES:	LINEAR FEET REQUIRED:	<u>100'</u>	INLET DEPTH:	<u>4'</u>
	TRENCH WIDTH:	<u>2'</u>	MAXIMUM BOTTOM DEPTH:	<u>10'</u>
	MINIMUM SPACE BETWEEN TRENCHES:		EFFECTIVE AREA BEGINNING DEPTH:	<u>~6'</u>
LOCATION:	<u>Install 2 x 50' trenches approx. 40' or so out from existing S.T.</u>			
NOTES:	<u>Existing Dry well to be pumped out and collapsed. obs. pipes rigid in trenches. Manhole riser to be added on ex. S.T.</u>			

ISSUED BY: K. Wolf, RENS ISSUE DATE: 5-28-14 EXPIRATION DATE: 5/28/15

- NOTE: CONTRACTOR MUST SCHEDULE A PRE-CONSTRUCTION INSPECTION PRIOR TO BEGINNING ANY INSTALLATION
NOTE: CONTRACTOR MUST SCHEDULE AN INSPECTION AND GAIN APPROVAL OF ALL COMPONENTS PRIOR TO COVERING
NOTE: STONE MUST BE APPROVED BY HEALTH DEPARTMENT AND GRAVEL TICKET MUST BE AVAILABLE FOR REVIEW.
NOTE: WATERTIGHT SEPTIC TANKS REQUIRED
NOTE: ALL PARTS OF SEPTIC SYSTEM SHALL BE AT LEAST 100 FEET DOWNGRADIENT FROM ANY WATER WELL
NOTE: MANHOLE RISERS REQUIRED ON ALL SEPTIC TANKS AND PUMP CHAMBERS
NOTE: AN ELECTRICAL PERMIT IS REQUIRED FOR INSTALLATION OF ANY ELECTRICAL COMPONENTS OF THE SYSTEM

NEITHER THE HOWARD COUNTY COUNCIL NOR THE HEALTH DEPARTMENT IS RESPONSIBLE FOR THE SUCCESSFUL OPERATION OF ANY SYSTEM.


PERMITTEE RESPONSIBLE FOR OBTAINING FINAL APPROVAL ON THIS PERMIT.

CALL 410-313-1771 TO SCHEDULE INSPECTIONS.

NOT TO SCALE

Public H₂O

No Existing Walls

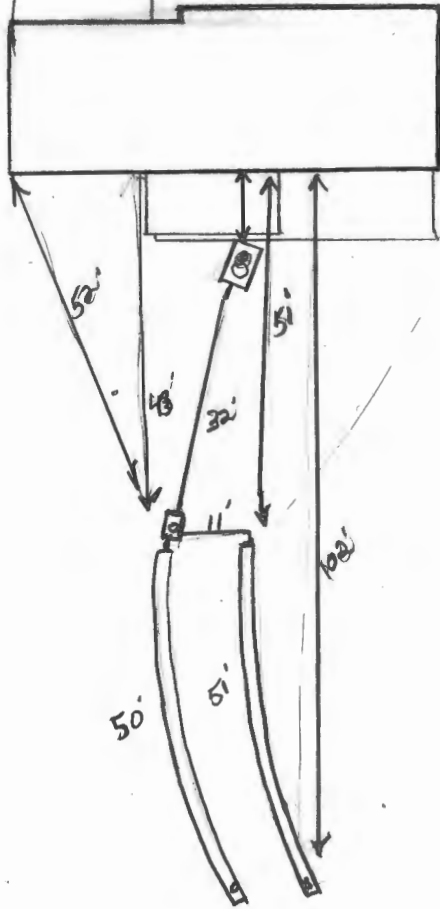

TRENCH/DRAINFIELD DATA

WIDTH	INLET	BOTTOM
2'	4'	10'
NUMBER OF TRENCHES		2
TOTAL LENGTH		100'
ABSORPTION AREA		200' x 5W
DISTRIBUTION BOX LEVEL		Leveler's
DISTRIBUTION BOX BAFFLE		Yes
DISTRIBUTION BOX PORT		Yes

SEPTIC TANK DATA

SEPTIC TANK 1 LEVEL	OK
MANUFACTURER	?
CAPACITY	1000 GAL
SEAM LOC	mid
TANK LID DEPTH	12" = 18"
BAFFLES	New outlet
BAFFLE FILTER	-
MANHOLE LOC	Center
6" PORT LOC	Front
WATERTIGHT TEST	OK
SLOTTED	no
DATE ON LID	-

PUMP/SEPTIC TANK LEVEL

MANUFACTURER	
CAPACITY	GAL
SEAM LOC	
TANK LID DEPTH	
BAFFLES	
BAFFLE FILTER	
MANHOLE LOC	
6" PORT LOC	
WATERTIGHT TEST	
SLOTTED	
DATE ON LID	

PRE-CONSTRUCTION:

5/28/14 Install 2 x 50' trenches approximately 40' out from existing S.T. New sch 40 plumbing to be installed. Existing P.W. to be pumped / 10' deep. Call for inspection (Kai)

INSTALLATION:

5/29/14 Lower trench almost complete. Told contractor to stop working when trench is complete. Heavy rain forcing muddy/clay water into trenches. D box set and tied in. (Kai) 5/30/14 Ex Drywell pumped each collapsed. New outlet baffle installed on S.T. Trenches complete. OK to cover all work.

FINAL INSPECTOR

K. Wolf

DATE OF APPROVAL

5/30/14

WOODLINE

400'
TO
PROP
LINE

