



HOWARD COUNTY HEALTH DEPARTMENT

46372

CODES

DATE

5/22/14

A5

☐ CASH

☒ CHECK

NO.

459100

Received
From

For

Fogles Septic Clean
Pore / Kopein - 14621

Three hundred thirty ~~four~~ thirty four Dollars RD.

\$ 330.00

Received By

King

ASP A546372


(A)

Fill

1'-1.5' Fairly Dense Br Loam
 4'-4.5' Fairly Dense Sa Cl Loam
 5'-5.5' Dense Red Sa Cl Loam + Beige
 6' Loamy Sa
 6' Moderately Dense Fine Beige Loamy Sa 5-15%
 16' Rock

O.B.
 (Cl Loam)

6'-6.5' Fine Loamy Sa Beige ~5% ~15% Rock - Saprolite

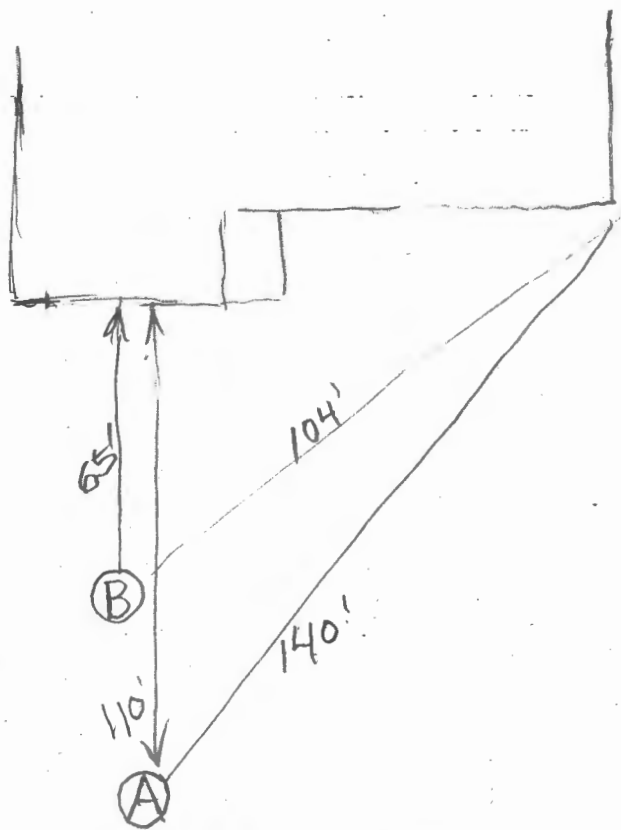

(B)

Moderately Dense Or B. Cl Loam ~4'
 Moderately Dense Red Br Sa Cl Loam 5'-5.5'
 Dense Very Fine Sa Loam
 Moderately Dense Loamy Sa 5-10% Rock

DATE	TEST #	DEPTH	START	BREAK 1" DROP	STOP 2" DROP	TIME OF 2ND INCH	P/F/H
6/17/14	A	7'16" V	11:31:30	11:37:30	11:44	6 1/2	P
	B	9' V					

REMARKS _____
 SANITARIAN _____ BACKHOE _____ OTHERS _____
 TEST HOLES USED IN SDA _____ AVG. PERC TIME _____ SQ. FT/BR _____
 TRENCH WIDTH 2' INLET DEPTH 5' MAX. BOT DEPTH 11' EFFECTIVE SAW 4'

MORE
ACREAGE -
UPHILL GRADE

↑ ↑ ↑ ↑
GRAD. ~~UPHILL~~ SLOPE
UPHILL

14621 Roxbury Rd
GLENELG MD

EVERGREEN
TREE

SEPTIC
TANK

30'
FAILING
Drywell

50'

Roxbury Rd