

Bureau of Environmental Health

8930 Stanford Boulevard, Columbia, MD 21045

Main: 410-313-2640 | Fax: 410-313-2648

TDD 410-313-2323 | Toll Free 1-866-313-6300

www.hchealth.org

Facebook: www.facebook.com/hocohealth

Twitter: HowardCoHealthDep

Maura J. Rossman, M.D., Health Officer

September 11, 2020

Gary and Jennie Rudacille
3600 Scheel Drive
Ellicott City, MD 21042

RE: Waiver Approval
3600 Scheel Drive
Ellicott City, MD 21042

Mr. and Mrs. Rudacille,

This letter is being issued in response to your waiver request dated August 28, 2020. Your request for a waiver of the Howard County Code requirement for a percolation certification plan has been **approved**. The proposed ten (10) by fifteen (15) foot addition will have little to no impact on the area available for future on-site sewage disposal system repair area. Any deviations from the proposed work illustrated on the site plan submitted with the waiver request will be subject to further review by this department.

Any questions regarding this decision may be directed to the Well and Septic Program of the Howard County Health Department.

Respectfully,

Michael J. Davis
Assistant Director
Bureau of Environmental Health

August 28, 2020


Department of Environmental Health
Ascend One Building
8930 Stanford Boulevard
Columbia, Maryland 21045

9/11/2020
Approved
Michael J. Davis

Attn.: Mike Davis, Deputy Director

We've been living in our house at 3600 Scheel Drive for 40 years, and we're hoping to stay there as long as we can. To make things a little easier on us we would like to move our washer, dryer, and laundry tub into a separate mud room. In doing so we would not put any extra strain or increase the load on our well or septic system. Knowing this we are requesting a waiver for percolation certification plan requirement. If any more information is needed, please do not hesitate to call. Thank you in advance for your consideration concerning our plans.

Larry + Jennie Rudasille
3600 Scheel Drive
Ellicott City, Maryland 21042
410-531-5747

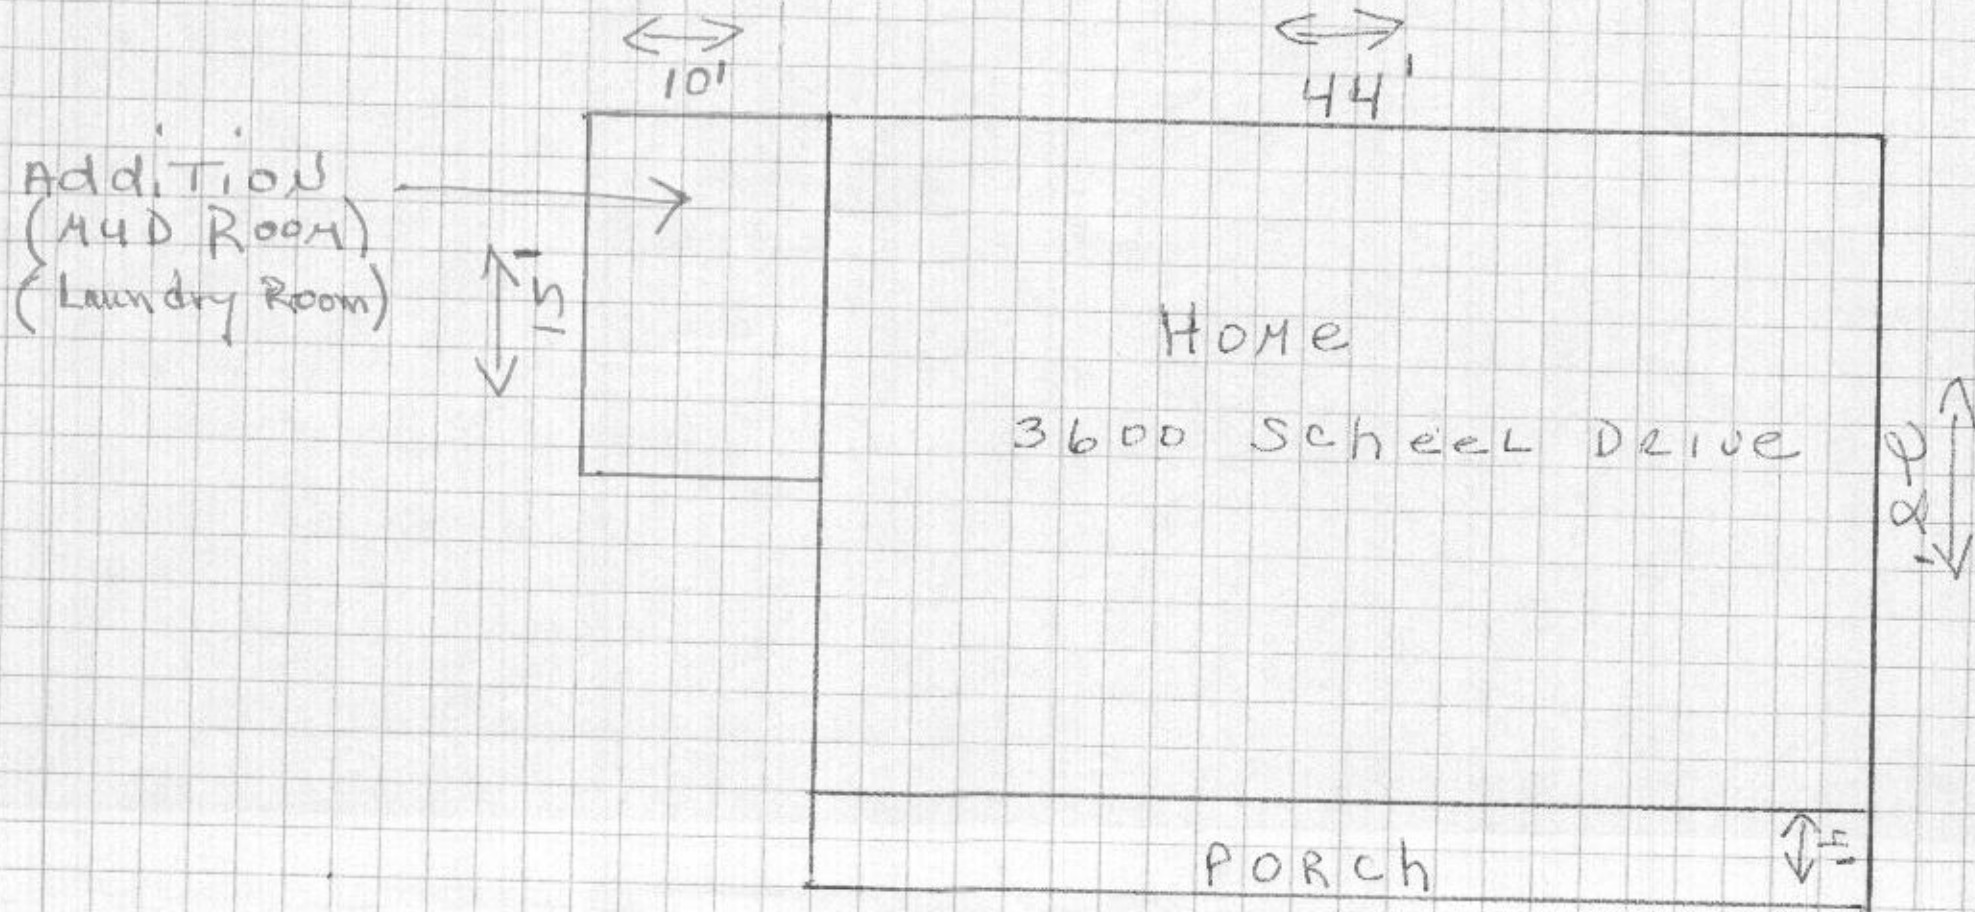

Septic
20' dry well

- Septic
- Well
- = 2'

N73924		Job Class	Issued By	Date	Service B.	Service Center	Bldg. Supt.	Tel. No.																	
Location		Zip	Development	City/County	Work in Connection with																				
Meters Set In Name Of		Bill Monthly Consumption To (If Different From Above)			Zip	W.O. No.																			
Bill Service Connection To		Service Billing Address			Zip	D.O. No.																			
Used Before Also Uses First Time		Last Lived Address			PERMITS		Estimate No.																		
Occupied As/Meter Supplies		New Bldg.		Single Bldg.	Two Bldg.	Main to Bldg.	Curb to Bldg.	Plate No.																	
		Pressure		Lo	Med	10#	Hi	OH																	
		UG - G. & E.		Elect.	Ceiling	Baseboard	Furnace																		
		Heat: Heat Pump		Supplemental Only																					
House Numbers	No. Hs.	Rge.	Wh.	Dry.	Fur.	Other	900 MCF Over	Gas Annual Base	De-mand Cu. Ft.	Outside Meter	Yes	No	Outside Riser	Yes	No	Sch.	Grid Code	Service Center	Tax Dist. Code	Size	Overall Length	Excess Over 50'	Total	Certificate Information	GAS Paid/Bill
House Numbers	No. Hs.	Rge.	Wh.	Dry.	Heat	Air Cond. Cent.	Win.	Other	Elect. Annual Base	Tax Dist. Code	Volts-Ph-W 120/240-10-3	Estimate No.	De-mand KVA	Sch.	Grid Code	TLC	Length Feet @ 50'	Normal Service \$	Excess Feet @	Excess \$	TOTAL	EL CHG. Paid/Bill	Certificate Information		
3600	1	12	45	5	DN	3/4"			0710	04-3	"	"		40	2-2-0AL & 2-2-0ALN	23-156	200	1301			40	X	Hang		

REMARKS: TC BALTIMORE GAS AND ELECTRIC COMPANY (herein referred to as the Company).

You are hereby requested to extend your underground distribution system to supply the premises at the above location in accordance with the applicable Public Service Commission rules and Company Service Tariffs. The undersigned agrees: (a) to furnish suitable Rights of Way, clear the area of trees, stumps, and other obstructions, grade to within 6 inches of the final grade, and to otherwise provide conditions satisfactory to the Company, all at no cost to the Company, before it begins construction, and (b) to pay the above charges upon completion of each service connection line. It is agreed that title to said underground distribution system extensions, including service connection lines, shall be vested in the Company, and that the installation thereof is subject to the availability of material and labor.

SIGNED: JEROME W. WALKER DATE: 12-25-79

N73924		Location		100 SCHOLL DRIVE LOT 6		Tel. No.		Y-14 to Dist. C/Rel to Contact	
PERMISSIONS		Private R/W Req'd		Yes No Contact Verbal ok		Mr. Mrs.			
		2-2-0AL & 2-2-0ALN		23-156		Total Length		200 Ft. ED 1301	
		2-250AL & 2-0ALN		23-181					
		2-350AL & 3-0ALN		23-154					
		197' TRENCHING		DIRT DITCH					
		3600							
		1-2-80							


	Actual Date	Empl. Code	Man-Hours
Initial Contact	12-25-79	3055	
Pre-Eng. Compl.	12-28-79	3055	1
Eng. Compl.	"	3017	1/2
Layout Compl.	12-28-79	3055	2
Rel. to Const.			

LETTERS		
1	Builder	Customer
2	Builder	Customer

INDICATE ON SKETCH

- TOTAL SERVICE CABLE LENGTH TO INCLUDE LENGTH OF RUN PLUS SLACK AT EACH END
- NORTH ARROW
- TYPE OF DIGGING
- PRESENT & FUTURE SUBSURFACE OBSTRUCTIONS
- DIMENSIONS
 - 1 GAS TRENCH LENGTH
 - 2 ELECTRIC TRENCH LENGTH
 - 3 RELATIONSHIP OF ROAD WIDTH, PUBLIC R/W, PRIVATE P/L'S, ETC.
 - 4 DISTANCE TO X-ROAD C/L

WELLS

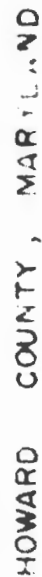

662 / 455

WITH THE MINIMUM
EQUIPPED BY THE
HEALTH REGULATIONS

SITE INSPECTION SHEET

OWNER: Gary & Jennie Rudzick PHONE #: 410-531-5747


ADDRESS: 3600 Scheel Drive CONTRACTOR: _____

Ellicott, City WELL TAG #: _____

SUBDIVISION: _____ LOT: _____ COUNTY #: _____

PROPOSAL: 10 x 15' mudroom & carport

LOCATION DIAGRAM

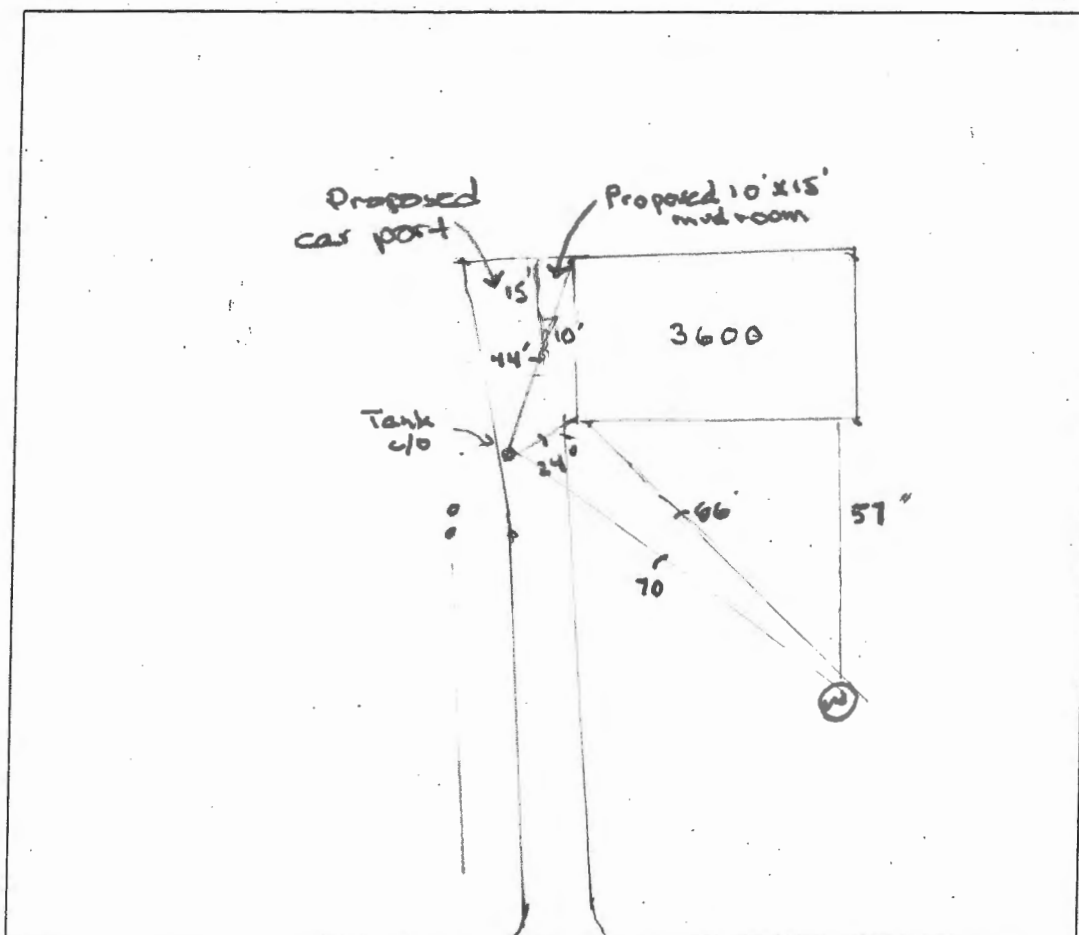

Scheel Drive

COMMENTS: The owners would like to add a mudroom for easy access to washer/dryer. They also talked about adding a carport next to the mudroom over existing paved driveway. No noted issue w/ septic. The drilled well is about 12" above grade w/ 2 pc cap. Informed owners

DATE: 9/8/20 INSPECTOR: Hank Oswald

to make conduit flush w/ cap again.