

Sheppard Manor
lot 12 & 11 (650A)

COUNTY #

SOIL PROFILE

653

Dark Brown

Loam

Brown

Clay Loam (3)

Brown

Silt Loam

w/

10-20%

Mica

Fragments

13'

656

Dark Brown

Loam

Brown

Clay

Loam (3)

Brown

Silt Loam

w/

10-20%

Mica

Fragments

11'

655

Dark Brown

Loam

Brown

Clay

Loam (2)

Brown

Silt Loam

w/

10-20%

Mica

Fragments

10"

654

Dark Brown

Loam

Brown

Clay

Loam (2)

Brown

Silt Loam

w/

10-20%

Mica

Fragments

10"

657

Dark Brown

Loam

Brown

Clay

Loam (2)

Brown


Silt Loam

w/

10-20%

Mica


Fragments

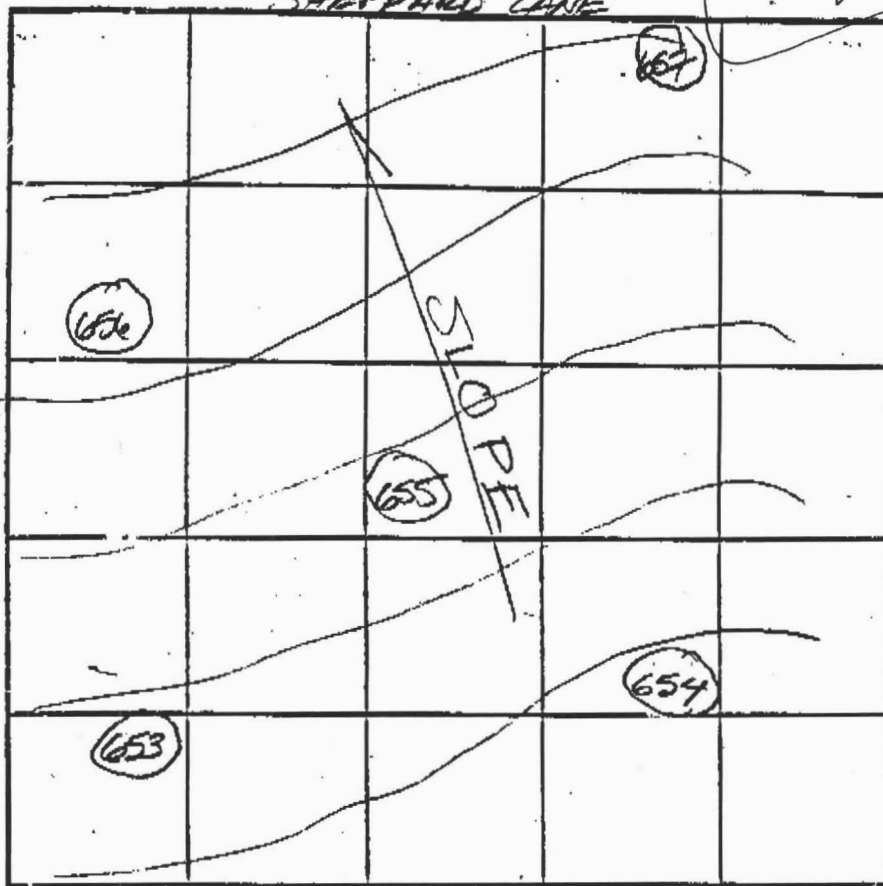

INDICATE NORTH - NAME ADJOINING ROADWAY AS BASE LINE.

SOIL PROFILE

0'

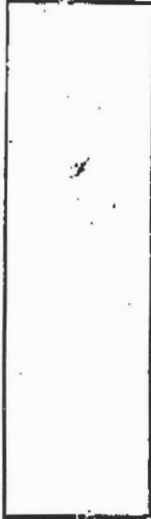

657

Brown

Silt Loam

Heavy Silt Loam

Yellow

Tan

Gray

Silt Loam

10-15%

Dark

Fragments

14'

DATE	TEST NO.	DEPTH	PRE-WET		TEST - 1" DROP		TIME
			START	STOP	START	STOP	
5/30/03	656	5' 1/2" V 13'	2:40	2:49	2:49	2:52	3min
5/30/03	653	5' V 13'	2:43	2:46	2:46	2:51	5min
5/30/03	654	5' V 12'	3:13	3:18	3:18	3:30	12min
5/30/03	655	5' V 9'	3:19	3:21	3:21	3:23	2min
5/30/03	650A	VISUAL	OK				
5/30/03	657	5' V 14'	2:04:55	2:06:50	2:06:50	2:09	2min

REMARKS LOT PASSED

TYPE OF SOIL

TESTED BY FA / MR

ALSO PRESENT HATFIELD

TRENCH DESIGN DATA: AVERAGE PERCOLATION TIME

TRENCH WIDTH

INLET DEPTH

MAXIMUM BOTTOM DEPTH

SQ. FT/BEDROOM

Lot 11

MR