
907000/23 Scaned 8/31/07 DD EPARTMENT OF INSPECTIONS, LICENSES AND PERMIT 3430 COURT HOUSE DRIVE ELLICOTT CITY, MO 21043 PERMITS (410) 313-3455 INSPECTIONS (410) 313-1810 AUTOMATED INFORMATION (410) 313-3800 HOWARD COUNTY PERMIT APPLICATION Building Address 4635 SHEPPARA MANCE DRIVE Property Owner's Name ( 210,43 iTY, MD SDP/WP/Petition #: HEPPARD MANOR Census Tract 605/0/ Subdivision Applicant's Name & Mailing Address, (if other than stated hereon) 268 Tax Map RC. Fax 410-997-4358 Map Coordinates 10F/3Lot size 47, 179 T Phone ZoningNEO SAME VACANT Contractor Company Existing Use Proposed Use \_ Contact Person 300,000 Estimated Construction Cost \$\_ Description of Work MODEL! HUNTINGTON W, Address BUAR GARAGE State Zip Code City\_ License No. Phone I ROUGH-IN FP, SUNROUN, GARAGE, (4BR Engineer Contact Name Address City Phone Fax Phone Fax BUILDING DESCRIPTION - RESIDENTIAL BUILDING DESCRIPTION - COMMERCHAL **Building Characteristics** Utilities **Building Characteristics** Water Supply: SF Townhouse Height: Water Supply: Public Width **Public** O Private No. of stories: Private 1st floor: Sewage Disposal: Sewage Disposal: 2nd floor: Public Public Private Gross area, sq. ft. per floor: Private Electric Yes No 🗆 Electric Yes □ No □ Yes No Y Gas 24 Use group: Gas Yes □ No □ Heating System: No. of efficiency units: No. of 1 BR units: No. of 2 BR units: Heating System: Electric XEA Oil Construction type: Electric Oil Natural Gas 💥 Reinforced Concrete Natural Gas □ BR units: Propane Gas X Structural Steel Masonry er Structure: Sprinkler system: N/A B Sprinkler system: nsions: Wood Frame N/A D NFPA#13D Full NFPA #13R ight Partial Other: State Certified Modular Other Suppression State Certified Modular # of Heads Mahufactured Home THE UNDERSIGNED HEREBY CERTIFIES AND AGREES AS FOLLOWS: (1) THAT HE/SHE IS AUTHORIZED TO MAKE THIS APPLICATION; (2) THAT THE INFORMATION IS CORRECT; (3) THAT HE/SHE WILL COMPLY WITH ALL REGULATIONS OF HOWARD COUNTY WHICH ARE APPLICABLE THERETO; (4) THAT HE/SHE WILL PERFORM NO WORK ON THE ABOVE REFERENCED PROPERTY NOT SPECIFICALLY DESCRIBED IN THIS APPLICATION; (5) THAT HE/SHE GRANTS COUNTY OFFICE THE RIGHT TO ENTER ONTO THIS PROPERTY FOR THE PURPOSE OF INSPECTING THE WORK PERMITTED AND POSTING NOTICES. Title/Company Date Checks payable to: DIRECTOR OF FINANCE OF HOWARD COUNTY \*\* PLEASE WRITE NEATLY AND LEGIBLY. FOR OFFICE USE ONLY-AGENCY SIGNATURE APPROVAL DPZ SETBACK INFORMATION PROPERTY DE 132 Land Development, DPZ Filing fee Front: 290 State Highways Rear: Permit fee 6472 40 **Building Official** Side 39 Dev. Engineering, DPZ Side St Add'I per. fee 8016 Health All minimum setbacks met? TOTALFEES Fire Protection YES D NO D Sub-total paid Is Sediment Control approval required prior to issuance? Balance due is Entrance Permit required? YES D NO D YES D NO D Chack Historic District? Validation CONTINGENCY CONSTRUCTION START DILLER YES D NO D ONE STOP SHOP: Lot Coverage for NewTown Zone SDP/Red-line approval date Accepted by Distribution of Copies-White: Building Official Green: LDD, DPZ Yellow: DED, DPZ Pinic Health Gold: SHA T:Yorms/PERMIT.FRM Rev. 11/4//04

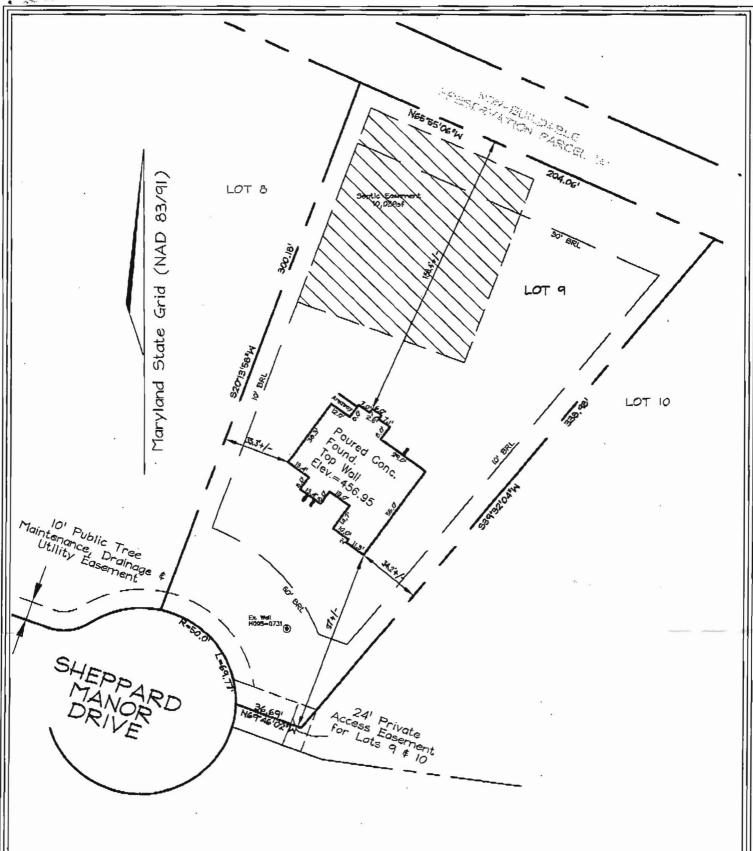

RP# B07003568

## **Associates**


Engineers Planners Surveyors 6339 Howard Lane, Elkridge, MD 21075 Tel:410-567-5200 Fax: 410-796-1562 E-mail: FSHERI.COM

= FIREPLACE = BAY WINDOW = DRIVEWAY = CONCRETE F/P O/H OVERHANG H/P HEAT PUMP GAS METER ELECTRIC METER DIW G/M

DIMENSIONS FROM FOUN, WALL TO PROPERTY LINE ARE +/-0.1 ADDRESS No.: 4635 SHEPPARD MANOR DRIVE

ADDRESS No.: 4635 SHEPPARD MANOR DRIVE
TOP OF WALL ELEV. = 456.95
THIS LOCATION DRAWING IS OF BENEFIT TO THE CONSUMER ONLY
INSOFAR AS IT IS REQUIRED BY A LENDER OR A TITLE INSURANCE
COMPANY OR ITS AGENT IN CONNECTION WITH CONTEMPLATED
TRANSFER, FINANCING OR REFINANCING.
THIS LOCATION DRAWING IS NOT TO BE RELIED UPON FOR THE ESTABLISHMENT OR LOCATION OF FENCES, GARAGES, BUILDINGS, OR
OTHER EXISTING OR FUTURE IMPROVEMENTS.
THIS LOCATION DRAWING DOES NOT PROVIDE FOR THE
ACCURATE IDENTIFICATION OF PROPERTY BOUNDARY LINES, BUT
SUCH IDENTIFICATION MAY NOT BE REQUIRED FOR THE TRANSFER
OF TITLE OR SECURING FINANCING OR REFINANCING.

WALL CHECK	
FOUNDATION	Date: 8/07/08
FINAL	Date:
DRAWN BY:	el8
SCALE:	"=5 <i>0</i> '
W.O. No.:	3160

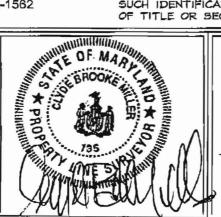

LOT 9 #4635 SHEPPARD MANOR DRIVE

PLAT #19210

TAX MAP 29 GRID I PARCEL 268 5TH ELECTION DISTRICT HOWARD COUNTY, MARYLAND