

Building Permit Application
Howard County Maryland
Department of Inspections, Licenses and Permits
3430 Court House Drive
Permits: 410-313-2455 www.howardcountymd.gov

Date Rec	eived: _	
----------	----------	--

Permit No.: ___

Building Address: 3346 S	ANG RI	Property Owner's Name:	Millorin
	m Zip Code: 21738	Address: 3346 SANGE	4)
	1	City: (Newwood State: M)	
Suite/Apt. #SDF	P/WP/BA #:	Phone: 443-878-6584 Fa	X:
Subdivision:		Email: Jim Kulundu	6 ganos. Com
		1	9
Lot: Tax Map:	Parcel:	Applicant's Name & Mailing Address, (If ot	
		Applicant's Name:	
Existing Use:		Address:	7in Codo
		City:State:	
Proposed Use:		Phone:Fax:	
Estimated Construction Cost: \$/C	,000.00	Email:	
Description of Work:		Contractor Company:	
	_	Contact Person:	
(8' x 36') to	tront of	Address:	
Hone		City:State:	
7,6,7			
		License No. :	***
		Phone: Fax:	
Occupant/Tenant Name:	Es Killagia	Email:	
	-		
Was tenant space previously occupied	? □Yes □No	Engineer/Architect Company:	
Contact Name:	15.1100 1	Responsible Design Prof.:	
Address: 3346 SANC	- P1)	Address:	
City: (Hen wood	State: Zip Code: Z1738	City:State:	Zip Code:
	,		
Phone: 443-818-6580	And the second of the second o	Phone: Fax:	
Email: Jinkillorin	@ Ushoo. com	Email:	
•	O .		
Commercial Building Characteristic		<u>Utilities</u>	1000 1000 1000 1000 1000 1000 1000 100
Height:	✓ SF Dwelling ☐ SF Townhouse	Electric: ✓ Yes ☐ No	
No. of stories:	<u>Depth</u> <u>Width</u>	Gas: ☐ Yes ☐ No	
Gross area, sq. ft./floor:	1 st floor:	Water Supply	
	2 nd floor:	□ Public	
Area of construction (sq. ft.):	Basement:	Private	
	☐ Finished Basement		
Use group:	☐ Unfinished Basement	<u>Sewage Disposal</u>	
	☐ Crawl Space	☐ Public	
Construction type:	☐ Slab on Grade	Private	
☐ Reinforced Concrete	No. of Bedrooms:	Heating System	
☐ Structural Steel	<u>Multi-family Dwelling</u>	Electric Dil	
☐ Masonry	No. of efficiency units:		
☐ Wood Frame	No. of 1 BR units:	☐ Natural Gas ☐ Propane Gas	
☐ State Certified Modular	No. of 2 BR units:	☐ Other:	
	No. of 3 BR units:	Sprinkler System:	
2	Other Structure:	☐ Yes ☐ No	The state of the s
	Dimensions:		
> Roadside Tree Project Permit	Footings:	Grading Permit Number:	
□Yes □No	Roof:	Grading Permit Number.	-
Roadside Tree Project Permit #	☐ State Certified Modular		
	☐ Manufactured Home	Building Shell Permit Number	
WITH ALL REGULATIONS OF HOWARD COUNTY V APPLICATION; (5) THAT HE/SHE SPANTS COUNTY Applicant's Signature	VHICH ARE APPLICABLE THERETO; (4) THAT HE/SHE WIL	MAKE THIS APPLICATION; (2) THAT THE INFORMATION IS COLPERFORM NO WORK ON THE ABOVE REFERENCED PROPER FOR THE PURPOSE OF INSPECTING THE WORK RERMITTED AND KILL OR WORK THE WORK RERMITTED AND KILL OR WORK THE WOR	TY NOT SPECIFICALLY DESCRIBED IN THIS
 Title/Company			
пие/ Сотрипу	Checks Payable to: DIRECTOR OF F	INANCE OF HOWARD COUNTY	
	**PLEASE WRITE NE		
	-FOR OFFICE		
	DD7 CETDA	CK INFORMATION Filing Fee	\$
AGENCY DATE	SIGNATURE OF APPROVAL Front:	Permit Fo	
1			

AGENCY	DATE	SIGNATURE OF APPROVAL
State Highways		
Building Officials		
PSZA (Zoning)		
PSZA (Engineering)	,	
Health	3/17/20	co That fait
s Sediment Control appro	val required	I for issuance? ☐ Yes ☐ No

☐ CONTINGENCY CONSTRUCTION START

	Side:			
	Side St.:			
	All minimum setbacks met?	☐ Yes	□No	
	Is Entrance Permit Required?	☐ Yes	□No	
thin	Historic District?	☐ Yes	□No	_
	Lot Coverage for New Town Zone:			
ce? ☐ Yes ☐ No	SDP/Red-line approval date:			
				_

Rear:

Filing Fee	\$
Permit Fee	\$
Tech Fee	\$
Excise Tax	\$
PSFS	\$
Guaranty Fund	\$
Add'l per Fee	\$
Total Fees	\$
Sub- Total Paid	\$
Balance Due	\$
Check	#

Distribution of Copies:

White: Building Officials

Green: PSZA,Zoning

Yellow: PSZA,Engineering

Pink: Health

Gold: SHA


WALKTHRU BUILDING PERMIT

BP#

A#

APP SAN RALLT Free DATE: 3/01/200

DESC. OF WORK: 8 × 36 | Recent

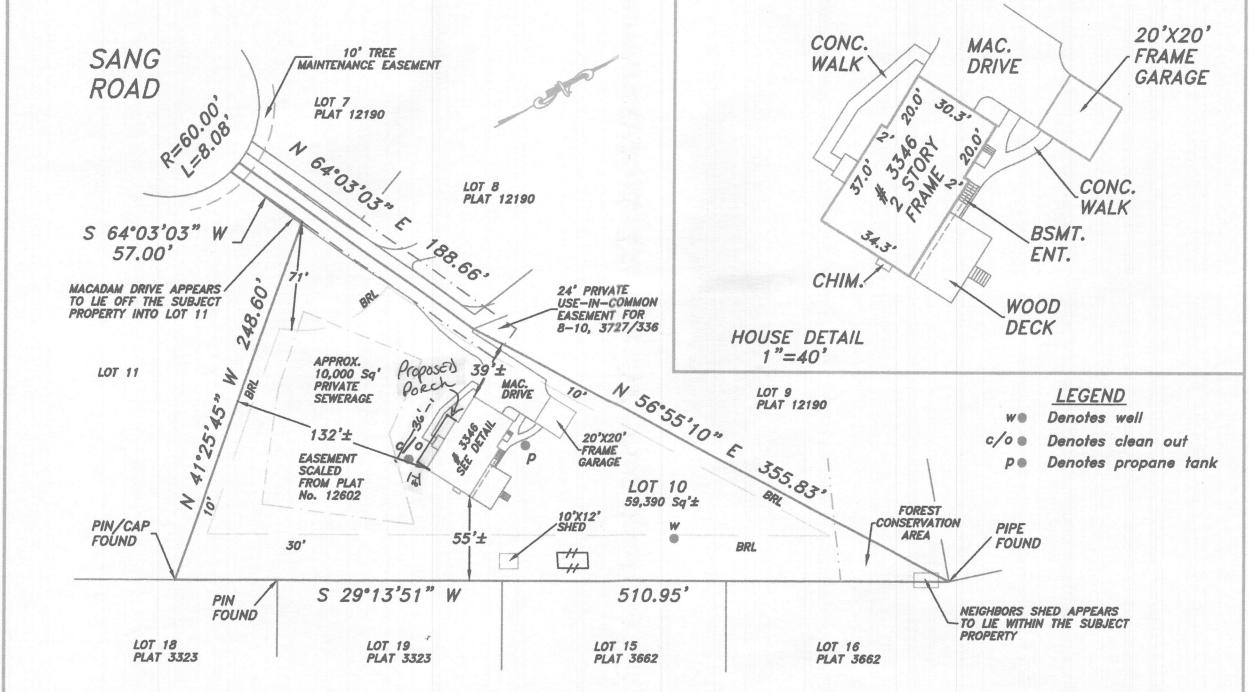

The purpose of this drawing is to locate, describe, and represent the positions of buildings and substantial improvements affecting the property shown hereon, being known as:

LOT 10, as shown on the plat entitled "HOLLY HILLS" SECTION II

recorded among the land records of Howard County, Maryland in Plat Number 12602

This is to certify that I either personally prepared or was in responsible charge over the preparation of this drawing and the surveying work reflected in it, all set forth in Regulation .12 of Chapter 09.13.06 of the Code of Maryland Annotated Regulations.

This is page one of a two page document. The advice found on the affixed page is an integral part of this drawing, and is not valid without all pages.



James Carl Hudgins
Property Line Surveyor #96
Expiration Date: 3/11/16

LOCATION DRAWING

3346 SANG ROAD 4th ELECTION DISTRICT HOWARD COUNTY, MARYLAND

NTT Associates, Inc.

16205 Old Frederick Rd.
Mt. Airy, Maryland 2177
Phone: (410) 442-2031
Fax: (410) 442-1315
www.nttsurveyors.com

Scale:	1 "=	80'
Date:	4/26	/14
Field By:	1	RIK
Drawn B	y:	RIK
File No.:	MISC	11074
Page No.	.: 1	of 2