


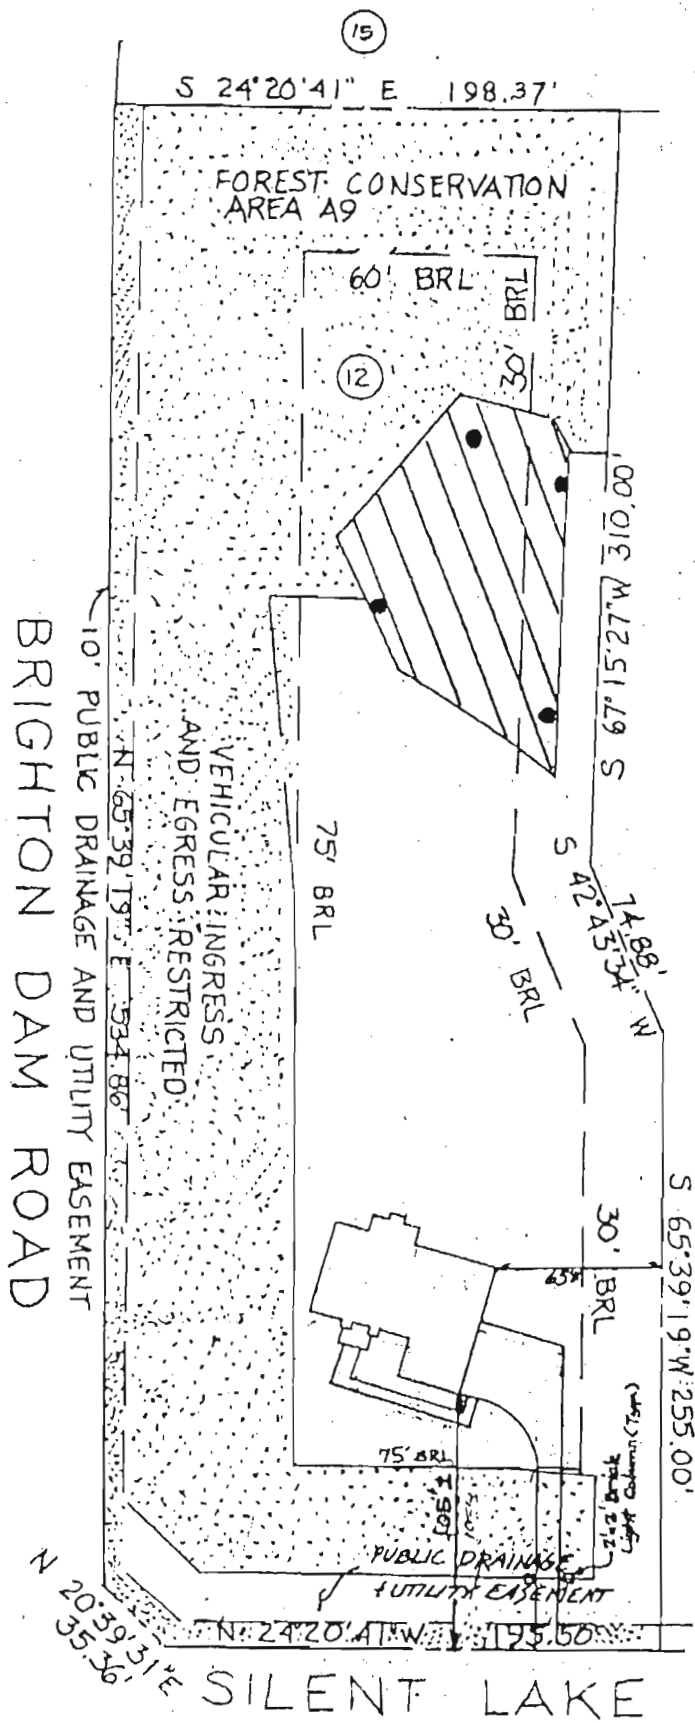

13


APPROVED

WALK-THRU BUILDING PERMIT

BP# 000158314 A# 49861-C

APP. SAN CFD DATE: 2/3/06

DESC. OF WORK: Finish Basement

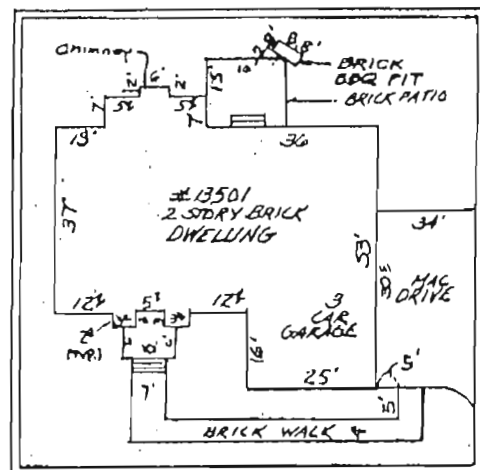

ENLARGEMENT 1"=30'

THE LOT SHOWN HEREON IS IN FLOOD ZONE C PER F.E.M.A. FLOOD INSURANCE RATE MAP PANEL # 24004-00328

The plat is of benefit to a consumer only insofar as it is required by a lender or a title insurance company or its agent in connection with contemplated transfer, financing, or refinancing. The plat is not to be relied upon for the establishment or location of fences, garages, buildings, or other existing or future improvements. The plat does not provide for the accurate identification of property boundary lines, but such identification may not be required for the transfer of title or securing financing or refinancing. The plat contains a tolerance of accuracy of two feet, more or less.

H HICKS ENGINEERING CO., INC.
ENGINEERS, SURVEYORS & PLANNERS
200 EAST JOPPA ROAD - SUITE 402
TOWSON, MARYLAND 21288
TELEPHONE: (410)404-0001

DEED REF: 000158314
PLAT REF: M.D.R. 12383

LOCATION DRAWING OF:

#13501 SILENT LAKE DRIVE - LOT 12
PLAT OF CORRECTION SPRINGDALE ESTATES
LOTS 1-18 & PRESERVATION PARCELS A & B
FIFTH ELECTION DISTRICT HOWARD COUNTY, MD.

DATE: 2/26/03

SCALE: 1"=60'

FILE: