

Approved 11/24/20 - H.C.

Menu Save Reset Cancel Help

## Record Detail \* (This section is required.)

Permit Type	Permit Number	Opened Date
Building/Residential/Misc/Pool Spa	B20004080	11/20/2020
Description of Work		
SFD/ CONSTRUCT 34'X18' IN GROUND CONCRETE POOL, FENCE TO CODE, FILLED BY TRUCK, DEPTH 3 1/2' TO 7'		

[check spelling](#)

## Address \* (This section is required.)

Search Reset Clear Get Parcel &amp; Owner

Street #	Street Name	Street Type
3642	SHARP	RD
Unit Type	Unit #	X Coordinate
--Select--		-77.01077
		Y Coordinate
		39.27069
City	State	Zip Code
GLENWOOD	MD	21738
		Primary
		Yes

## Parcel \* (This section is required.)

Search Reset Clear Get Address &amp; Owner

GIS ID *	Parcel	Parcel Area	Land Value	Improved Value	Exemption Value	Plan Area
896083	145	3.1	245700	595000	349300	RURAL
Legal Description						
IMPSP/O PAR F 3.107 AR I[ ]3642 SHARP RD NWS[ ]JUSTICE TRACT						

[check spelling](#)

Block	Lot	Census Tract	Council Dist	Inspection Dist	Supervisor Dist	Map #	DAP Zone
	2 F	605601	5				
Plan Area	State Tax Id	Subdivision Name					
	1404314921						
Section	Area	Tax Map					
		21					
Grid	Zoning District	ADC Map					
21-11	RR-DEO	4812-J7					
SDP No.	Final Plan No.	WP File No.					
Record Plat No.	WS Contract No.	FDP No.					
Owner Occupied	Year Built	Historic District					
<input type="radio"/> Yes <input type="radio"/> No	2008	<input type="radio"/> Yes <input checked="" type="radio"/> No					
Historic District Registry No.	Stat Area	Flood Plain					
	4-09	<input type="radio"/> Yes <input checked="" type="radio"/> No					

Building No

Owner \* (This section is required.)

Search

Reset

Clear

Name \*

KEILHOLTZ WILLIAM L

Address Line 1

3642 SHARP RD

Address Line 2

Address Line 3

Mail City

GLENWOOD

Mail State

MD

Mail Zip Code

21738

Phone

410-507-7705

Primary

Yes

E-mail

Cell Number

Fax Number

Professionals (This section is not required.)

Search

Reset

Clear

License # \*

08050132939

Business Name

PARADISE POOLS INC

License Type \*

MHIC Co

▼

First Name

VERA

Middle Name

Last Name

FRANCISCO

Primary

Yes

▼

Address Line 1

7901 POPLAR GROVE ROAD

Address Line 2

City

SEVERN

State

MD

ZIP Code

21144-0000

Phone 1

3017250005

Phone 2

Fax

0000000000

E-mail

OFFICE@PARADISEPOOLSMD.COM

Applicant (This section is not required.)

Search

As Owner

As Lic. Prof

As Contact

Type \*

Applicant

▼

First Name

KAREN

MI

H

Last Name

ROWLEY

Relationship

Agent for Applicant

▼

Full Name

KAREN H ROWLEY

Primary

Yes

▼

Organization Name

KH &amp; K

Street Address

293 SOUTHLAND COURT

Address Line 2

<b>City</b>	<b>State</b>	<b>Zip Code</b>
DUNKIRK	MD	20754
<b>Phone</b>	<b>Cell</b>	<b>Fax</b>
410-507-7705		
<b>E-mail *</b>		
KHKPERMITS05@YAHOO.COM		

## Addtl Info

<b>Est Construction Cost *</b>	<b>Housing Units *</b>	<b>Number of Buildings *</b>	<b>Public Owned</b>
40000	0	0	No <input type="checkbox"/>
<b>Construction Type</b>			
--Select-- <input type="checkbox"/>			

## POOL INFORMATION

## MISCELLANEOUS POOL INFORMATION

<b>Capital Project-No Fee *</b>	<b>Capital Project Number</b>	<b>Fee Exempt *</b>	<b>Water Supply *</b>	<b>Sewage Disposal *</b>
<input type="radio"/> Yes <input checked="" type="radio"/> No		<input type="radio"/> Yes <input checked="" type="radio"/> No	Private <input type="checkbox"/>	Private <input type="checkbox"/>
<b>Existing Use</b>	<b>Type of Pool or Spa *</b>	<b>Electrical Permit Number</b>	<b>Expiration Date</b>	
SFD <input type="checkbox"/>	In Ground Pool <input type="checkbox"/>		5/22/2021 <input type="checkbox"/>	

## PAYMENT INFORMATION

<b>Check 1</b>	<b>Payee 1</b>	<b>SAP Doc No</b>	<b>SAP Entered</b>

## Related Records

1

<u>Permit Number</u>	<u>Record Type Alias</u>	<u>Status</u>	<u>Number</u>	<u>Street Name</u>	<u>Opened Date</u>	<u>Des</u>
B20004080	Residential Pool or Spa Permit	Review In Process	3642	SHARP	11/20/2020	SFI
E20005214	Residential Electrical Miscellaneous Permit	Application Acceptance Pending	3642	SHARP	11/22/2020	PO

1

&lt;

&gt;

Submit


Cancel

SETBACKS
FRONT: 40'
SIDE: 7'
BACK: 7'

UTILITIES
Well
septic



10620 Kings Hill Rd, Laurel, MD 20794 | Phone: 301-255-0005 | Fax: 206-291-1277 | www.paradisepools.com | 10111C-P2-200701

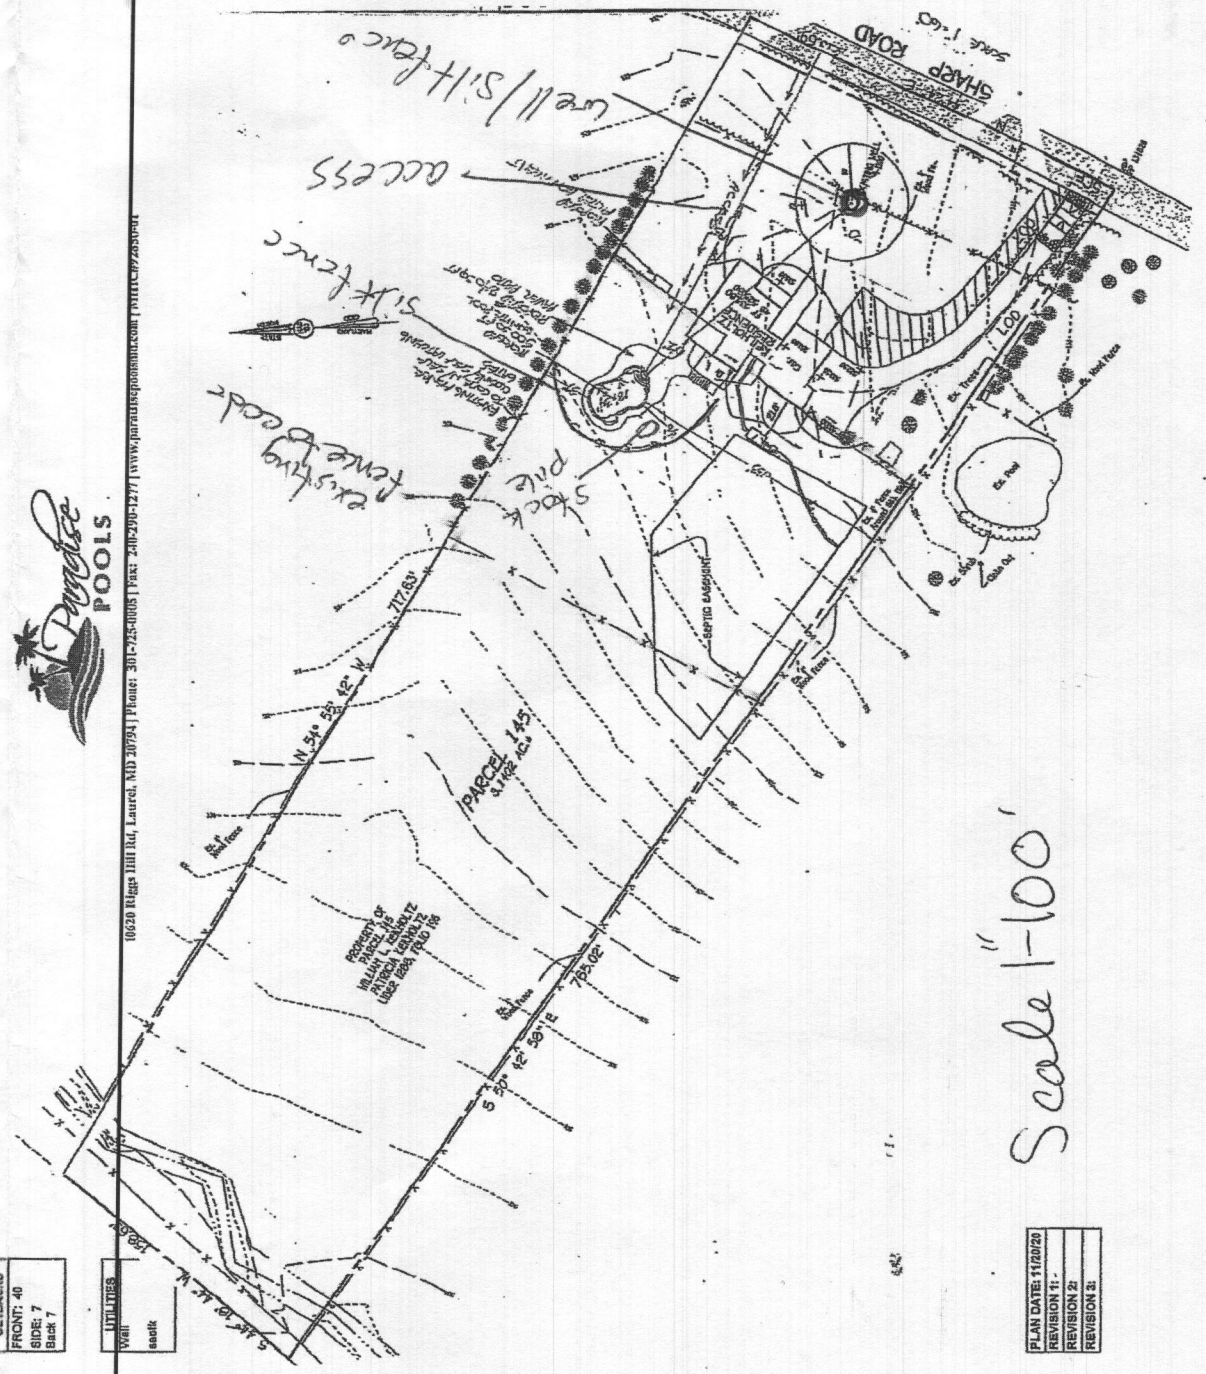

PLAN DATE: 11/07/20
REVISION 1:
REVISION 2:
REVISION 3: